

## **Addendum II**

### **RE-BID 25-4090-02 Installation of Limited Use/Limited Application Elevator Q&A**

1. Request a copy of the complete Building Plans and Specifications by posting on the solicitation website or by email.
  - a. See attached files.
2. Request copy of the TDLR-approved LU/LA Permit for this Project.
  - a. Permit will need to be acquired by installer.
3. Request suspension of further framing and drywall work on the 1st and 2nd floor elevator lobby walls until such time an elevator contractor provides a lobby frame opening for approval.
  - a. not putting sheet rock up, contractors will pull off if needed, 2<sup>nd</sup> floor has some on the back wall.

**DISCUSSION:** The rough-framed lobby opening appears too close to the right side wall for the elevator opening--there's insufficient room inside the pit for elevator cab clearance. We suspect both floors will require the frame to shift left by several inches in order to accommodate the elevator. Suspending lobby wall work until the elevator opening location is confirmed avoids cost to shift the openings to fit the elevator being installed.

- a. Provide specific dimensions for opening size and location. We can get building contractor to adjust opening.
4. Request confirmation of the applicable year code--2016, 2019, or 2022--for ASME A17.1?
  - a. City of Burnet follows IBC 2021. If there are any additional state or regulatory codes that LU/LA's need to abide by, they need to be followed as well.
5. Request Bid Due/Opening Date be moved to 5 days after response to RFI's to provide sufficient time to refine pricing and schedule.
  - a. Extended to December 02, 2025 per addendum I.
6. Please confirm if the elevator contractor or General Contractor responsible for providing, installing and piping the elevator sump pump and the sump pump grate. For piping, does it include the check valve and ball valve? If elevator contractor responsible, request detail/drawing that identifies the sump pump general path and connection point to the existing sanitary drain.
  - a. GC is taking care of this.

**DISCUSSION:** SOW, Specs and plans do not clarify who is providing sump pump or piping to drain. Concern is the plans show no piping path/connection for the sump pump. May require saw cutting concrete to route piping to 1st floor bathroom drain.

- a. GC has taken care of this.
7. Is there a required oil detector, pit water level alarm, or oil/water separator? If so, is the elevator contractor or General Contractor to provide and install? Where is it to be placed? Does it need to be connected to a building automation system?
  - a. Elevator contractor is required to provide all equipment and accessories needed to comply with code and manufacturer's warranty.

8. Please confirm if the elevator contractor or General Contractor to provide electrical service to the sump pump?
  - a. GC is taking care of this
9. Please confirm a smoke detector to be placed at 1st and 2nd floor elevator, and at the top of the elevator shaft?
  - a. If one is needed by code or manufacturer, elevator contractor will need to provide one.
10. Please confirm if the Elevator Contractor or General Contractor is to provide electrical service to the elevator controller where it needs to land within the hoistway for the elevator controller?
  - a. Elevator contractor to be responsible.
11. Please confirm if the Elevator Contractor or General Contractor is to include the cost of the smoke detector placement/install?
  - a. If one is needed by code or manufacturer, elevator contractor will need to provide one.
12. Request confirm if the elevator contractor or General Contractor is to included the cost of lowering the elevator pit if required?
  - a. Elevator contractor to be responsible.

**DISCUSSION:** Specification indicates Pit to be 13 inches or greater. Current pit depth is 12 inches.

- a. Correct

13. Request confirmation if Cibes Symmetry is the only acceptable LU/LA, or an equal alternate LU/LA Elevator Manufacturer is acceptable?
  - a. Alternates are acceptable with detailed reasoning as to why you are suggesting an alternate. Provide pricing for both Cibes Symmetry and alternate should there be one.

**DISCUSSION:** We believe more durable and cost-effective alternatives exist relative to a Cibes Symmetry?

- a. Alternates are acceptable with detailed reasoning as to why you are suggesting an alternate. Provide pricing for both Cibes Symmetry and alternate should there be one.

14. Request confirmation if the Elevator Contractor or General Contractor is to construct the Fire-Rated Hoistway?
  - a. Elevator contractor to be responsible. Shaft is built and EC should prep the shaft for elevator and any fire rating requirements per code.
15. Request confirmation if the Elevator Contractor or General Contractor is to perform fire caulking penetrations?
  - a. Elevator Contractor is to be responsible.
16. Request confirmation of any ADA Accessibility features required by ASME A17.1 (2022) code, such as: video monitoring, touchless controls, remote (off-site) callout.
  - a. Elevator contractor is responsible for providing all code required features. This unit has to be accessible and allow for card reader access control.

17. Request confirmation if the Elevator Contractor or General Contractor is responsible for providing telephone service to the LU/LA? Is the telephone service analog (POTS) or digital? Is the Elevator Contractor, General Contractor or County to pay the monthly telephone service bill?
  - a. Required telephone service to be the counties responsibility. County to pay bill.
18. Is there to be remote maintenance monitoring of the elevator--requires a seperate (dedicated) phone line?
  - a. Provide pricing for county to compare.
19. Is the elevator contractor or General Contractor responsible for providing and installing the elevator flooring? Please provide product data for the elevator flooring?
  - a. Flooring will be LVT, provided by client and installed by elevator contractor.
20. Is the elevator contractor to provide their own dumpster or can the elevator contractor use the General Contractor's dumpster? Same with Port-a-Potty?
  - a. If GC is still here, yes you can use it. They can not guarantee they will still be onsite.
21. Is the General Contractor installing a fire sprinkler head in the Hoistway?
  - a. This building is not sprinklered. The only fire suppression system in the building is going to be an inert gas system for the server room on the second floor.




PROJECT GENERAL NOTES

- 1 THE CONTRACTOR, IN ACCORDANCE WITH THE PROVISIONS SET FORTH IN THESE CONTRACT DOCUMENTS, SHALL PROVIDE ALL MATERIALS, EQUIPMENT, LABOR AND SUPERVISION TO COMPLETE ALL WORK DESCRIBED HEREIN AND WHICH CAN BE REASONABLY INFERRED TO BE REQUIRED IN THESE DRAWINGS FOR CONSTRUCTION.
- 2 PRIOR TO BEGINNING CONSTRUCTION, CONTRACTOR TO VERIFY ALL DIMENSIONS, AND CONDITIONS, AND SHALL NOTIFY ARCHITECT IN WRITING OF ANY DISCREPANCIES. PROCEEDING WITH WORK SHALL CONSTITUTE ACCEPTANCE BY THE CONTRACTOR THAT ALL CONDITIONS ARE ACCEPTABLE AND THE CONTRACTOR SHALL ASSUME FULL RESPONSIBILITY.
- 3 DO NOT SCALE DRAWINGS - IF DIMENSIONS ARE IN QUESTION, THE CONTRACTOR SHALL BE RESPONSIBLE FOR OBTAINING CLARIFICATION FROM THE ARCHITECT BEFORE CONTINUING WITH CONSTRUCTION.
- 4 CONTRACTOR SHALL PERFORM ALL WORK IN ACCORDANCE WITH ALL APPLICABLE CODES, REGULATIONS, ACTS, AND COVENANTS, HAVING JURISDICTION.
- 5 THE CONTRACTOR SHALL OBTAIN AND PAY FOR ALL PERMITS, INSPECTION FEES, AND DEPOSITS REQUIRED FOR THE PROVISION AND INSTALLATION OF ALL WORK. IT SHALL BE THE CONTRACTOR'S RESPONSIBILITY TO CALL FOR LOCAL INSPECTIONS AND OBTAIN APPROVAL FROM INSPECTORS. THE CONTRACTOR SHALL BE RESPONSIBLE FOR ALL INSURANCE AND NECESSARY INCIDENTALS
- 6 SEAL ALL CRACKS AROUND STRUCTURAL MEMBERS, BRACING, PIPES, CONDUITS, DUCTS AND BETWEEN WALLS AND ROOF DECK WHERE AIR INFILTRATION BETWEEN CONDITIONED AND NON-CONDITIONED (EXTERIOR) SPACES MAY OCCUR (I.E. SEAL THE BUILDING ENVELOPE).
- 7 CONCEAL ALL PIPING IN GYPSUM WALLBOARD, TYPE 'X'. WHERE PIPING IS TOO LARGE, WALLS ARE TO BE FURRED-OUT THE MINIMUM REQUIRED TO CONCEAL PIPING. INFORM ARCHITECT PRIOR TO PROCEEDING WITH THE WORK.
- 8 PROVIDE DOUBLE STUDS, BLOCKING, AND/OR DIAGONAL BRACING AT JAMBS OF DOORS, AND ALL WALL OPENINGS.
- 9 PROVIDE TRANSITION STRIPS AT ALL CHANGES IN FLOOR FINISH.
- 10 THE CONTRACTOR SHALL BE RESPONSIBLE FOR THE MEANS AND METHODS OF CONSTRUCTION. THE CONTRACTOR SHALL PROVIDE ALL MEASURES NECESSARY TO PROTECT THE STRUCTURE AND PERSONNEL DURING CONSTRUCTION. SUCH MEASURES SHALL INCLUDE BUT NOT BE LIMITED TO BRACING, SHORING OF LOADS DUE TO CONSTRUCTION EQUIPMENT, EXCAVATION PROTECTION, SCAFFOLDING, AND JOB SITE SAFETY. OBSERVATION VISITS TO THE SITE BY ARCHITECT, OWNER, OR ENGINEER SHALL NOT INCLUDE INSPECTION OF ABOVE ITEMS
- 11 FIRE EXTINGUISHERS SHALL BE PURCHASED AND INSTALLED BY THE CONTRACTOR PER LOCAL FIRE DEPARTMENT AND BUILDING CODE REQUIREMENTS.
- 12 ELECTRICAL PANEL AND FIRE EXTINGUISHER CABINETS LOCATED IN RATED PARTITIONS SHALL BE BACKED WITH DRYWALL TO MAINTAIN FIRE RATING
- 13 ALL DOORS PENETRATING "1 HOUR" CORRIDOR WALLS SHALL BE 45-MINUTE RATED DOORS UNLESS NOTED OTHERWISE.
- 14 PENETRATIONS THROUGH WALLS OR CEILINGS NOTED TO BE FIRE RATED SHALL BE FIRE SAFED AND SEALED TO MAINTAIN THE RATING. ALL WALL AND FLOOR CEILING PENETRATIONS SHALL BE PROTECTED BY PRODUCTS EQUIVALENT TO USG FIRE CODE SEALANT AND THERMAFIBER SAFING INSULATION PER MANUFACTURER'S INSTRUCTIONS AND CONFORMING TO SYSTEM WL-7001, WL-7002, WL-1027, WL-3023, WL-1039, AND/OR UL SYSTEM #CAJ-0032, CAJ-0032, CAJ-3045. DUCT WORK PENETRATIONS THROUGH RATED ASSEMBLIES SHALL BE PROVIDED WITH AN APPROPRIATELY TESTED/RATED FIRE AND SMOKE DAMPER.
- 15 CONTRACTOR TO PROVIDE FIRE / SMOKE DETECTION AND ALARM SYSTEM.
- 16 IT IS THE INTENT OF THE OWNER AND ARCHITECT THAT THIS PROJECT COMPLY WITH THE AMERICANS WITH DISABILITIES ACT AND TEXAS ACCESSIBILITY STANDARDS.
- 17 THE GENERAL CONTRACTOR AND ALL SUBCONTRACTORS SHALL AGREE TO WARRANTY THE WORK, INCLUDING BOTH MATERIALS AND WORKMANSHIP, FOR A PERIOD OF ONE YEAR FROM THE DATE OF FINAL ACCEPTANCE BY THE OWNER. CONTRACTOR SHALL REMEDY, AT NO EXPENSE TO THE OWNER, ANY DEFECTS IN THE WORK WHICH BECOME APPARENT DURING THE WARRANTY PERIOD.

GENERAL NOTES

- 1 FIRE ALARM SYSTEM. A FIRE ALARM SYSTEM WILL BE INSTALLED PER THE FIRE CODE AND NFPA STANDARD 72. THE APPROVAL OF THIS SYSTEM WILL BE ADDRESSED THROUGH A DEFERRED SUBMITTAL. APPROVAL OF THE BUILDING PERMIT DOES NOT IMPLY APPROVAL TO INSTALL THE FIRE ALARM SYSTEM.
- 2 EMERGENCY SERVICES. NORMAL BUILDING LIGHTING WILL BE SUPPLIED FROM DEDICATED LIGHTING CIRCUITS AND EMERGENCY LIGHTING WILL BE SUPPLIED FROM THE SAME CIRCUITS. A SINGLE PRIMARY HOT FROM THE BREAKER WILL BE SPLIT BETWEEN THE SWITCH AND EMERGENCY HOT. THE PRIMARY HOT WILL SUPPLY THE LIGHTING FIXTURES AND WILL BE ROUTED THROUGH THE SWITCHES LOCATED ON THE CIRCUIT. THE EMERGENCY HOT WILL SUPPLY THE BACKUP BATTERIES ONLY. THE EMERGENCY HOT WILL BE INSTALLED AS AN UNSWITCHED, CONSTANT HOT. THE BREAKER SUPPLYING THE CIRCUITS MUST BE TURNED OFF TO CUT POWER TO THE EMERGENCY HOT. COORDINATE WITH MPE SYSTEMS DRAWINGS.
- 3 PORTABLE FIRE EXTINGUISHERS. PORTABLE FIRE EXTINGUISHERS WILL BE INSTALLED SO THAT NO POINT IN THE BUILDING WILL BE LOCATED MORE THAN 75 FEET FROM AN EXTINGUISHER. THIS DISTANCE IS MEASURED BY THE PATH OF TRAVEL. THE MINIMUM RATING FOR AN EXTINGUISHER IS 2A:10BC. 5-LB DRY CHEMICAL UNITS, WHICH CARRY A 3A-40BC RATING. EXTINGUISHERS SHALL BE MOUNTED ADJACENT TO EXIT DOORS AND AT INTERMEDIATE LOCATIONS TO MEET TRAVEL DISTANCE REQUIREMENTS. EXTINGUISHERS MUST BE MOUNTED IN A VISIBLE AND ACCESSIBLE LOCATION. THE TOP OF EXTINGUISHER SHALL NOT BE MORE THAN 5 FEET ABOVE THE FINISHED FLOOR LEVEL. EXTINGUISHERS MUST BE PROVIDED WITH A CURRENT INSPECTION TAG BY A LICENSED FIRE PROTECTION CONTRACTOR.
- 4 MAIN ELECTRICAL DISCONNECT. THE MAIN ELECTRICAL DISCONNECT MUST BE LOCATED ON THE EXTERIOR OF THE BUILDING AND APPROVED SIGNAGE TO BE PROVIDED AND INSTALLED TO IDENTIFY THE LOCATION OF THE MAIN ELECTRICAL DISCONNECT. THE DISCONNECT MUST BE A KNOX-YAULT 4500 SERIES POWER SHUTDOWN. PRIOR TO INSTALLATION, THE SIZE, DESIGN AND PLACEMENT OF IDENTIFICATION SIGNS MUST BE APPROVED BY THE FIRE DEPARTMEN. COORDINATE WITH MPE SYSTEMS DRAWINGS.
- 5 MAIN GAS DISCONNECT. THE MAIN GAS DISCONNECT MUST BE LOCATED ON THE EXTERIOR OF THE BUILDING AND APPROVED SIGNAGE TO BE PROVIDED AND INSTALLED TO IDENTIFY THE LOCATION OF THE MAIN GAS DISCONNECT. PRIOR TO INSTALLATION, THE SIZE, DESIGN AND PLACEMENT OF IDENTIFICATION SIGNS MUST BE APPROVED BY THE FIRE DEPARTMENT. COORDINATE WITH MPE SYSTEMS DRAWINGS.
- 6 CARBON DIOXIDE SYSTEMS WITH MORE THAN 100 POUNDS (45.4 KG) OF CARBON DIOXIDE USED IN BEVERAGE DISPENSING APPLICATIONS SHALL COMPLY WITH THE 2015 INTERNATIONAL FIRE CODE, SECTIONS 5307.2 THROUGH 5307.5.2.

LOCATION MAP

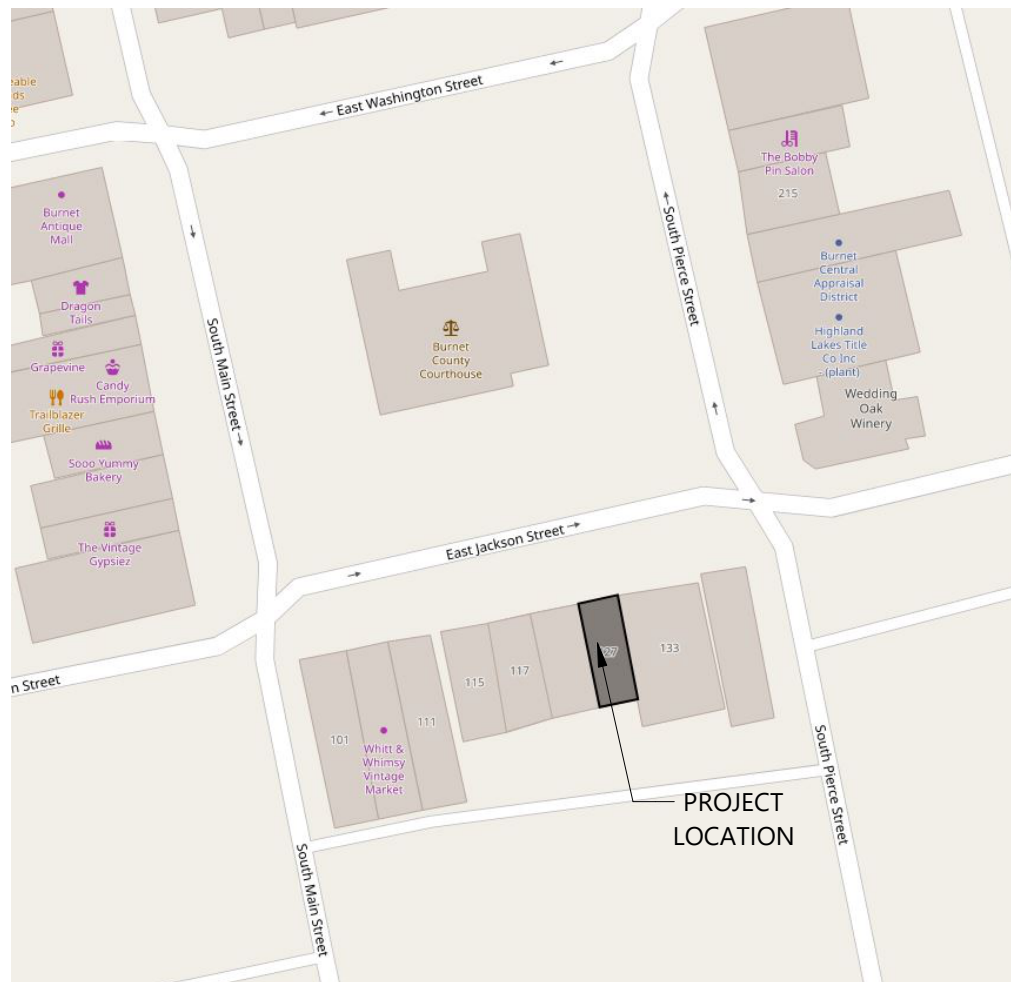

SYMBOL LEGEND

TRUE NORTH

PROJECT NORTH

AREA NOT IN CONTRACT

REVISION CLOUD & REVISION TAG/ NUMBER

COLUMN REFERENCE GRID

XX/AX.X

EXTERIOR ELEVATION

XX/AX.X

INTERIOR ELEVATION

XX/AX.X

DETAIL CALLOUT

KEY NOTE

CENTERLINE

LEVEL NAME ELEVATION

SPOT ELEVATION

ROOM LABEL

XX/AX.X

WALL SECTION

XX/AX.X

BUILDING SECTION

PARTITION TAG

DOOR TAG

GLAZING TAG

# BURNET COUNTY ANNEX

## 127 EAST JACKSON STREET, BURNET TX 78611

PROJECT TEAM DIRECTORY:

**OWNER:**  
BURNET COUNTY AUDITOR'S OFFICE  
133 E JACKSON ST  
BURNET, TX 78611  
CONTACT:JOE DON DOCKERY  
CELL #:512-715-5235

**ARCHITECT OF RECORD:**  
LEVY DYKEMA  
PROJECT #LD10-23055  
620 CONGRESS AVE., STE 110  
AUSTIN, TEXAS 78701  
WWW.LEVYDYKEMA.COM

**MEP ENGINEER:**  
HOLLINGSWORTH PACK  
PROJECT #33-1408  
3801 S CONGRESS AVE, STE 110  
AUSTIN, TX  
HOLLINGSWORTHPACK.COM  
(512) 275-6060

**STRUCTURAL ENGINEER:**  
STRUCTURES PE, LLP  
PROJECT #23.078  
4315 GUADALUPE ST. STE 301  
AUSTIN, TX  
STRUCTURESTX.COM  
(512)499-0919

**GENERAL CONTRACTOR:**  
TBD  
PROJECT #:TBD  
TBD  
TBD  
TBD  
CONTACT:TBD  
CELL #:TBD  
EMAIL:TBD



1 VIEW FROM E. JACKSON ST.

SHEET INDEX

SHEET #	SHEET NAME	CURRENT REVISION		
		#	DESCRIPTION	DATE
00 - GENERAL				
G-001	COVER SHEET			
G-101	LIFE SAFETY PLAN	1	2ND FLOOR LAYOUT	8/11/2025
G-501	ACCESSIBILITY GUIDELINES			
G-502	ACCESSIBILITY GUIDELINES			

03 - STRUCTURAL				
S-000	STRUCTURAL NOTES			
S-001	STRUCTURAL NOTES			
S-002	STRUCTURAL NOTES			
S-003	SPECIAL INSPECTIONS			
S-100	FOUNDATION PLAN			
S-200	FRAMING PLAN			
S-201	ROOF FRAMING PLAN			
S-300	TYPICAL CONCRETE DETAILS			
S-301	SLAB ON GRADE FOUNDATION SECTIONS			
S-302	SLAB ON GRADE FOUNDATION SECTIONS			
S-303	CONCRETE REPAIR DETAILS			
S-600	TYPICAL WOOD DETAILS			
S-601	TYPICAL WOOD DETAILS			
S-610	TYPICAL WOOD SHEAR WALL DETAILS			
S-611	TYPICAL WOOD SHEAR WALL DETAILS			
S-612	TYPICAL WOOD SHEAR WALL DETAILS			
S-630	STICK FRAME FLOOR FRAMING DETAILS			
S-650	MONOSLOPE ROOF TRUSS DETAILS			

04A - ARCHITECTURAL SITE				
AS-101	ARCHITECTURAL SITE PLAN			

04B - ARCHITECTURAL DEMOLITION				
AD-101	DEMOLITION FLOOR PLANS			
AD-121	DEMOLITION ROOF PLAN & EXTERIOR ELEVATIONS			

04C - ARCHITECTURAL				
A-101	ARCHITECTURAL FLOOR PLANS	1	2ND FLOOR LAYOUT	8/11/2025
A-111	REFLECTED CEILING PLANS	1	2ND FLOOR LAYOUT	8/11/2025
A-121	ROOF PLAN			
A-131	FINISH PLANS	1	2ND FLOOR LAYOUT	8/11/2025
A-201	EXTERIOR ELEVATIONS	1	2ND FLOOR LAYOUT	8/11/2025
A-221	INTERIOR ELEVATIONS	1	2ND FLOOR LAYOUT	8/11/2025
A-301	BUILDING SECTIONS	1	2ND FLOOR LAYOUT	8/11/2025
A-311	WALL SECTIONS	1	2ND FLOOR LAYOUT	8/11/2025
A-401	ENLARGED PLANS	1	2ND FLOOR LAYOUT	8/11/2025
A-402	ENLARGED PLANS			
A-431	ENLARGED FINISH PLANS			
A-511	DETAILS	1	2ND FLOOR LAYOUT	8/11/2025
A-512	STAIR DETAILS			
A-522	MILLWORK DETAILS			
A-602	INTERIOR PARTITION TYPES	1	2ND FLOOR LAYOUT	8/11/2025
A-611	DOOR SCHEDULES AND DETAILS			
A-631	STOREFRONT & WINDOW SCHEDULE	1	2ND FLOOR LAYOUT	8/11/2025

06 - MECHANICAL				
M-001	MECHANICAL COVER SHEET			
M-002	MECHANICAL DETAILS			
M-003	MECHANICAL SCHEDULES			
M-201	MECHANICAL HVAC PLANS - LEVEL 1			

07 - PLUMBING				
P-001	PLUMBING COVER SHEET			
P-002	PLUMBING DETAILS			
P-003	PLUMBING SCHEDULES			
P-101	PLUMBING DWV PLANS			
P-201	PLUMBING DOMESTIC WATER PLANS			
P-301	PLUMBING RISER DIAGRAMS			

08 - ELECTRICAL				
E-001	ELECTRICAL COVER SHEET			
E-002	ELECTRICAL SPECIFICATIONS			
E-003	ELECTRICAL DETAILS			
E-004	ELECTRICAL ONE-LINES & SCHEDULES			
E-201	ELECTRICAL LIGHTING PLAN			
E-301A	ELECTRICAL POWER PLAN			
E-301B	ELECTRICAL HVAC POWER PLAN			

REQUIREMENTS

**IMPORTANT:**

SHOULD A CONFLICT AND/ OR DISCREPANCY ARISE BETWEEN THE SPECIFICATIONS AND/ OR DRAWINGS, THE HIGHEST QUALITY AND QUANTITY SHALL BE PROVIDED AND INSTALLED.

**IMPORTANT:**

GENERAL CONTRACTOR IS RESPONSIBLE FOR VERIFYING THAT ALL TEXAS DEPARTMENT OF LICENSING AND REGULATION (TDLR), TEXAS ACCESSIBILITY STANDARDS (TAS), AND AMERICANS WITH DISABILITIES ACT (ADA) REQUIREMENTS ARE MET.

**IMPORTANT:**

THE ARCHITECT'S PACKAGE IS INTENDED TO BE VIEWED IN FULL COLOR. WORK INCORRECTLY INSTALLED AS A RESULT OF VIEWING THE DRAWINGS IN GRAYSCALE, SHALL BE THE RESPONSIBILITY OF THE GENERAL CONTRACTOR TO CORRECT.



APPLICABLE CODES & STANDARDS

AUTHORITY HAVING JURISDICTION: BURNET, TEXAS

APPLICABLE CODES:

- 2021 INTERNATIONAL BUILDING CODE WITH AMENDMENTS
- 2015 INTERNATIONAL EXISTING BUILDING CODE WITH AMENDMENTS
- 2015 INTERNATIONAL FIRE CODE WITH AMENDMENTS
- 2021 INTERNATIONAL PLUMBING CODE WITH AMENDMENTS
- 2015 INTERNATIONAL MECHANICAL CODE WITH AMENDMENTS
- 2021 INTERNATIONAL ENERGY CONSERVATION CODE WITH AMENDMENTS
- 2015 NFPA 101 LIFE SAFETY CODE
- 2014 NATIONAL ELECTRICAL CODE WITH AMENDMENTS
- 2012 TEXAS ACCESSIBILITY STANDARDS (TAS/TDLR)

TDLR NUMBER: TBD

USES & CONSTRUCTION TYPES:

USE GROUP(S) AND CONSTRUCTION TYPE(S) PER IBC CHAPTERS 3, 4, 5, AND 6

BASIC OCCUPANCY GROUPS:

BUSINESS (GROUP B)

TYPE OF CONSTRUCTION:

TYPE V: □ A ■ B

BUILDING LIMITS

MAXIMUM BUILDING HEIGHT	40' - 0"
ACTUAL BUILDING HEIGHT	30' - 6"
ALLOWABLE STORIES ABOVE GRADE	2
ACTUAL STORIES ABOVE GRADE	2

MAX. FLOOR AREA:	9,000 SF
ACTUAL FLOOR AREA:	3,875 SF

MIN. FIRE-RESISTIVE REQUIREMENTS:

FIRE-RESISTIVE RATING REQUIREMENTS FOR BUILDING ELEMENTS (PER IBC TABLE 601):

TYPE OF CONSTRUCTION	V-B	ADDITIONAL FIRE-RESISTIVE RATINGS:
BUILDING ELEMENT	REQ'D RTG (HRS)	BUILDING ELEMENT REQ'D RTG (HRS)
PRIMARY STRUCTURAL FRAME	0	SHAFT ENCLOSURES (IBC 713.4)
EXTERIOR BEARING WALLS	0	<4 STORIES 1
INTERIOR BEARING WALLS	0	EXIT ENCLOSURES (IBC 1023.2)
EXTERIOR NON-BEARING WALLS	0	<4 STORIES 1
INTERIOR NON-BEARING WALLS	0	EXIT PASSAGEWAYS (IBC 1024.3) 1
FLOOR CONSTRUCTION	0	
ROOF CONSTRUCTION	0	

OCCUPANCY	OCCUPANT LOAD SERVED	REQ'D RATING (HRS)
B	>30	1

SERVER ROOM CEILING (CLG-03): 1 HR FIRE RATED, UL P522 ROOF - CEILING ASSEMBLY  
SERVER ROOM FLOORING: 1 HR RATED, UL L521 FLOOR- CEILING ASSEMBLY

MEANS OF EGRESS SIZING:

BUILDING ELEMENT	MINIMUM REQUIRED EGRESS WIDTH
STAIRWAYS	0.3
OTHER EGRESS COMPONENTS	0.2

OCCUPANCY	MAXIMUM COMMON PATH OF TRAVEL (IBC TABLE 1006.2.1)	EXIT ACCESS TRAVEL DISTANCE (IBC TABLE 1017.2)	DEAD END CORRIDOR LENGTH (IBC 1020.5)
B	75'	200'	20'

PROJECT GENERAL NOTES

- THE PURPOSE OF THE LIFE SAFETY PLANS IS TO ILLUSTRATE IN A SCHEMATIC FASHION, THE APPLICABLE EXITING, FIRE-RESISTANCE, AND LIFE SAFETY CONCEPTS UTILIZED BY THIS PROJECT, INCLUDING, BUT NOT LIMITED TO:
  - OCCUPANCY CLASSIFICATIONS
  - OCCUPANCY LOAD FACTORS
  - EXIT LOCATIONS, EXIT PATHS & CAPACITY
  - FUNCTION OF SPACE
  - FIRE-RESISTANCE RATED CONSTRUCTION
  - AND OTHER STRATEGIES RELATED TO THE CODE COMPLIANCE APPROACH OF THIS PROJECT.
- ADDITIONAL DETAILED REQUIREMENTS APPLY TO THE CONSTRUCTION OF PARTITIONS, FIRE RATED DOOR ASSEMBLIES, INTERIOR GLAZED OPENINGS, DUCTS, SMOKE AND FIRE DAMPERS AND THROUGH-PENETRATION FIRE STOPPING, IF APPLICABLE. REFER TO THE DRAWINGS OF EACH DISCIPLINE FOR THESE REQUIREMENTS.
- ADDITIONAL DETAILED REQUIREMENTS SHOWN ELSEWHERE MAY REQUIRE CONSTRUCTION HAVING GREATER FIRE RATINGS, MORE EXTENSIVE FIRE-RATED CONSTRUCTION, OR MORE COMPLEX ASSEMBLIES THAN INDICATED. WHEN PROVIDED, THE ADDITIONAL DETAILED REQUIREMENTS SHALL GOVERN.
- FIRE BARRIERS SHALL EXTEND FROM THE TOP OF THE FOUNDATION OR FLOOR/CEILING ASSEMBLY BELOW TO THE UNDERSIDE OF THE FLOOR OR ROOF SHEATHING, SLAB OR DECK ABOVE AND SHALL BE SECURELY ATTACHED THERETO. SUCH FIRE BARRIERS SHALL BE CONTINUOUS THROUGH CONCEALED SPACES.
- SHAFT ENCLOSURES SHALL BE CONSTRUCTED AS FIRE BARRIERS.
- FIRE PARTITIONS SHALL EXTEND FROM THE TOP OF THE FOUNDATION OR FLOOR/CEILING ASSEMBLY BELOW TO THE UNDERSIDE OF THE FLOOR OR ROOF SHEATHING, SLAB OR DECK ABOVE OR TO THE FIRE-RESISTANCE-RATED FLOOR/CEILING OR ROOF/CEILING ASSEMBLY ABOVE, AND SHALL BE SECURELY ATTACHED THERETO.
- SMOKE BARRIERS SHALL FORM AN EFFECTIVE MEMBRANE CONTINUOUS FROM OUTSIDE WALL TO OUTSIDE WALL AND FROM THE TOP OF THE FOUNDATION OR FLOOR/CEILING ASSEMBLY BELOW TO THE UNDERSIDE OF THE FLOOR OR ROOF SHEATHING, DECK OR SLAB ABOVE, INCLUDING CONTINUITY THROUGH CONCEALED SPACES.
- SMOKE PARTITIONS SHALL EXTEND FROM THE TOP OF THE FOUNDATION OR FLOOR BELOW TO THE UNDERSIDE OF THE FLOOR OR ROOF SHEATHING, DECK OR SLAB ABOVE OR TO THE UNDERSIDE OF THE CEILING ABOVE WHERE THE CEILING MEMBRANE IS CONSTRUCTED TO LIMIT THE TRANSFER OF SMOKE.
- DIRECTIONAL SIGNAGE SHALL BE PROVIDED AT EACH ELEVATOR LANDING THAT STATES "IN FIRE EMERGENCY, DO NOT USE THE ELEVATOR, USE THE STAIRS".
- INTERIOR WALL & CEILING FINISHES SHALL HAVE A FLAME SPREAD INDEX RATING OF NO MORE THAN CLASS 'B' AT VERTICAL EXITS & EXIT PASSAGEWAYS, EXIT ACCESS CORRIDORS, AND OTHER EXIT WAYS.
- INTERIOR WALL & CEILING FINISHES SHALL HAVE A FLAME SPREAD INDEX RATING OF NO MORE THAN CLASS 'C' AT ROOMS AND ENCLOSED SPACES.
- ALL MATERIALS EXPOSED WITHIN DUCTS OR PLENUMS SHALL HAVE A FLAME SPREAD INDEX RATING OF NOT MORE THAN 25 AND A SMOKE DEVELOPED RATING OF NOT MORE THAN 50.
- FIRE EXTINGUISHERS SHALL BE LOCATED SUCH THAT TRAVEL DISTANCE TO AN EXTINGUISHER SHALL NOT EXCEED 75' (WHERE REQUIRED BY CODE).
- LEVEL / AREA MAIN OCCUPANCY EXIT SIGN LOCATIONS MAY NOT BE SHOWN ON THIS SHEET. REFERENCE ELECTRICAL SHEETS FOR ALL EXIT SIGN LOCATIONS.
- FIRE RESISTIVE ASSEMBLY DETAILS, IF APPLICABLE, ARE LOCATED ELSEWHERE IN THIS DRAWING SET. REFERENCE THE SHEET INDEX.
- ELEVATOR HOISTWAY OPENINGS SHALL BE PROTECTED AS REQUIRED BY CODE, CORRESPONDING TO THE RATING OF THE HOISTWAY.
- EVERY ROOM / SPACE WITH AN ASSEMBLY OCCUPANCY SHALL HAVE THE OCCUPANT LOAD POSTED IN A CONSPICUOUS SPACE.
- EACH PARTITION SHOWN ON THE DRAWINGS TO HAVE A FIRE AND/OR SMOKE RESISTANCE RATING SHALL BE IDENTIFIED AS SUCH WITH A LABEL ABOVE THE CEILING ON EACH SEGMENT OF THE WALL AND 6' - 0" MAX. EACH SIDE.

LIFE SAFETY LEGEND:

□ ITEM NOT SELECTED

■ ITEM SELECTED

ROOM NAME

101

OCCUPANCY

150 SF

22

# OF OCCUPANTS

1-HR FIRE RATED WALL

2-HR FIRE RATED WALL

(EATD) EXIT ACCESS TRAVEL DISTANCE

(CPET) COMMON PATH OF EGRESS TRAVEL DISTANCE

(DECL) DEAD END CORRIDOR LENGTH

F.E.C. #

F.E. #

F.A.C.P.

KNOX

69

123

24"

12"

FIRE EXTINGUISHER CABINET

FIRE EXTINGUISHER

FIRE ALARM/STROBE

FIRE PULL

FIRE ACCESS CONTROL PANEL

KNOX BOX

EXIT SIGN

SMOKE DETECTOR

# OF PEOPLE EGRESSING THROUGH DOOR

REQUIRED EGRESS WIDTH

ACTUAL EGRESS WIDTH


OCCUPANCY LOAD

OCCUPANCY TYPE	AREA	OCCUPANT LOAD FACTOR	OCCUPANCY
01 FIRST FLOOR			
BUSINESS	1,940 SF	100 SF	20
02 SECOND FLOOR			
BUSINESS	1,935 SF	100 SF	20

REQUIRED PLUMBING FIXTURES

FLOOR	CLASSIFICATION	OCCUPANCY LOAD	WATER CLOSETS MEN	WATER CLOSETS WOMEN	LAVATORIES MEN	LAVATORIES WOMEN	DRINKING FOUNTAINS	SERVICE SINKS
1ST FLOOR	BUSINESS	20	.4	.4	.25	.25	.2	1
2ND FLOOR	STORAGE	4	.02	.02	.02	.02	0.004	0*
TOTAL		24	1	1	1	1	1**	1


\*Per IBC 2015 Table 1004.1.2 and IPC 2015 Table 403.1  
\*\*SEEKING ALTERNATE COMPLIANCE METHOD OF: TENANT STAFF TO UTILIZE EXISTING DRINKING FOUNTAINS IN CURRENT ANNEX OFFICE (WITHIN 500 FEET PER 2015 IPC) AND OWNER TO PROVIDE BOTTLED WATER TO THE PUBLIC. SEE LETTER EXHIBIT.

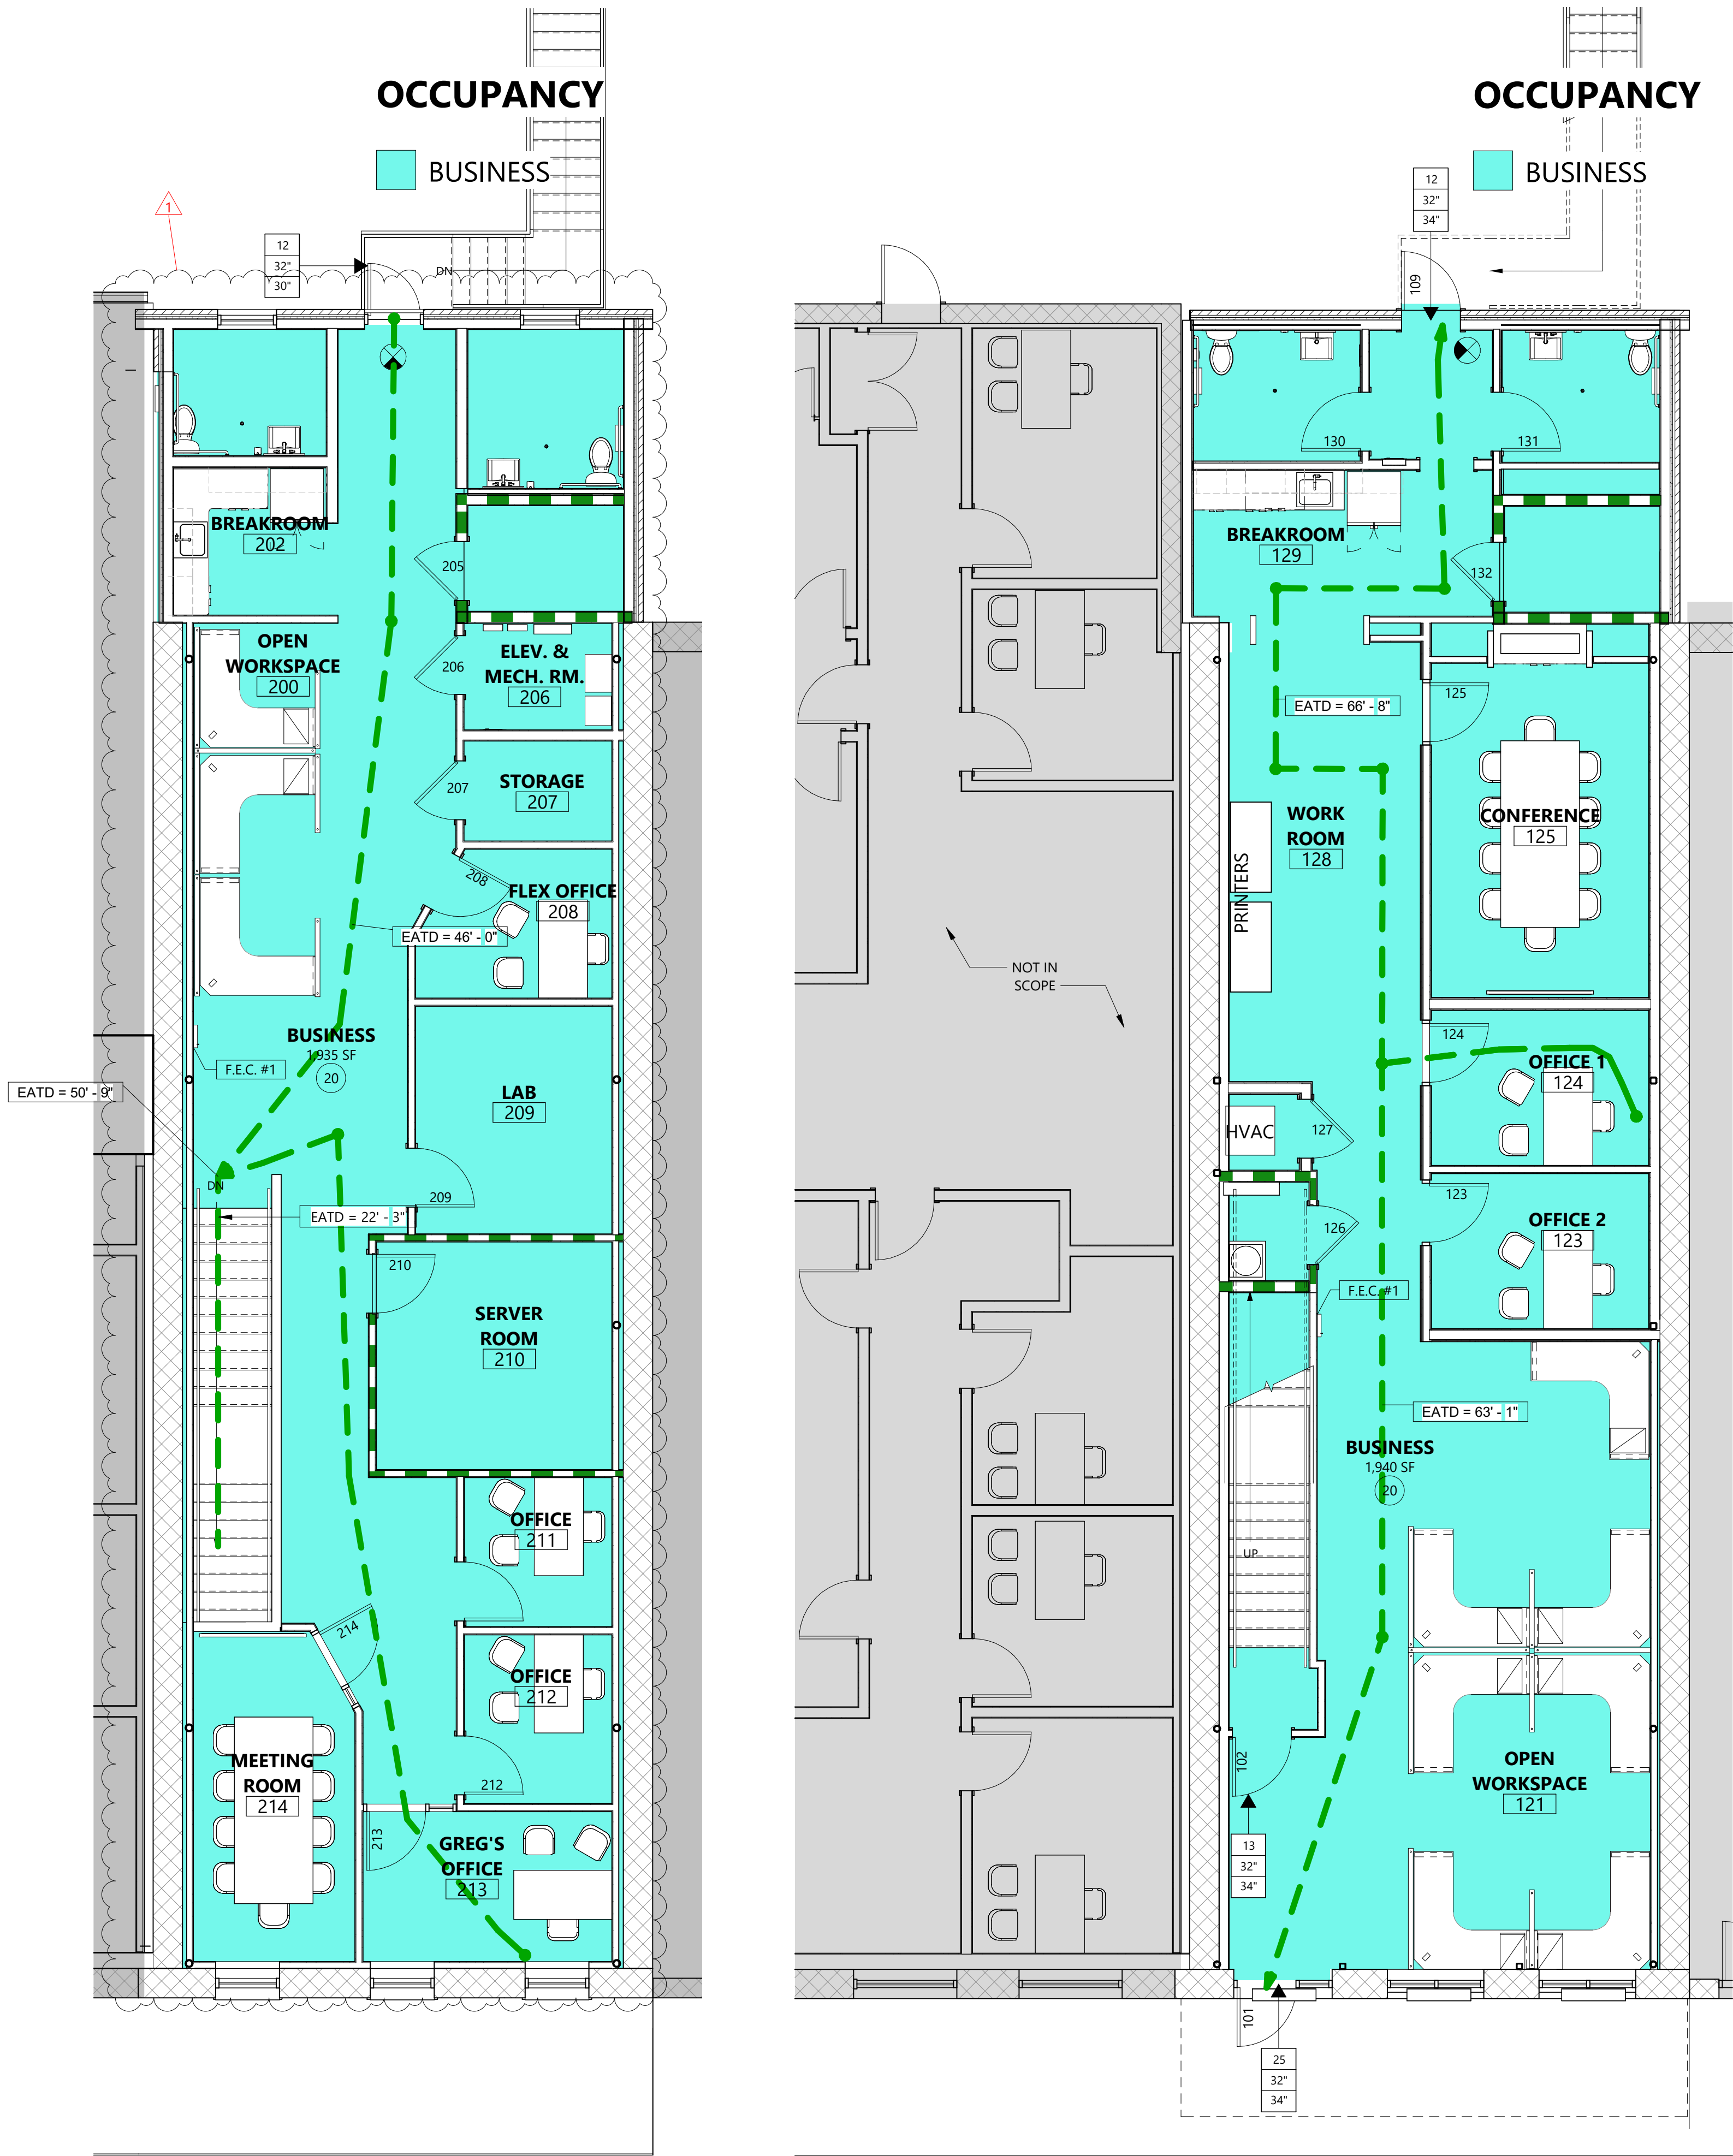


2 LIFE SAFETY PLAN - SECOND FLOOR  
SCALE: 3/16" = 1'-0"

1 LIFE SAFETY PLAN - FIRST FLOOR  
SCALE: 3/16" = 1'-0"



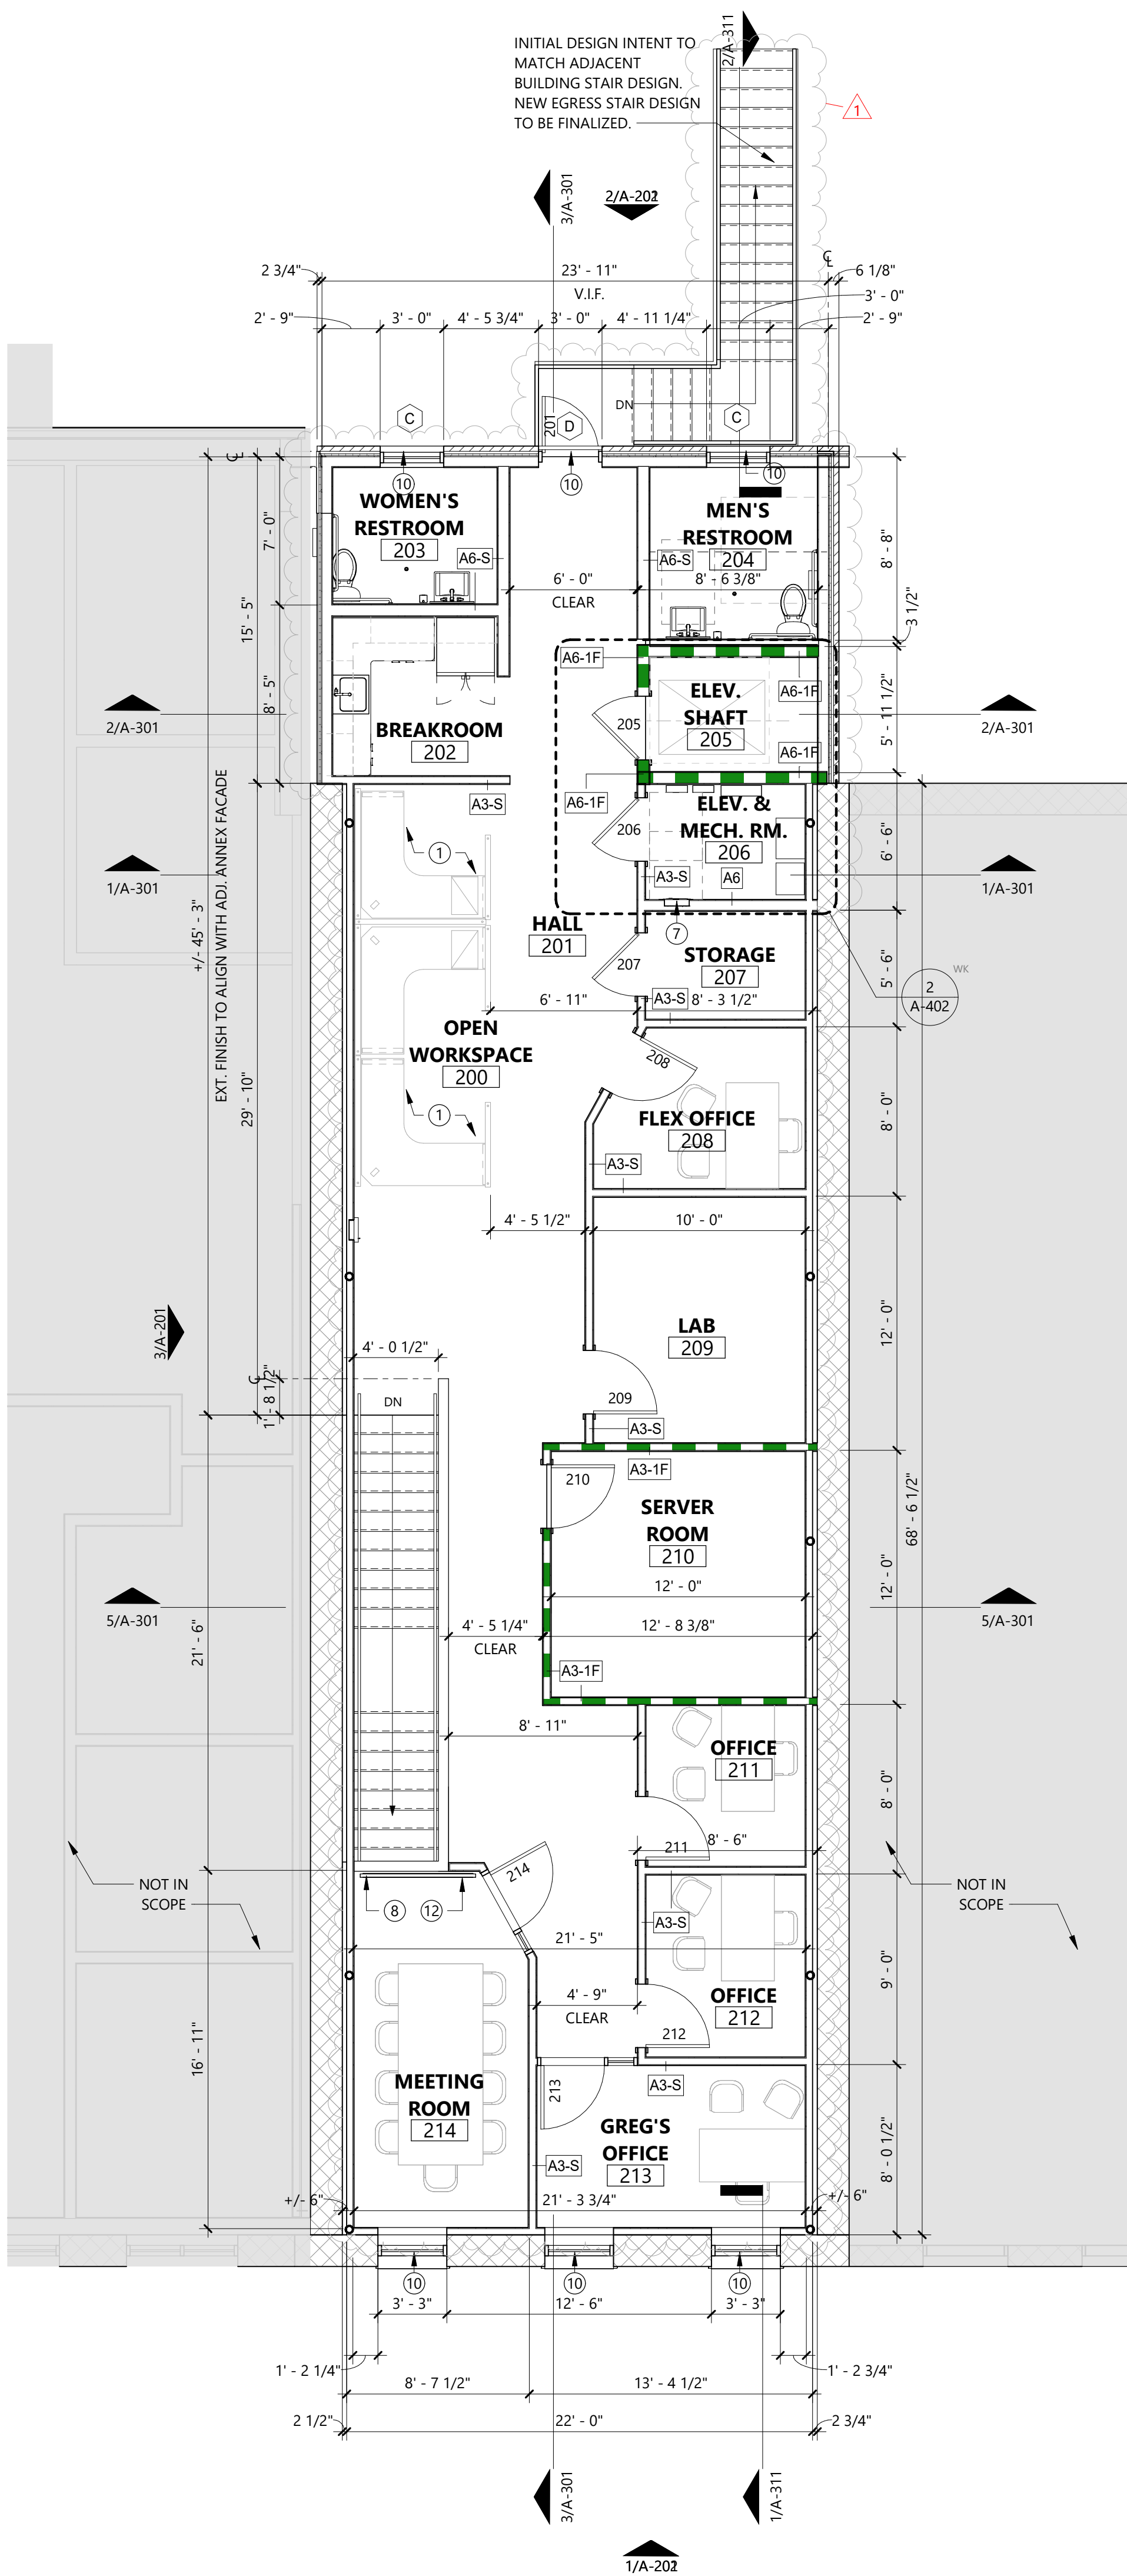

2 ARCHITECTURAL FLOOR PLAN - SECOND FLOOR  
SCALE: 3/16" = 1'-0"

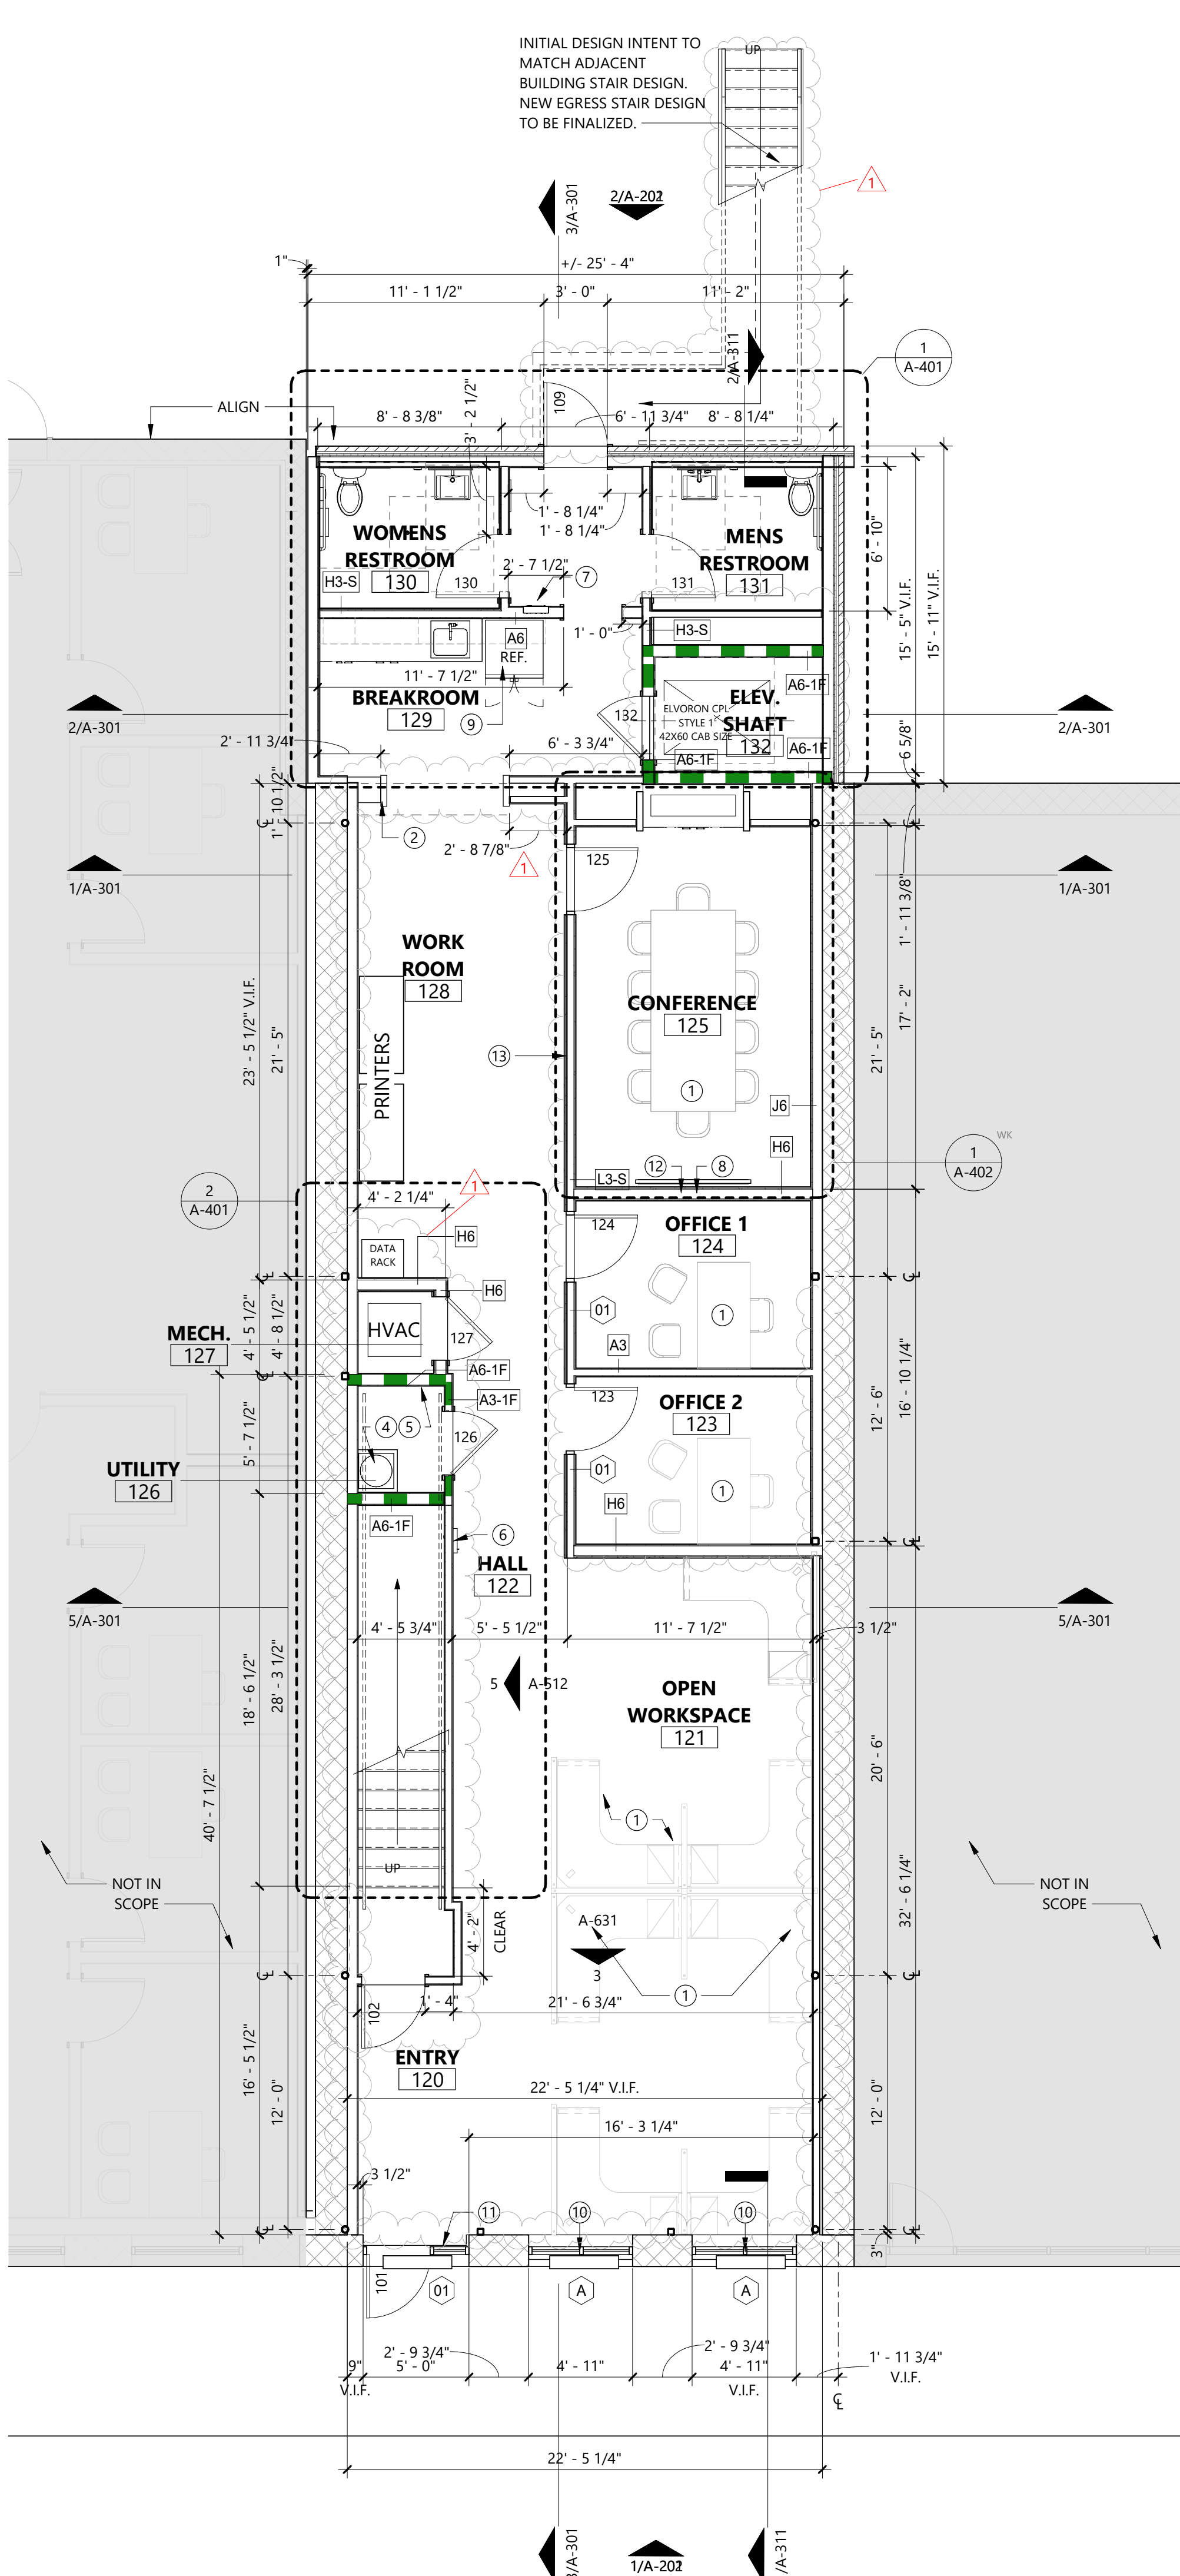

1 ARCHITECTURAL FLOOR PLAN - FIRST FLOOR  
SCALE: 3/16" = 1'-0"


## GENERAL NOTES:

- REFER TO SHEET A-602 FOR INTERIOR PARTITION TYPES.
- REFER TO SHEET A-611 FOR DOOR SCHEDULE
- REFER TO SHEET A-631 FOR WINDOW SCHEDULE
- REFER TO SHEET G-601 FOR FINISH SCHEDULE.
- REF. MEP FOR ITEMS REQUIRED BUT NOT SHOWN ON ARCHITECTURAL DRAWINGS, PROVIDE LOCKABLE ACCESS PANELS AT ALL LOCATIONS INDICATED AS NEEDING ACCESS ON MEP DRAWINGS. PROVIDE NECESSARY BLOCKING, FRAMING, ETC. FOR ACCESS PANELS.
- DO NOT CUT ANY STRUCTURAL ELEMENT IN A MANNER THAT WILL DIMINISH THEIR LOAD-BEARING CAPACITY. NOTIFY STRUCTURAL ENGINEER AND DO NOT PROCEED WITH ANY STRUCTURAL CUT WITHOUT THEIR WRITTEN APPROVAL.
- EXTERIOR WALLS ARE DIMENSIONED TO EXTERIOR FACE OF STUD OR EDGE OF SLAB. ALL EXISTING WALLS ARE DIMENSIONED TO FAC OF FINISH. VERIFY ALL EXISTING WALL AND WINDOW DIMENSIONS IN FIELD PRIOR TO CONSTRUCTION.
- EXTERIOR WALLS (ABOVE GRADE) SHALL ACHIEVE A MINIMUM OF R-20 THERMAL ENVELOPE INSULATION COMPONENT REQUIREMENTS (2015 IECC TABLE C402.1.3).
- EXTERIOR OPENING DIMENSIONS ARE TO THE ROUGH OPENING.
- INTERIOR PARTITIONS ARE DIMENSIONED TO THE FACE OF STUD AND DO NOT INCLUDE WALL FINISHES.
- INSTALL VERTICAL CONTROL JOINTS IN GYP. BD. WHERE WALL LENGTH EXCEEDS 30 FEET. AT EACH SIDES OF OPENINGS THAT DO NOT TERMINATE AT A CEILING, AT OTHER LOCATIONS INDICATED, AND IN ACCORDANCE WITH GA-216.
- DOOR JAMBS TO BE 6" FROM ADJACENT WALL.
- PROVIDE A MINIMUM OF 18" CLEAR FLOOR SPACE BETWEEN THE FACE OF THE STRIKE JAMB OF DOORS ADJACENT TO PERPENDICULAR WALLS. THIS REQUIREMENT DOES NOT APPLY TO NON-ACCESSIBLE TOILET STALLS.
- FINISH FLOOR ELEVATIONS NOTED ARE TAKEN FROM THE TOP OF STRUCTURAL CONCRETE. REF. FINISH PLANS FOR EXTENT OF SPECIAL FINISHES AND FLOOR FINISH PATTERNS.
- PROVIDE APPROPRIATE FIRESTOPPING ASSEMBLIES AT ALL PENETRATIONS OF RATED WALL AND FLOOR ASSEMBLIES.
- PROVIDE FIRE RETARDANT BLOCKING IN WALL AS REQUIRED FOR WALL MOUNTED TOILET FIXTURES, ACCESSORIES, CASEWORK / MILLWORK, SHELVING, EQUIPMENT AND SIGNAGE. ALL WOOD BLOCKING CONCEALED WITHIN THE BUILDING CONSTRUCTION SHALL BE FIRE RETARDANT.
- PROVIDE AND INSTALL 8' HIGH FIRE-RETARDANT PLYWOOD ON ALL WALLS IN THE MDF, IDF, AND ELECTRICAL ROOMS, U.N.O.


## SHEET NOTES:

- FURNITURE BY OWNER
- NEW WOOD FRAMED CASED OPENING, SEE FINISH SCHEDULE
- RESTORE MASONRY FACADE: REMOVE EXISTING PLASTER AND PAINT. TUCK POINT MASONRY FOR STRUCTURAL INTEGRITY AS REQUIRED
- WATER HEATER OVER MOP SINK, REF: PLUMBING
- BOBRICK B-239 UTILITY SHELF WITH RAG HOOKS AND BROOM HOLDERS
- SEMI-RECESSED FIRE EXTINGUISHER CABINET, JL INDUSTRIES AMBASSADOR 1017V10
- ELECTRICAL PANEL, REF: ELECTRICAL
- TV BY OWNER, CONFIRM LOCATION AND MOUNTING HEIGHT WITH OWNER AND ARCHITECT BEFORE INSTALLATION
- REFRIGERATOR BY OWNER
- NEW WINDOWS, REF A-631
- NEW FRONT DOOR AND WINDOWS, REF A-631
- OFFSET OUTLETS TO PREVENT SOUND LEAKS
- EXTEND ALL CONFERENCE ROOM WALLS TO UNDERSIDE OF FLOOR DECK ABOVE. WALLS MUST REACH MINIMUM STC 50.



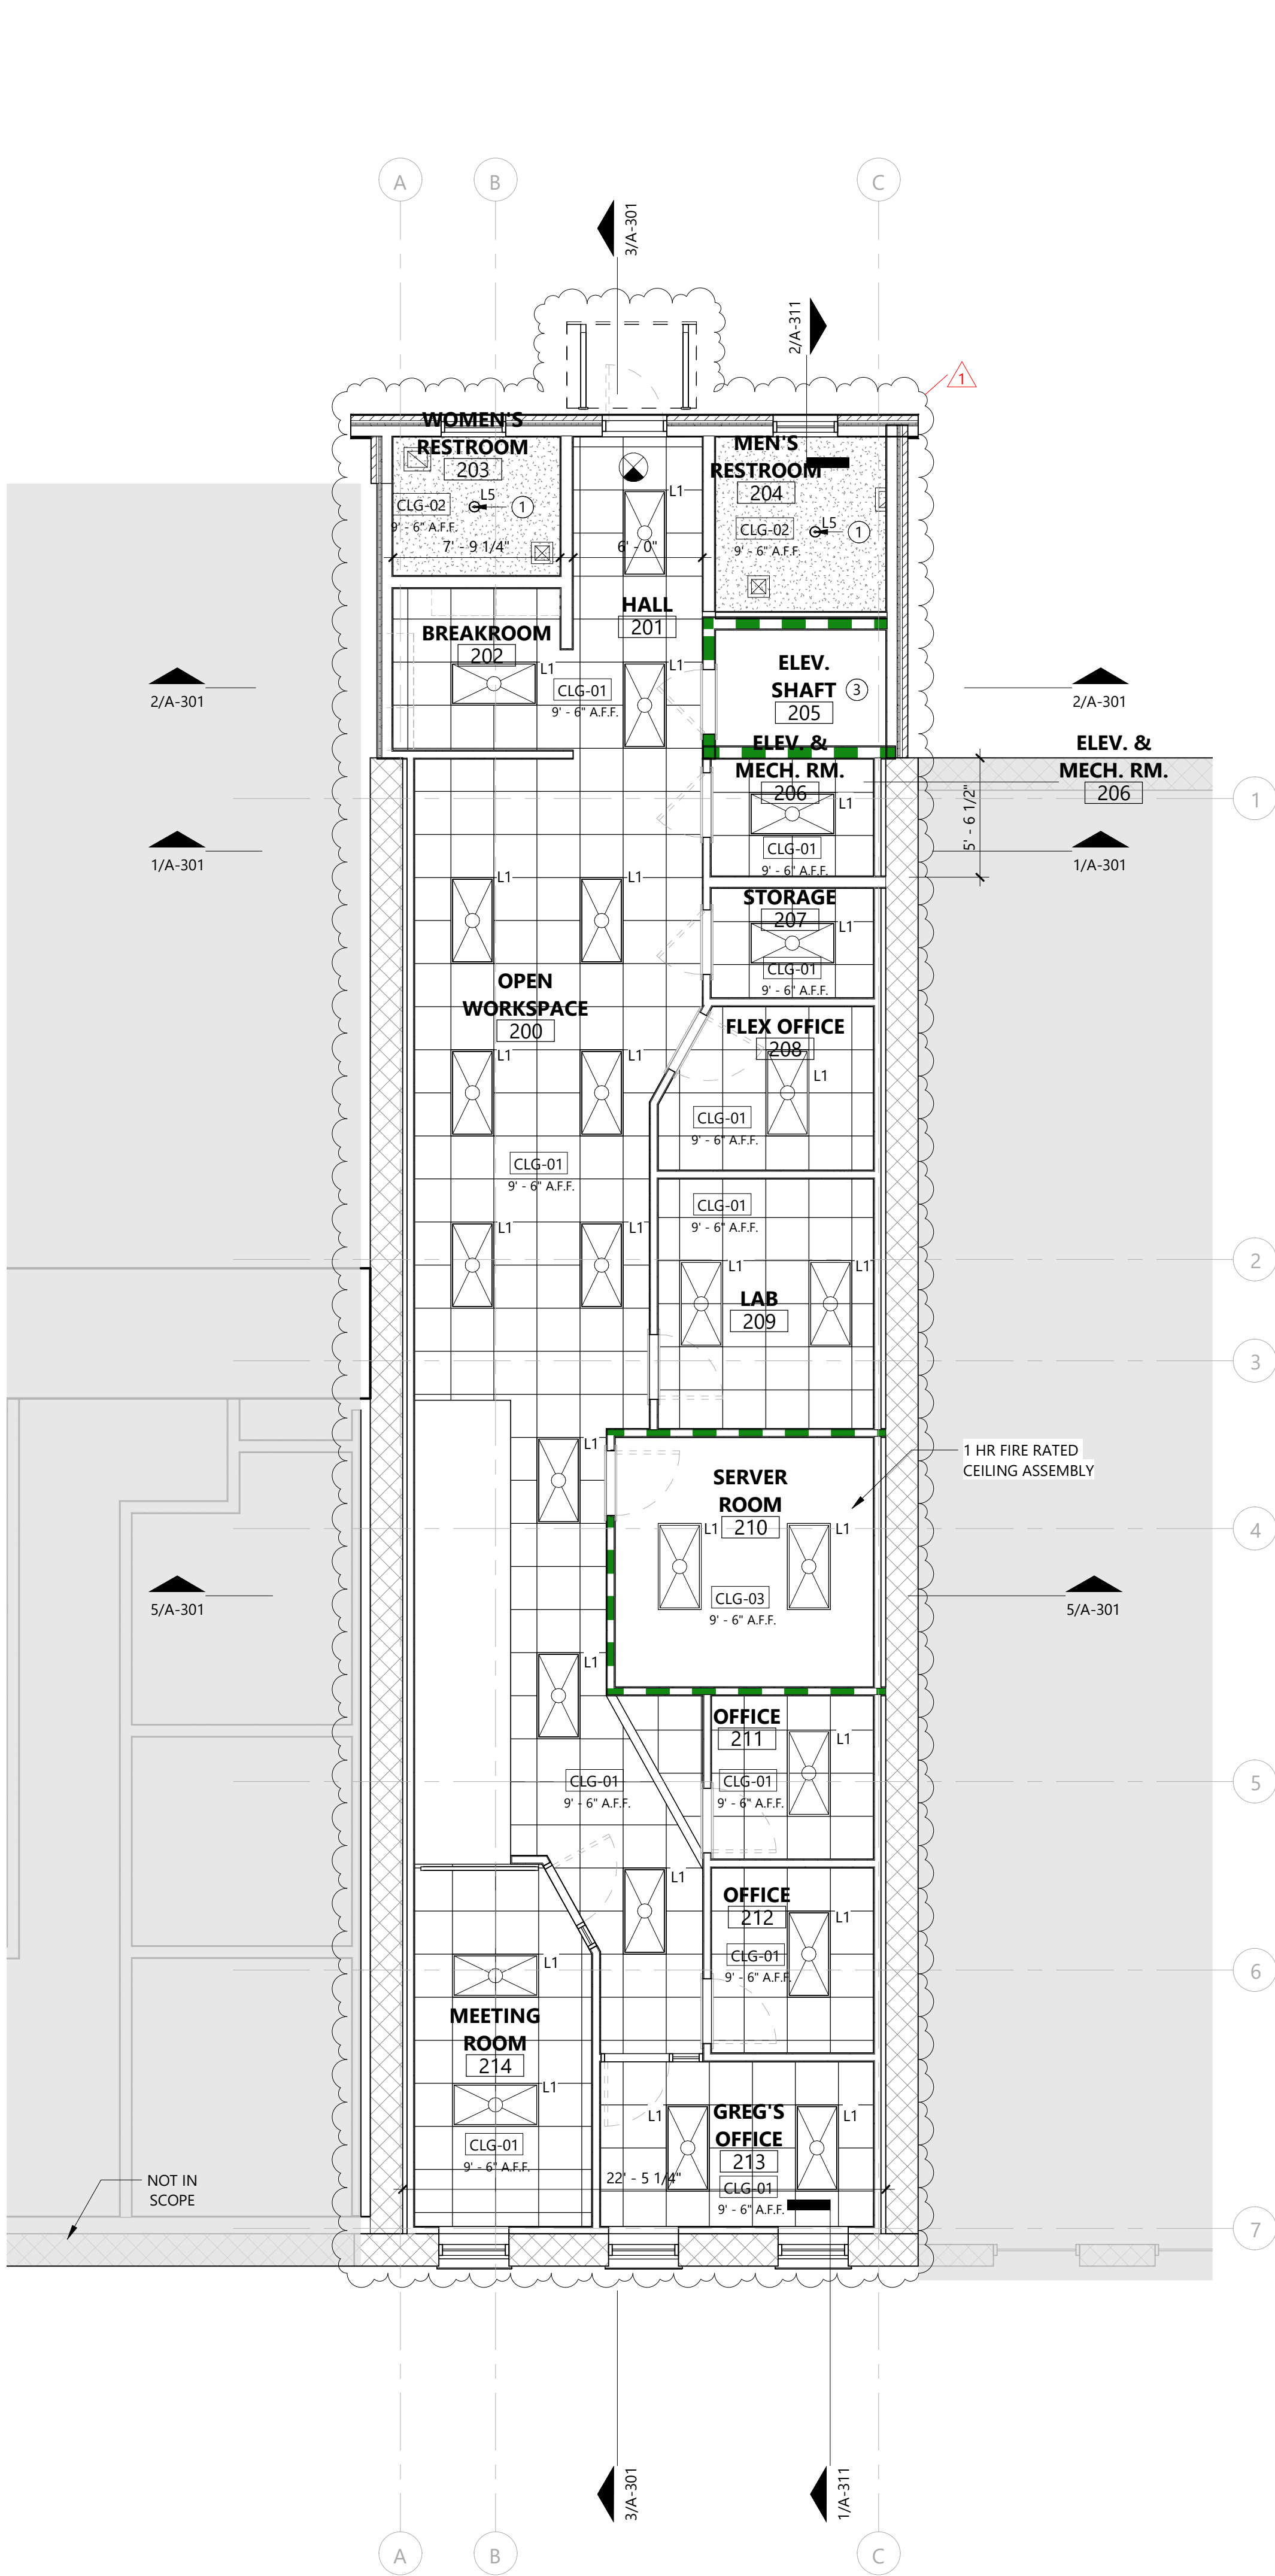

2 ARCHITECTURAL REFLECTED CEILING PLAN - SECOND FLOOR  
SCALE: 3/16" = 1'-0"

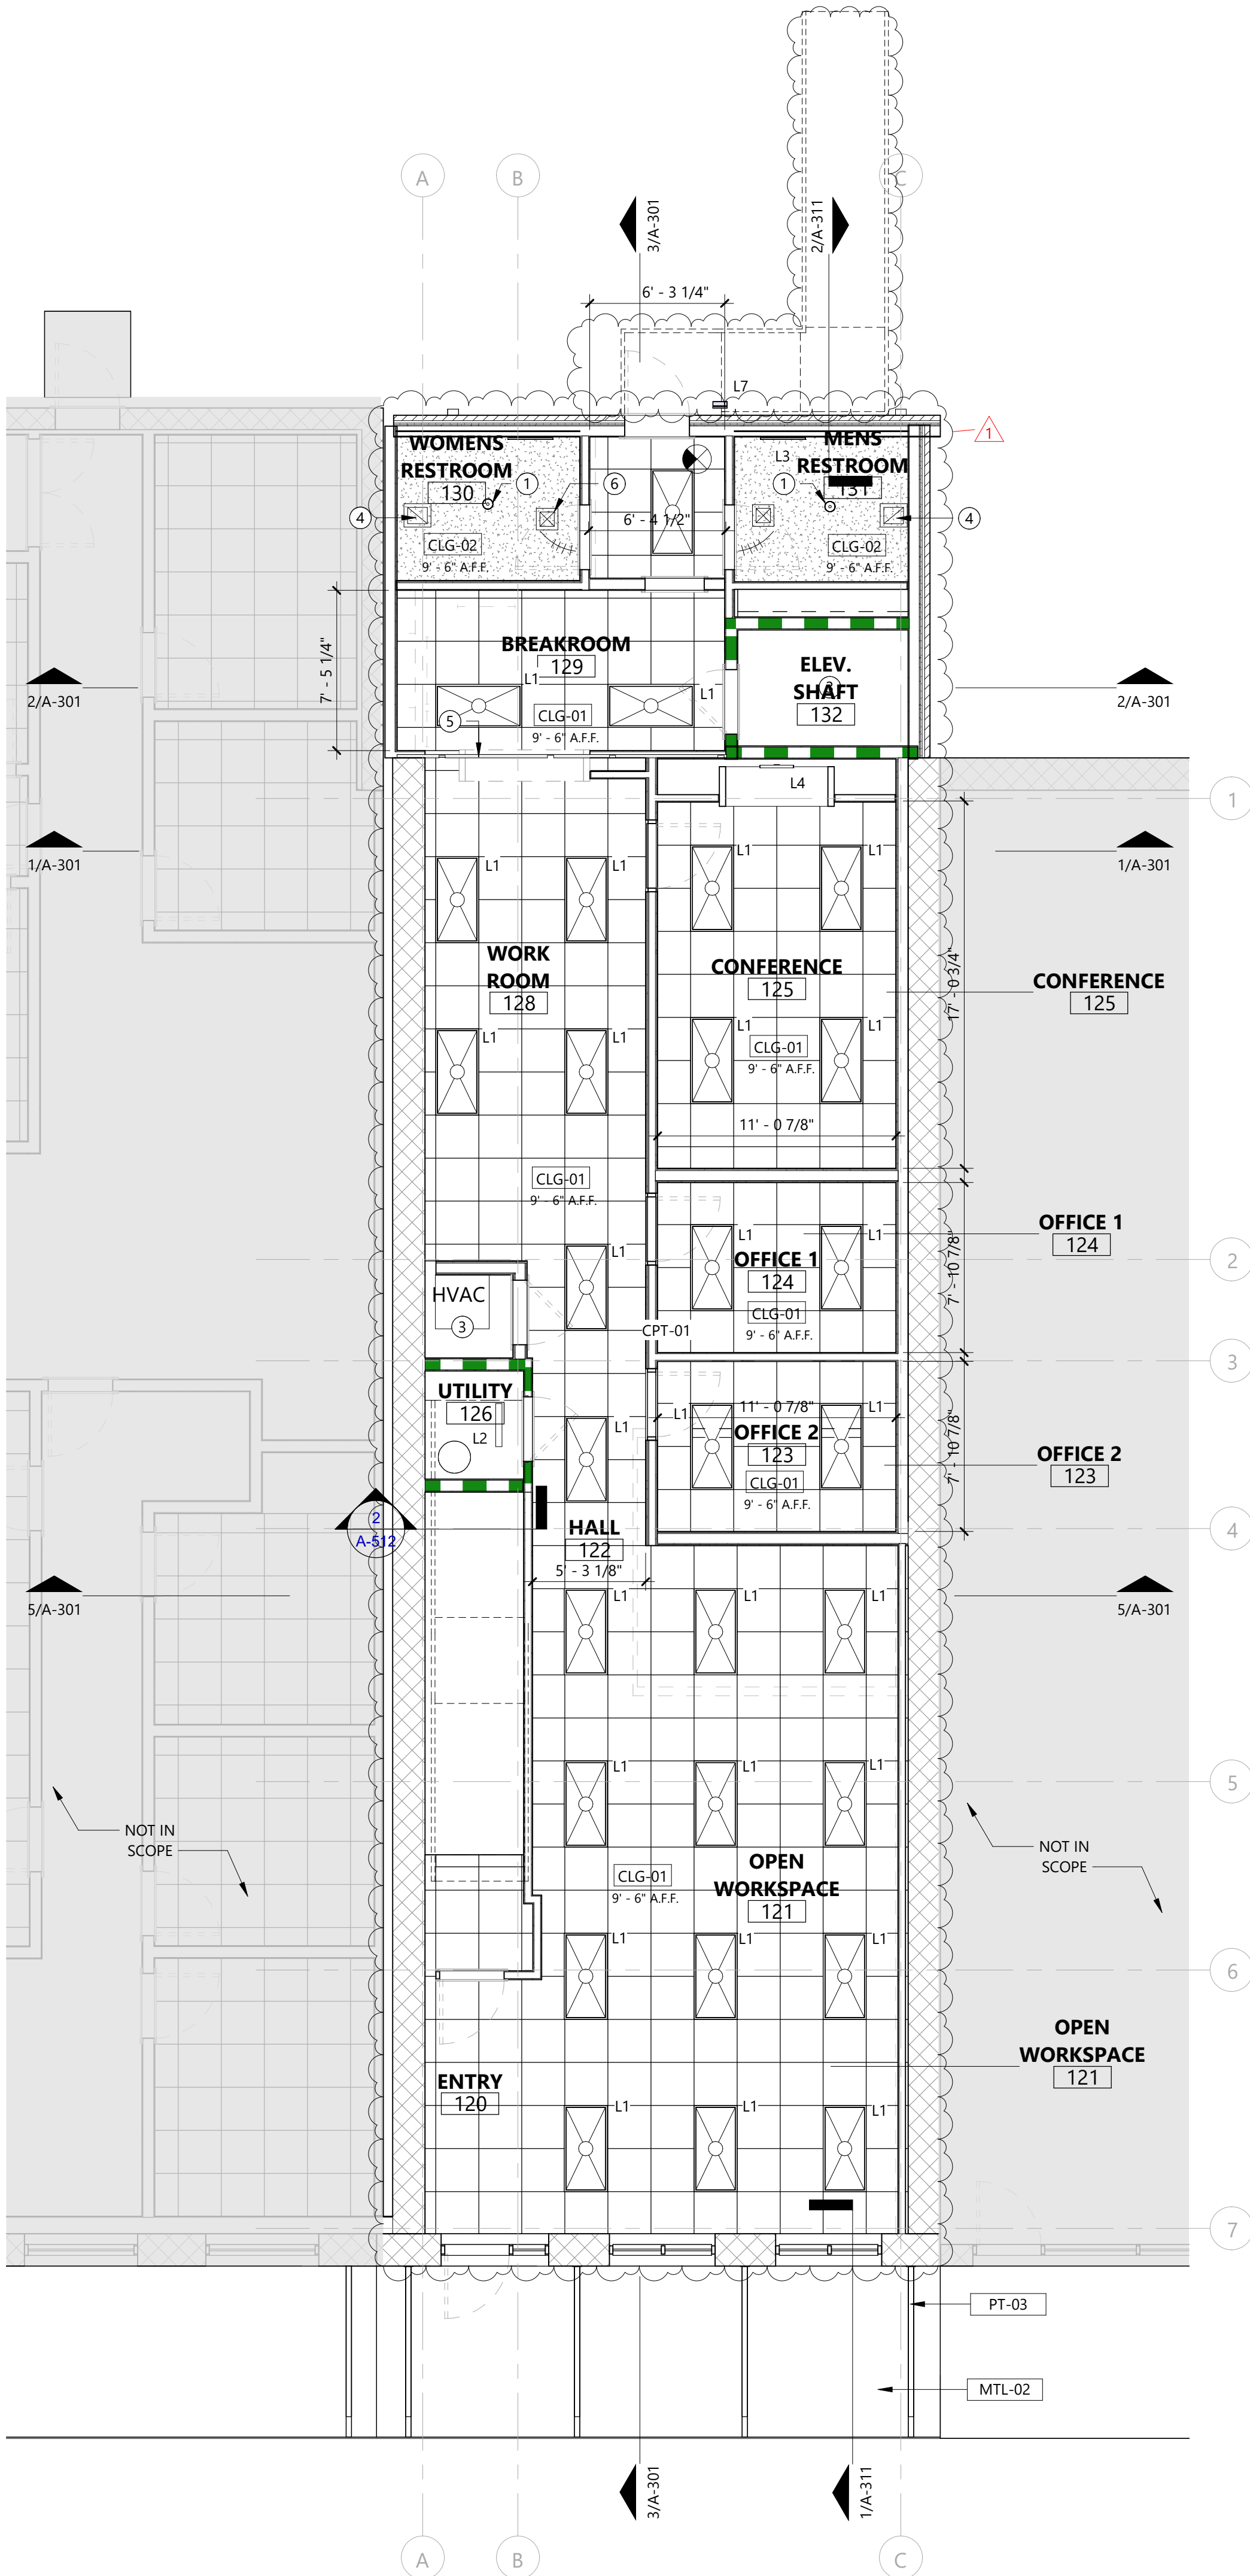

1 ARCHITECTURAL REFLECTED CEILING PLAN - FIRST FLOOR  
SCALE: 3/16" = 1'-0"

## GENERAL NOTES:

- 1 ARCHITECTURAL REFLECTED CEILING PLAN(S) AND ELECTRICAL PLAN(S) SHALL BE CONSIDERED AS ONE. ANY DISCREPANCIES BETWEEN THE TWO DISCIPLINES SHALL BE PRICED / BID BASED ON THE PLAN WITH THE HIGHEST QUANTITY AND / OR QUALITY.
- 2 PRIOR TO ROUGH-IN, CONTRACTOR TO COORDINATE WITH ARCHITECT SPECIFIC LOCATIONS OF ALL WALL- AND CEILING-MOUNTED MECHANICAL, ELECTRICAL, PLUMBING, LIFE SAFETY, SECURITY AND AUDIO VISUAL DEVICES.
- 3 REF. MEP FOR DESIGN OF THESE SYSTEMS (HVAC, CIRCUITING, LIGHTING, SPRINKLERS, ETC.)
- 4 VERIFY FIELD CONDITIONS AND LOCATIONS OF ALL PLUMBING, DUCTS, STRUCTURAL ELEMENTS, AND OTHER APPLICABLE ITEMS. ARRANGE AND MODIFY NON-VIABLE ITEMS TO ENSURE ADEQUATE CLEARANCE FOR CEILING LAYOUT AS SHOWN.
- 5 PROVIDE UNISTRUT METAL FRAMING SYSTEM AND CHAIN SECURED TO STEEL STRUCTURE AS REQUIRED FOR CEILING MOUNTED LIGHTING, FIRE ALARM DEVICES AND EQUIPMENT IN AREAS WHERE FINISHED CEILING IS EXPOSED (OPEN TO STRUCTURE).
- 6 CEILINGS AND OTHER SUSPENDED ITEMS SHALL BE ATTACHED TO STRUCTURE BY FULLY EMBEDDED OR 'SHEAR' CONNECTION. PULL OUT CONNECTIONS ARE NOT ACCEPTABLE.
- 7 MEASURE EACH CEILING AREA AND ESTABLISH LAYOUT OF ACT TO BALANCE BORDER WIDTHS AT OPPOSITE SIDES OF THE ROOM. BORDER WIDTHS SHOULD BE > 1/2" TILE, U.N.O.
- 8 ALL GYB. BD. CEILINGS SHALL BE 5/8" TYPE 'X' GYPSUM BOARD ON SUSPENDED LIGHT-GAUGE FRAMING PER THE SPECIFICATIONS.
- 9 REFER TO ELECTRICAL DRAWINGS FOR LIGHTING AND LIFE SAFETY EQUIPMENT
- 10 LIGHT FIXTURES AND DEVICES TO BE CENTERED AS INDICATED.
- 11 ALL LIGHT SWITCHES SHALL BE LOCATED 48" TO CENTERLINE ABOVE FINISH FLOOR AND BE LOCATED 6" FROM STRIKE SIDE OF DOOR, U.N.O. COORDINATE WITH ELECTRICAL DRAWINGS.
- 12 ALL THERMOSTATS SHALL BE LOCATED 48" TO CENTERLINE ABOVE FINISH FLOOR. QUANTITY AND APPROXIMATE LOCATION OF THERMOSTATS SHALL BE DETERMINED BY MECHANICAL ENGINEER. LOCATIONS SHALL BE SUBMITTED TO ARCHITECT FOR REVIEW AND APPROVAL PRIOR TO INSTALLATION. WHERE LIGHT SWITCHES AND THERMOSTATS ARE ADJACENT, INSTALL BOTH ALIGNED HORIZONTALLY AT CENTERLINE. COORDINATE WITH MECHANICAL ENGINEER
- 13 FIRE SPRINKLER CONTRACTOR SHALL REFERENCE ALL DRAWINGS AND SPECIFICATIONS TO DETERMINE PROPER COVERAGE AND SPRINKLER HEAD LAYOUT / DESIGN.
- 14 FINAL SPRINKLER HEAD LOCATIONS SHALL BE SET BY ENGINEER AND COORDINATED WITH ARCHITECT. CENTER HEADS IN ACOUSTICAL TILE OR CEILING PANELS, U.N.O.
- 15 PROVIDE CONTINUOUS SOUND BATT INSULATION ABOVE ALL TOILET ROOM CEILINGS.
- 16 CEILING / SOFFIT HEIGHTS ARE NOTED ON THE REFLECTED CEILING PLANS. HEIGHTS ARE ABOVE FINISH FLOOR.
- 17 REF. INTERIOR ELEVATIONS FOR ADDITIONAL INFORMATION ABOUT CEILING HEIGHTS, MATERIALS, AND SPECIAL CONDITIONS.
- 18 ALL GYP. BD. CEILINGS AND SOFFITS TO BE PT-01, U.N.O. REF. DETAILS FOR ADDITIONAL INFORMATION.
- 19 EXPOSED (OPEN TO STRUCTURE) SURFACES TO BE PAINTED AS SCHEDULED.

## SHEET NOTES:

- 1 CENTER LIGHT IN CEILING
- 1 FURNITURE BY OWNER
- 3 NO CEILING. OPEN TO STRUCTURE ABOVE
- 4 PROVIDE BATT INSULATION ABOVE CEILING
- 5 INTERIOR WALL-TO-CEILING TRANSITION, REF: TRANSITION SCHEDULE
- 6 REF: MEP FOR DUCT RUNS, SIZING, AND REGISTER LOCATIONS

## TRANSITIONS SCHEDULE


### EXPANSION JOINTS AND INTERIOR TRANSITIONS

<b>EXTERIOR</b>	
ROOF EXPANSION JOINT:	INPRO 672 SERIES (G01) ROOF TO ROOF
WALL-TO-WALL	1200 SERIES FOAM SEAL
<b>INTERIOR</b>	
WALL-TO-WALL	INPRO 101 SERIES RECESS MOUNT A07 (A09 PER WALL TO CORNER CONDITION)
WALL-TO-CEILING	INPRO 101 SERIES RECESS MOUNT A09
FLOOR-TO-FLOOR	INPRO 105 SERIES SURFACE MOUNT A01
FLOOR-TO-WALL	INPRO 105 SERIES SURFACE MOUNT A02


## RCP LEGEND:

- LAY-IN ACT CLG.
- GYB BOARD CLG.
- L1 - 2x4 TROFFER LIGHT
- L2 - WALL-MOUNTED LINEAR STRIP LIGHT
- L3 - LED VANITY WALL SCONCE
- L4 - LED WALL SCONCE
- L5 - 6" RECESSED CAN LIGHT
- L7 - EXTERIOR LIGHT



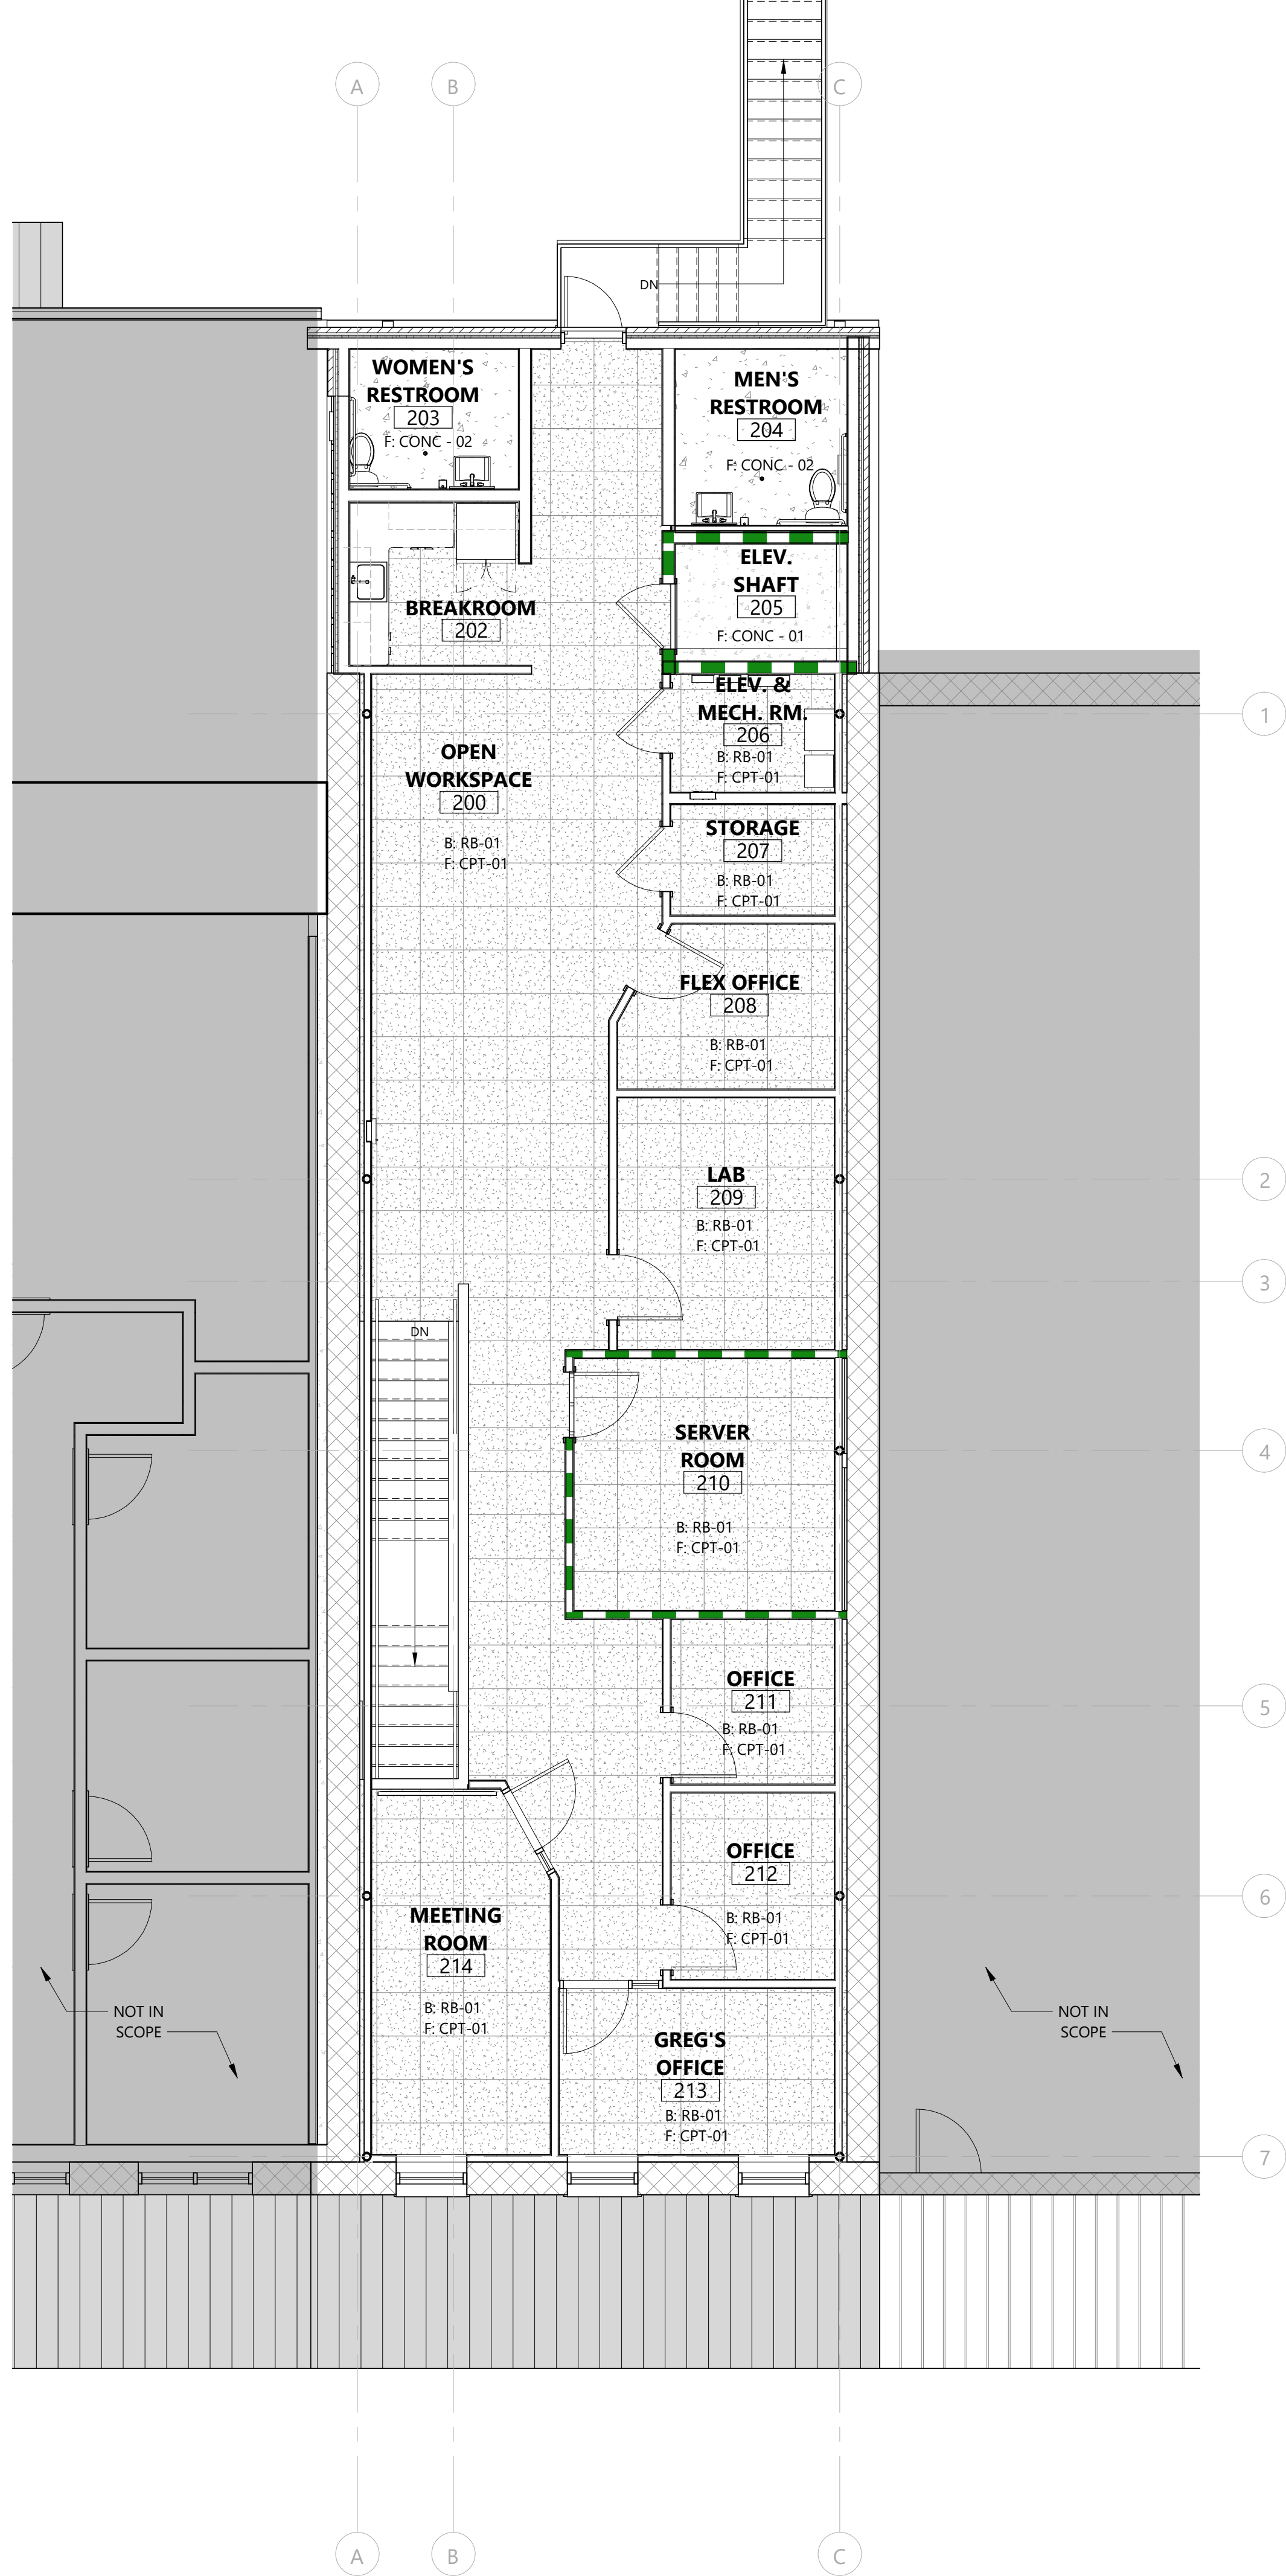

2 FINISH PLAN - SECOND FLOOR  
SCALE: 3/16" = 1'-0"

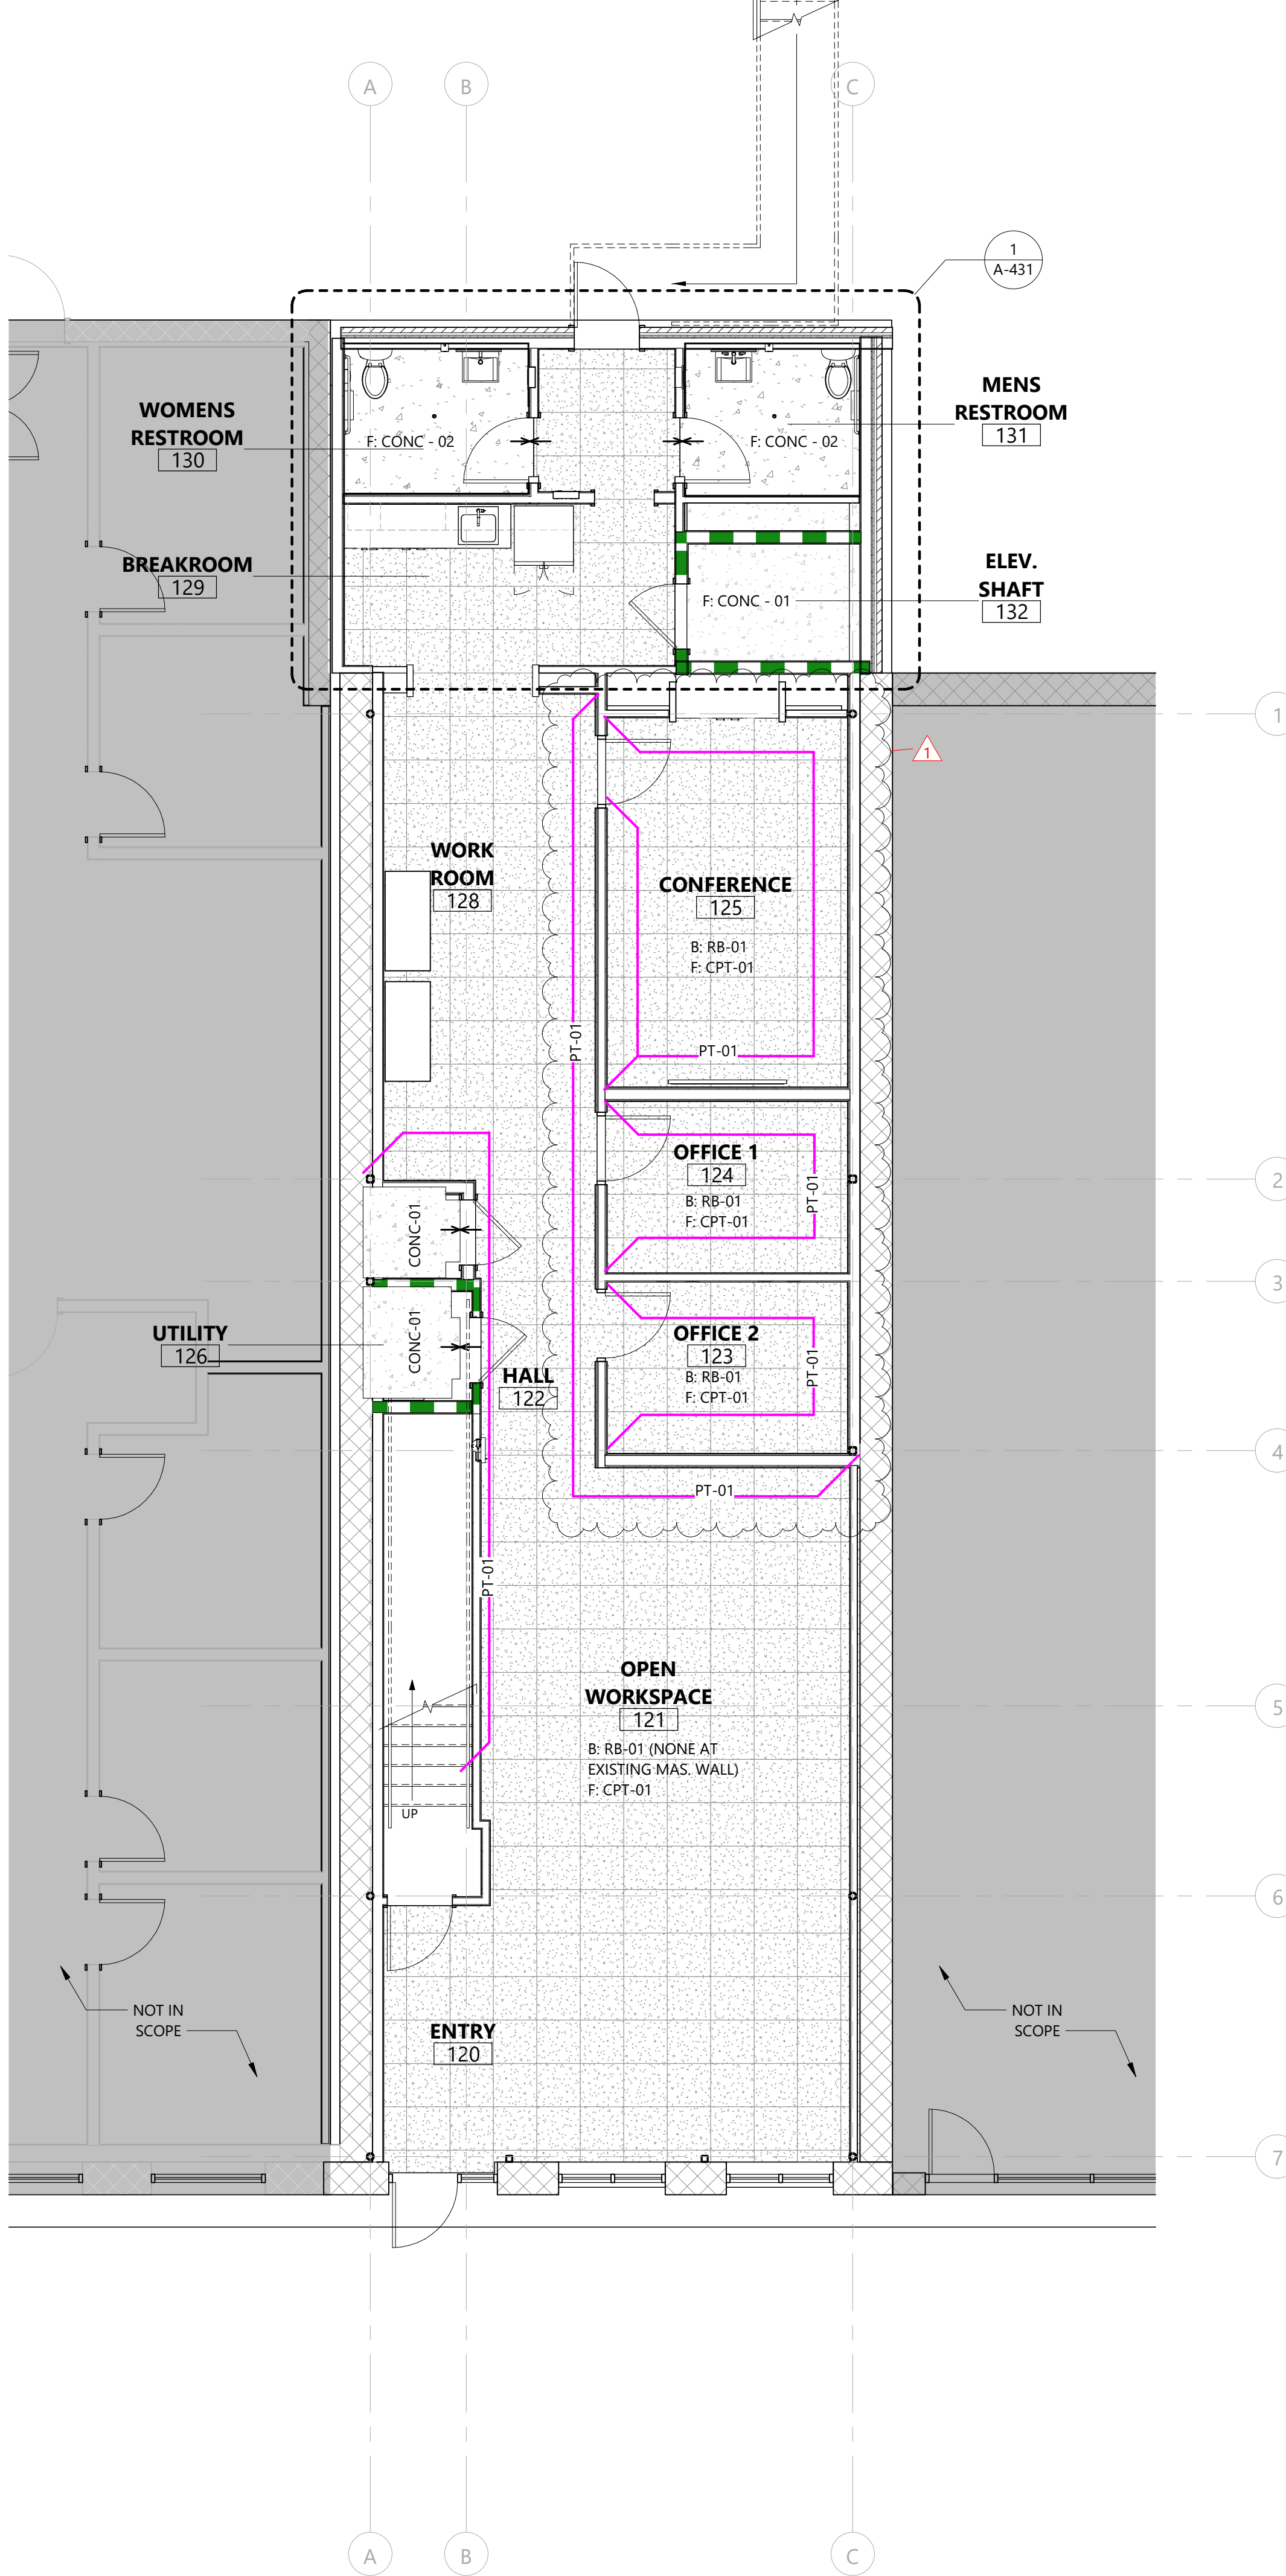


1 FINISH PLAN - FIRST FLOOR  
SCALE: 3/16" = 1'-0"

GENERAL NOTES:


- 1 INFORMATION SHOWN ON G-501 & G-502 GOVERNS OVER ANY INFORMATION SHOWN ON THIS SHEET. IMMEDIATELY NOTIFY THE ARCHITECT OF ANY DISCREPANCY BETWEEN THE INFORMATION ON THIS SHEET AND THE INFORMATION SHOWN ON SHEET G-501 & G-502.
- 2 REF. ELEVATIONS FOR ADDITIONAL FINISH INFORMATION.
- 3 REF. FINISH SELECTIONS FOR MATERIALS AND FINISH DESIGNATIONS.
- 4 PREPARE SLAB AS REQUIRED PER FLOOR FINISH MANUFACTURER INSTRUCTIONS.
- 5 ALL WALLS AND COLUMNS TO BE PT-01, U.N.O.
- 6 BEGIN PAINTING FROM WALL EDGES AND CORNERS, U.N.O.
- 7 PROVIDE CLEAN TRANSITION IF PAINT ENDS AT OUTSIDE CORNER.
- 8 ALL FINISH FLOORS TO BE CPT-01, U.N.O.
- 9 CENTER FLOORING IN ROOM, U.N.O.
- 10 ALL MATERIAL CHANGES / TRANSITIONS TO OCCUR UNDER CENTERLINE OF DOOR, U.N.O. DO NOT USE RUBBER TRANSITION STRIPS.
- 11 ALL SCHLUTER TRANSITION STRIPS TO BE ANODIZED ALUMINUM, U.N.O.
- 12 GROUT JOINTS ON FLOOR TO BE 1/8" WIDE, U.N.O. GROUT JOINTS ON WALL TILE TO BE 1/8" WIDE, U.N.O. NOTIFY ARCHITECT IF MANUFACTURER'S RECOMMENDED INSTALLATION INSTRUCTIONS DIFFER.
- 13 ALIGN GROUT JOINTS IN FLOOR TILE, WALL TILE AND TILE BASE, U.N.O.
- 14 PROVIDE CRACK ISOLATION MEMBRANE UNDER TILE AT ALL TILE FLOORING LOCATIONS ABOVE GRADE. LATICRETE FRACTURE BAN SC OR ARCHITECT APPROVAL EQUAL.
- 15 PROVIDE ATTIC STOCK FOR EACH FLOORING MATERIAL AND PAINT COLOR.
- 16 ALL OUTLET AND LIGHT SWITCH COLORS TO BE STANDARD WHITE, U.N.O.
- 17 REF. DOOR & HARDWARE SCHEDULE FOR DOOR AND FRAME FINISHES.
- 18 ALL WALL BASE TO BE RB-01, U.N.O.

LEGEND:

W: XX-XX B: XX-XX F: XX-XX	GENERAL ROOM FINISHES: WALL, BASE, FLOOR.		CONC-01
XX-XX	SPECIFIC WALL FINISH		CONC-02
X/X-X-XX	REFERENCE ELEVATION FOR FINISH		CPT-01
	FLOOR TRANSITION, RE: A-131		

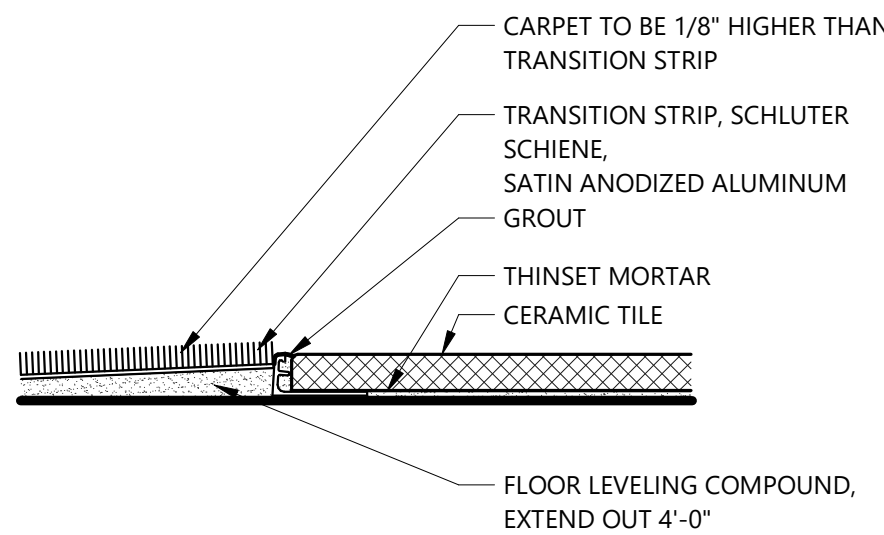

3 CARPET/ TILE  
SCALE: 6" = 1'-0"

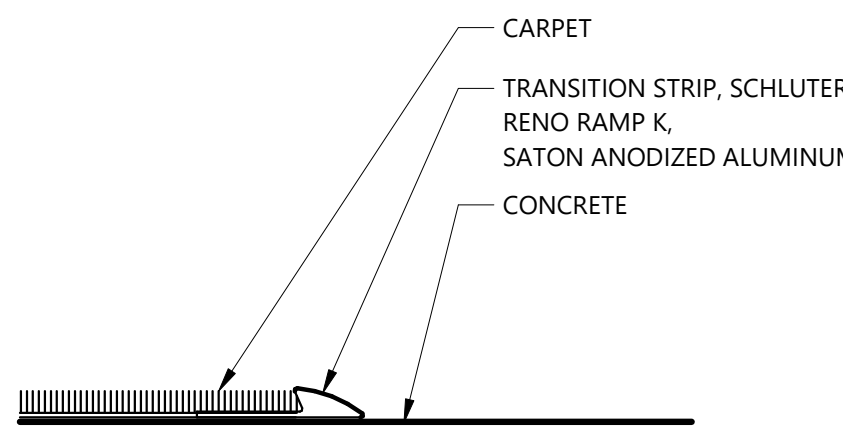

4 CARPET/ CONCRETE  
SCALE: 6" = 1'-0"



## GENERAL NOTES:


- REFER TO SHEET A-6-11 FOR DOOR SCHEDULE.
- REFER TO SHEET A-6-31 FOR STOREFRONT SCHEDULE.
- REFER TO SHEET G-6-01 FOR FINISH SCHEDULE.
- EXPOSED EXTERIOR STEEL TO BE PRIMED AND PAINTED AS SCHEDULED.
- WHERE INDICATED ON DRAWINGS PROVIDE EXPANSION JOINTS AT THE FOLLOWING LOCATIONS:
  - AT SHELF ANGLES
  - EVERY 30 FEET (MAXIMUM) ALONG WALLS
  - AT OFFSETS IN WALLS
  - AT INTERSECTIONS OF WALLS
  - WHERE SHORT RUNS OF MASONRY INTERFACE WITH LONG RUNS OF MASONRY
  - NEAR CORNERS (15 FEET MAXIMUM)
  - AT COLUMNS
  - AT FOUNDATIONS (BOND BREAK)
  - AT FLOOR OR ROOF CONNECTION
  - AT PARAPET WALLS
  - WHERE MATERIALS WITH DIFFERENCE COEFFICIENTS OF THERMAL EXPANSION ARE JOINED

## KEYED NOTES:


26 56 00.01 EXTERIOR WALL MOUNTED LIGHT FIXTURE, RE: ELECTRICAL FOR FIXTURE TYPE

## SHEET NOTES:


- RESTORE BOTH SIDES OF MASONRY FACADE: REMOVE EXISTING PLASTER AND PAINT. TUCK POINT MASONRY FOR STRUCTURAL INTEGRITY AS REQUIRED
- RESTORED MASONRY UNTELS, SILLS AND CORNICES - REMOVE EXISTING PLASTER AND PAINT. TUCK POINT MASONRY FOR STRUCTURAL INTEGRITY, AS REQUIRED
- MATCH THE SPACING OF EXISTING BRACKET TO ADJACENT DOOR/WINDOW
- DOUBLE RIB METAL ROOF (MTL-01) OVER STEEL TUBE AWNING BRACKETS WELDED TO BASE PLATE ANCHORED TO STONE WALL, REF: STRUCTURAL. REFERENCE ADJACENT ANNEX BUILDING FOR STEEL TUBE DIMENSION, PNT BLACK TO MATCH
- EMSEAL 25V MASONRY CAVITY WALL EXPANSION JOINT, INSTALL PER MANUFACTURER'S RECOMMENDATIONS

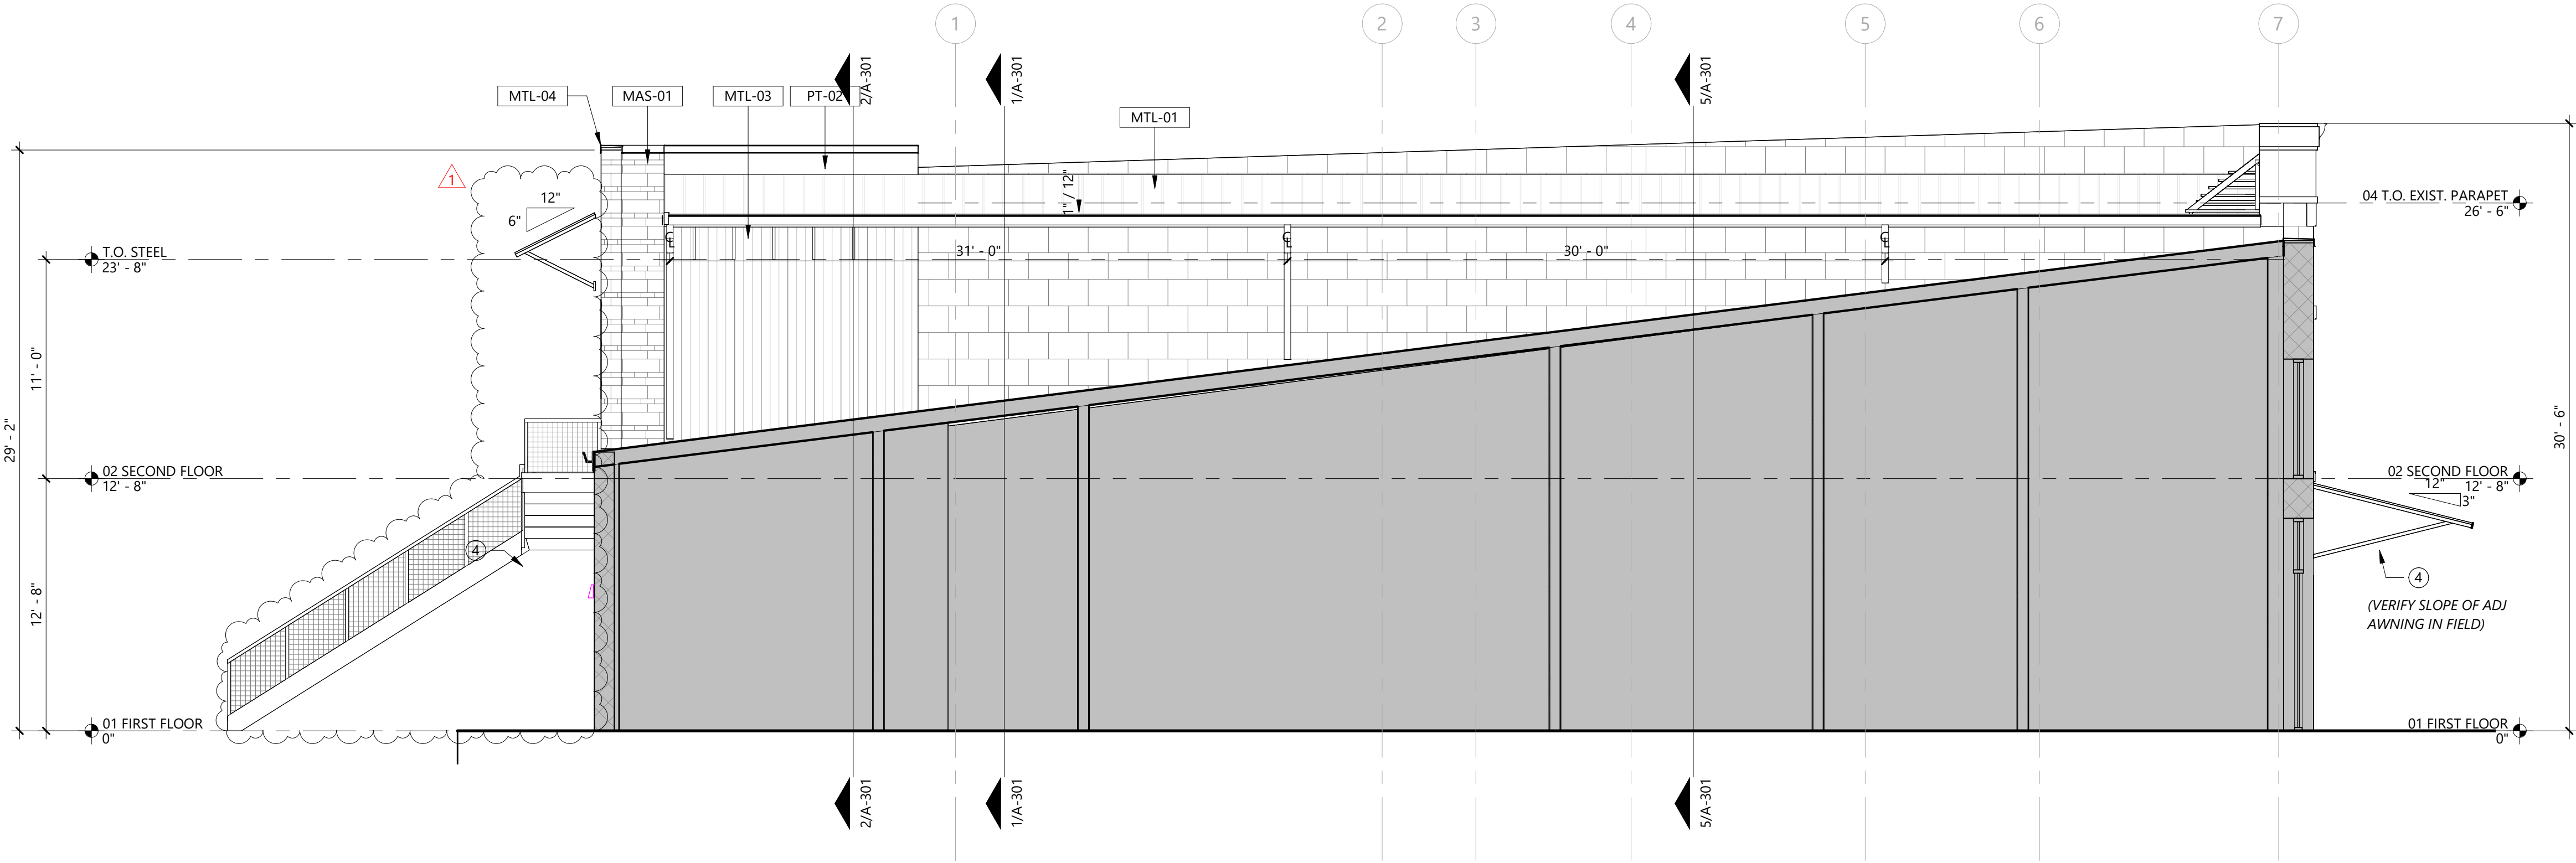


**3 PARTIAL ELEVATION**  
SCALE: 3/16" = 1'-0"

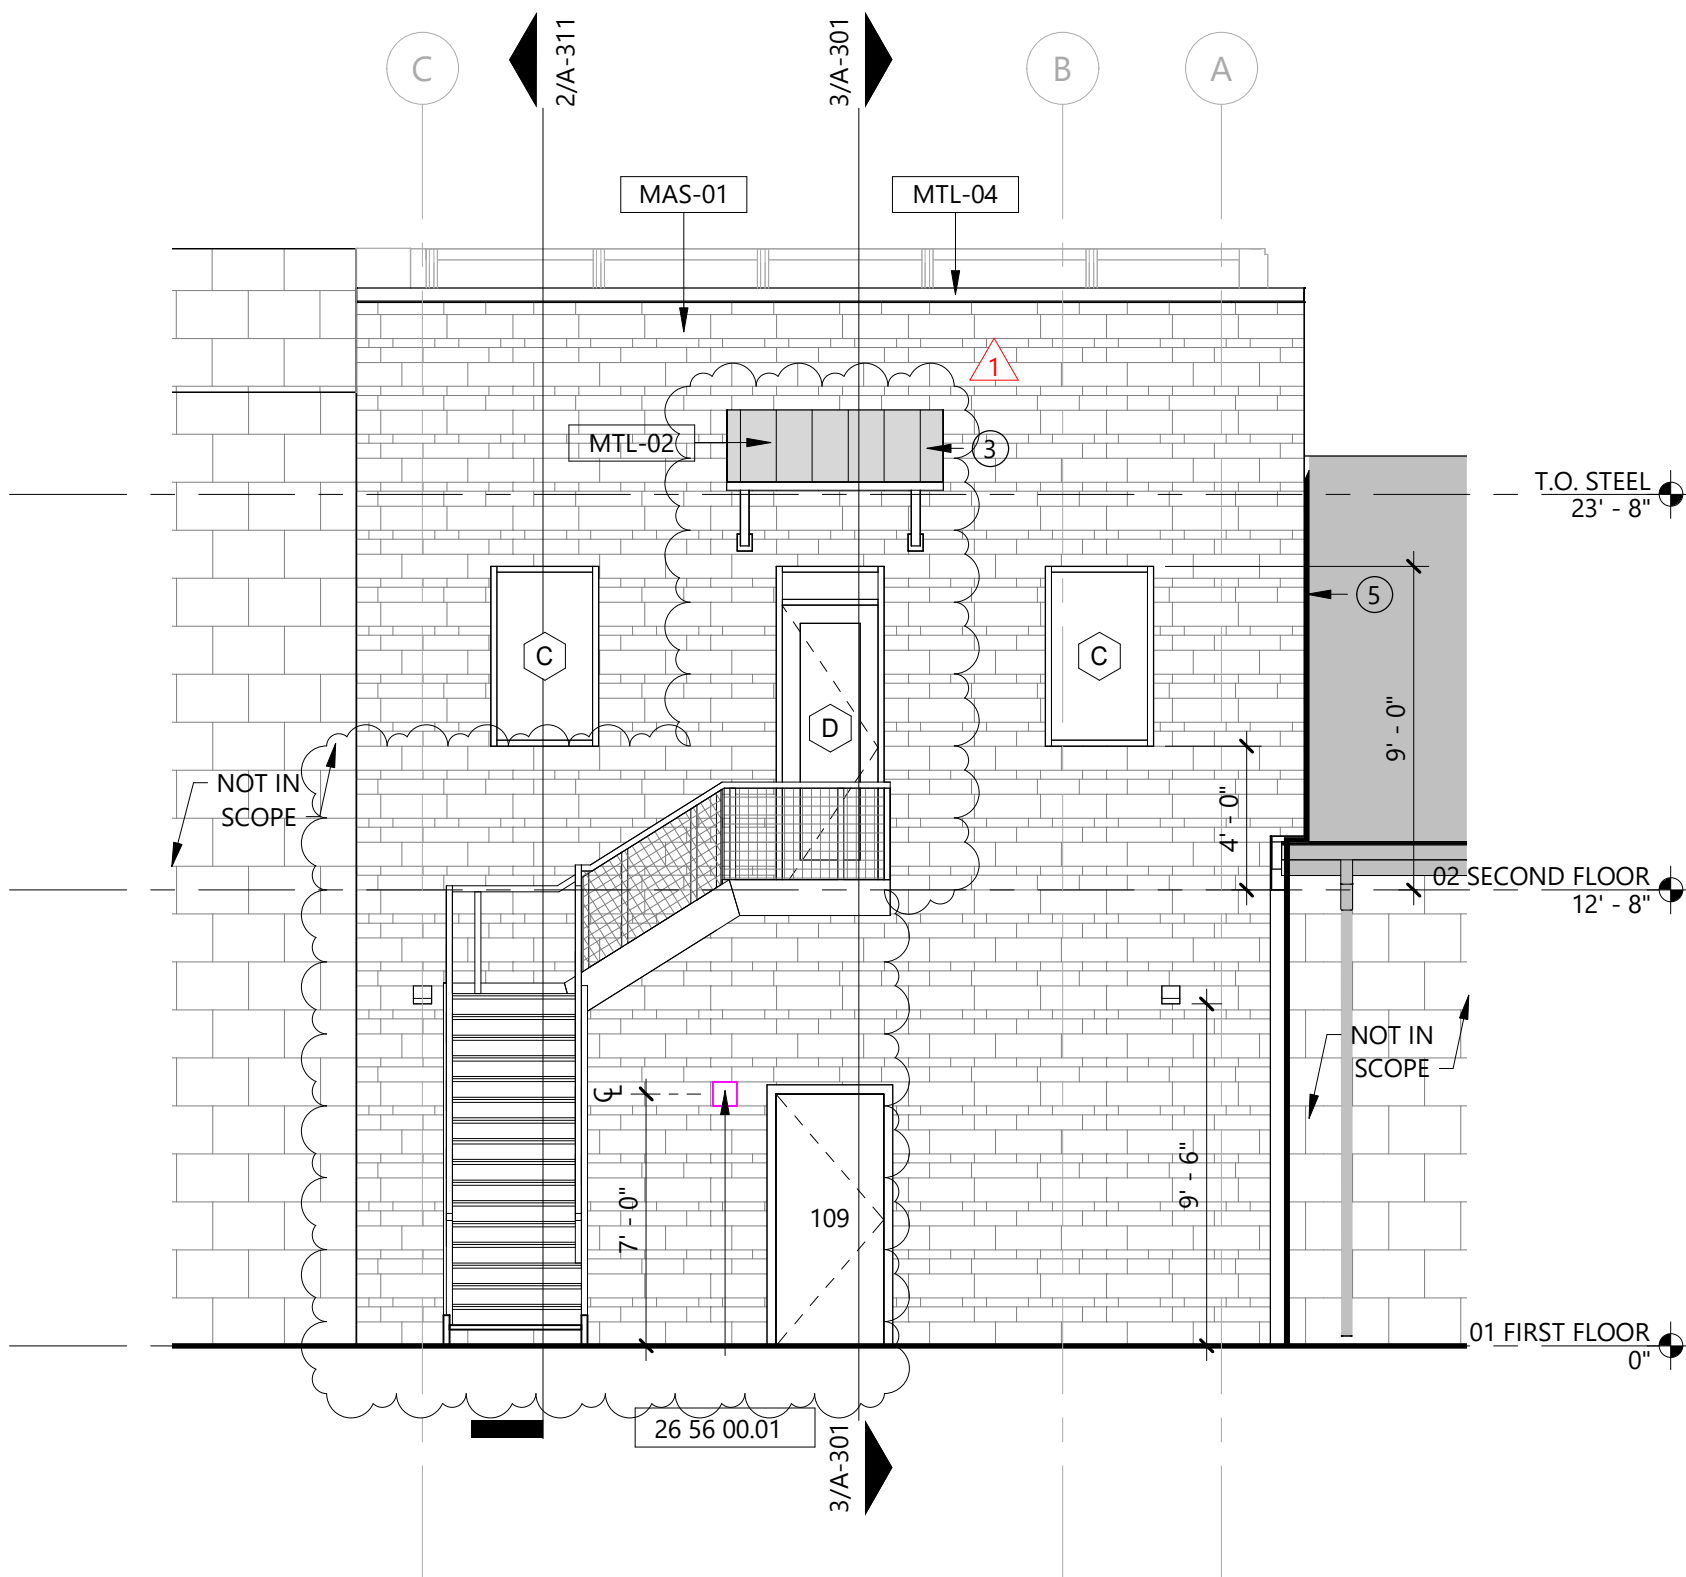

**2 REAR ELEVATION**  
SCALE: 3/16" = 1'-0"

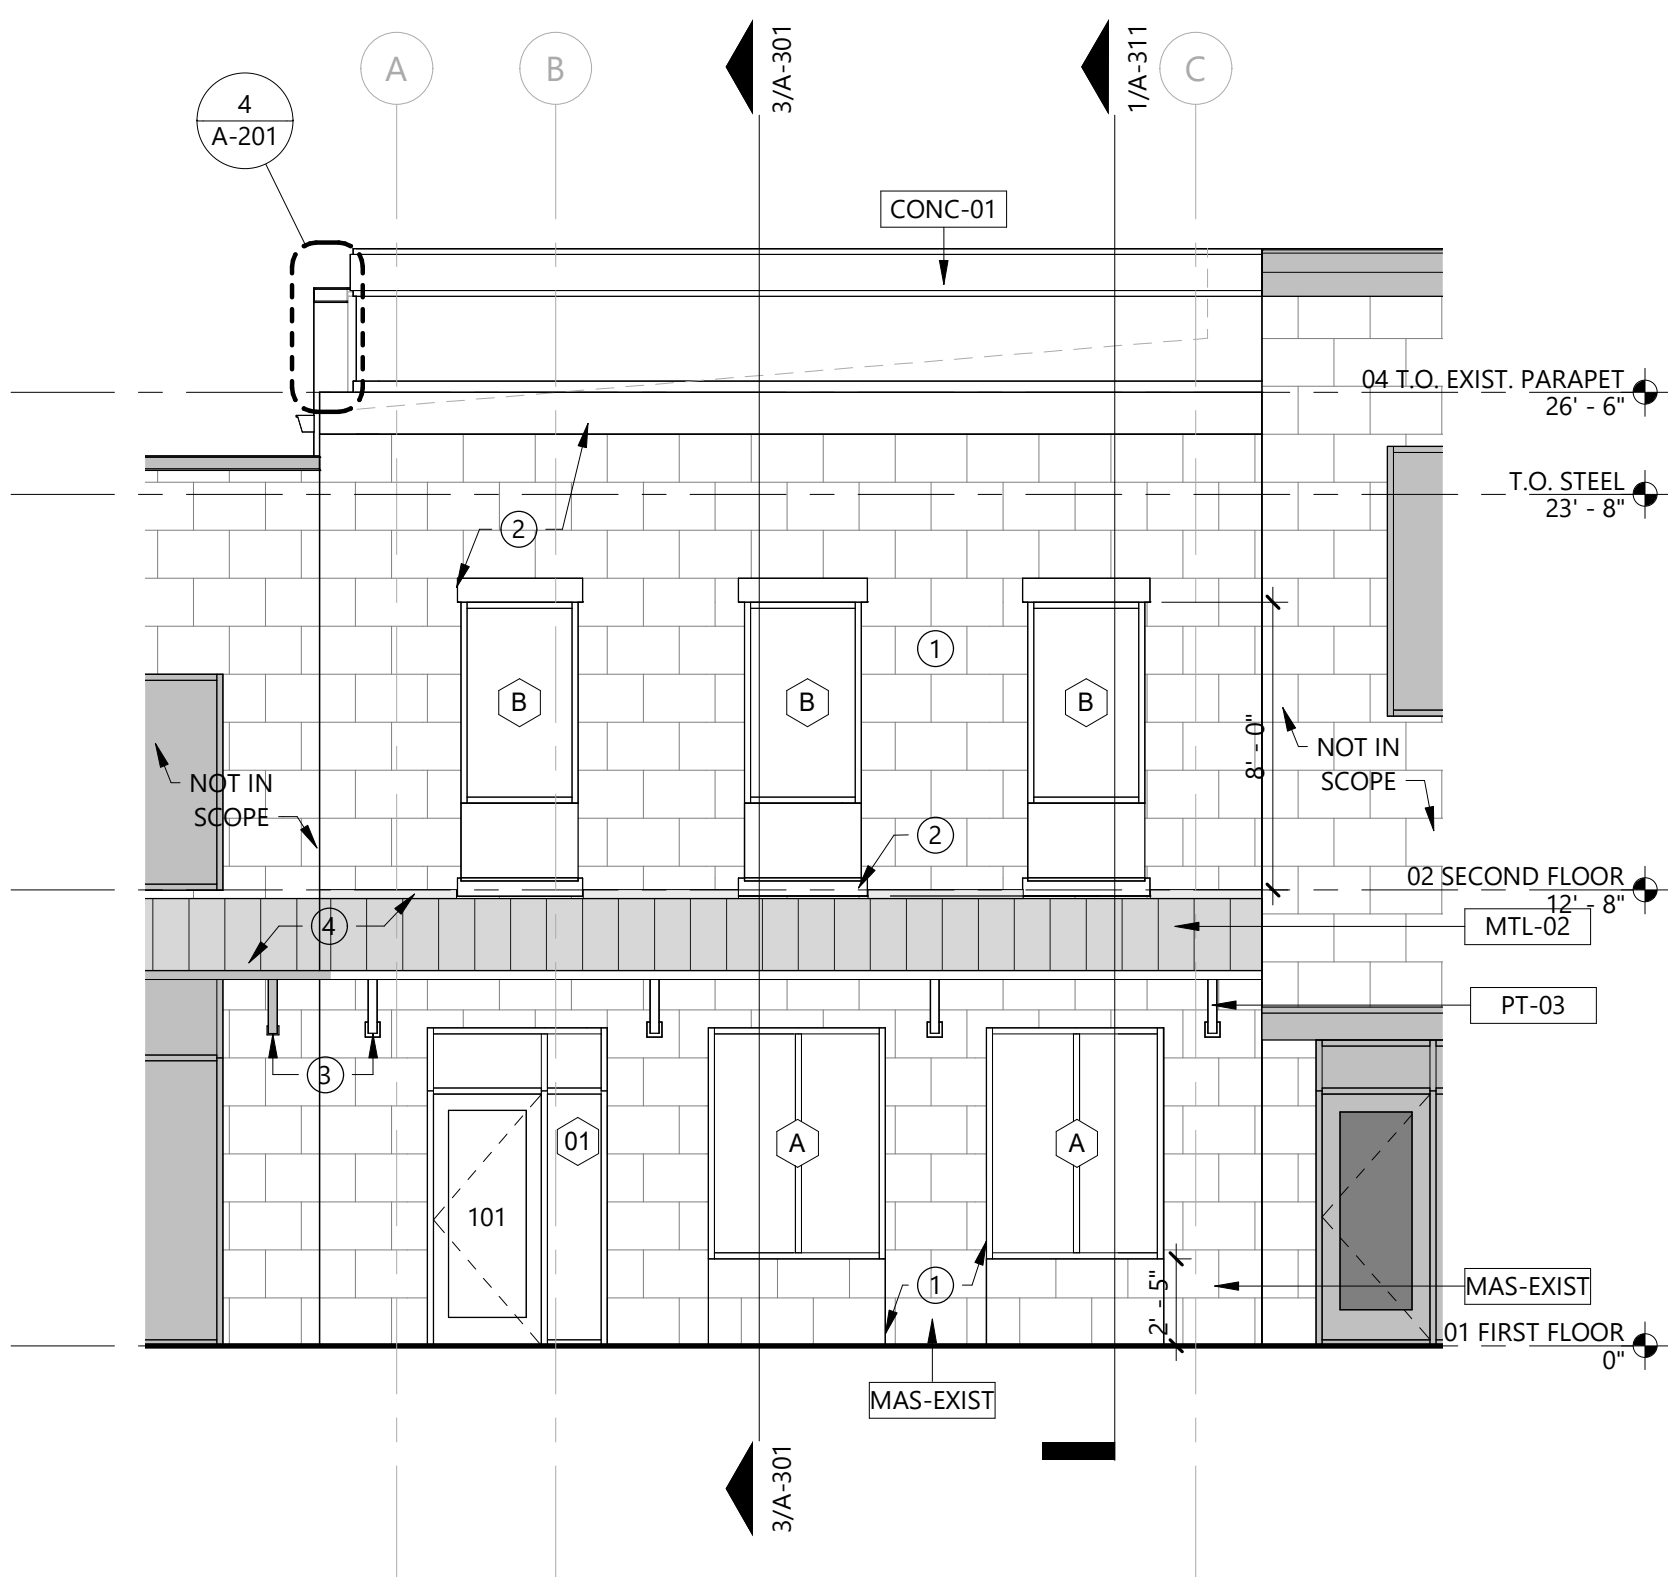

**1 FRONT ELEVATION**  
SCALE: 3/16" = 1'-0"

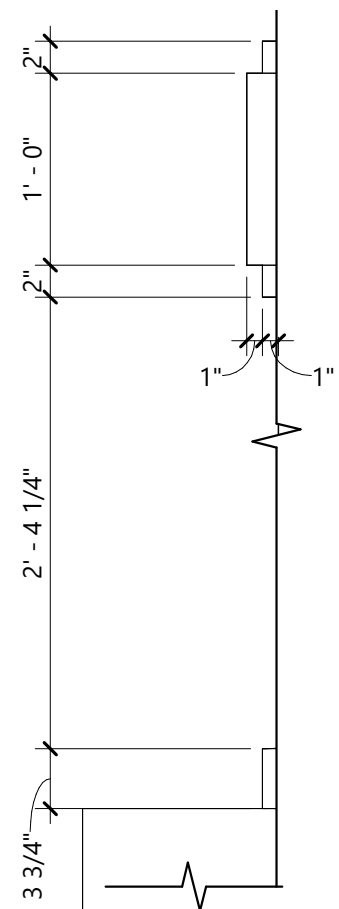

**4 CORNICE ELEVATION**  
SCALE: 1" = 1'-0"

## MATERIAL LEGEND:


MAS-01	LIMESTONE, REFER TO FINISH SCHEDULE
MAS-EXIST	RESTORE EXISTING MASONRY FACADE: REMOVE EXISTING PLASTER AND PAINT, TUCK POINT MASONRY FOR STRUCTURAL INTEGRITY AS REQUIRED
MTL-01	DOUBLE RIB METAL ROOF AWNING, RE: ROOF PLAN
MTL-02	STANDING SEAM METAL ROOF, RE: ROOF PLAN
MTL-03	METAL WALL PANEL
MTL-04	METAL COPING
PT-0X	SEE FINISH SCHEDULE FOR PAINT SELECTIONS

GENERAL NOTES:

- 1 REFER TO ACCESSIBILITY GUIDELINES G-501 AND G-502 FOR TOILET ACCESSORY MOUNTING HEIGHTS AND CLEARANCES.

SHEET NOTES:

- 1 SANITARY NAPKIN DISPOSAL ONLY IN WOMEN'S RESTROOM  
2 DEMOLISH NOTCH IN EXISTING LIMESTONE WALL TO ALLOW FOR PASSAGE OF HVAC DUCTING  
3 PROVIDE DUCT COLLAR TRIM FOR DUCT PENETRATIONS IN INTERIOR WALLS

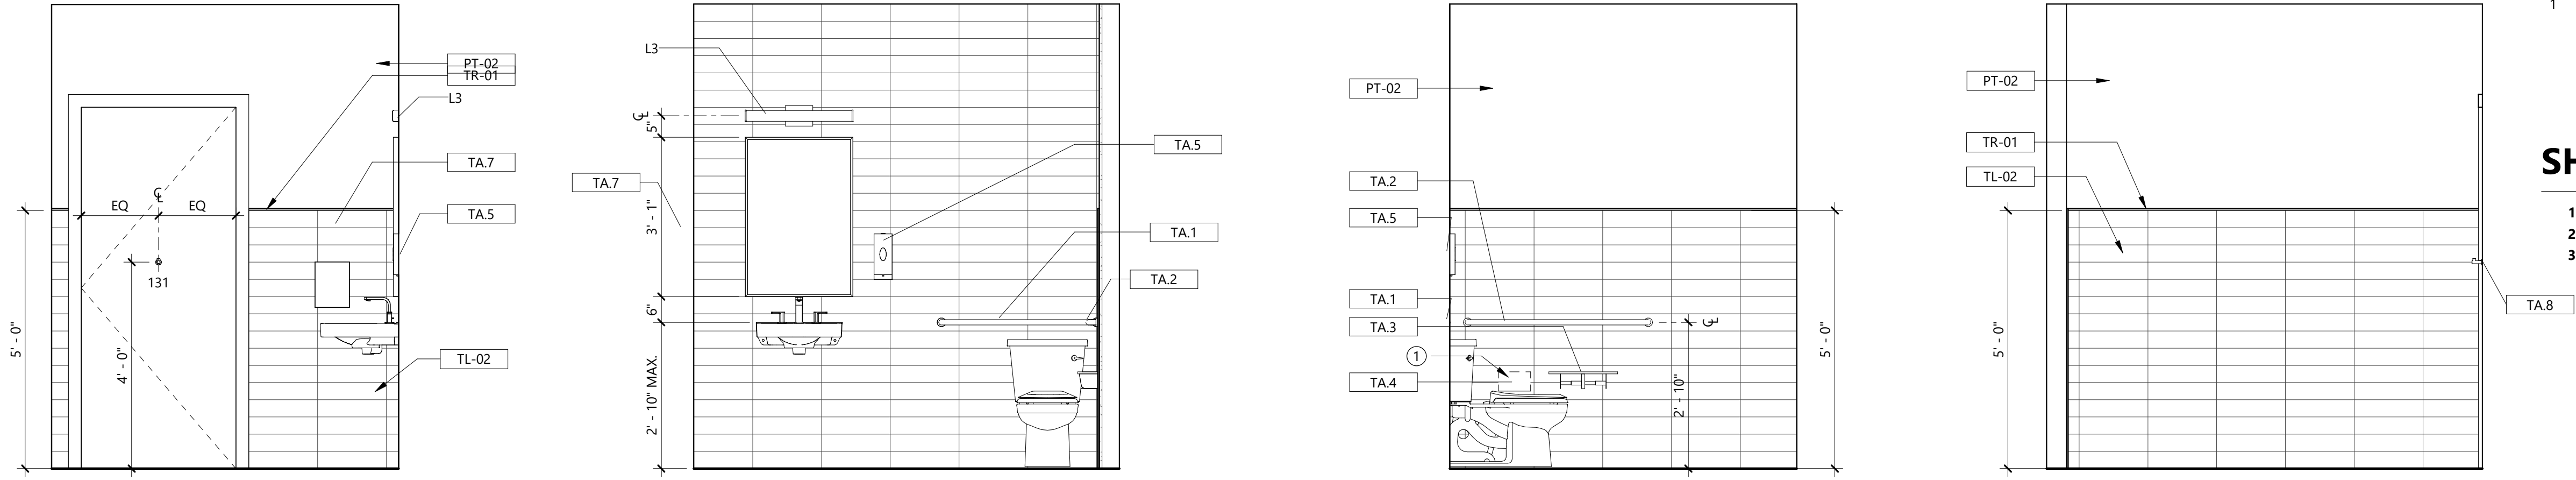


8 RESTROOM - WEST ELEVATION  
SCALE: 1/2" = 1'-0"

7 RESTROOM - NORTH ELEVATION  
SCALE: 1/2" = 1'-0"


6 RESTROOM - EAST ELEVATION  
SCALE: 1/2" = 1'-0"

5 RESTROOM - SOUTH ELEVATION  
SCALE: 1/2" = 1'-0"

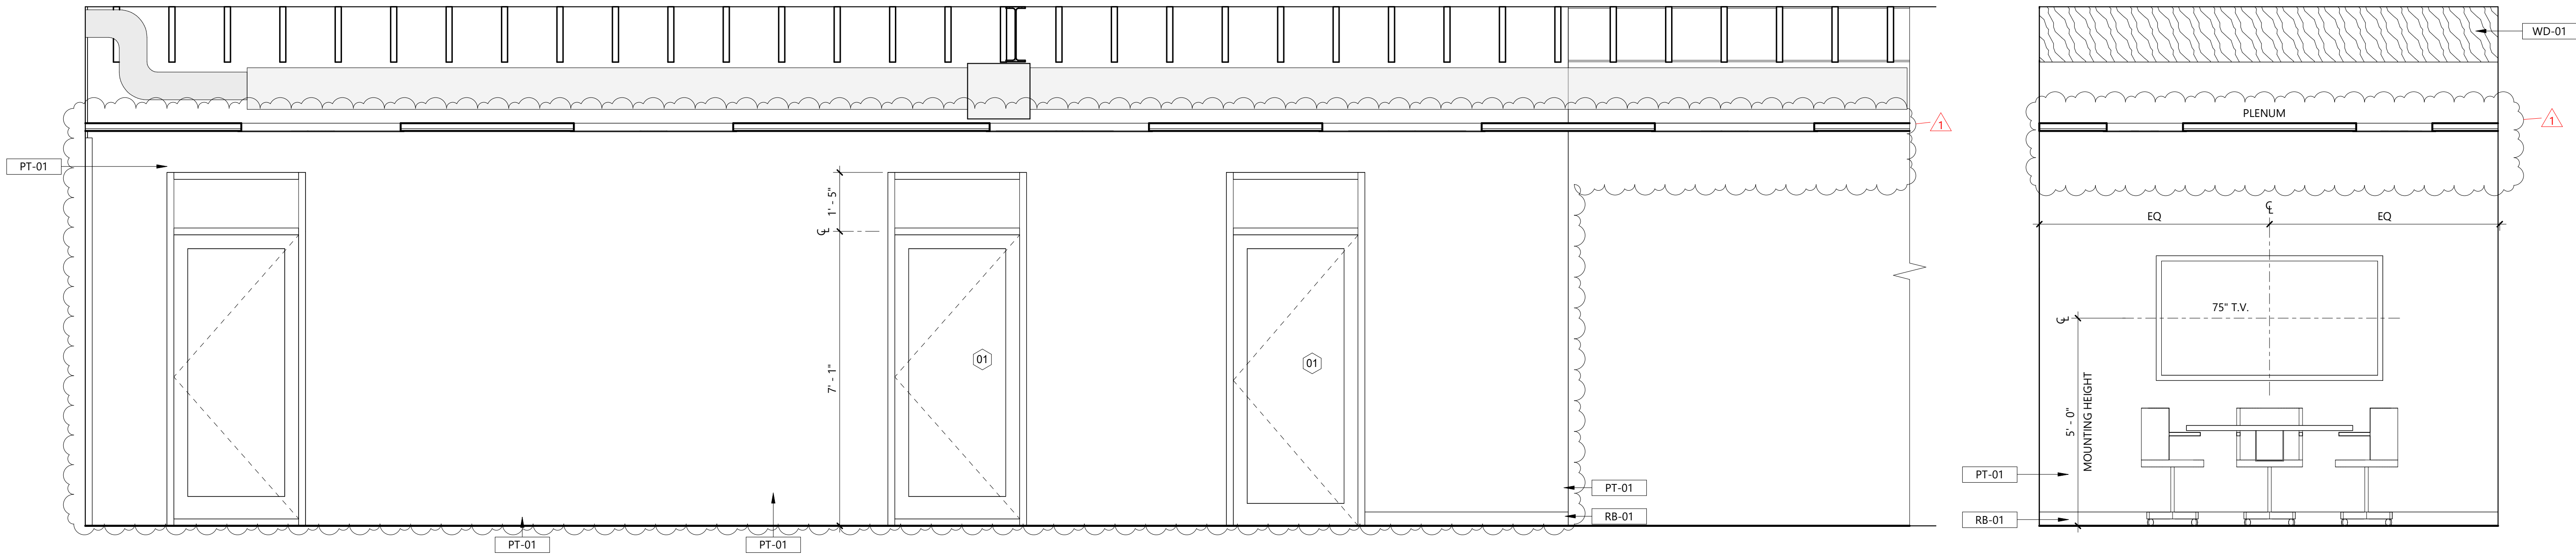


4 CONFERENCE, OFFICES, AND OPEN WORKSPACES  
SCALE: 1/2" = 1'-0"

3 CONFERENCE  
SCALE: 1/2" = 1'-0"

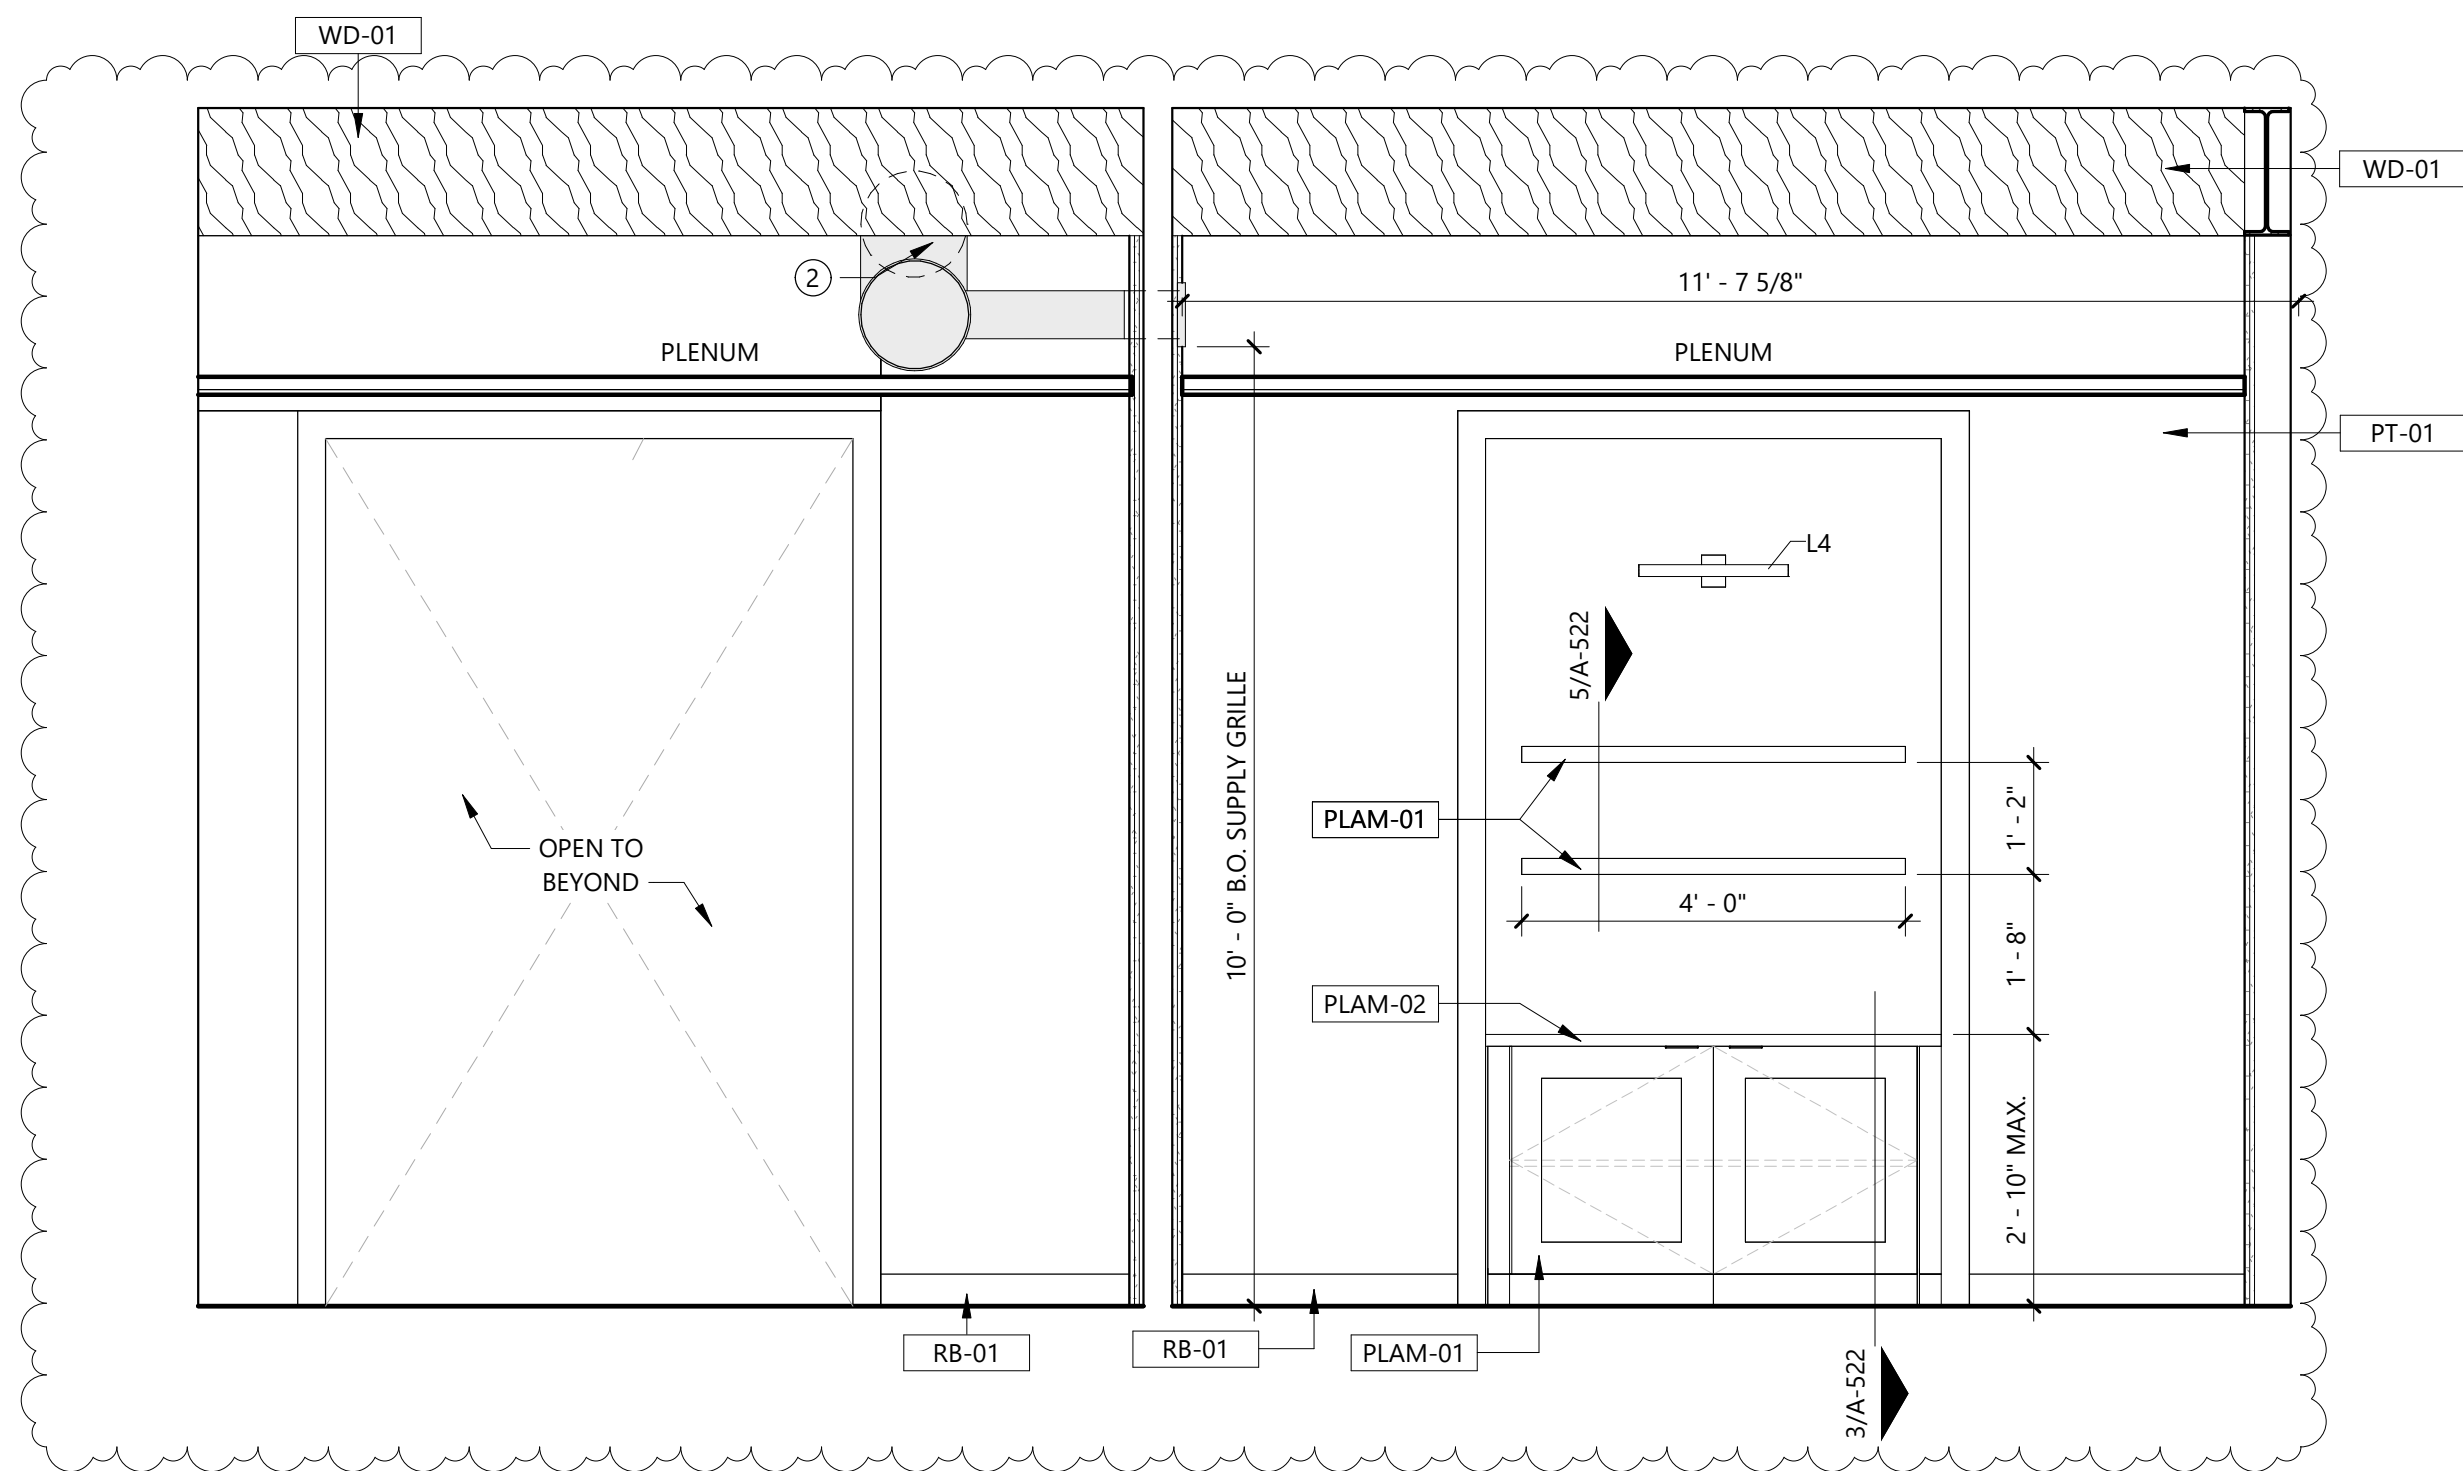


2 CONFERENCE AND BREAKROOM  
SCALE: 1/2" = 1'-0"

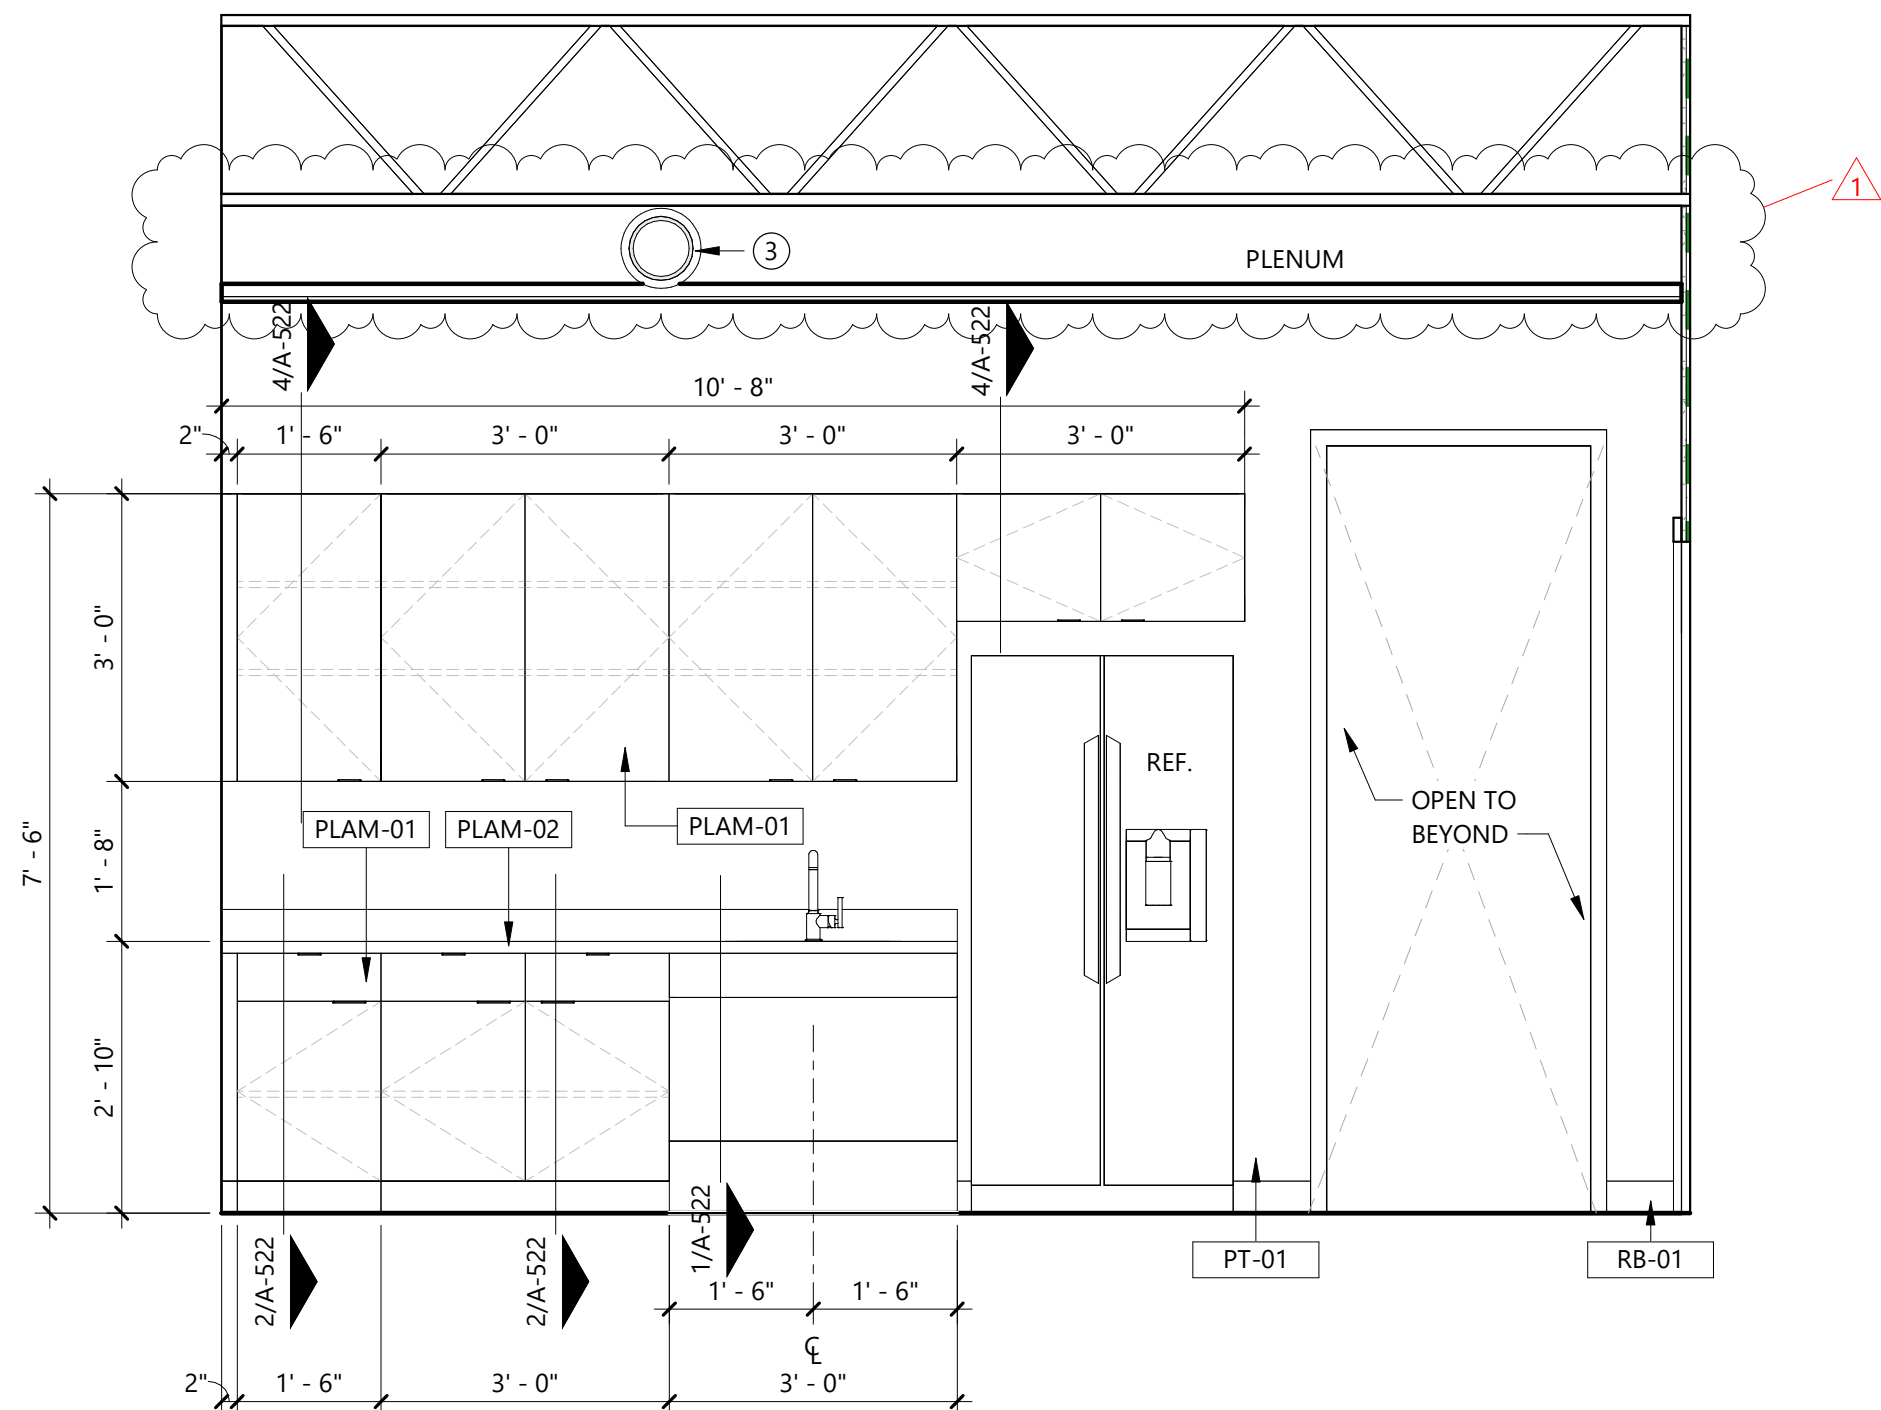


1 BREAKROOM  
SCALE: 1/2" = 1'-0"




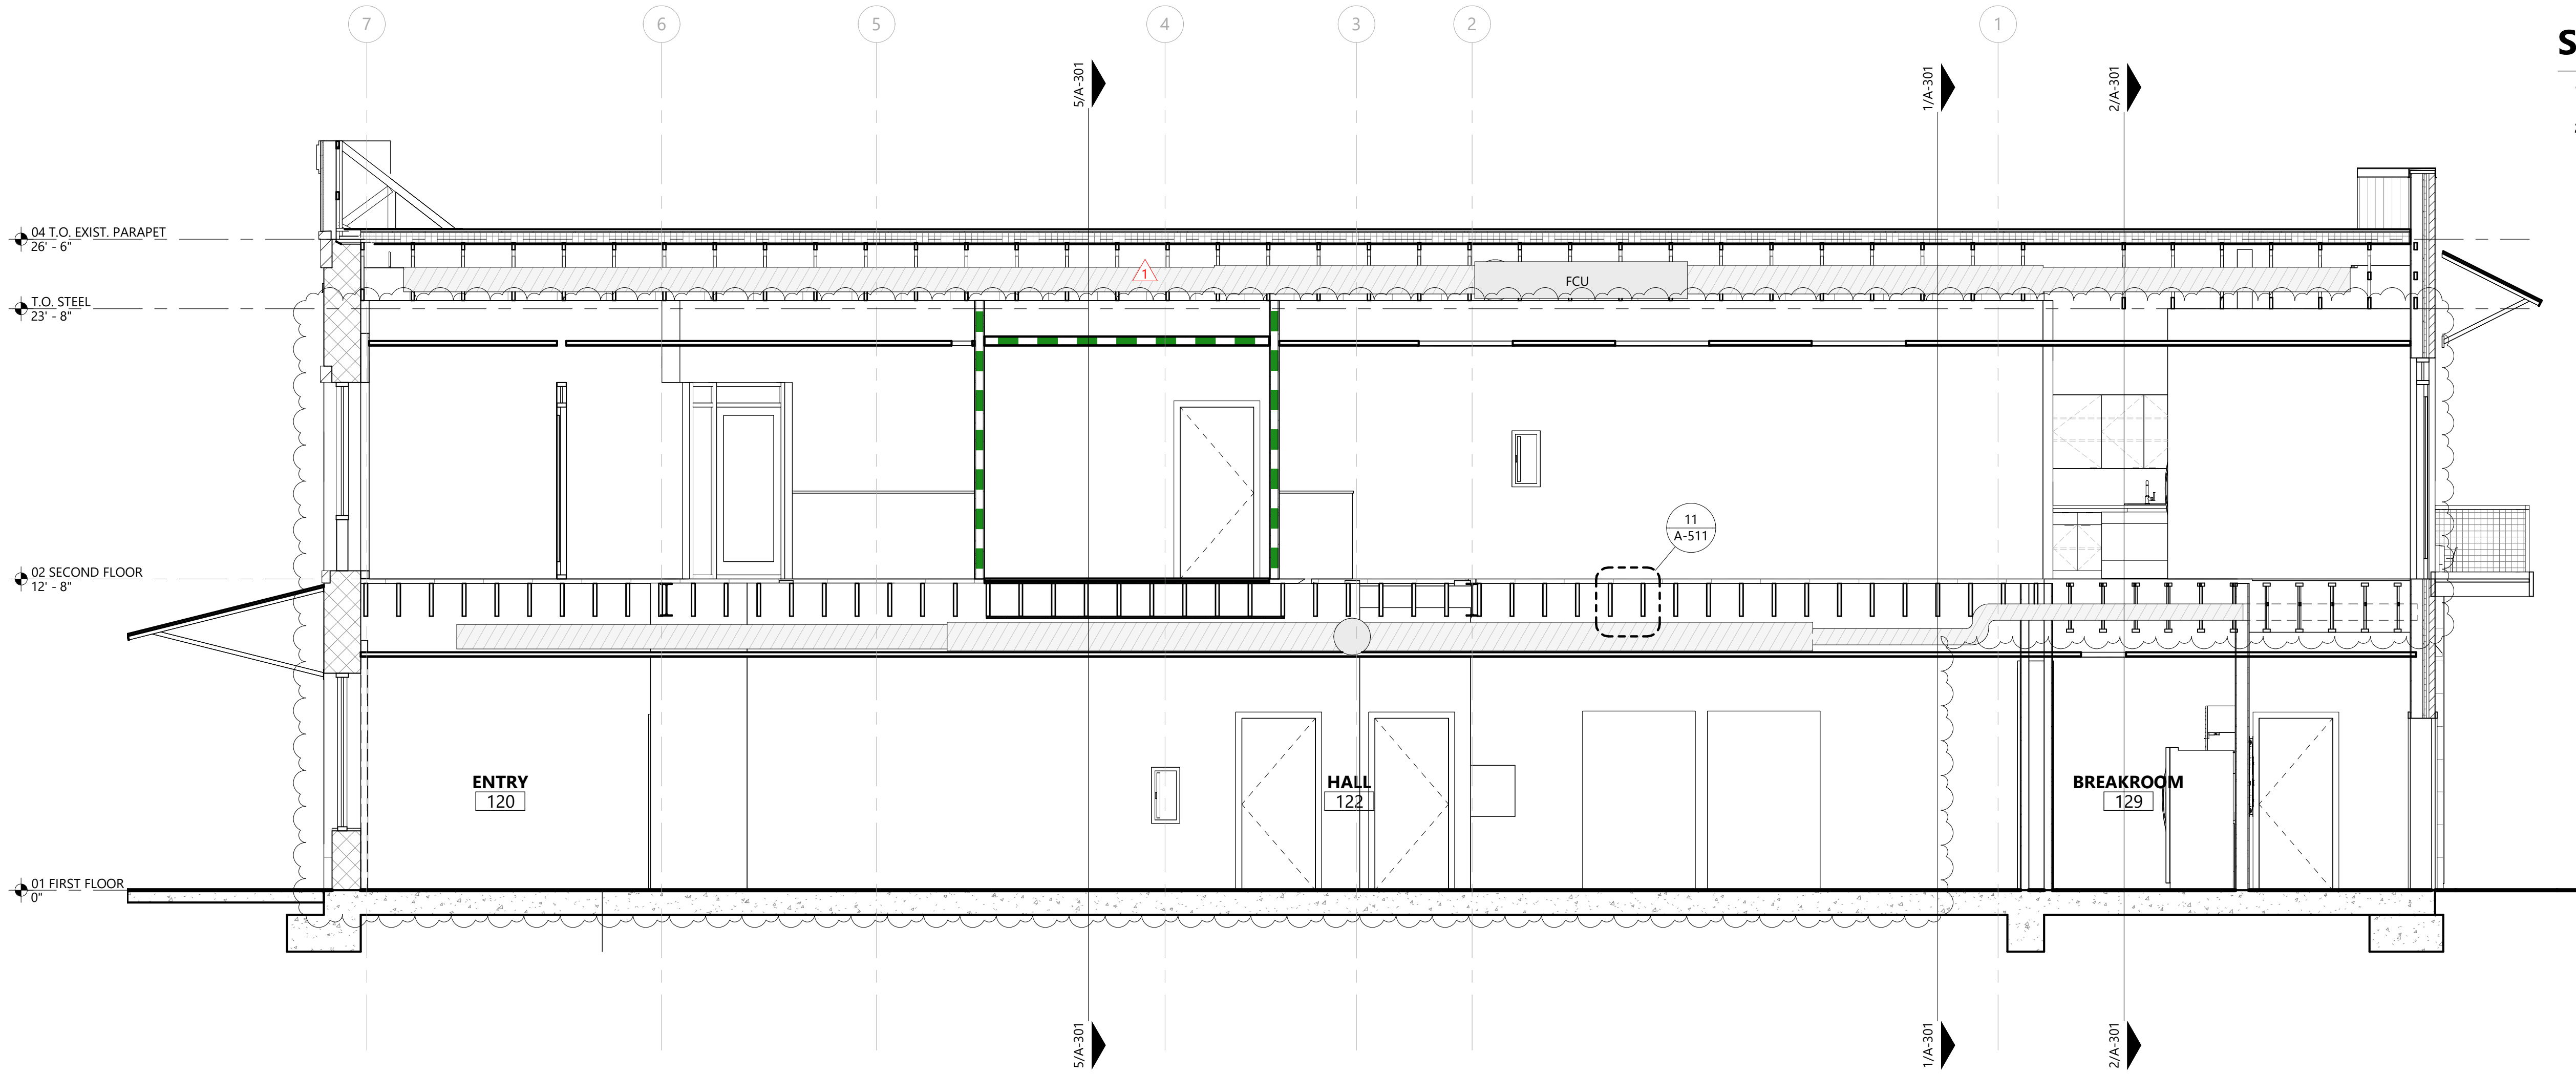


3 LONGITUDINAL SECTION AT HALL  
SCALE: 1/4" = 1'-0"

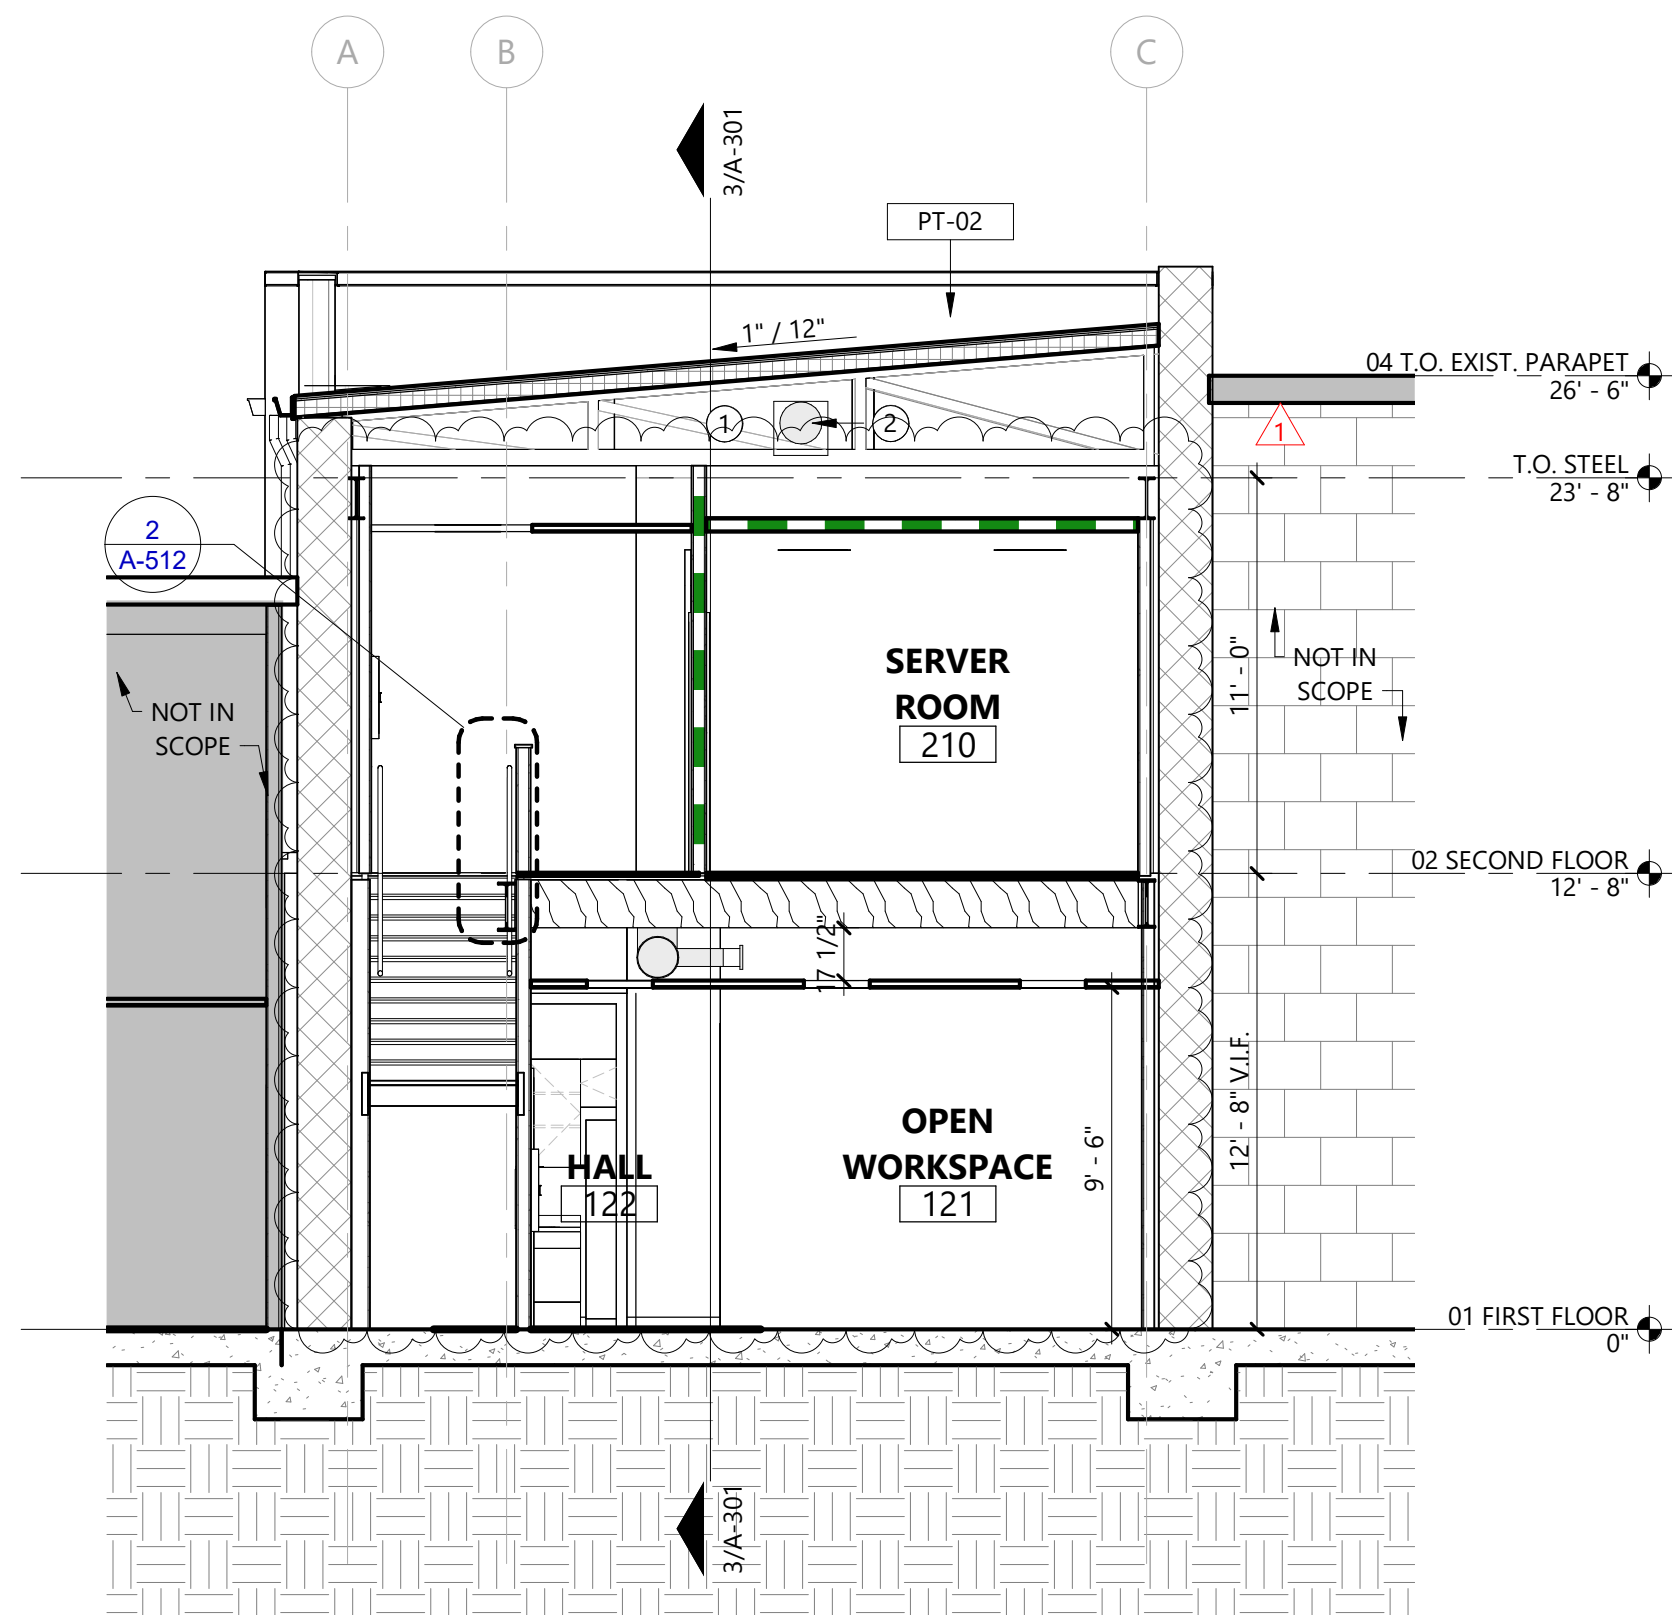

5 CROSS SECTION AT STAIR LANDING  
SCALE: 3/16" = 1'-0"

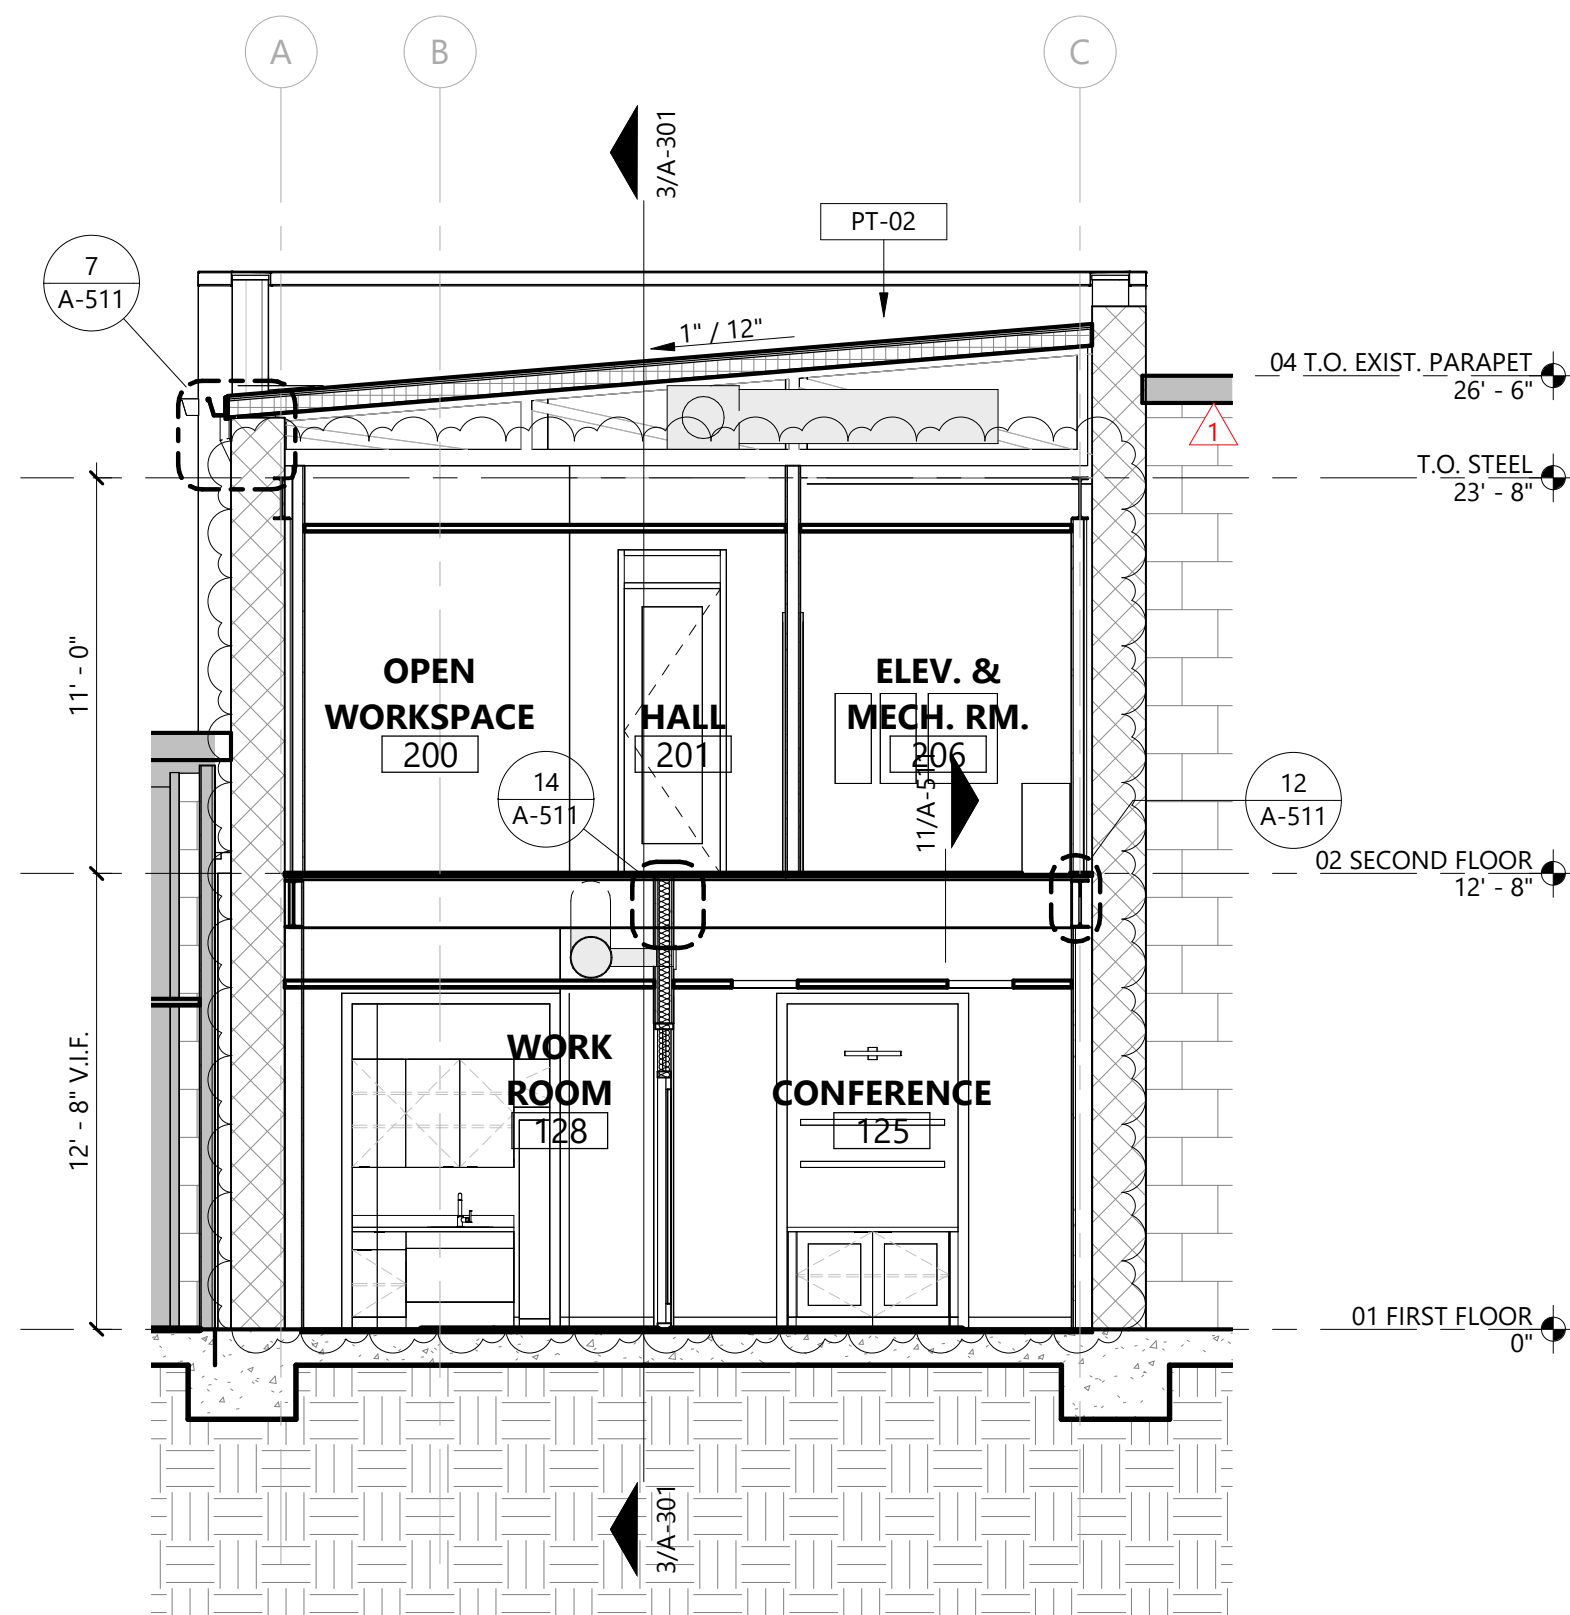

1 CROSS SECTION AT CONFERENCE ROOM  
SCALE: 3/16" = 1'-0"

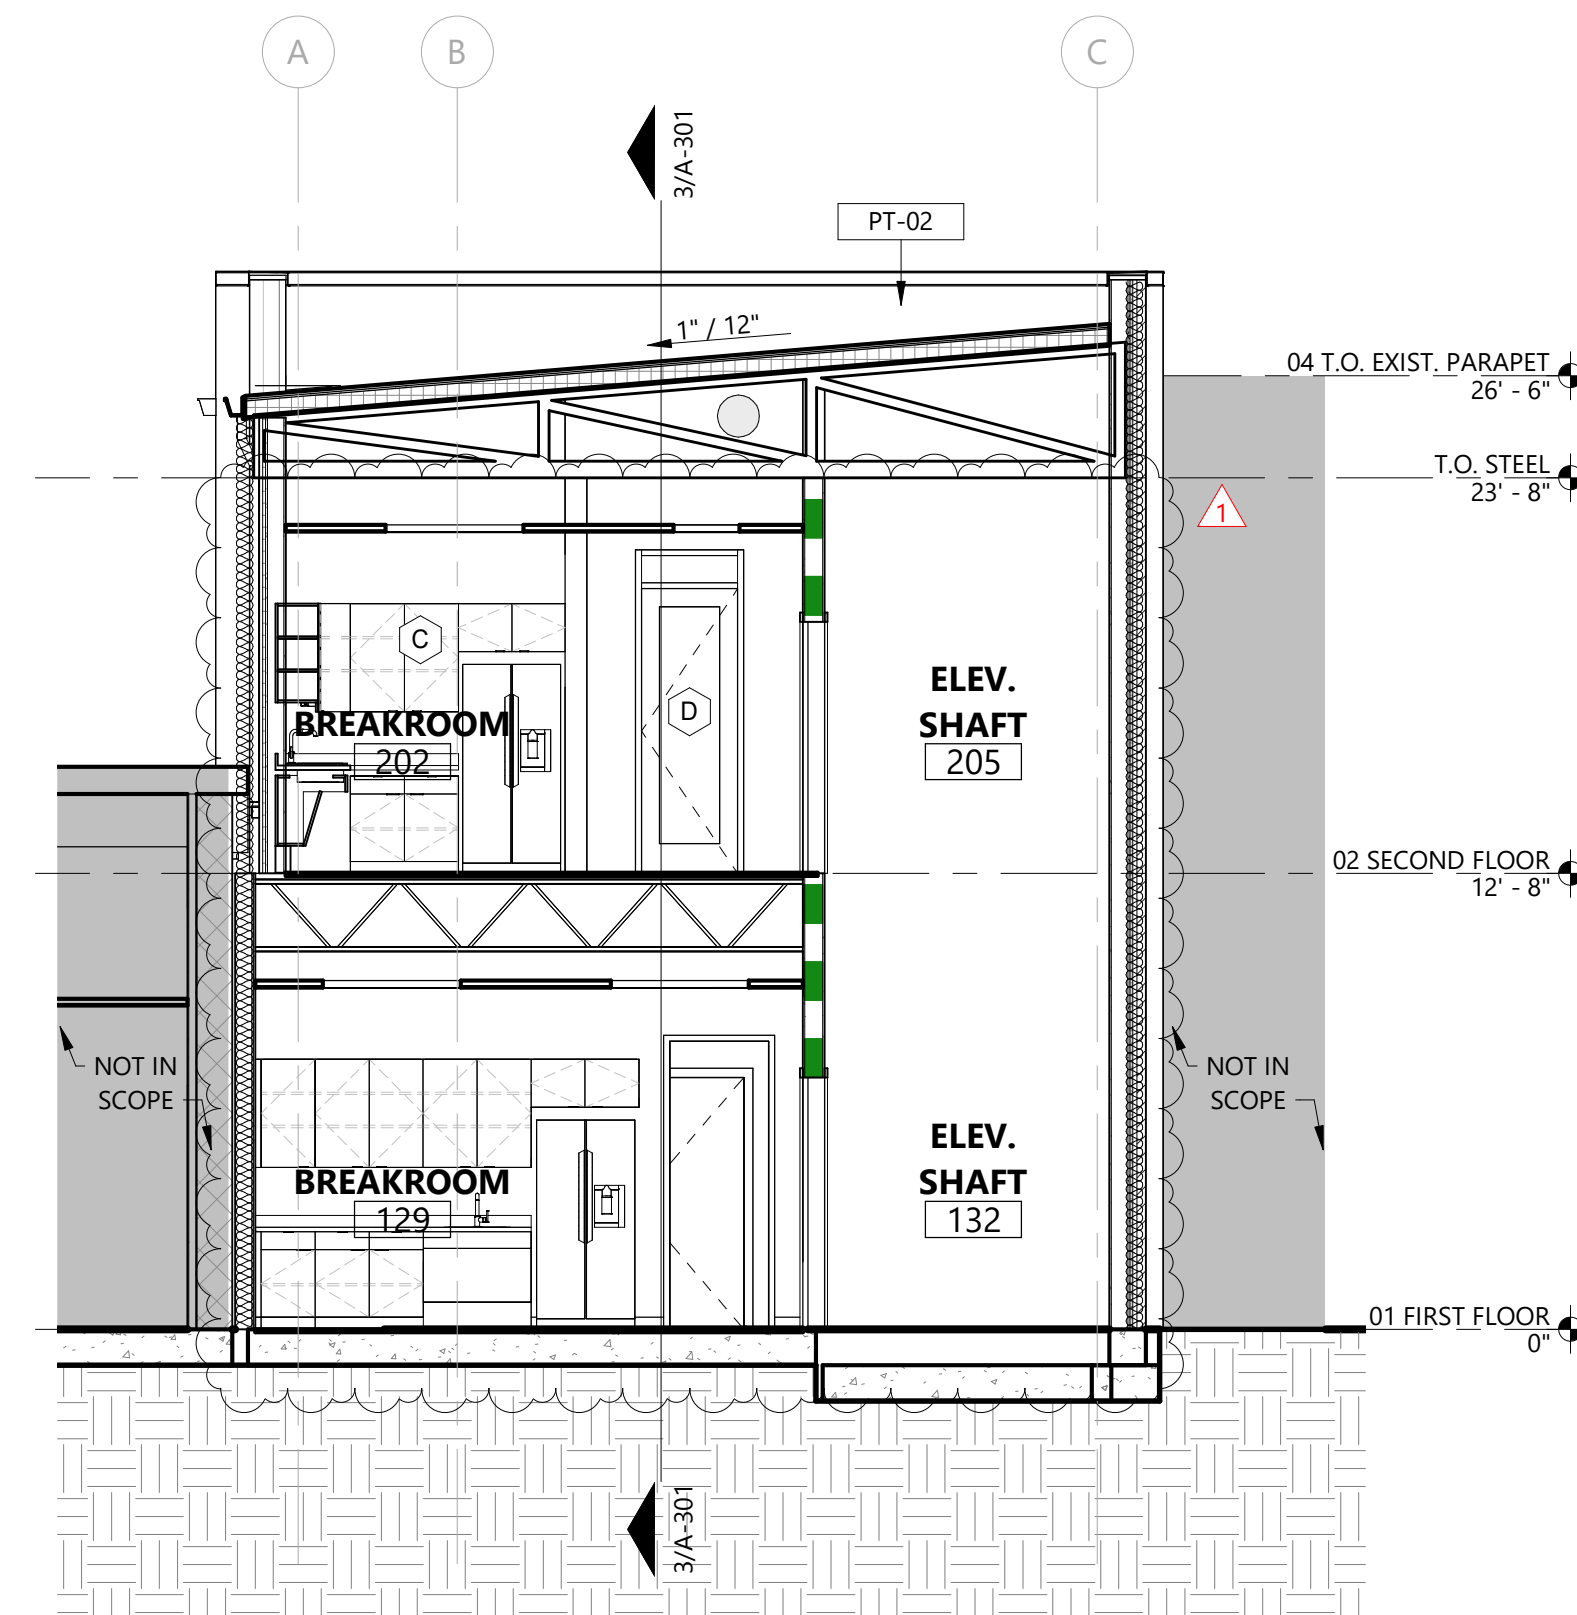


2 CROSS SECTION AT BREAKROOM  
SCALE: 3/16" = 1'-0"

## SHEET NOTES:

- 1 PRE-ENGINEERED ROOF TRUSS, REF: STRUCTURAL FOR MEMBER SIZING, SPACING, AND LOCATION OF MECHANICAL UNIT CHASES
- 2 MECHANICAL DUCTING AND EQUIPMENT COORDINATE TRUSS OPENING REF: STRUCTURAL AND HVAC

#	DATE	ISSUE
1	8/11/2025	2ND FLOOR LAYOUT

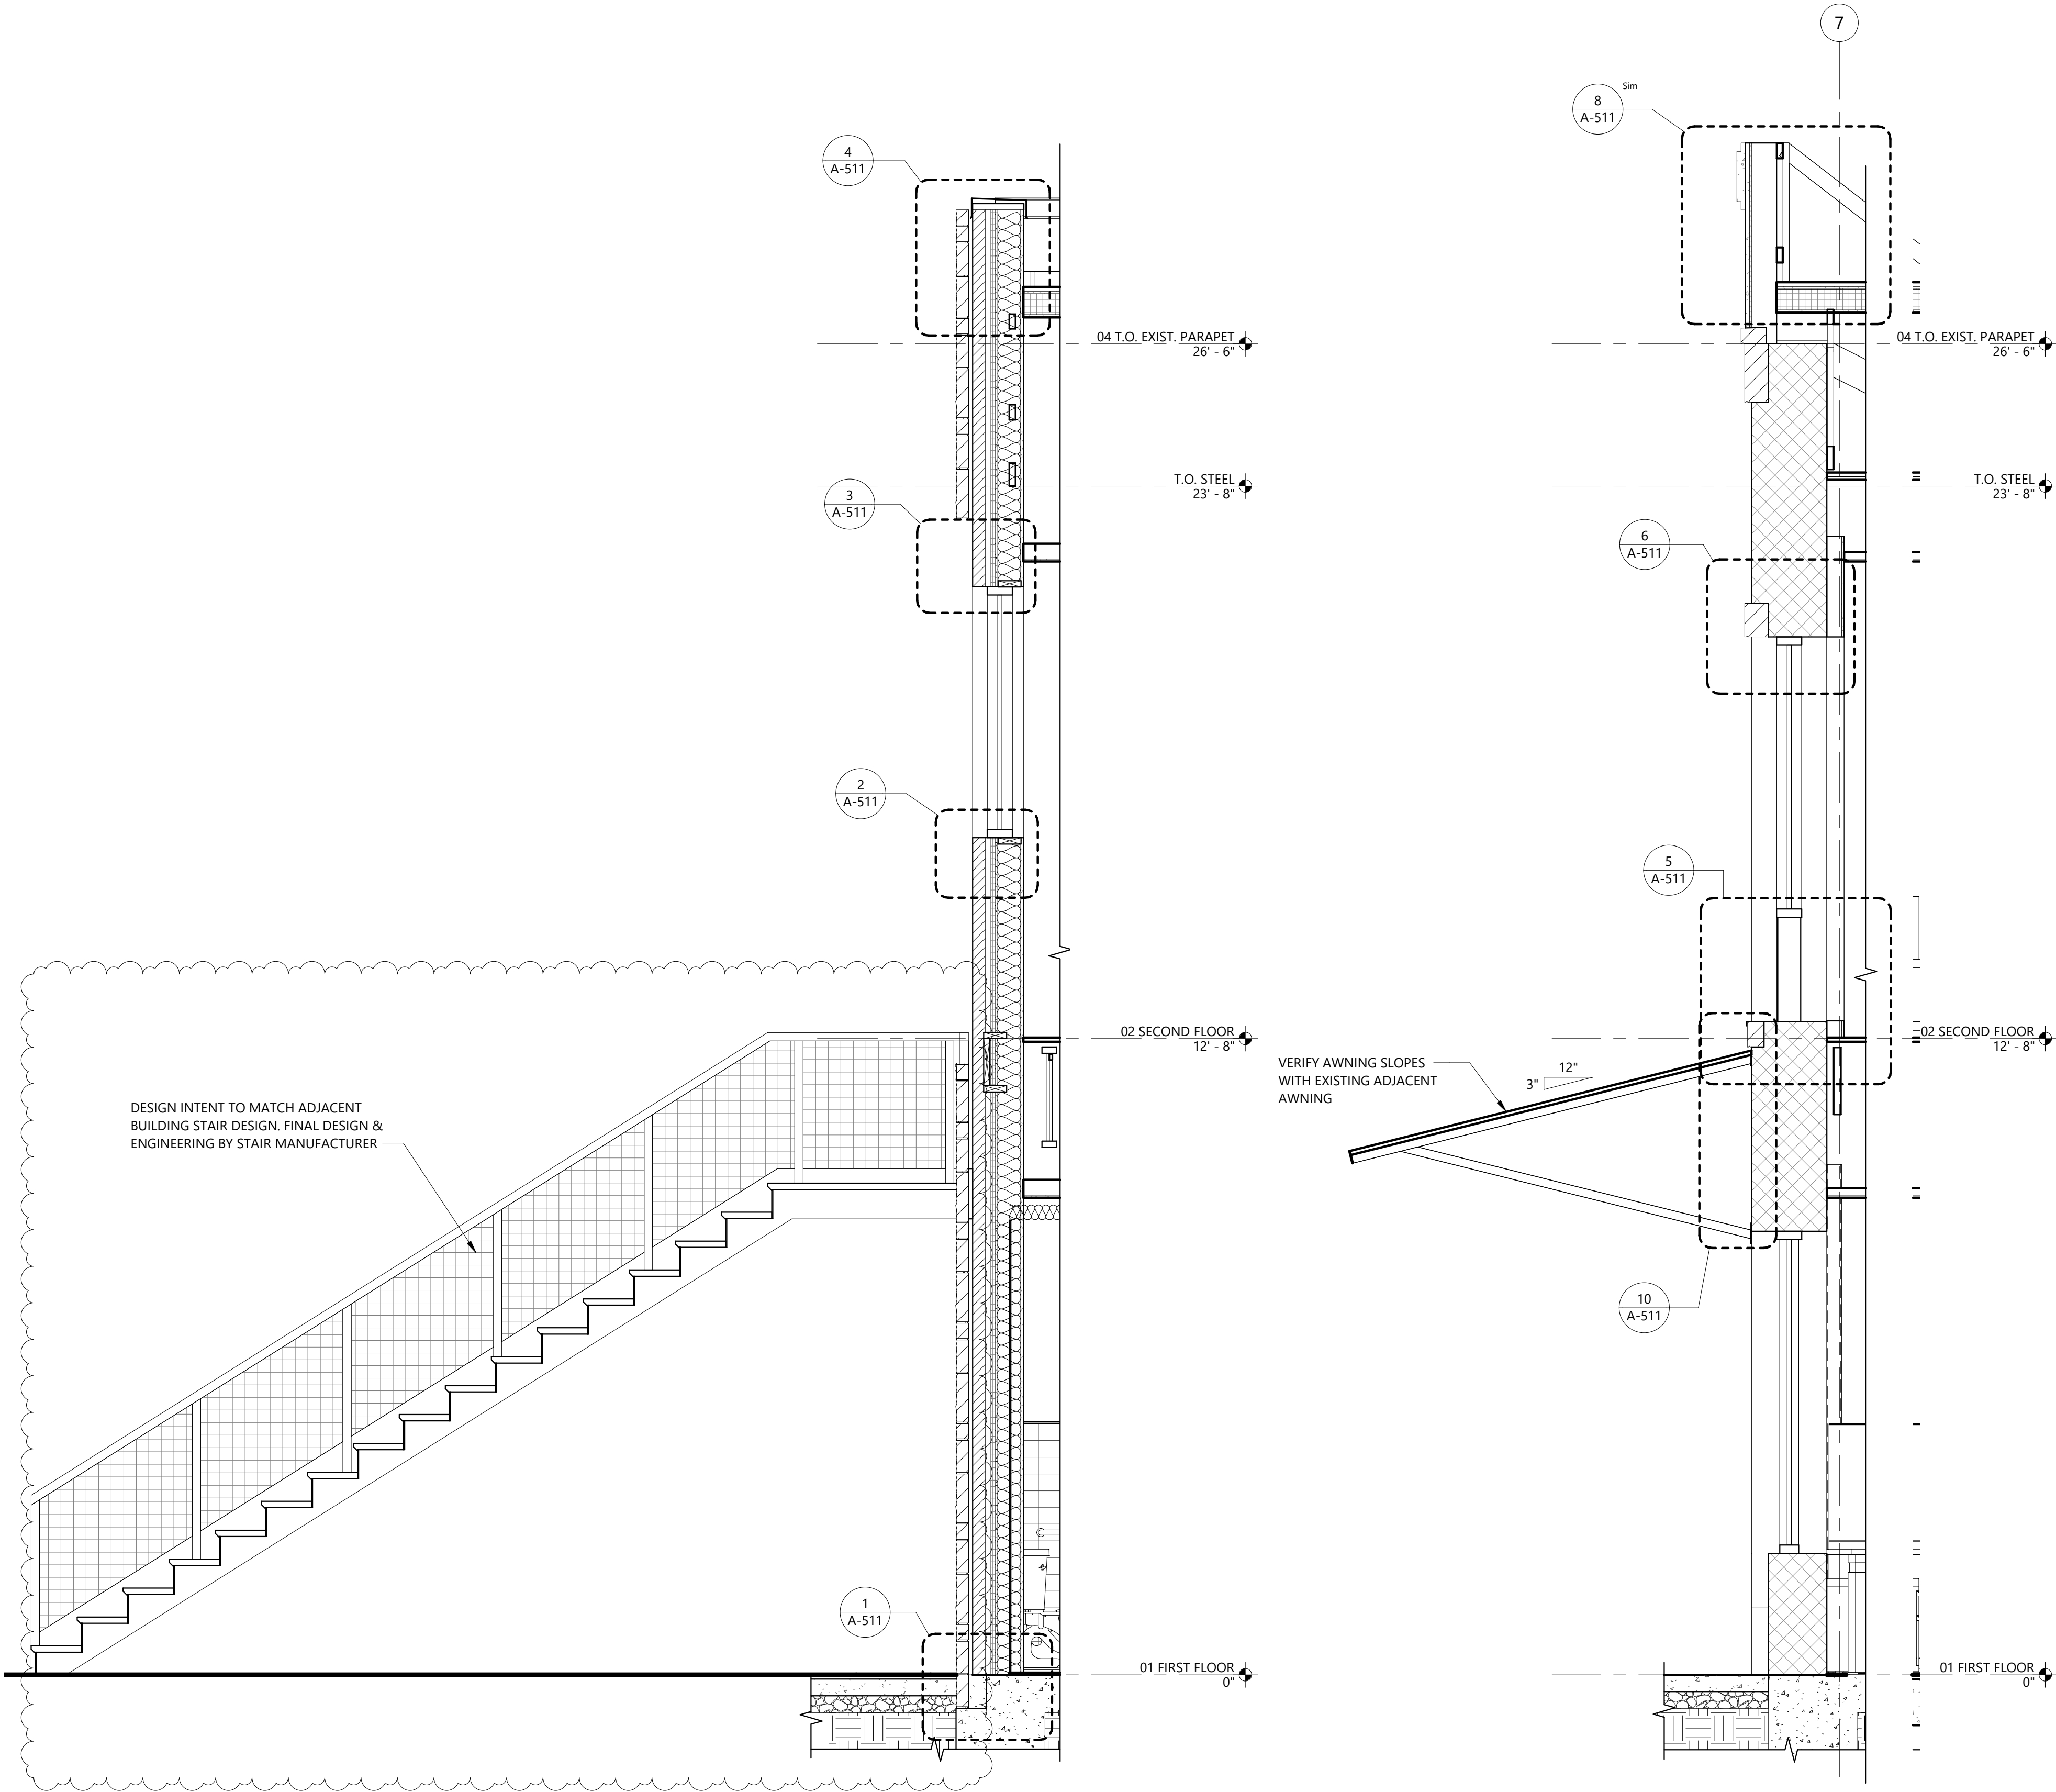

**2 SECTION B**  
SCALE: 1/2" = 1'-0"

**1 SECTION A**  
SCALE: 1/2" = 1'-0"




Project Number: LD10-23055  
© 2024 LEVY DYKEMA  
**ENLARGED PLANS**


**2 ENLARGED STAIR PLAN**  
SCALE: 1/2" = 1'-0"

**1 BREAKROOM & RESTROOMS - ENLARGED PLAN**  
SCALE: 1/2" = 1'-0"




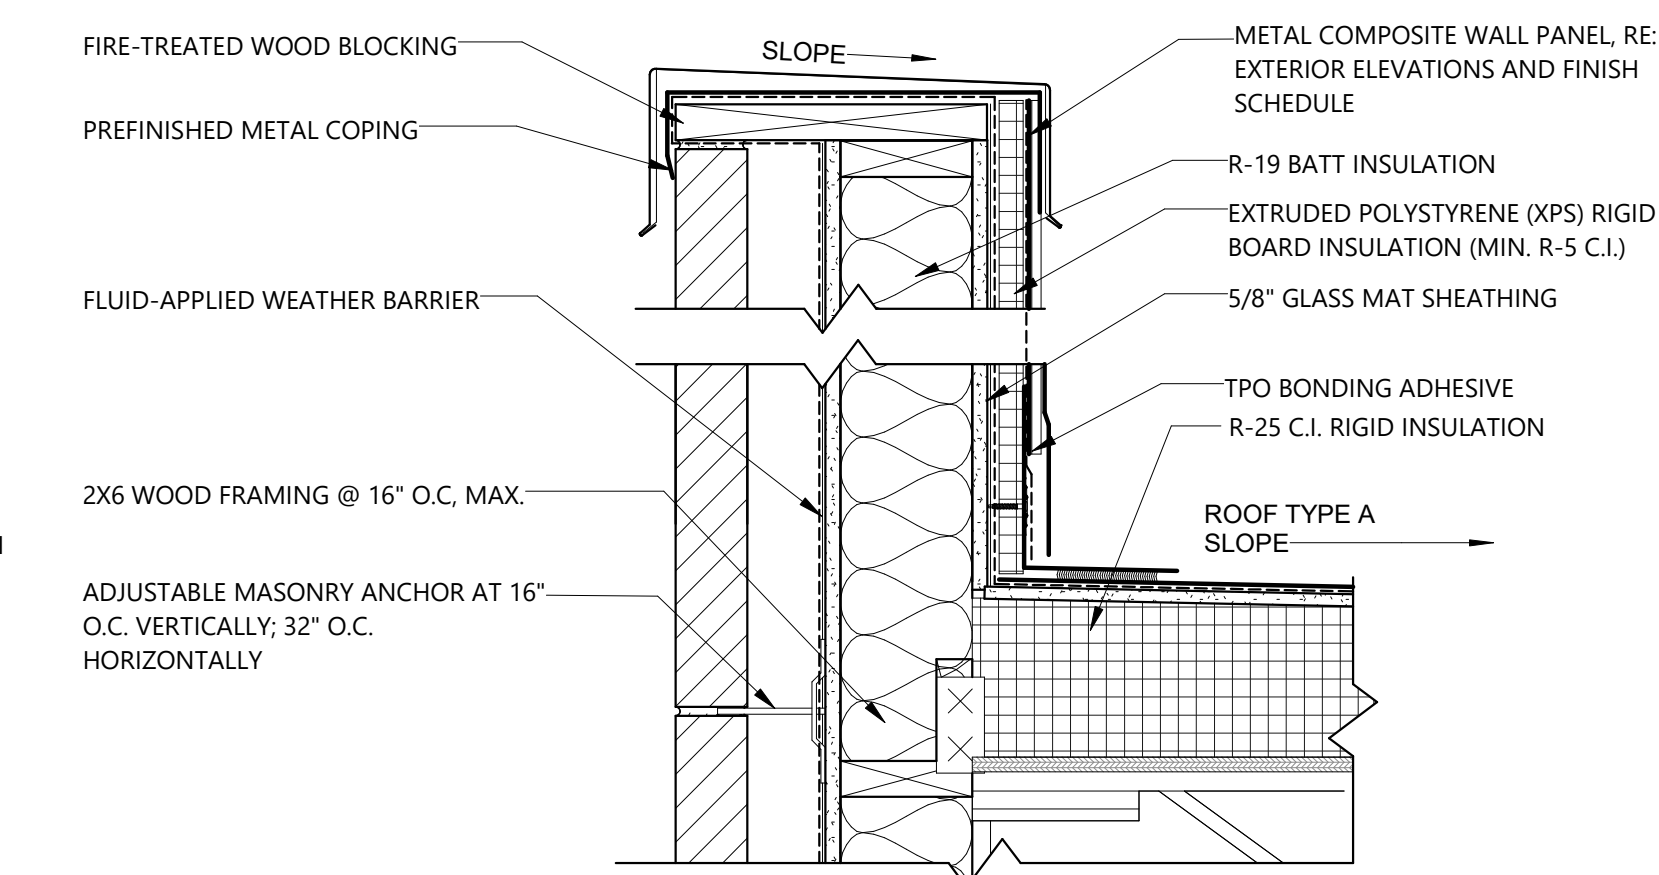


4 NEW PARAPET AT ROOF  
SCALE: 1 1/2" = 1'-0"

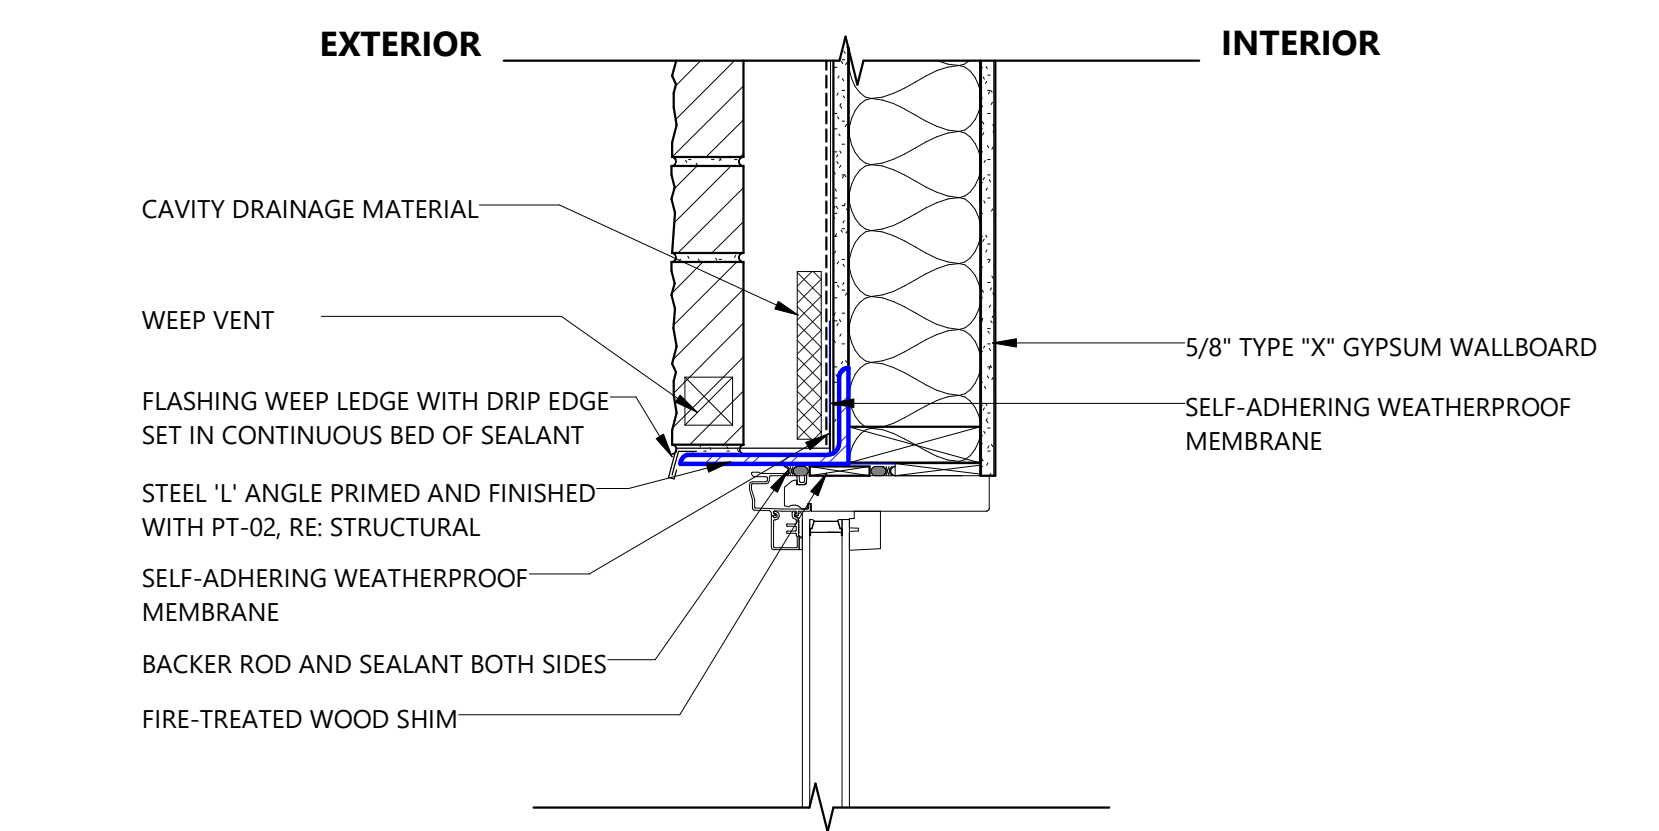


3 OPENING HEAD AT NEW WALL  
SCALE: 1 1/2" = 1'-0"

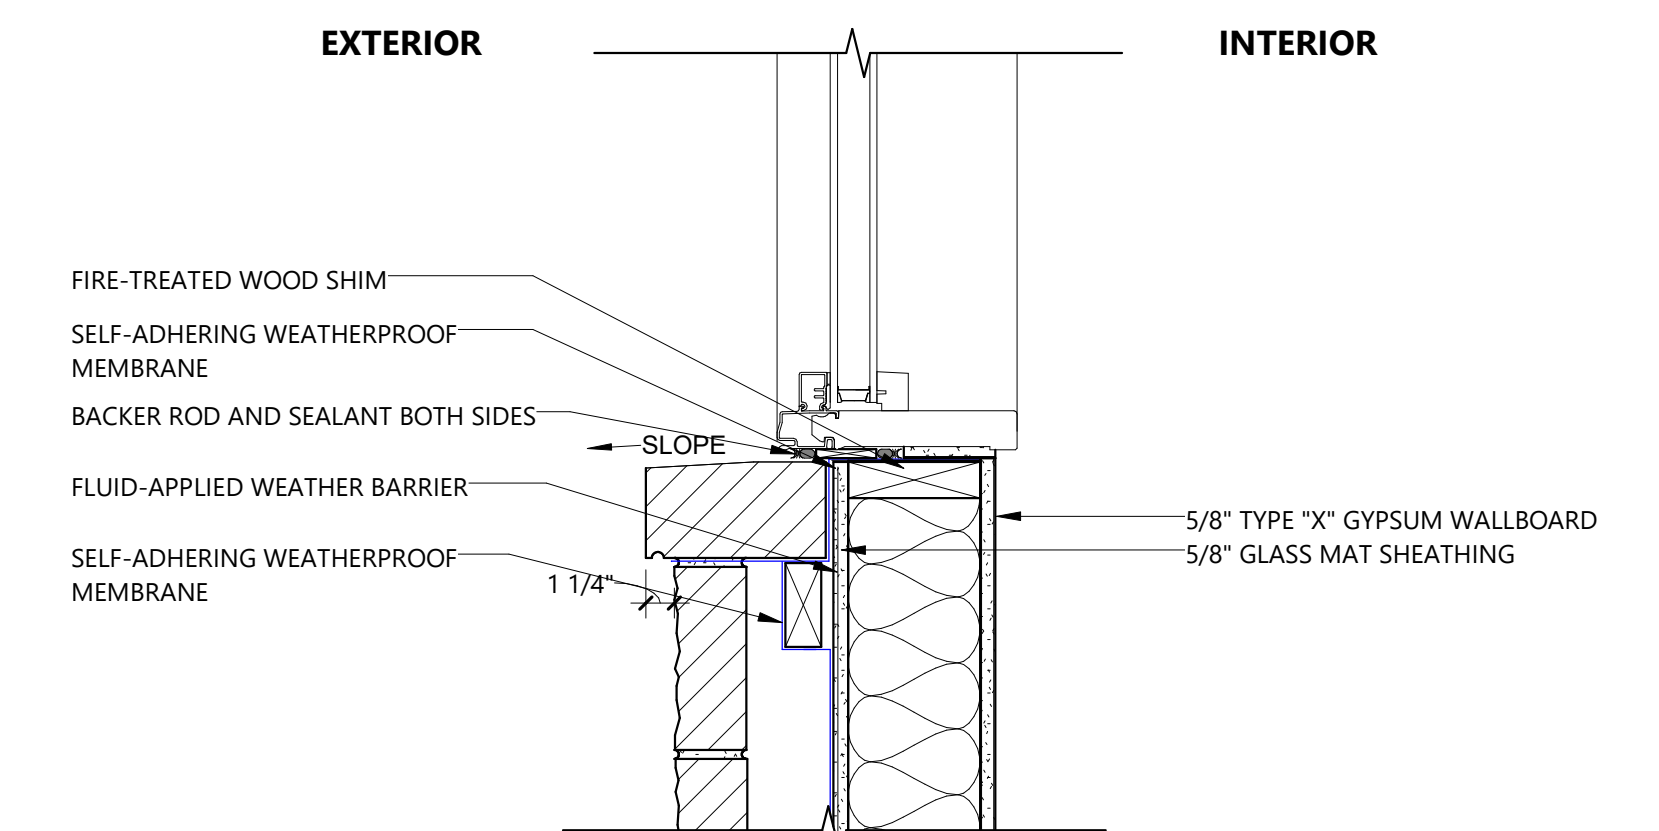


2 OPENING SILL AT NEW WALL  
SCALE: 1 1/2" = 1'-0"

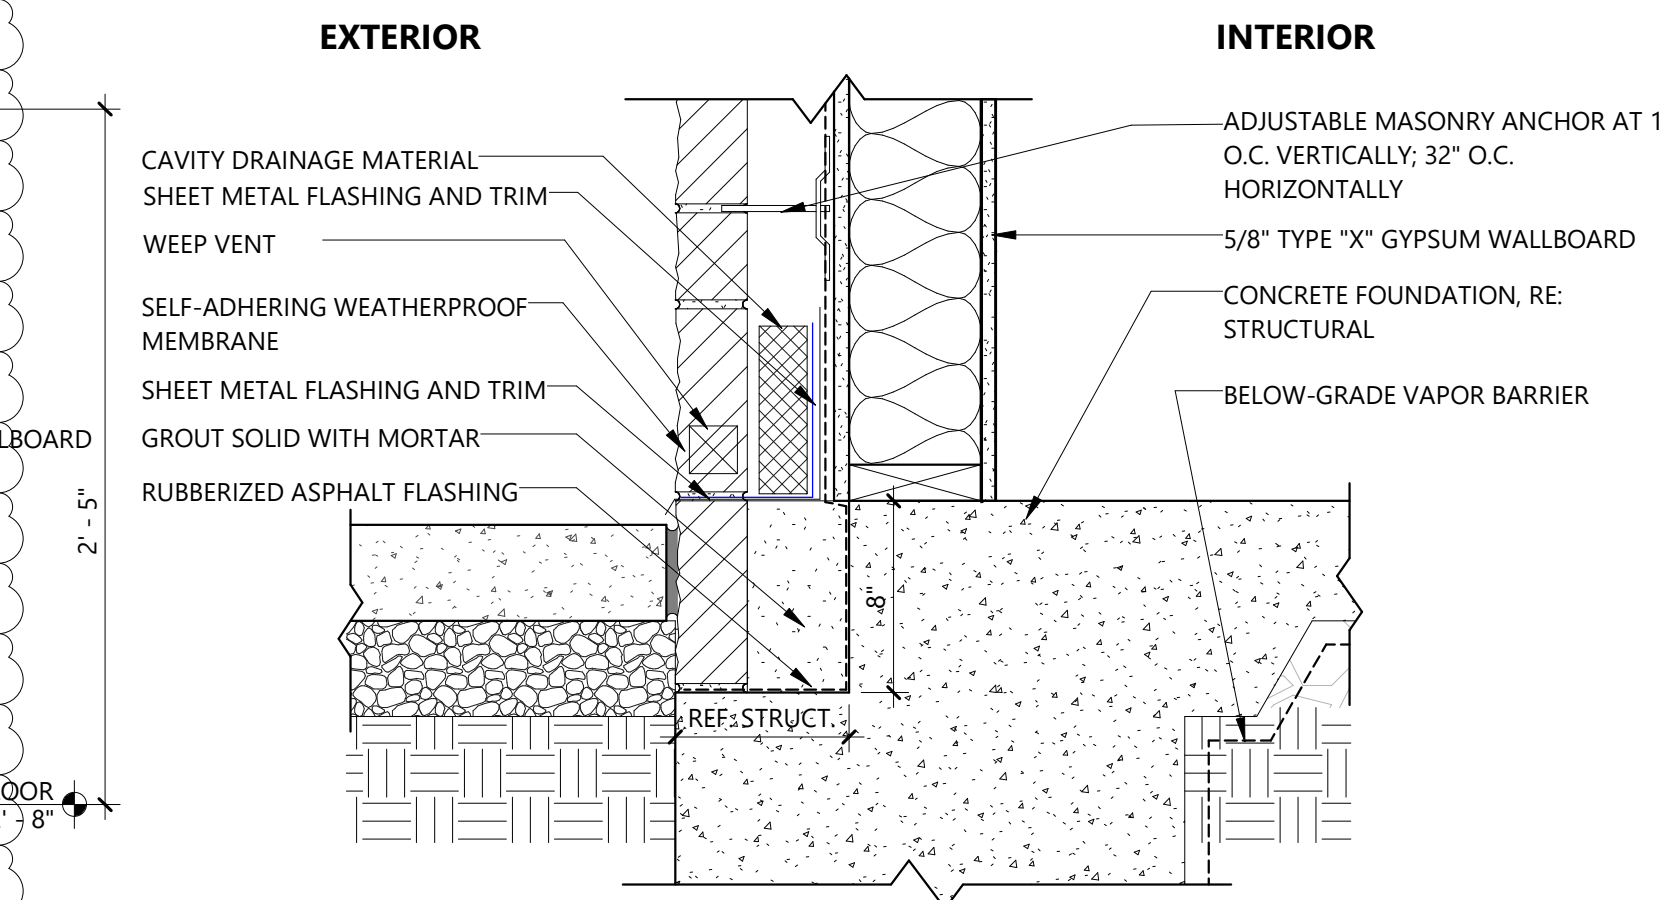


1 LIMESTONE BASE AT FOUNDATION  
SCALE: 1 1/2" = 1'-0"

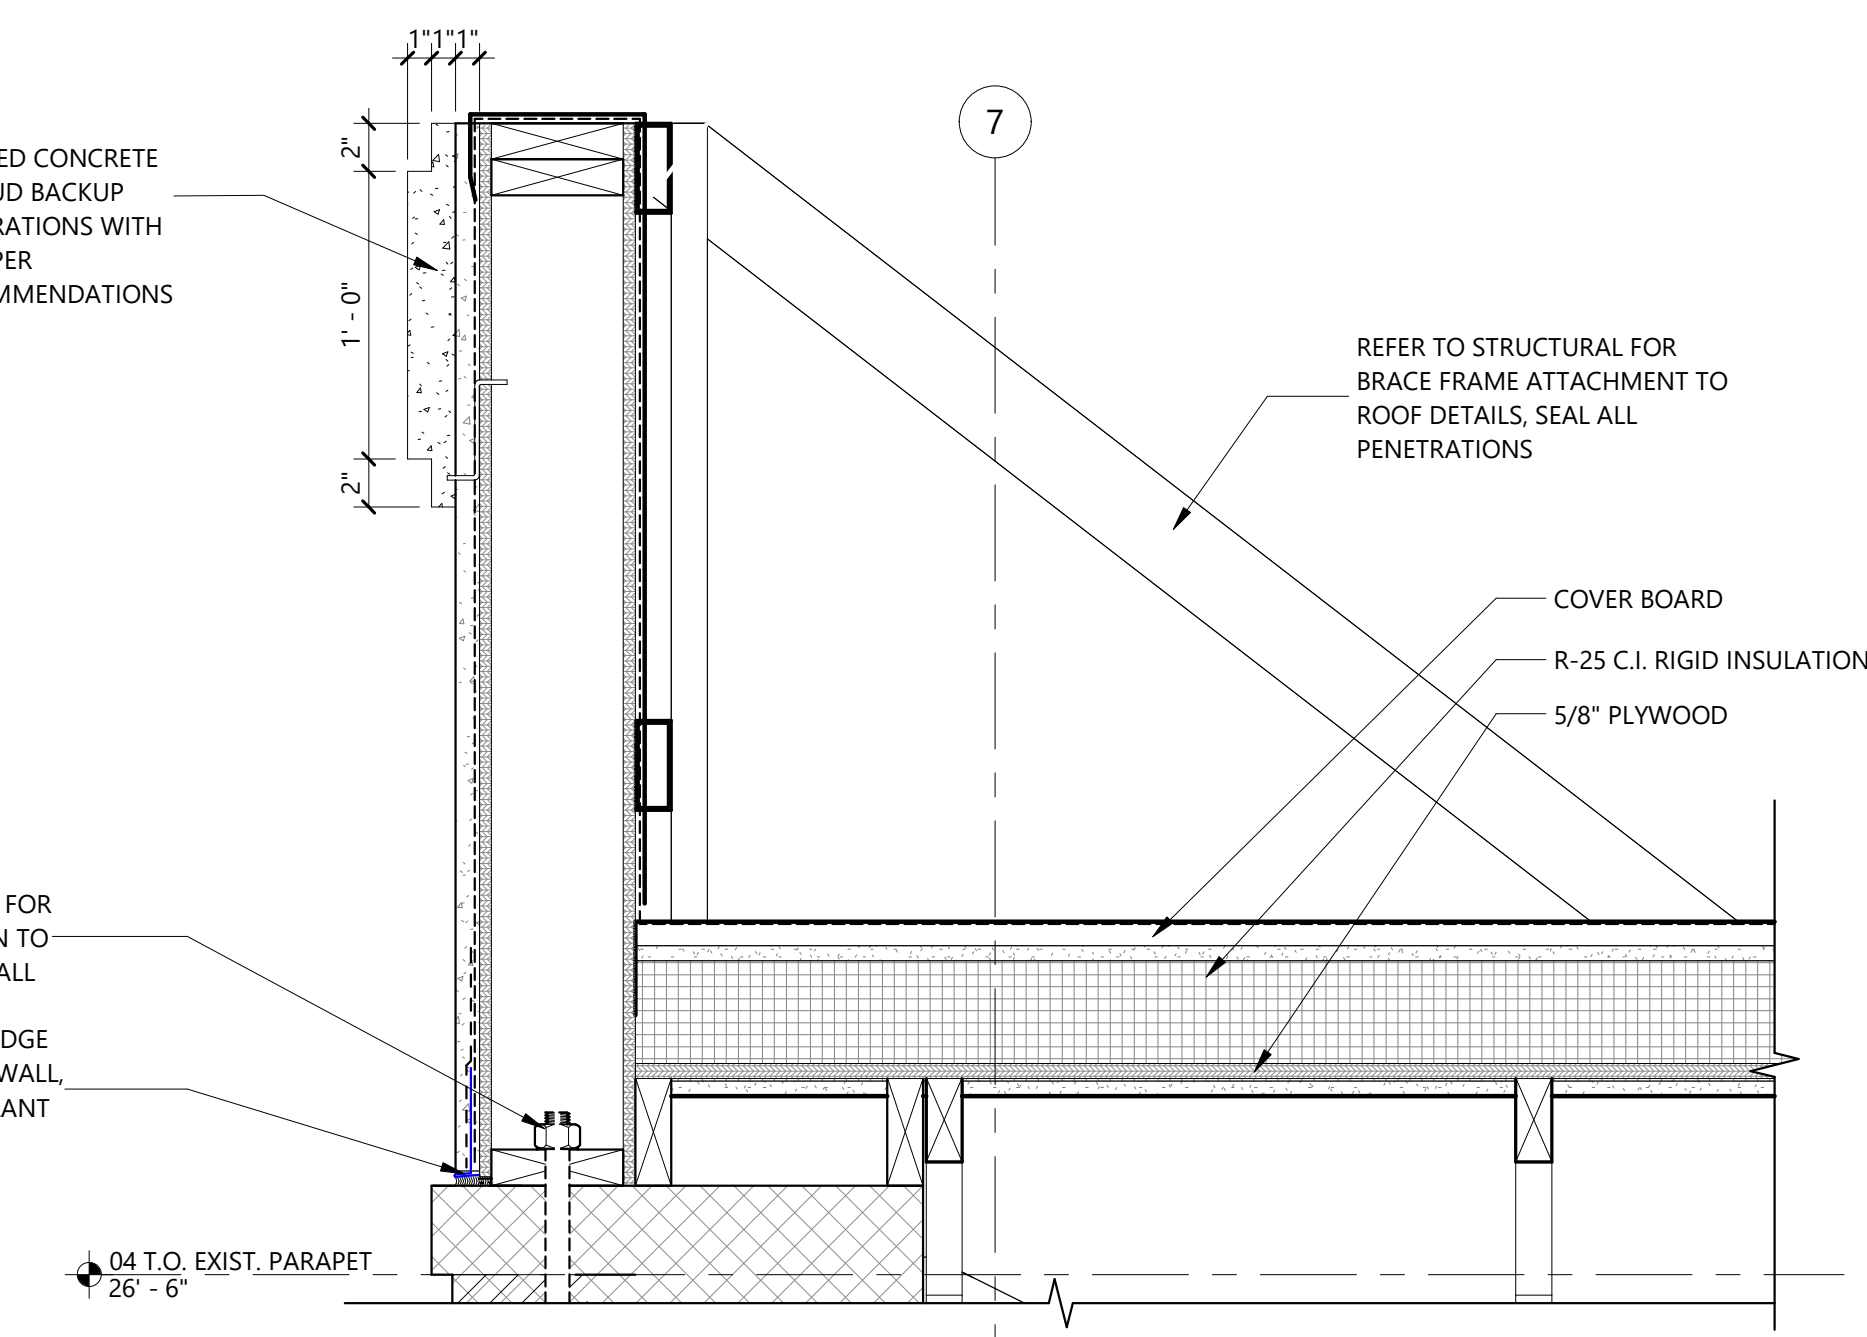


8 DETAIL - ARCHITECTURAL CONCRETE AT PARAPET  
SCALE: 1 1/2" = 1'-0"

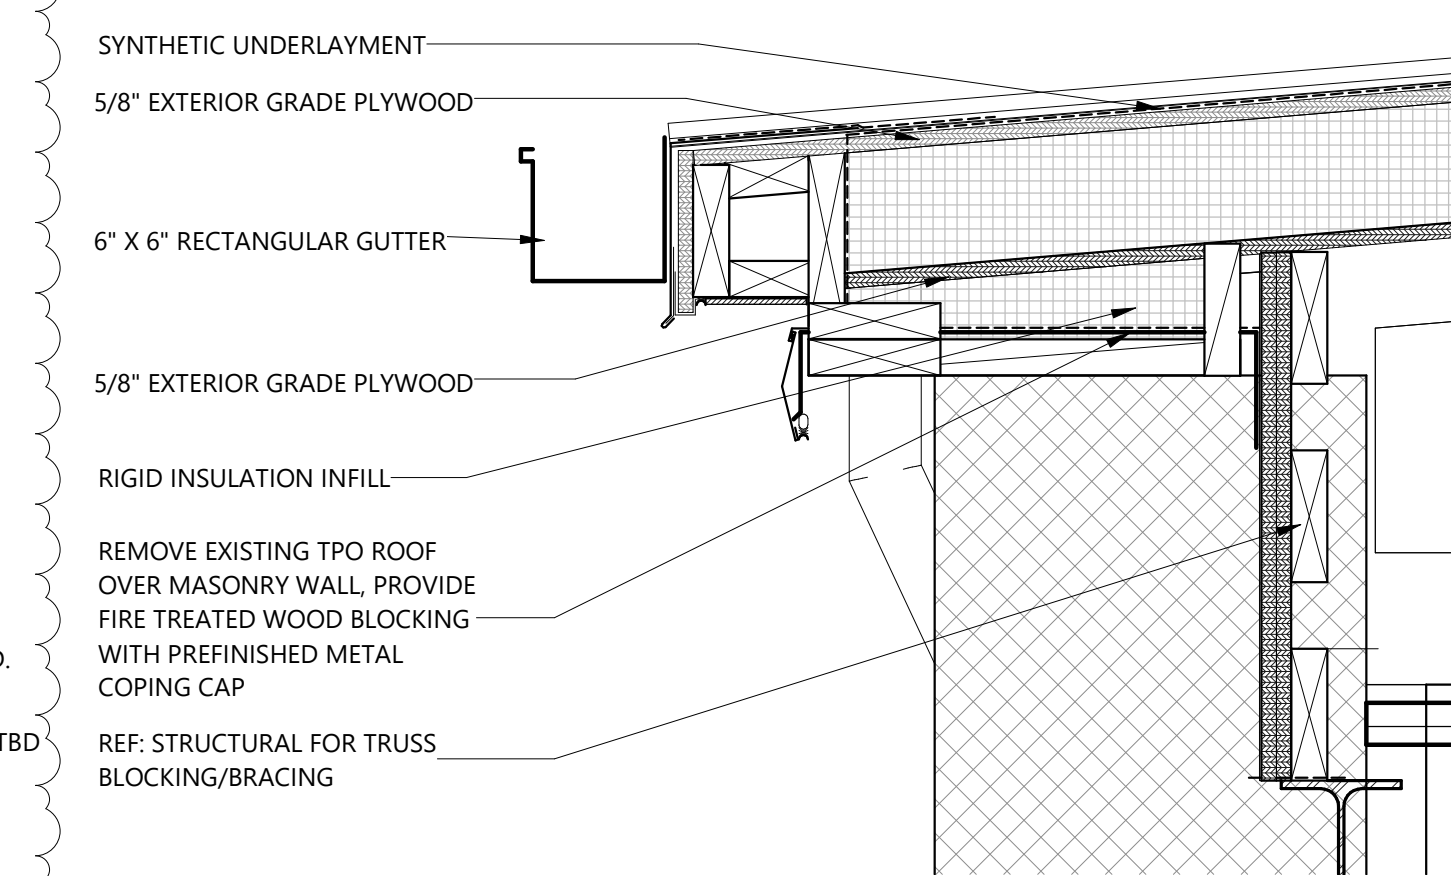


7 DETAIL - NEW EAVE AT EXISTING WALL  
SCALE: 1 1/2" = 1'-0"

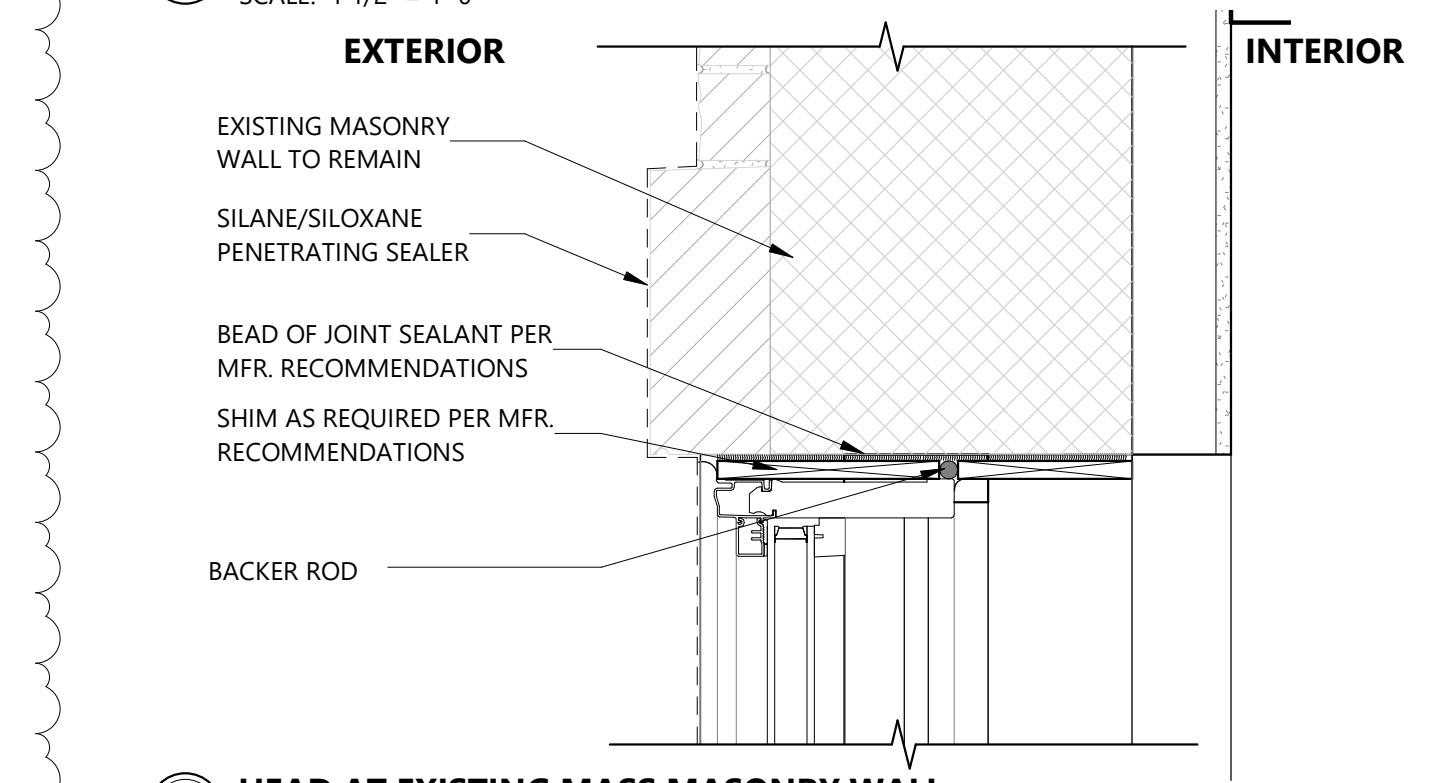


6 HEAD AT EXISTING MASS MASONRY WALL  
SCALE: 1 1/2" = 1'-0"

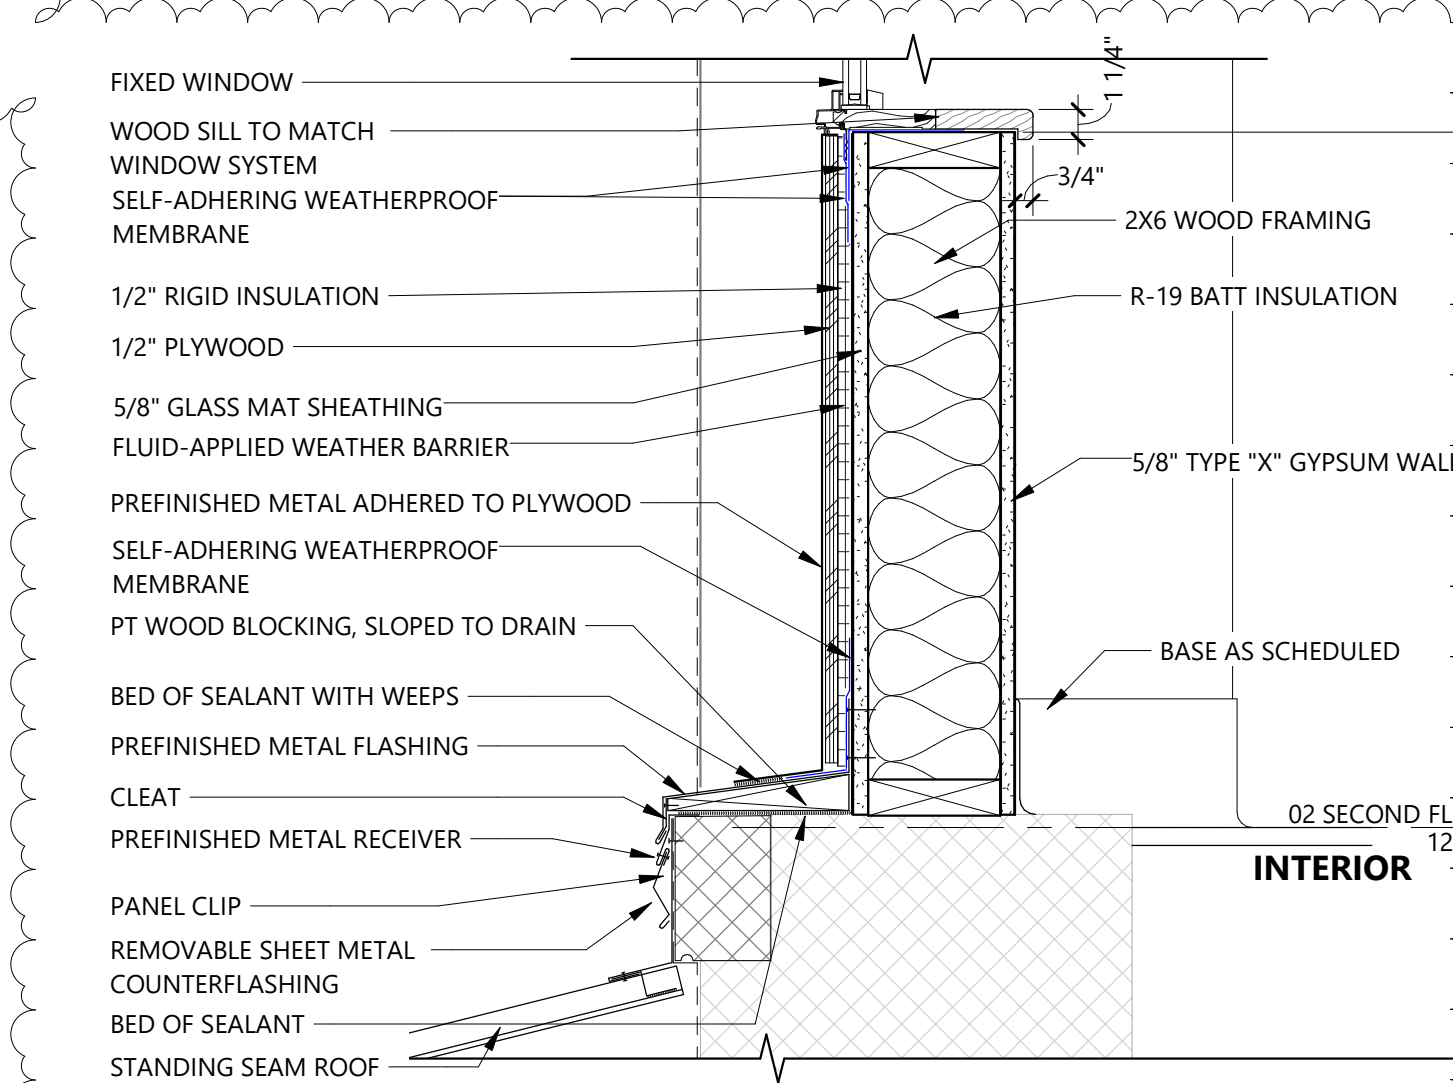


5 SILL AT EXISTING MASS MASONRY WALL  
SCALE: 1 1/2" = 1'-0"

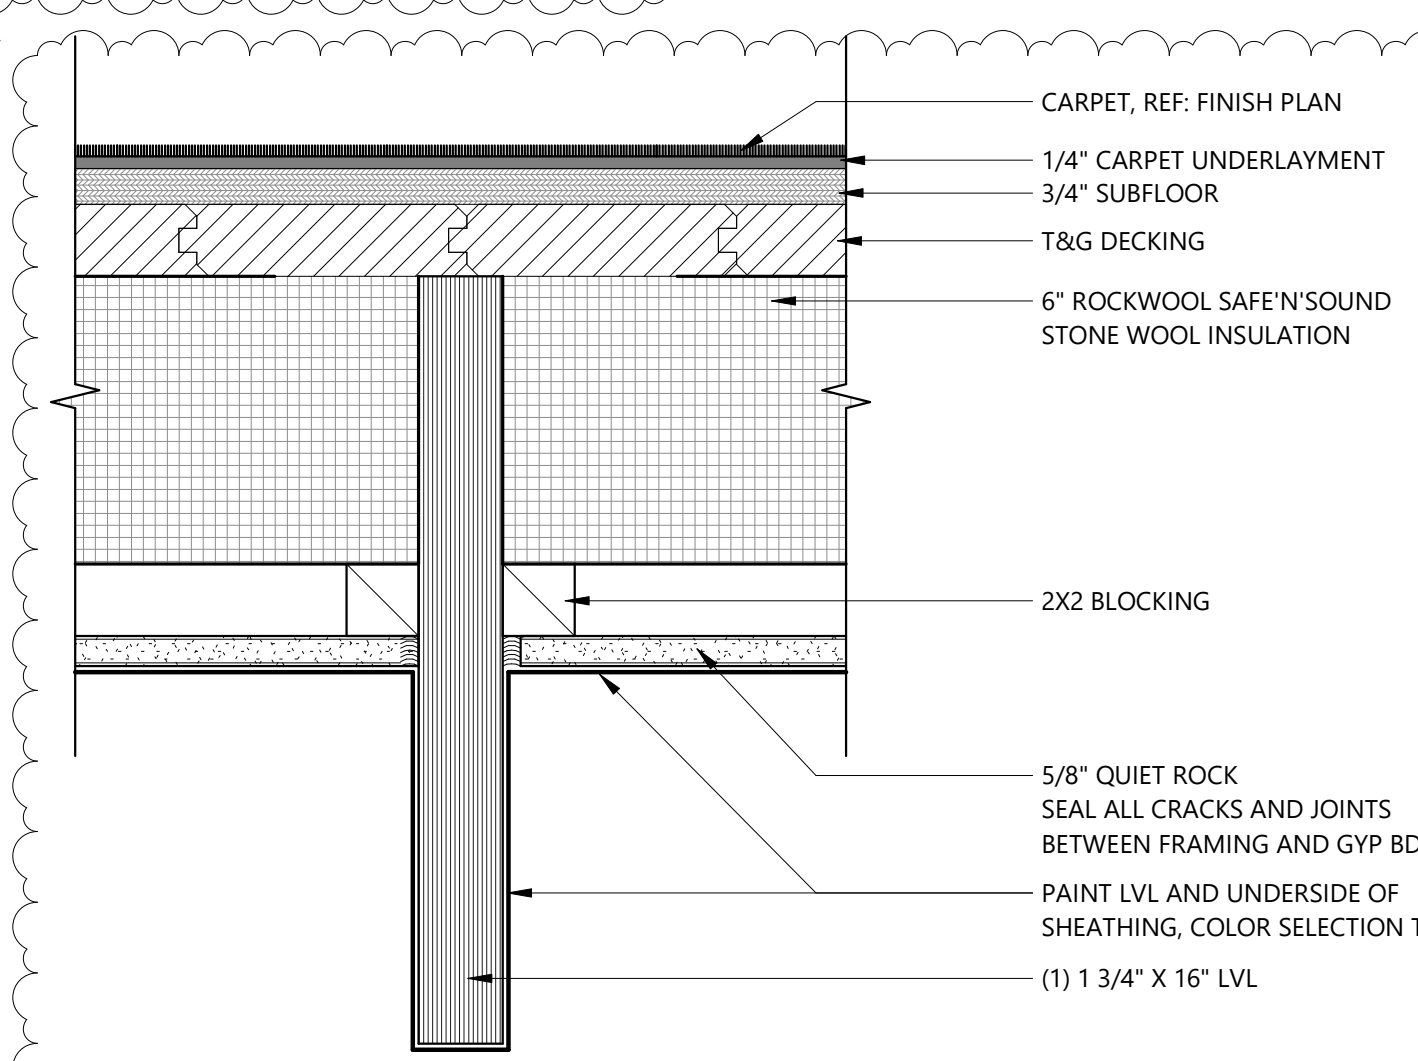


11 SECTION DETAIL - FLOOR ASSEMBLY  
SCALE: 3" = 1'-0"

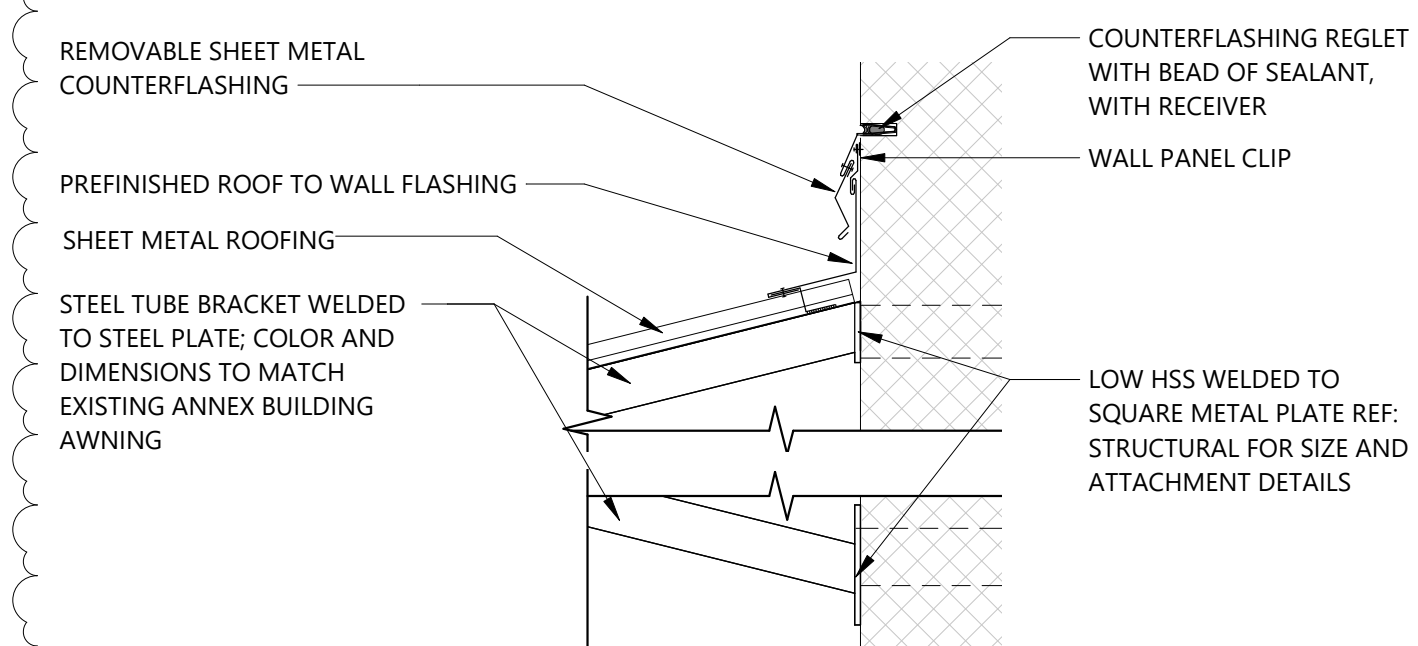


10 AWNING CONNECTION AT EXISTING WALL  
SCALE: 1 1/2" = 1'-0"

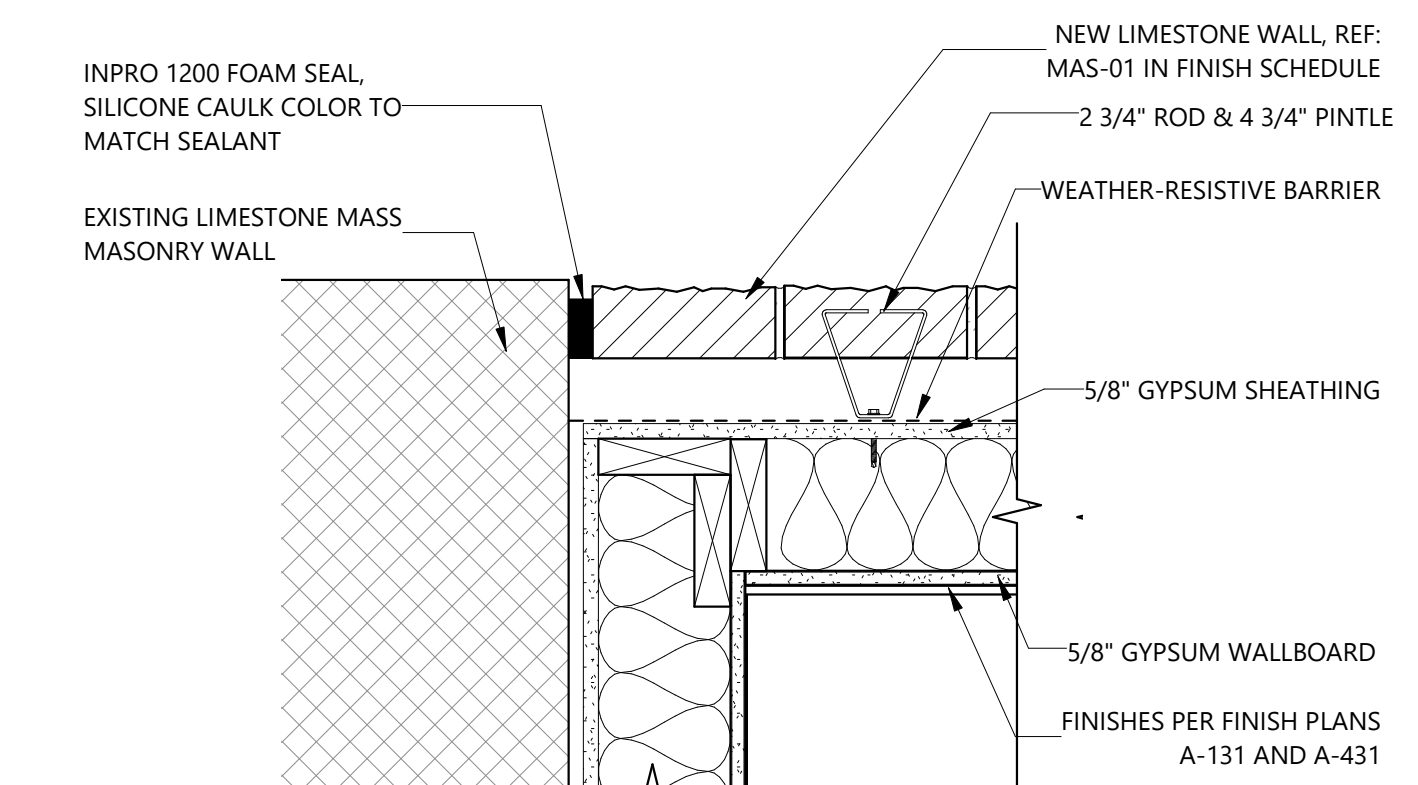

9 PLAN DETAIL - EXPANSION JOINT AT WALL TRANSITION  
SCALE: 1 1/2" = 1'-0"

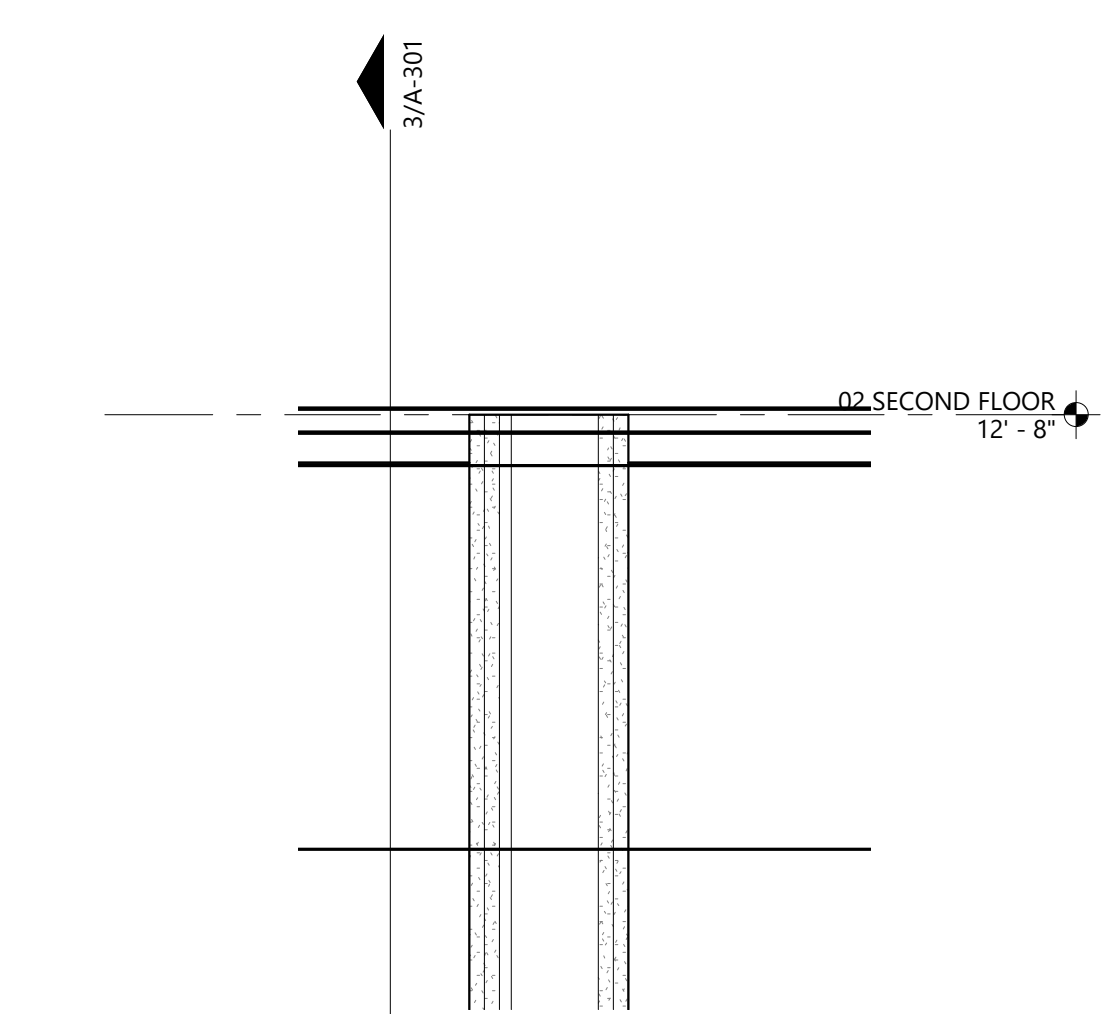

14 SECTION DETAIL - CONFERENCE ROOM EXT WALL CEILING  
SCALE: 1 1/2" = 1'-0"

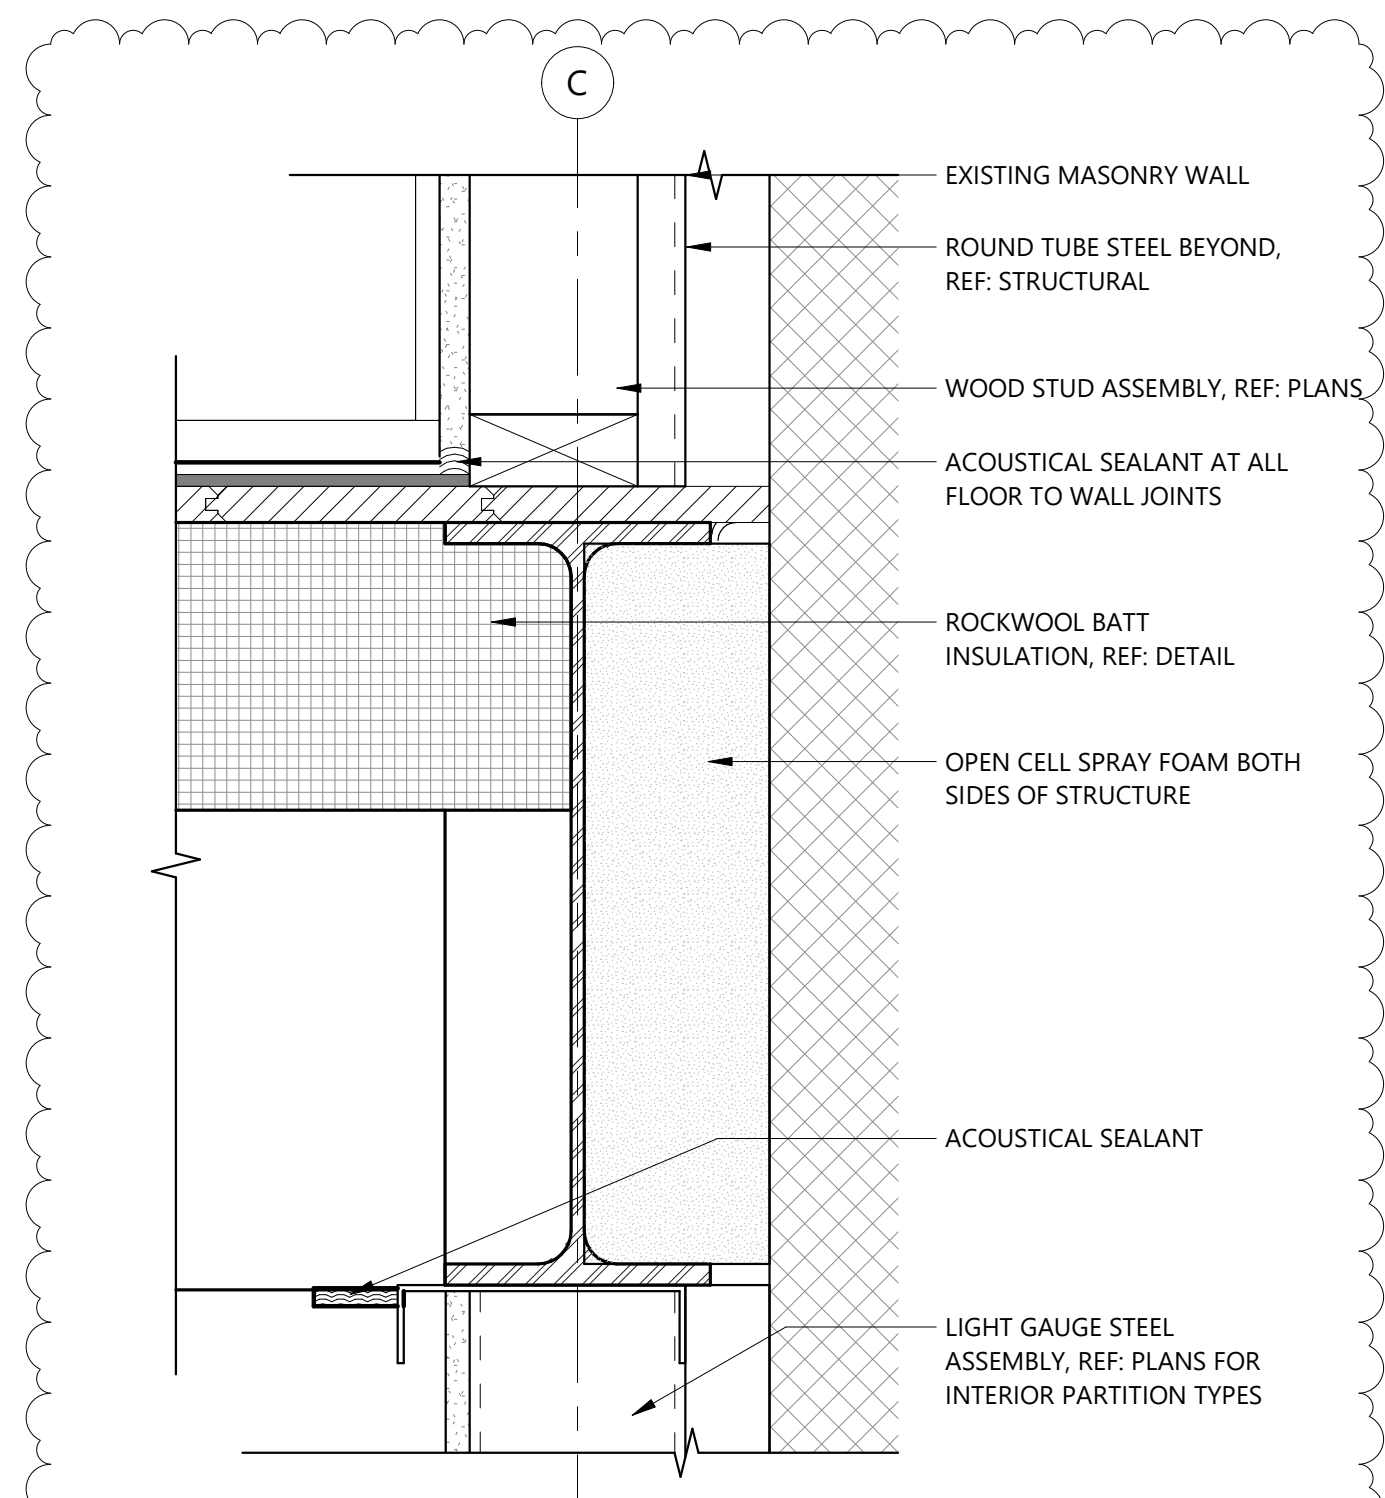

12 SECTION DETAIL - ACOUSTIC TREATMENT AT STRUCTURAL BEAM  
SCALE: 3" = 1'-0"






GENERAL NOTES:


- 25 FIREWALLS, FIRE BARRIERS, FIRE PARTITIONS, SMOKE BARRIERS AND SMOKE PARTITIONS OR ANY OTHER WALL REQUIRED TO HAVE PROTECTED OPENINGS OR PENETRATIONS SHALL BE EFFECTIVELY AND PERMANENTLY IDENTIFIED WITH SIGNS OR STENCILING. SUCH IDENTIFICATION SHALL:
1. BE LOCATED IN ACCESSIBLE CONCEALED FLOOR, FLOOR-CEILING OR ATTIC SPACES;
  2. BE REPEATED AT INTERVALS NOT EXCEEDING 30 FEET MEASURED HORIZONTALLY ALONG THE WALL OR PARTITION; AND
  3. INCLUDE LETTERING NOT LESS THAN 0.5 INCH IN HEIGHT, INCORPORATING THE SUGGESTED WORDING: "FIRE AND/OR SMOKE BARRIER-PROTECT ALL OPENINGS," OR OTHER WORDING.
- 26 SOUND-ISOLATION PARTITIONS SHALL BE SEALED AIRTIGHT FOR FULL HEIGHT TO PREVENT PASSAGE OF AIRBORNE SOUND. TAPE AND FINISH ALL GYP. BD. JOINTS AND FASTENERS. INSTALL ACOUSTIC SEALANT AT PERIMETER AND AT ALL PENETRATIONS, UNLESS NOTED FIRE RATED, THEN USE FIRE STOP SEALANT.
- 27 PROVIDE 2X4 MIN SIZE FIRE-TREATED WOOD BLOCKING OR 6" 20 GA. STEEL STUD/RUNNER REINFORCEMENT BEHIND ALL WALL HUNG ITEMS. SECURE WOOD BLOCKING WITH MIN. 2 SCREWS @ EA. END AND 4 SCREWS @ EA. END FOR STEEL STUDS OR RUNNERS. PROVIDE BLOCKING AND STEEL BACKING ADEQUATE TO SUPPORT LOADS IMPOSED ON WALL.
- 28 CONTROL JOINTS, WHERE REQUIRED, SHALL BE LOCATED ON EACH SIDE OF A DOOR OPENING. REFER TO CONSTRUCTION ELEVATIONS OF WALL OPENINGS INDICATED ON DETAILS SHEET.
- 30 FURRING @ COLUMNS EXTENDS 4" ABOVE CEILING WITH STUDS BRACED BACK TO COLUMN EXCEPT WHERE FURRING FORMS ONE SIDE OF A FIRE-RATED PARTITION ASSEMBLY. AT THOSE CONDITIONS, THE FURRING MUST EXTEND TO THE STRUCTURE ABOVE.
- 31 CHASE WALLS REQUIRE 12" GYP. PANEL CROSS BRACES (OR 2 1/2" MIN. STEEL STUD CROSS BRACES) BETWEEN STUD ROWS @ 48" O.C. VERTICALLY.

GENERAL NOTES:


- 1 UNLESS NOTED OTHERWISE, ALL NEW INTERIOR PARTITIONS ARE TYPE 'A3'.
- 2 ALL GYPSUM BOARD IS 5/8" THICK, TYPE 'X'. USE WATER-RESISTANT GYPSUM BOARD AT ALL WET LOCATIONS. USE CEMENT BACKER BOARD AT LOCATIONS SCHEDULED TO RECEIVE TILE OR OTHER RIGID FINISHES.
- 3 CEILING HEIGHTS MAY VARY ON EITHER OR BOTH SIDES OF THE PARTITION. REFER TO PLANS, REFLECTED CEILING PLANS AND OR CEILING FINISH NOTES FOR CEILING HEIGHTS.
- 4 FLOOR TO FLOOR DIMENSIONS MAY VARY. REFER TO BUILDING SECTIONS, WALL SECTIONS, AND OTHER CONSTRUCTION DOCUMENTS TO DETERMINE FLOOR TO FLOOR HEIGHTS.
- 5 PROVIDE VERTICAL CONTROL JOINTS IN ACCORDANCE WITH GA-216 IN ALL FULL HEIGHT GYPSUM BOARD PARTITIONS.
- 6 UNLESS INDICATED OTHERWISE, ALL JOINTS SHALL BE TAPED AND FLOATED, INCLUDING FIRE RATED PARTITIONS, NON RATED PARTITIONS, EXPOSED SURFACES, CONCEALED SURFACES AND SURFACES ABOVE THE CEILING.
- 7 ALL STUDS ARE CONTINUOUS FROM SILL PLATE TO BOTTOM OF STRUCTURE ABOVE, UNLESS INDICATED OTHERWISE. FILL ALL VOIDS BETWEEN THE TOP RUNNER TRACK AND THE BOTTOM OF STRUCTURE WITH THE APPROPRIATE SEALANT OR FIRE STOPPING SYSTEM. WHERE THE DISTANCE EXCEEDS AVAILABLE STUD LENGTHS, SUBMIT A PROPOSED SPLICE DETAIL FOR REVIEW AND APPROVAL BEFORE INSTALLATION OF PARTITION.
- 8 EXTEND FURRING TO 6" ABOVE CEILING. BRACE TO STRUCTURE OR WALL AT TOP AND AT MID-SPAN WHEN FURRING HEIGHT EXCEEDS 12'-0".
- 9 PARTITION TYPE REFERENCES ARE INDICATED ON THE FLOOR PLANS. WHERE AREAS THAT ARE ENLARGED ELSEWHERE ARE REFERENCED, PARTITION TYPES ARE INDICATED ON THE ENLARGED PLANS ONLY.
- 10 PARTITION TYPES DO NOT DETERMINE EXTERIOR WALL CONSTRUCTION. REFER TO WALL SECTIONS FOR EXTERIOR WALL CONSTRUCTION.
- 11 DETAILED PARTITION TYPES ARE PROVIDED FOR GENERAL REFERENCE. ALL TYPES SHOWN ARE NOT NECESSARILY USED ON THIS PROJECT. REFER TO FLOOR PLANS FOR ACTUAL PARTITION TYPES USED.
- 12 WHERE ROOMS ARE SCHEDULED WITHOUT CEILINGS, PARTITIONS SHALL EXTEND TO STRUCTURE ABOVE UNLESS NOTED OTHERWISE.
- 13 PENETRATIONS THROUGH PARTITIONS BY PIPES, CONDUIT, OR OTHER RIGID MEMBERS ARE TO BE THROUGH HOLES WHICH ARE AT LEAST 1" LARGER THAN THE PENETRATING MEMBER. THE HOLES ARE TO BE FILLED WITH FIBERGLASS AROUND THE MEMBER SO THAT THE MEMBER DOES NOT TOUCH THE WALL AND THEN THE FILLER IS TO BE SEALED OVER FULLY ON EACH SIDE OF THE WALL.
- 14 THE ACTUAL THICKNESS OF PARTITIONS ARE INDICATED ON THE PLANS AND DO NOT INCLUDE FINISH MATERIALS. REFER TO THE ROOM FINISH SCHEDULE FOR FINISH MATERIALS.
- 15 PARTITION TYPES DO NOT INCLUDE PARTIAL HEIGHT WALLS. REFER TO DETAILS FOR PARTIAL HEIGHT WALL INFORMATION.
- 16 ALL CONCRETE MASONRY PARTITIONS EXTEND FROM THE FLOOR SLAB TO THE BOTTOM OF STRUCTURE ABOVE. THE BOTTOM OF STRUCTURE IS DEFINED AS THE BOTTOM OF THE ROOF DECK OR FLOOR DECK ABOVE. SEE PARTITION DETAILS AND STRUCTURAL DRAWINGS FOR ANCHORAGE AT TOP OF CONCRETE MASONRY PARTITIONS.
- 17 WHEREVER LENGTH OF MASONRY PARTITIONS EXCEED 8'-0" BETWEEN LATERAL SUPPORTS AT PARTITION TOP, INSTALL 3"x3"x6" 12 GA. FORMED STEEL ANGLES ON EACH SIDE @ 4'-0" O.C. MAX. ANCHOR EACH ANGLE TO THE STRUCTURE WITH TWO FASTENERS @ 3" O.C. MAX. MASONRY SHALL STOP 1" BELOW THE STRUCTURE INCLUDING PROJECTING CONCRETE JOISTS, AND THE 1" SPACE SHALL BE FILLED WITH NON-COMBUSTIBLE COMPRESSIBLE FILLER. IF THE ANGLES CANNOT BE INSTALLED ON EACH SIDE OF THE MASONRY WALL, PROVIDE 9" LONG 12 GA. FORMED STEEL CHANNELS WITH 3" FLANGES AND WEB WIDTH EQUAL TO MASONRY WIDTH. SPACE @ 4'-0" O.C. MAX AND ANCHOR WITH THREE FASTENERS. ALL FASTENERS SHALL HAVE MIN. 3" IMBED INTO CONCRETE STRUCTURE. WELD OR SCREW FASTENERS INTO STEEL STRUCTURE.
- 18 THE LOCATION OF FIRE RATED PARTITIONS ARE INDICATED ON THE FLOOR PLANS BY LINE SYMBOLS IN THE CENTER OF THE WALL OR BY GENERAL NOTE. THESE LOCATIONS SHALL COMPLY WITH THE UL DESIGN ASSEMBLY AS INDICATED BY THE PARTITION TYPE, INCLUDING THE APPLICATION OF FIRE STOPPING SEALANT AT THE PERIMETER OF THE PARTITION.
- 19 CONSTRUCTION OF FIRE RATED PARTITIONS, INCLUDING TAPING, FLOATING, AND FINISHING OF GYPSUM BOARD FOR FULL HEIGHT TO STRUCTURE ABOVE SHALL BE IN ACCORDANCE WITH THE REQUIREMENTS OF THE TESTED ASSEMBLY TO ACHIEVE THE REQUIRED RATING.
- 20 AT ALL LOCATIONS WHERE FIRE RATED PARTITIONS ABUT OR ATTACH TO A FIRE RATED STRUCTURAL MEMBER THE FIRE RATING OF BOTH THE PARTITION AND THE STRUCTURAL MEMBER SHALL BE MAINTAINED.
- 21 WHERE ITEMS ARE RECESSED INTO A FIRE RATED PARTITION PROVIDE ADDITIONAL GYPSUM, FIREPROOFING, OR FIRE STOPPING AROUND THE RECESSED PORTION OF THE ITEM AS REQUIRED TO MAINTAIN THE INDICATED FIRE RATING.
- 22 FIRE RESISTANT SOUND ATTENUATION BLANKETS AND NON RATED SOUND ATTENUATION BLANKETS SHALL BE CONTINUOUS FOR THE FULL HEIGHT OF THE PARTITION AND 3" THICK.
- 23 CONTROL JOINTS AND EXPANSION JOINTS IN FIRE RATED PARTITIONS SHALL BE CONSTRUCTED TO MAINTAIN THE FIRE RATING OF THE PARTITION. CONTROL JOINTS AND EXPANSION JOINTS IN NON RATED PARTITIONS SHALL BE CONSTRUCTED WITH SOUND ATTENUATION BLANKET MATERIAL WITHIN THE JOINT TO REDUCE SOUND TRANSMISSION.
- 23 TYPICAL REINFORCEMENT FOR DOOR OPENINGS IN GYP. BD. WALL PARTITIONS:
  1. DOORS UP TO 3'-0" WIDE WEIGHING NOT MORE THAN 100 LBS.: DOUBLE 20 GA. STEEL STUDS AND 20 GA. RUNNERS.
  2. DOORS 2'-8" WIDE TO 4'-0" WIDE WEIGHING NOT MORE THAN 200 LBS.: DOUBLE 20 GA. STEEL STUDS AND 20 GA. RUNNERS.
  3. DOORS UP TO 4'-0" WIDE WEIGHING NOT MORE THAN 300 LBS.: DOUBLE 20 GA. STEEL STUDS AND 20 GA. RUNNERS.
  4. DOORS OVER 4'-0" WIDE WEIGHING MORE THAN 300 LBS.: DOUBLE 16 GA. STEEL STUDS AND 16 GA. RUNNERS.
- 24 PROVIDE VERTICAL CONTROL JOINTS IN CONCRETE MASONRY PARTITIONS AT A SPACING NOT TO EXCEED 20'-0" O.C..

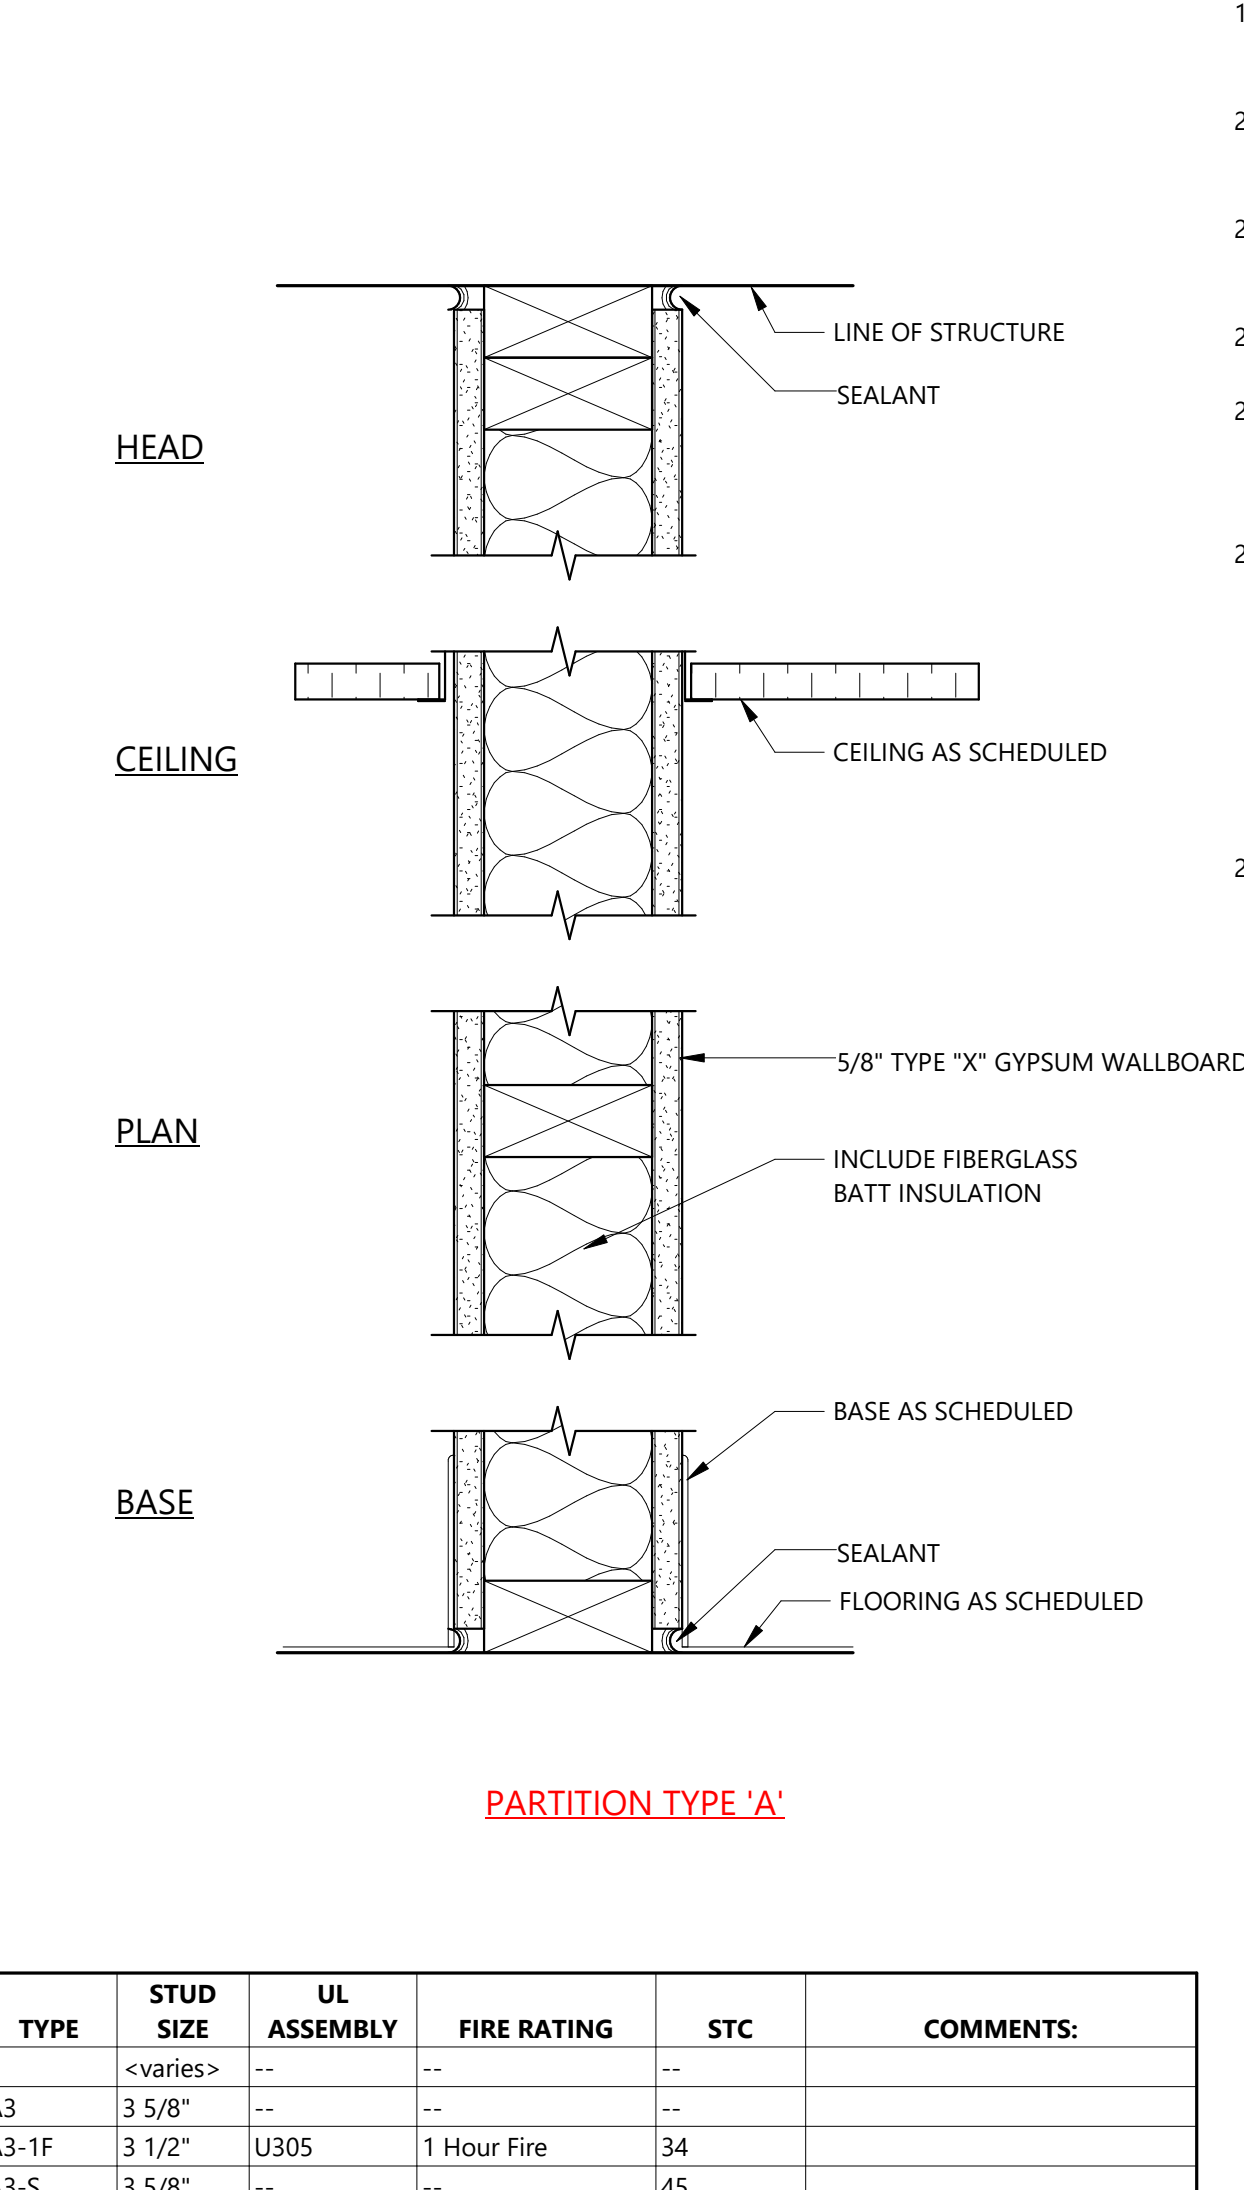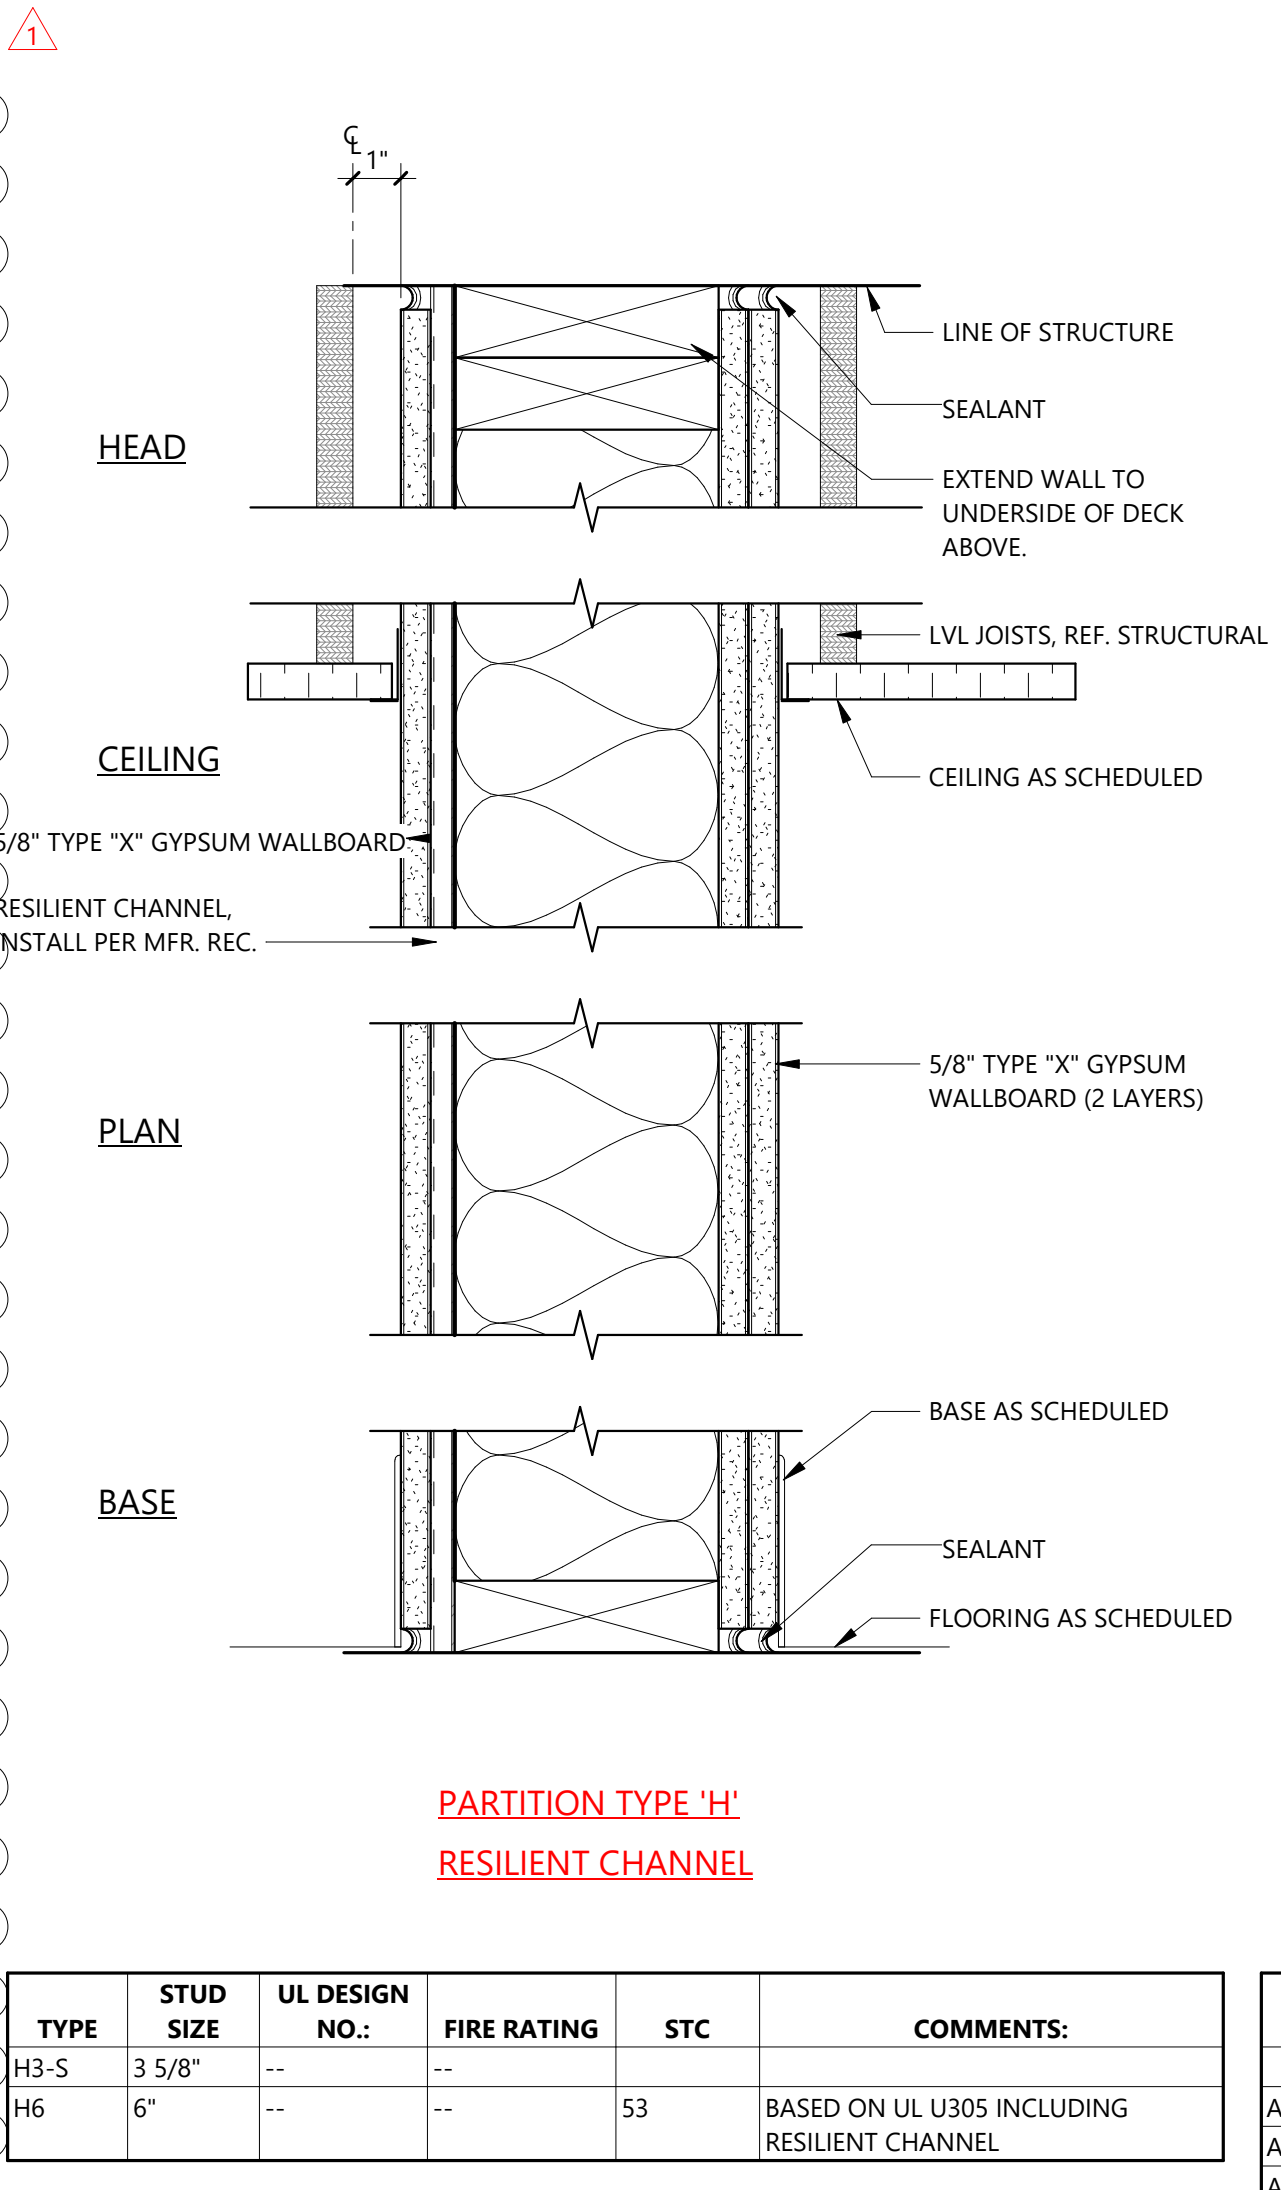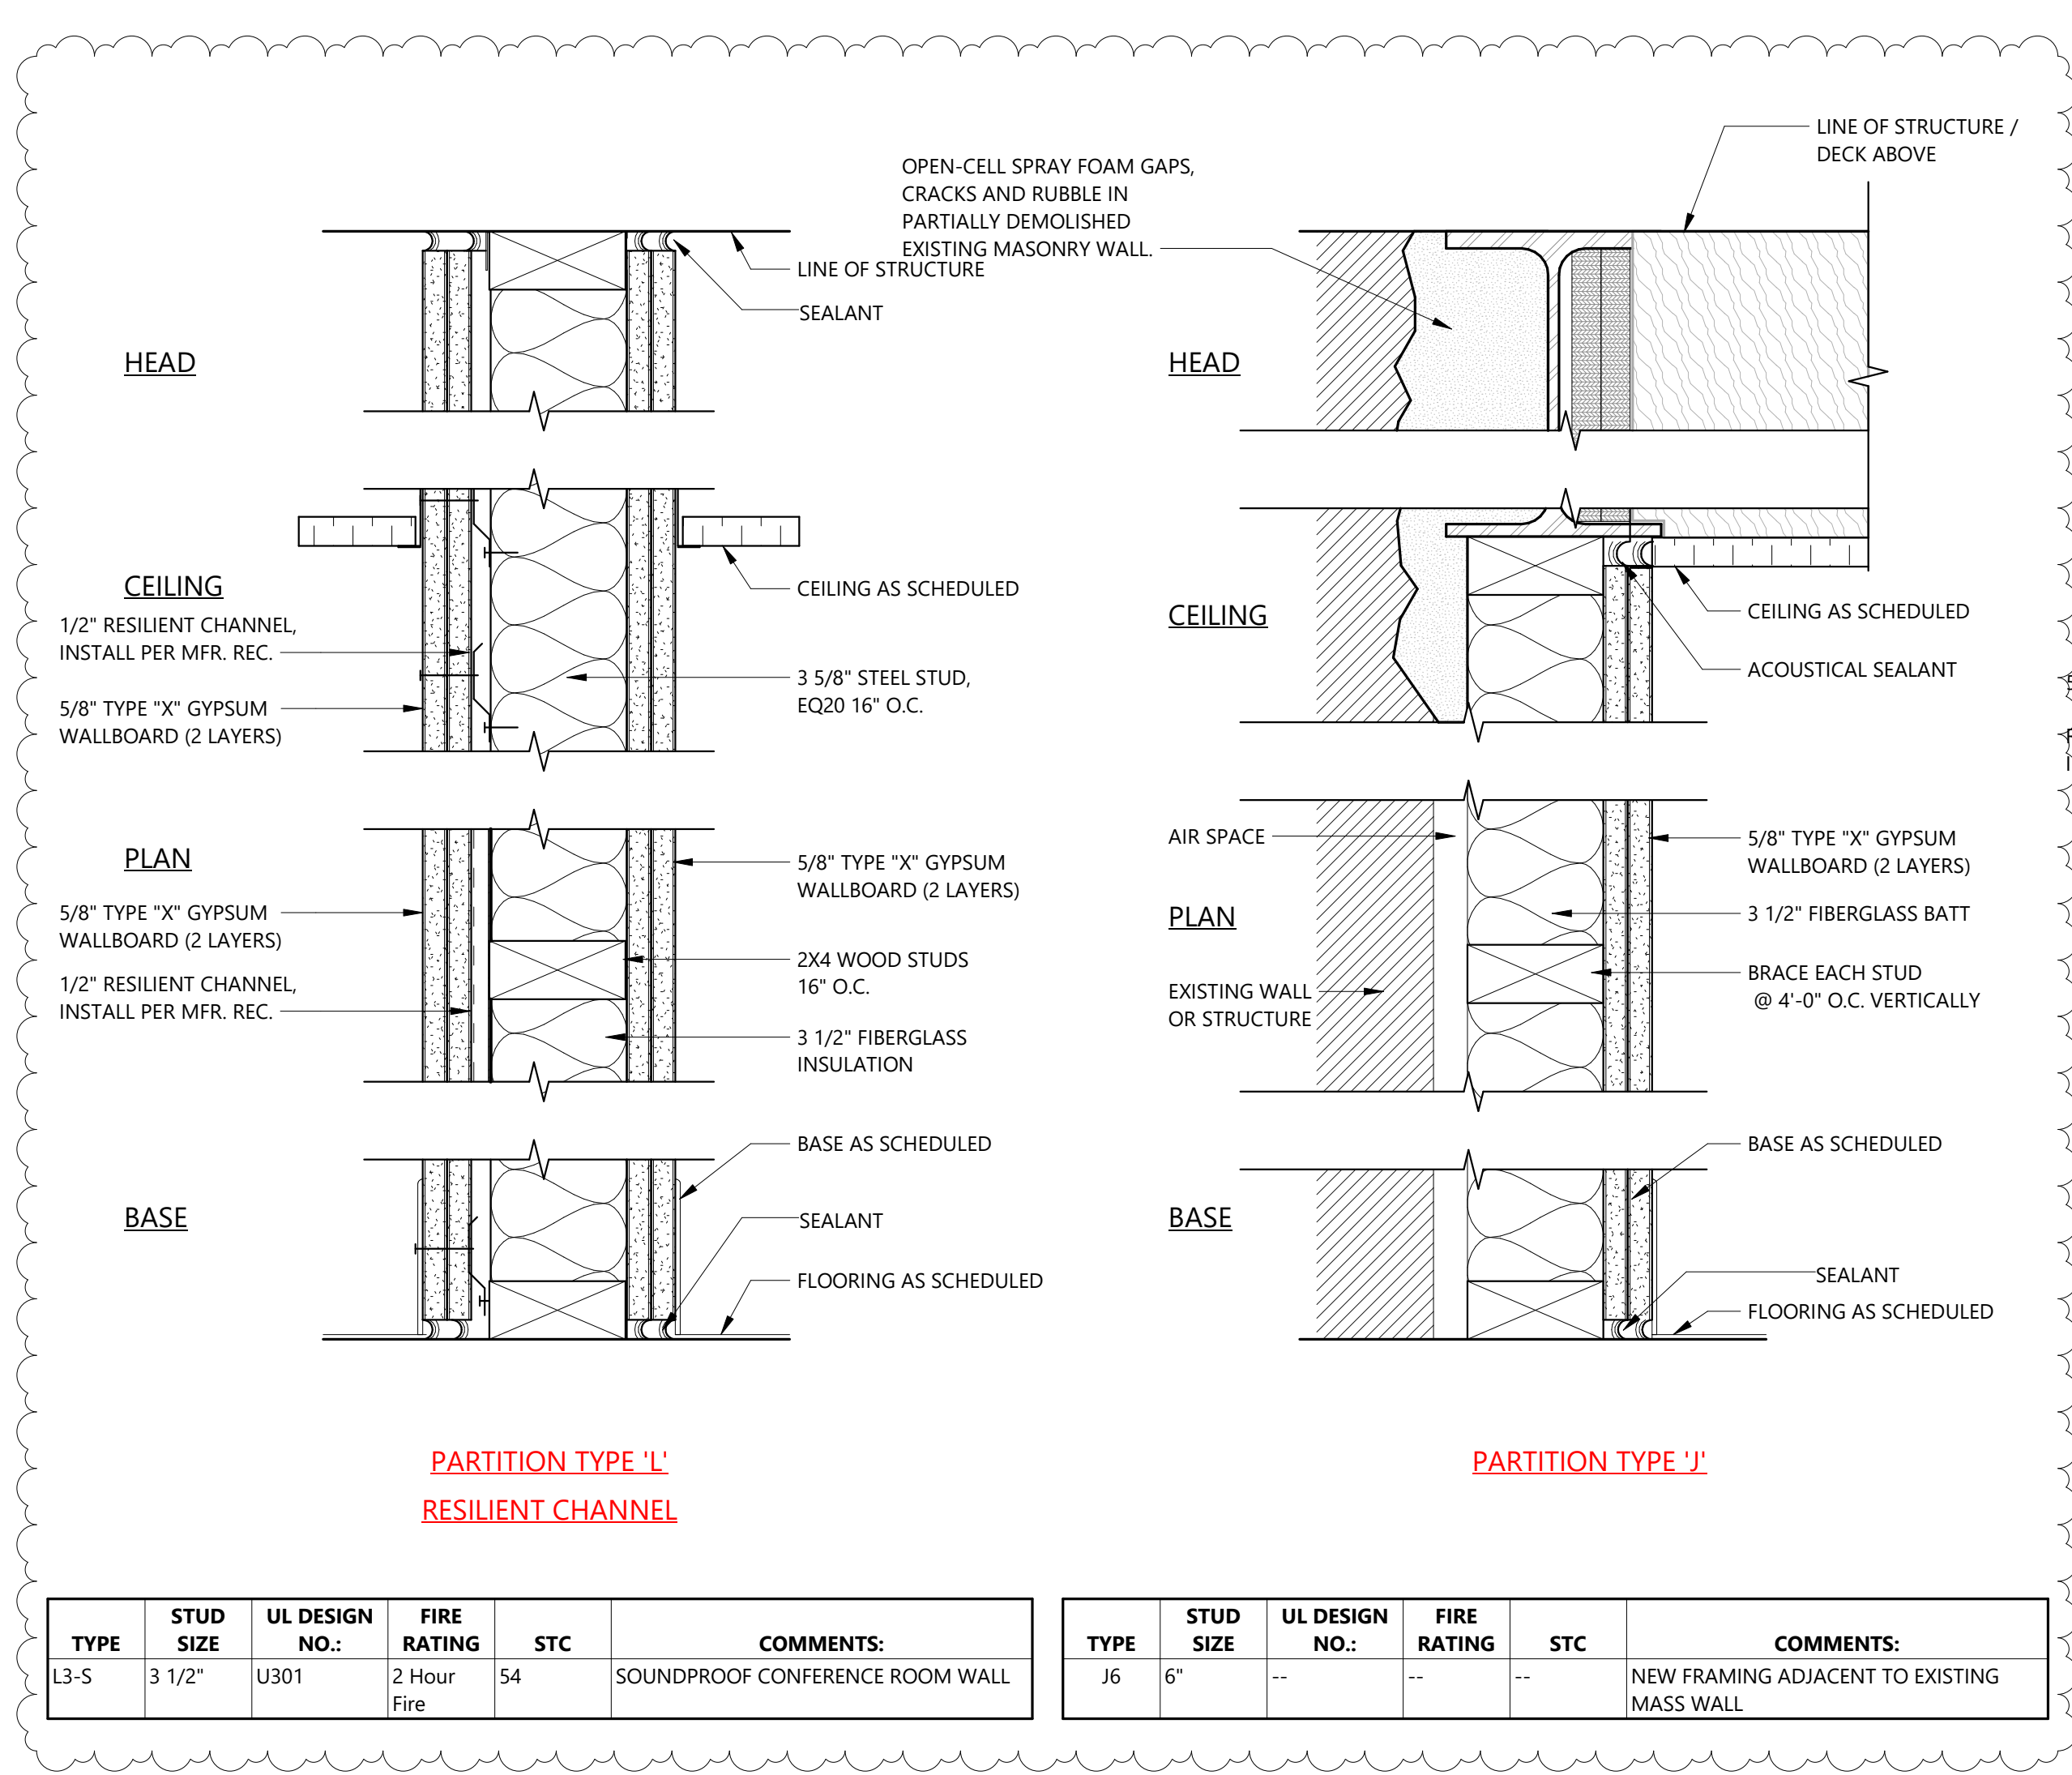

PARTITION TYPE GRAPHIC

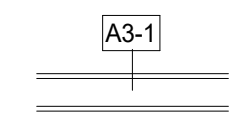

PARTITION TYPE ABBREVIATION

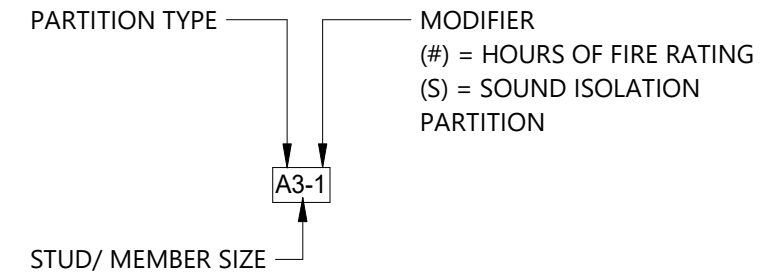





## GENERAL NOTES:

- 1 GENERAL CONTRACTOR TO FIELD VERIFY ALL DIMENSIONS PRIOR TO FABRICATION
- 2 ALL DIMENSIONS ARE NOMINAL OR ROUGH OPENING DIMENSIONS.
- 3 GENERAL CONTRACTOR TO COMPLY WITH IDENTIFICATION AND TEMPERING REQUIREMENTS PER NATIONAL AND LOCAL BUILDING CODES.

## GLAZING & PANEL LEGEND:

-  INSULATING GLASS
-  INSULATING GLASS, TEMPERED

## KEYED NOTES:

- 06 11 00.A2 WOOD BLOCKING AS REQUIRED  
07 92 00 JOINT SEALANTS  
07 92 00.A1 SEALANT  
08 11 16.01 ALUMINUM-FRAMED DOOR, RE: DOOR SCHEDULE  
08 43 00.A2 STOREFRONT DOOR JAMB AT SIDELIGHT  
08 71 00.A6 6" RABBETED THRESHOLD  
08 81 00.A1 GLAZING  
08 81 00.H1 GLAZING GASKET

### INTERIOR STOREFRONT & GLASS SPECIFICATION BASIS OF DESIGN


FRAMING SYSTEM: RACO DESIGN1  
FINISH: CLASS 1 BLACK ANODIZED  
GLASS: 3/8" PER MANUFACTURER SPECS  
CLOSER: MANUFACTURER'S STANDARD SURFACE MOUNT

### EXTERIOR WINDOW BASIS OF DESIGN

FRAMING SYSTEM: PELLA COMMERCIAL RESERVE - CONTEMPORARY, BLOCK FRAME  
FINISH: EXTERIOR - BLACK  
INTERIOR - PREFINISHED STAIN BLACK  
GLASS: 1" DUAL-SEAL INSULATING GLASS PER MANUFACTURER


### ENTRY DOOR

FRAMING SYSTEM: PELLA COMMERCIAL RESERVE - CONTEMPORARY  
DOOR: WOOD HINGED PATIO DOORS  
FINISH: EXTERIOR - BLACK  
INTERIOR - PREFINISHED STAIN BLACK  
GLASS: 1" DUAL-SEAL INSULATING GLASS PER MANUFACTURER

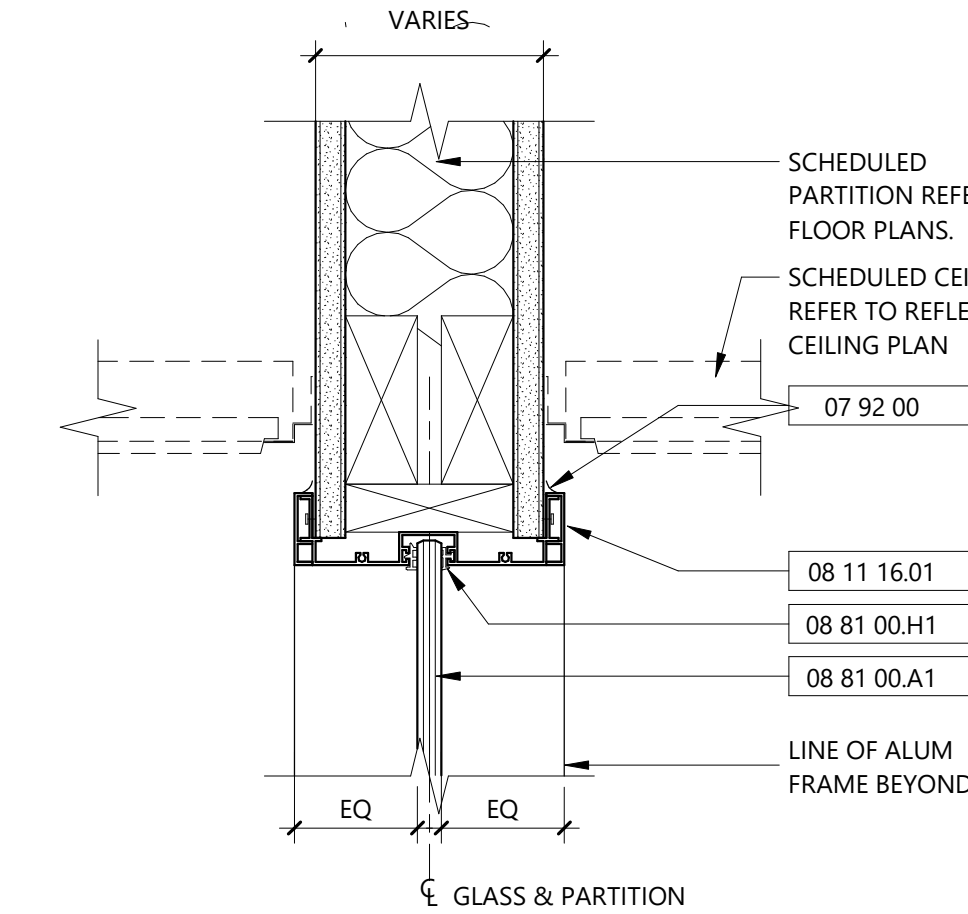


15 ALUM HEAD - SIDELIGHT

SCALE: 3" = 1'-0"

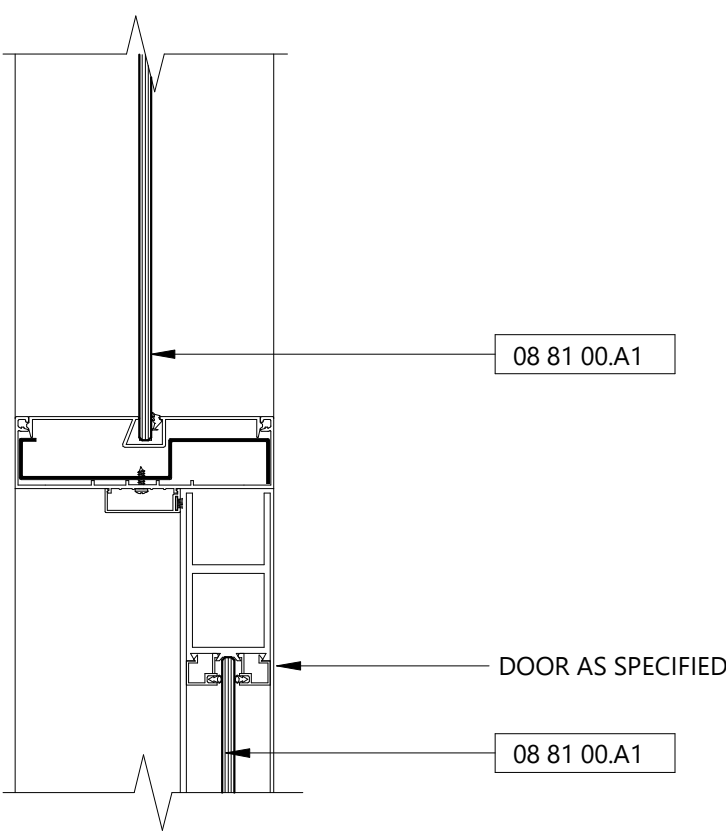


14 ALUM HEAD - GLASS DOOR

SCALE: 3" = 1'-0"

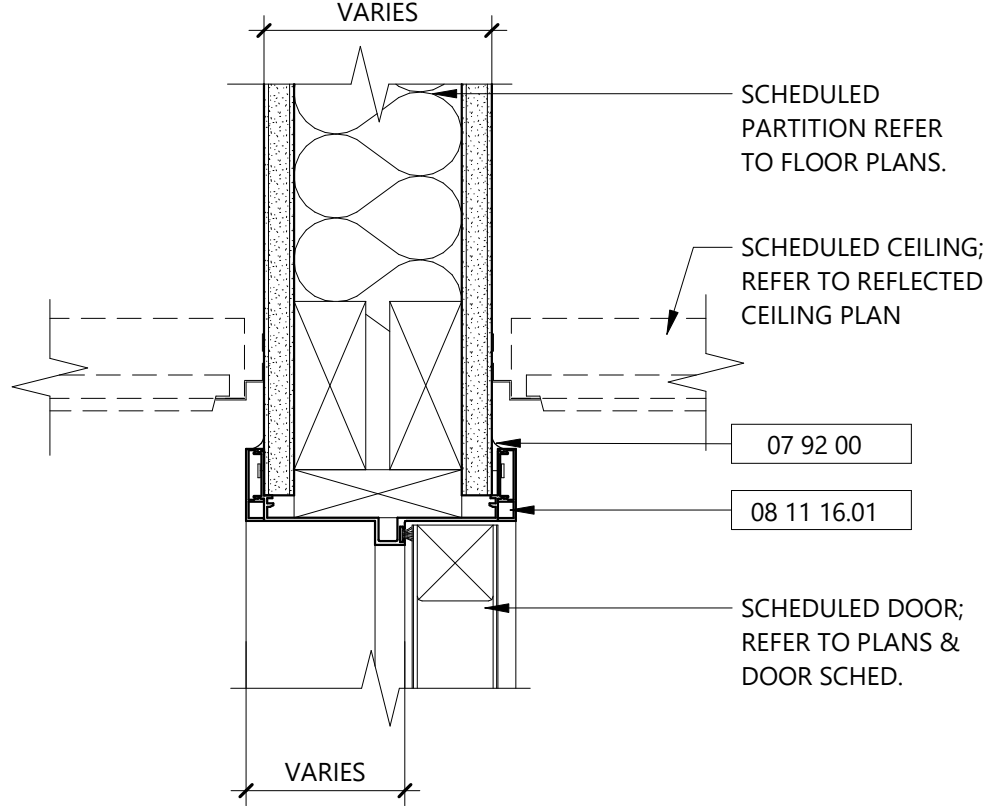


13 ALUM HEAD - DOOR

SCALE: 3" = 1'-0"

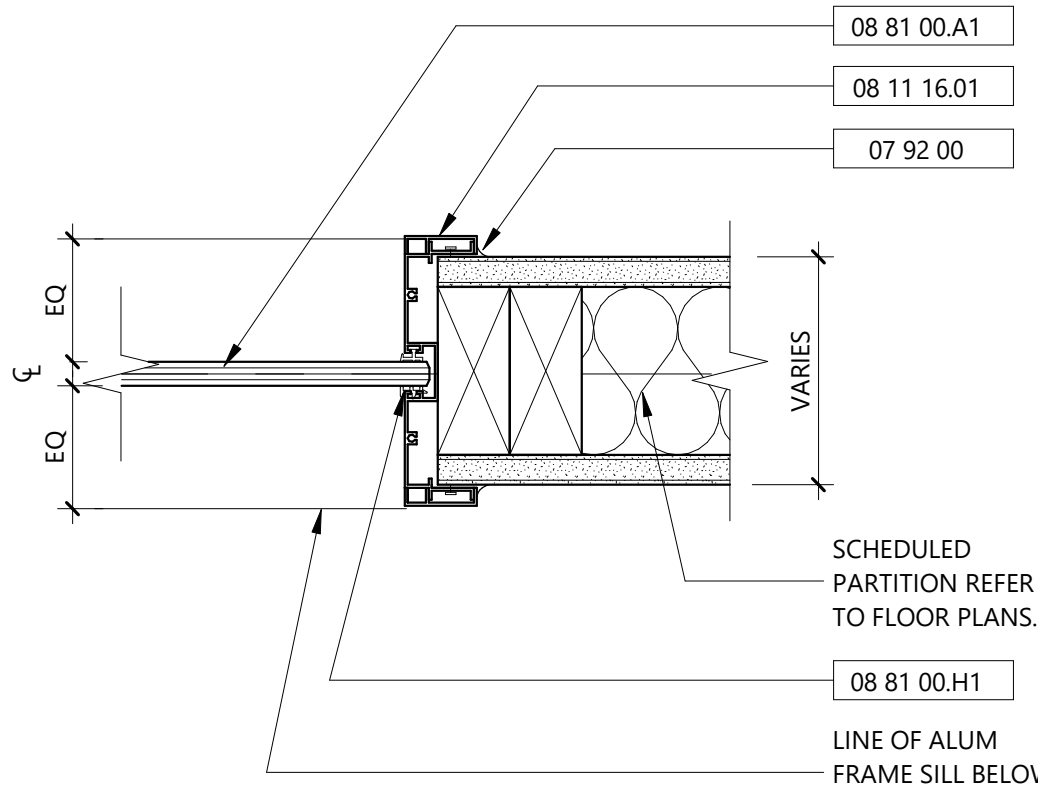


12 ALUM JAMB

SCALE: 3" = 1'-0"

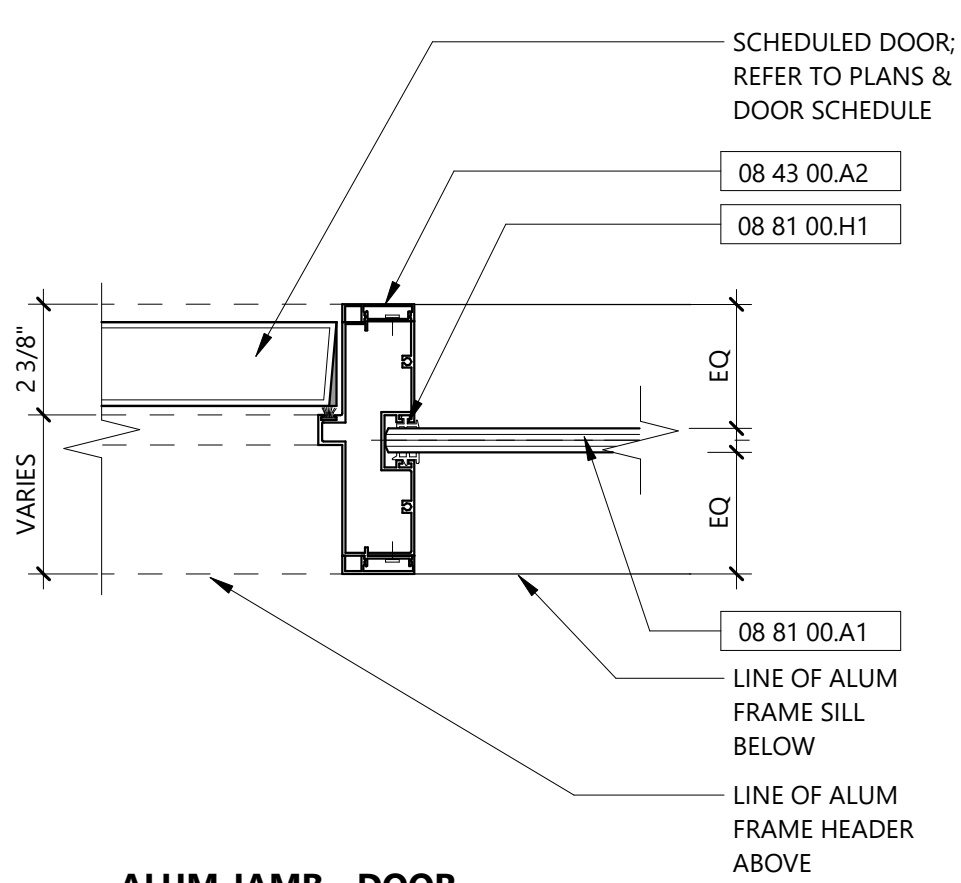


11 ALUM JAMB - DOOR SIDELIGHT

SCALE: 3" = 1'-0"

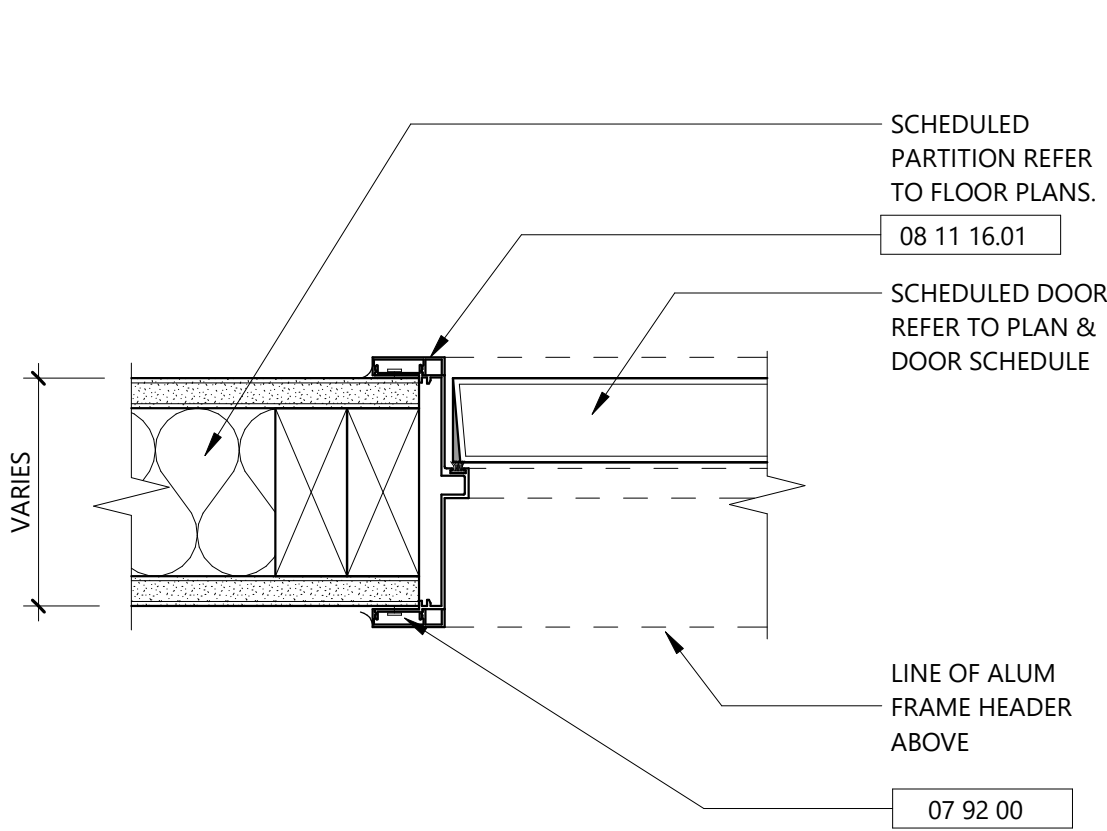


10 ALUM JAMB - DOOR

SCALE: 3" = 1'-0"

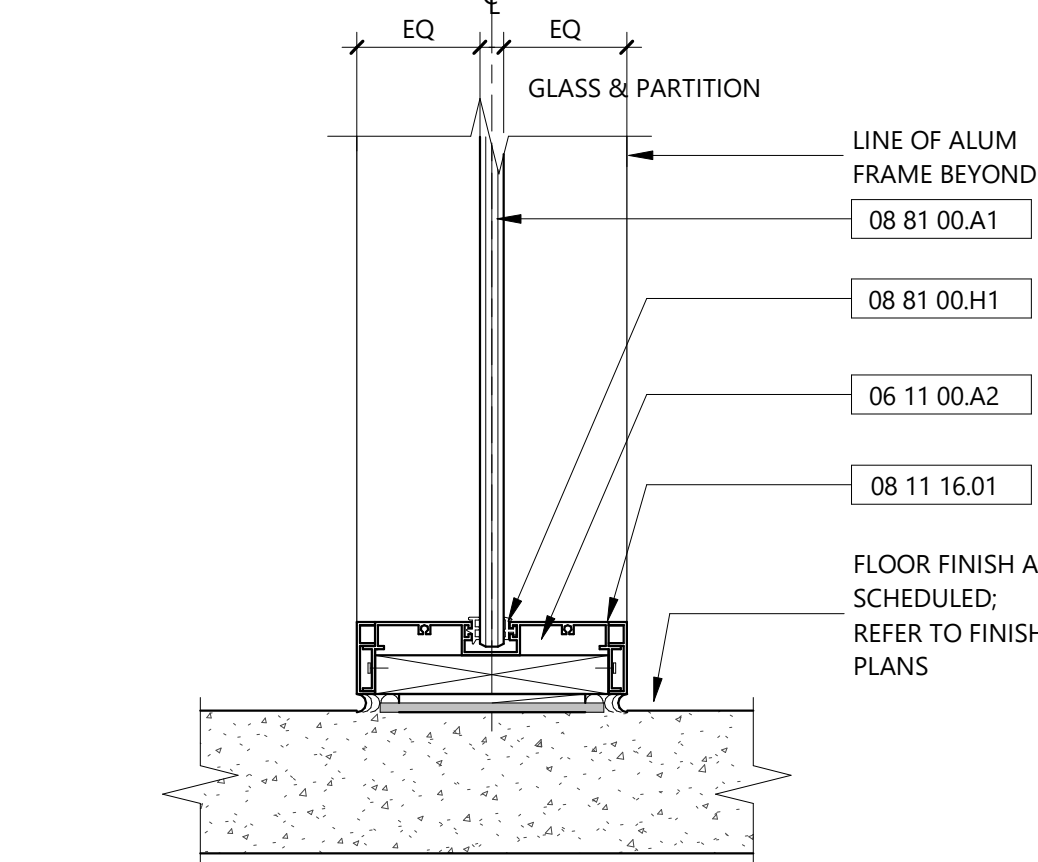


9 ALUM SILL - SIDELIGHT

SCALE: 3" = 1'-0"

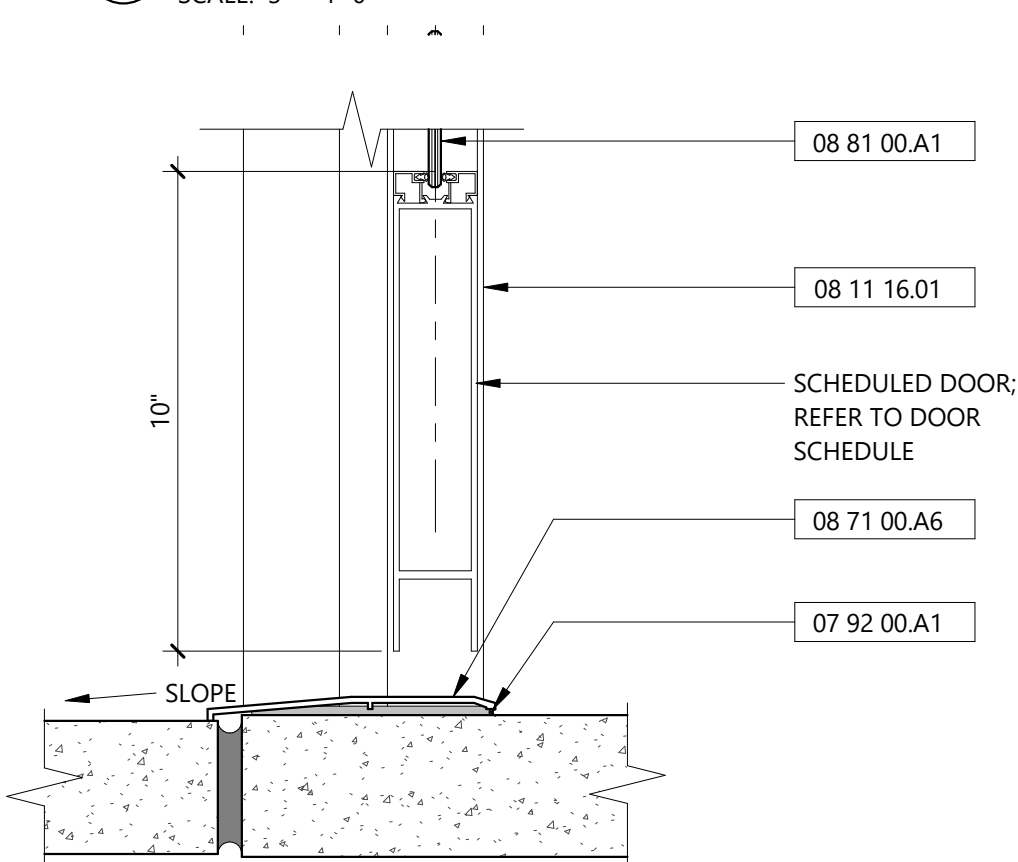


8 ALUM SILL - GLASS DOOR

SCALE: 3" = 1'-0"

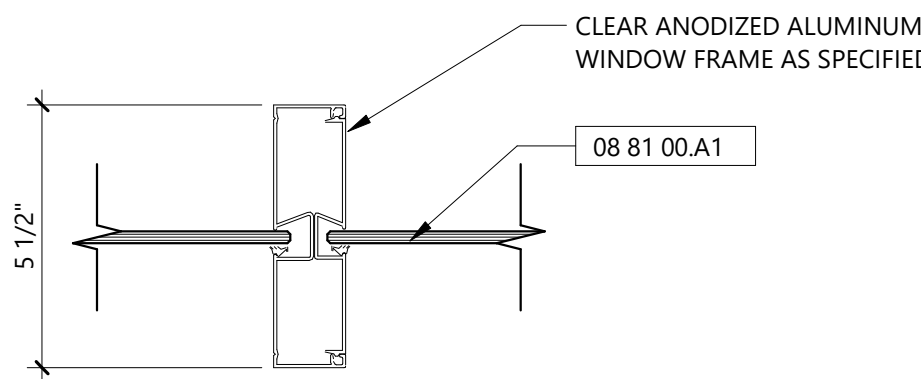

7 ALUM WINDOW MULLION

SCALE: 3" = 1'-0"

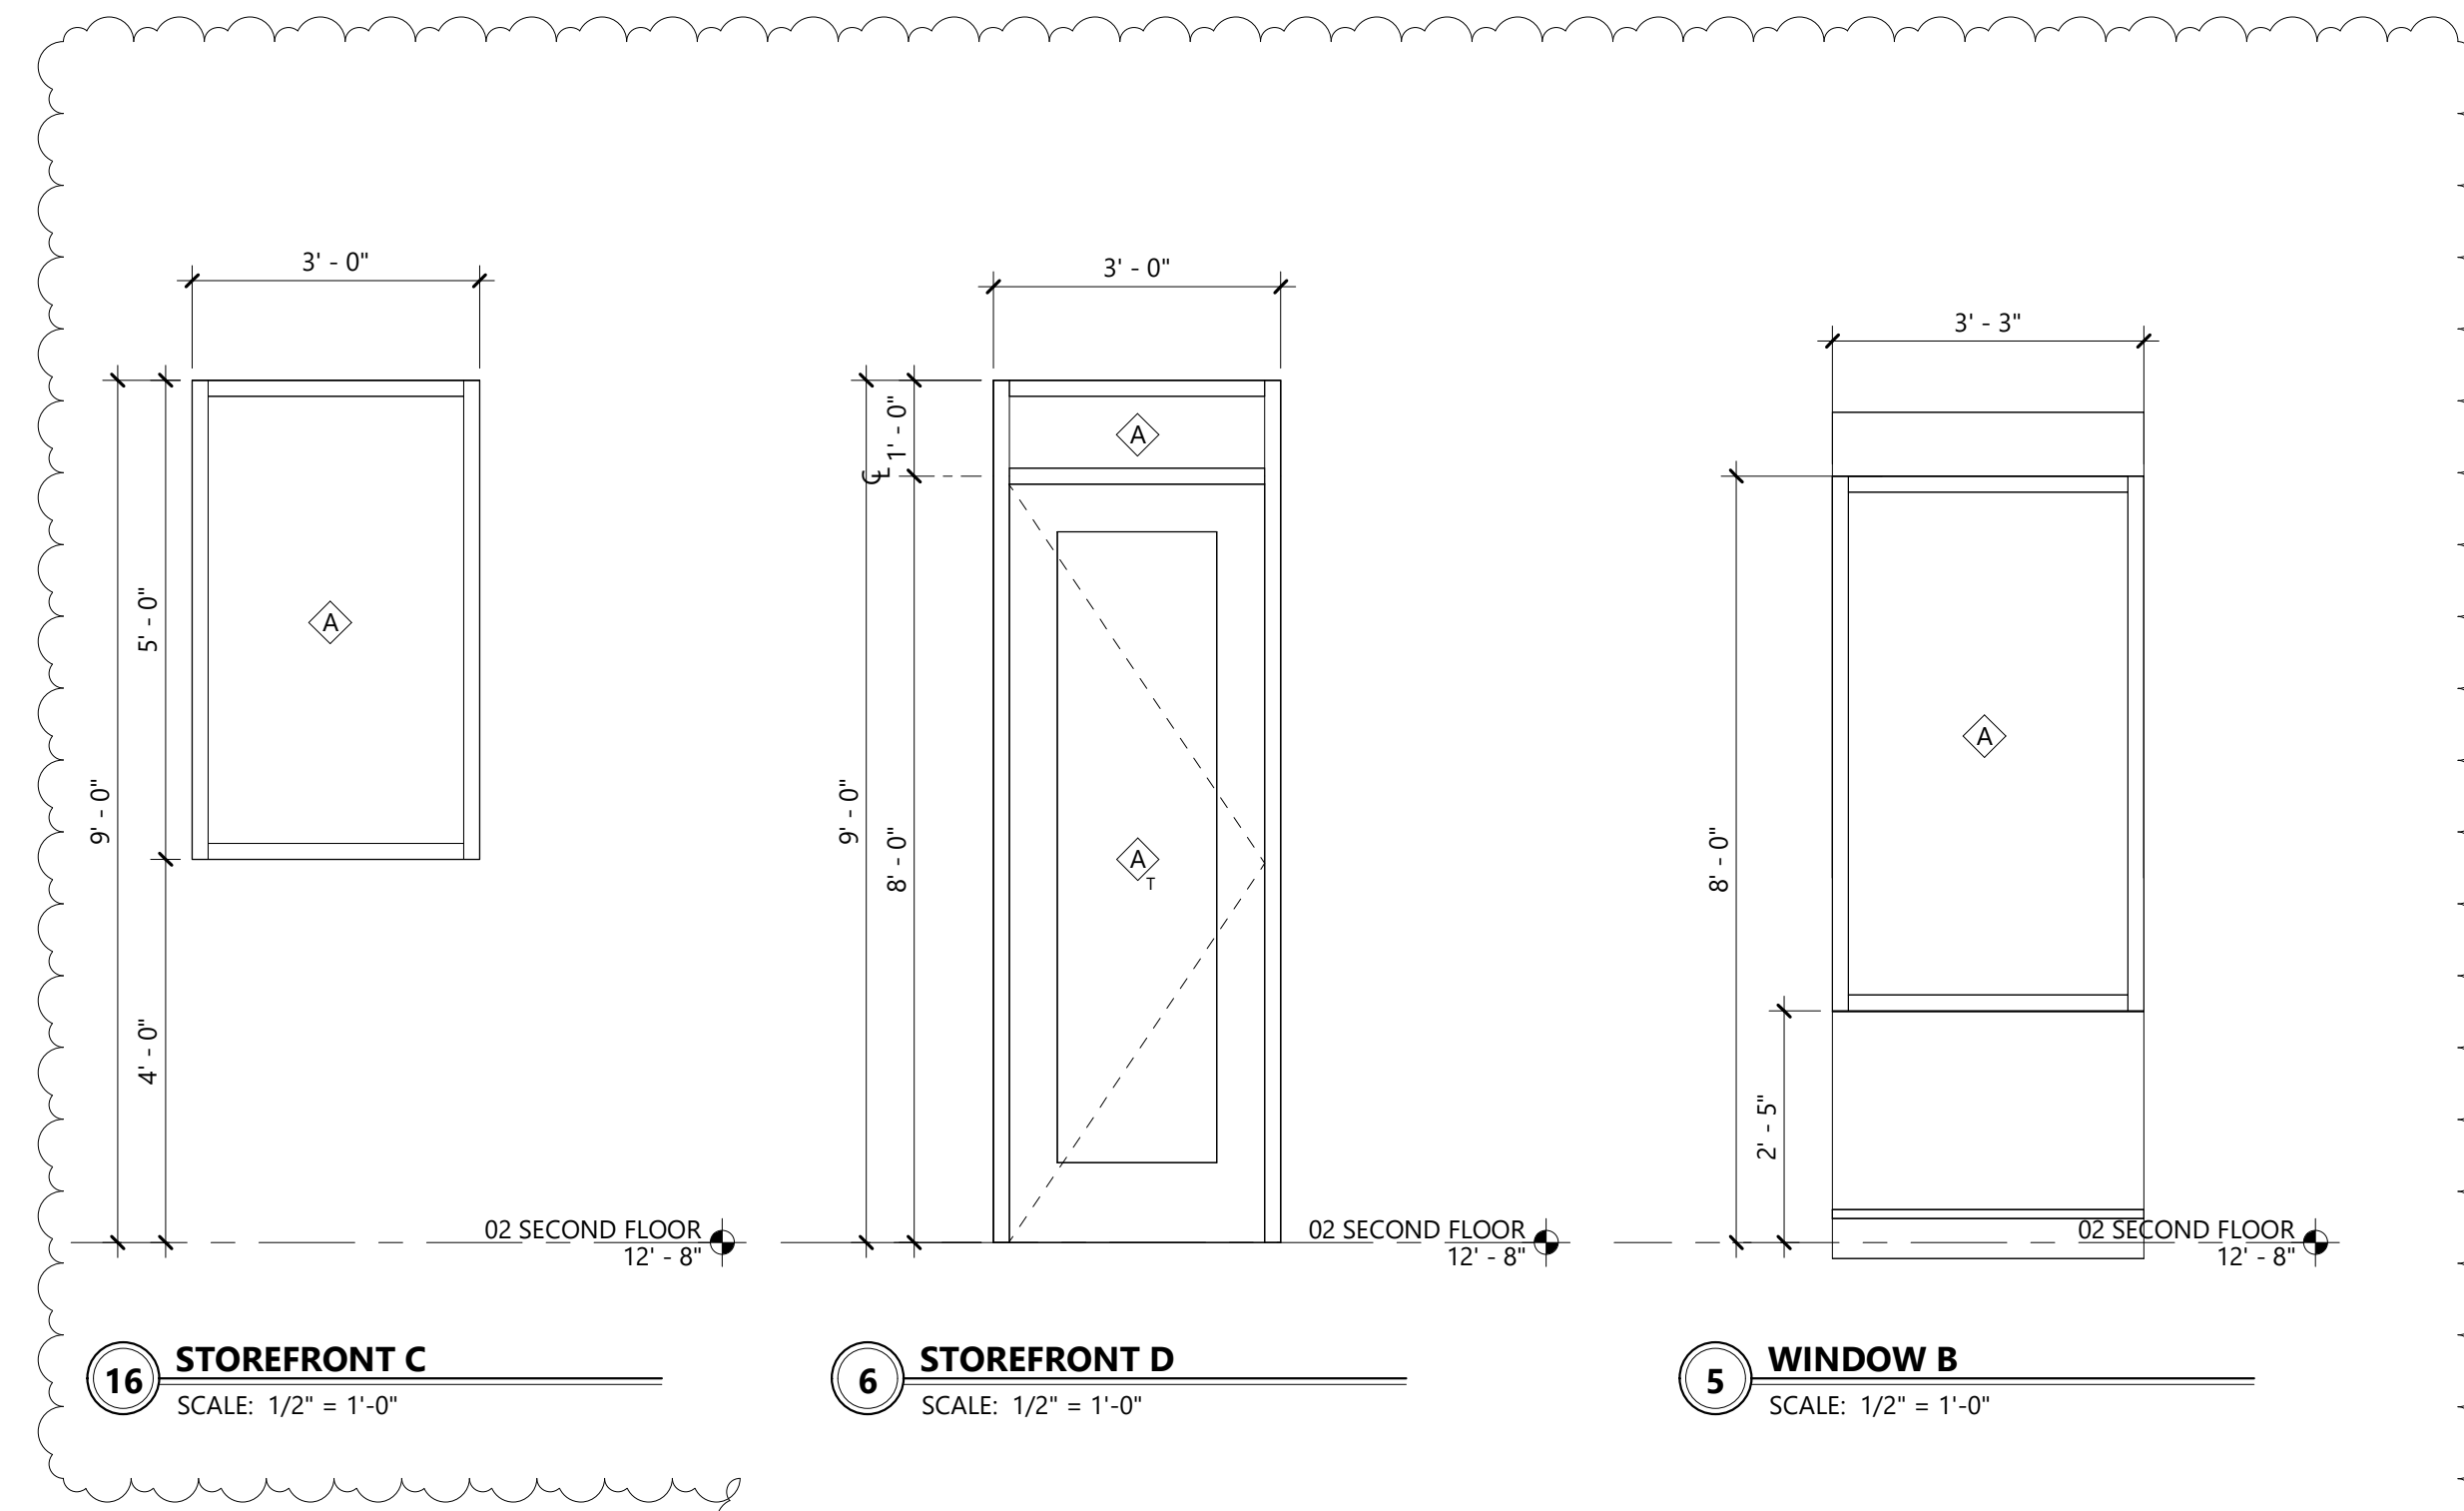

16 STOREFRONT C


SCALE: 1/2" = 1'-0"

6 STOREFRONT D

SCALE: 1/2" = 1'-0"

5 WINDOW B

SCALE: 1/2" = 1'-0"

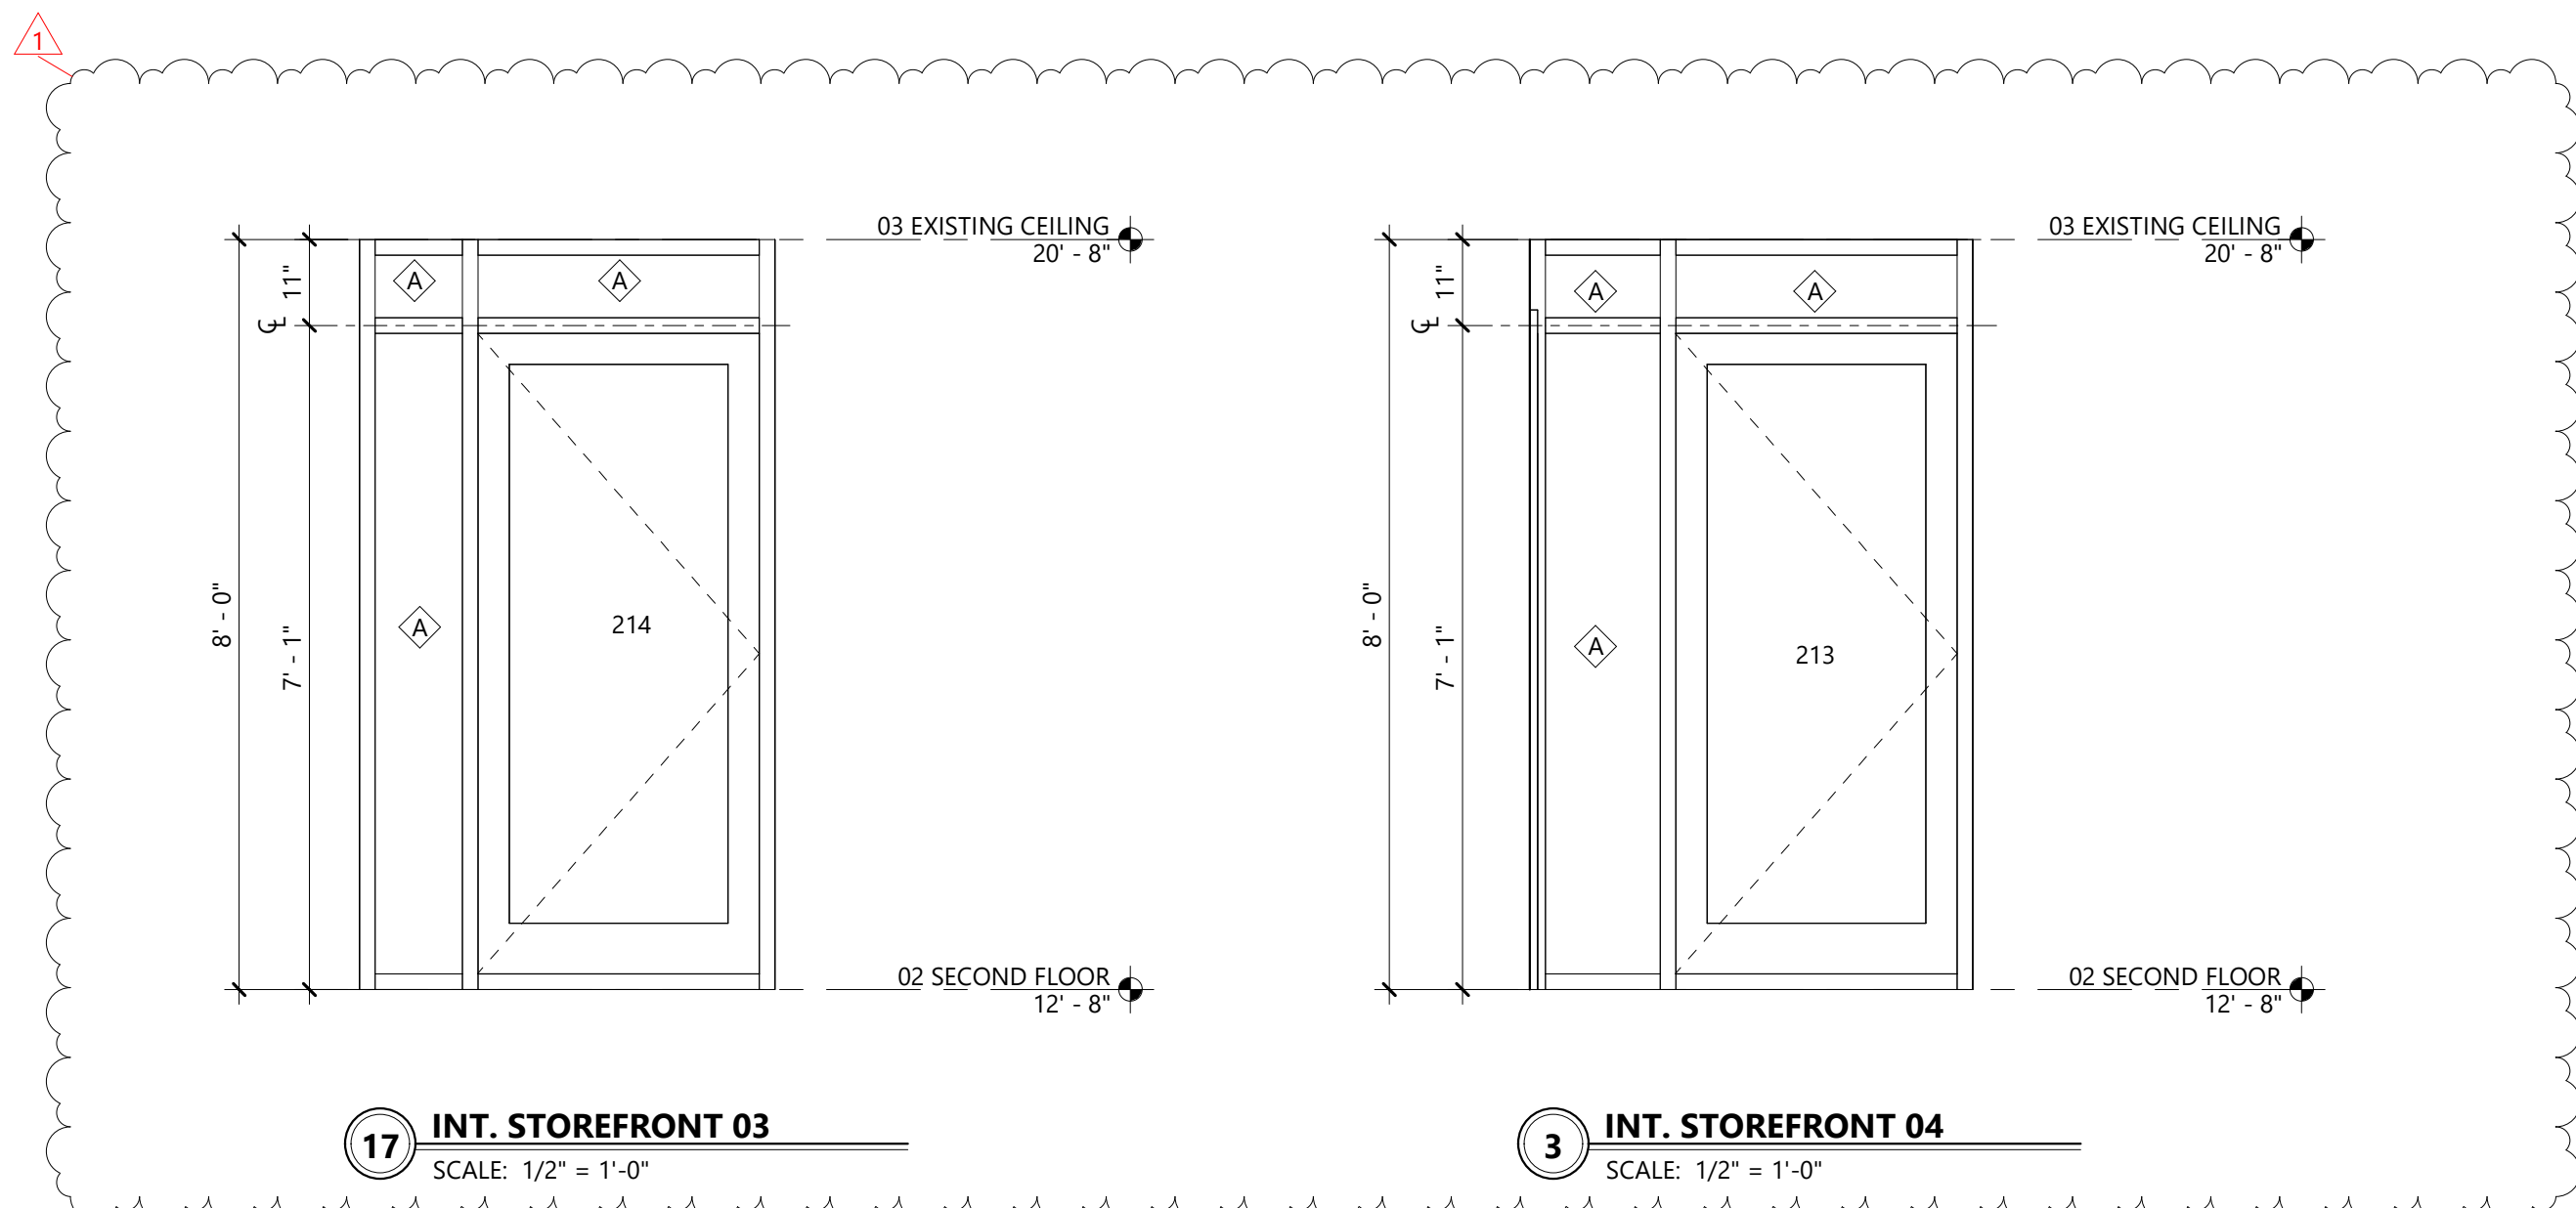


17 INT. STOREFRONT 03

SCALE: 1/2" = 1'-0"

3 INT. STOREFRONT 04

SCALE: 1/2" = 1'-0"

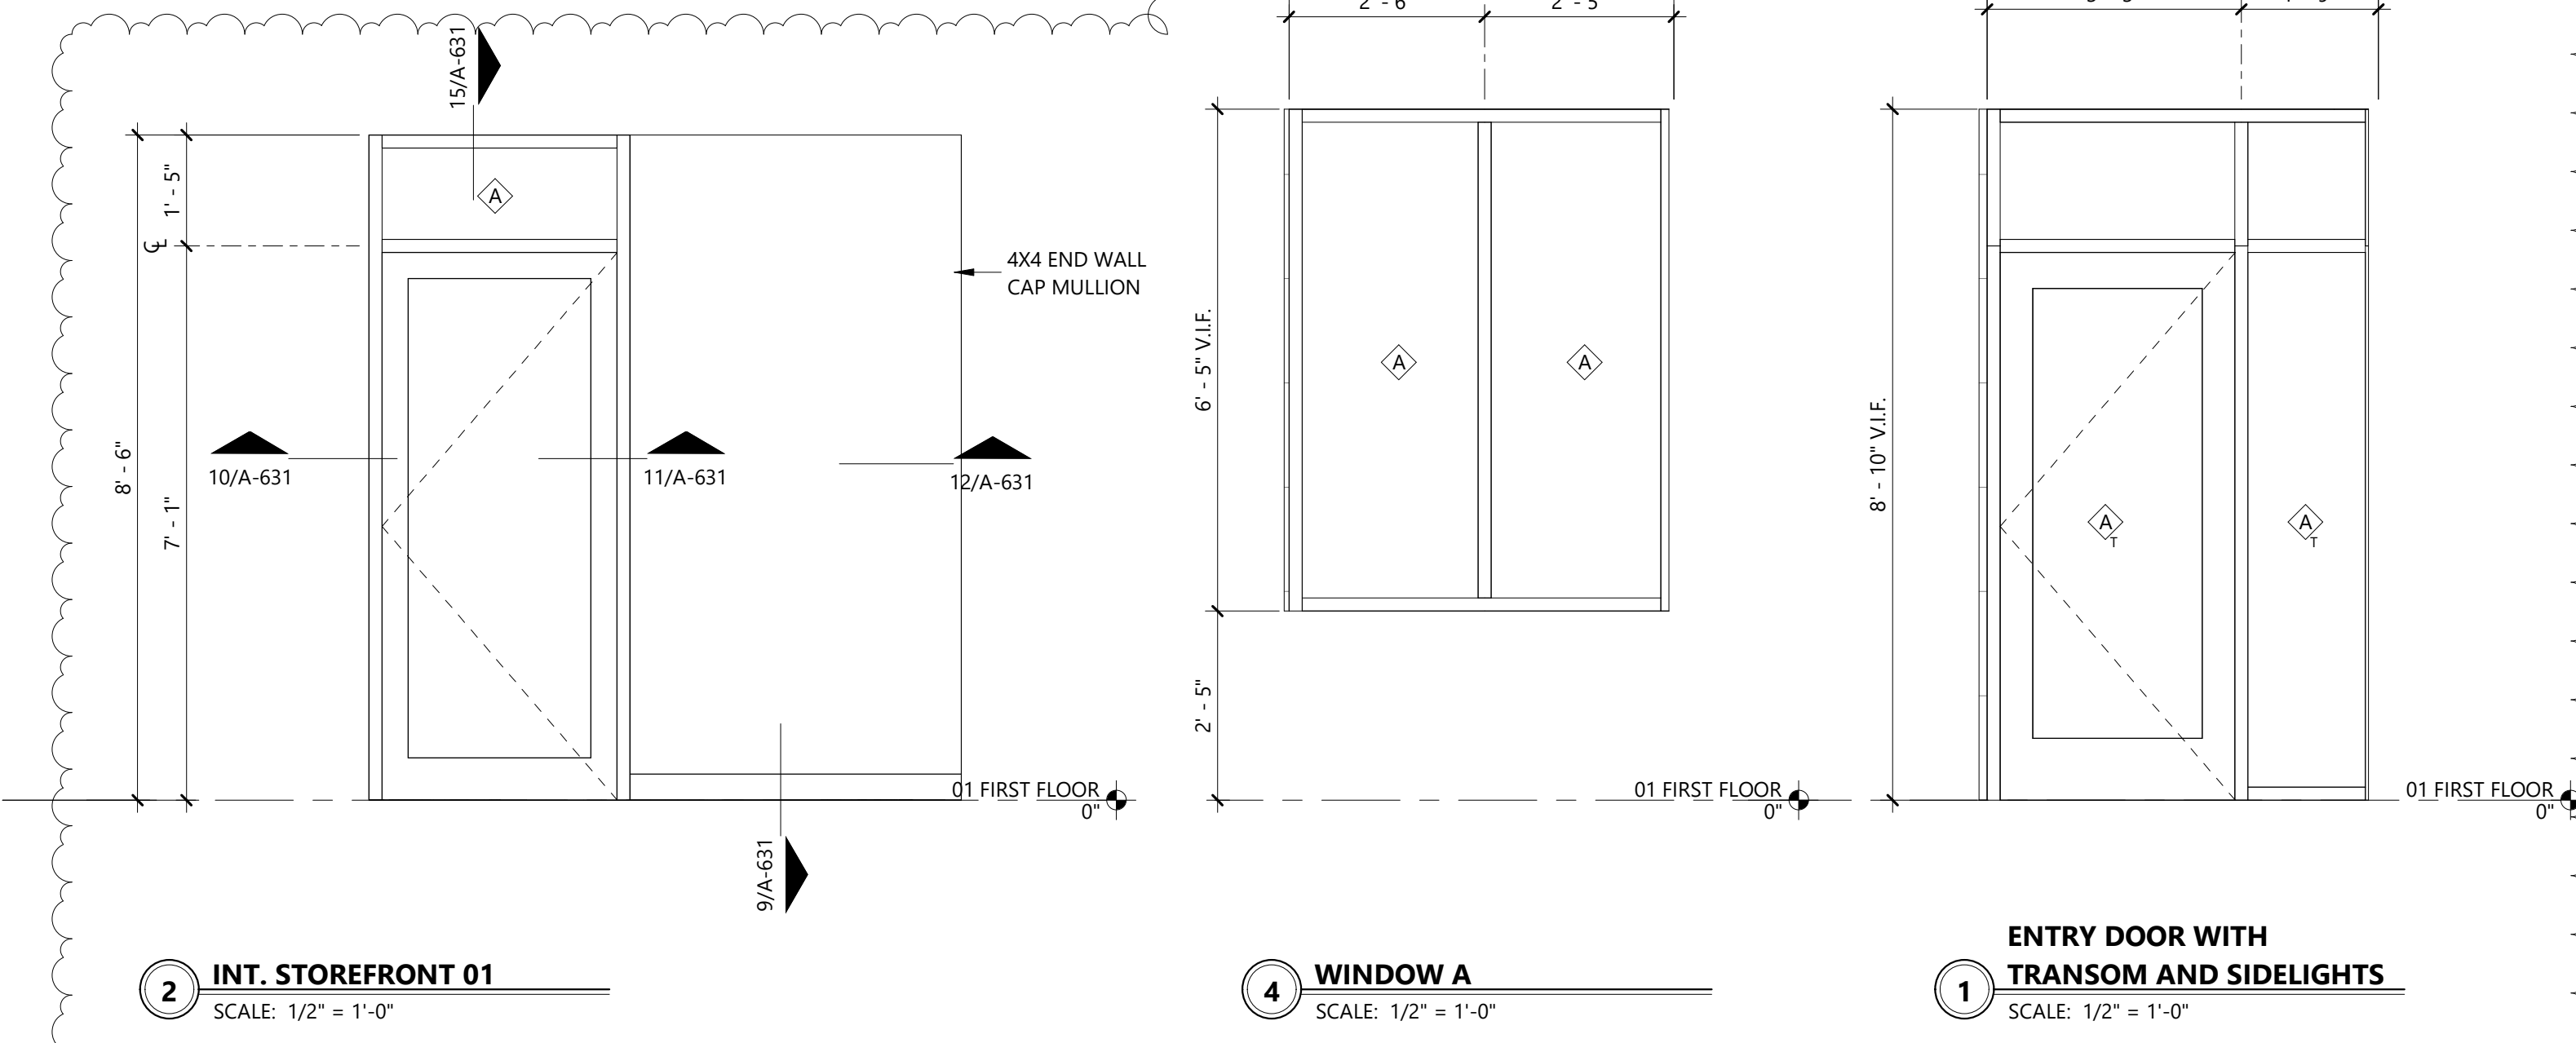

2 INT. STOREFRONT 01

SCALE: 1/2" = 1'-0"

4 WINDOW A

SCALE: 1/2" = 1'-0"

1 ENTRY DOOR WITH TRANSOM AND SIDELIGHTS

SCALE: 1/2" = 1'-0"



Autodesk Docx/733-1428 Burnet County Annex/Burnet County, ELEC, R022.rvt

## GENERAL NOTES

- ALL WORK SHALL BE PERFORMED PER 2020 NEC, AND ALL WORK SHALL BE PERFORMED IN COMPLIANCE WITH THE LATEST EDITION OF ALL LOCAL ORDINANCES AND REGULATIONS AS ADOPTED BY THE CITY OF BURNET AND THE STATE OF TEXAS, AND THE PUBLICATIONS AND STANDARDS OF THE FOLLOWING AUTHORITIES, IN ADDITION TO THOSE SPECIFIED IN RELATED SUPPLEMENTARY CONDITIONS, WHICH ARE REFERENCED IN ELECTRICAL SPECIFICATIONS BY THE ABBREVIATIONS NOTED.
- UNITED STATES OF AMERICA STANDARDS INSTITUTE - USASI INSTITUTE OF ELECTRICAL AND ELECTRONIC ENGINEERS - IEEE NATIONAL ELECTRICAL CODE - NEC NATIONAL FIRE PROTECTION ASSOCIATION - NFPA UNDERWRITERS LABORATORIES - UL NATIONAL ELECTRICAL MANUFACTURERS ASSOCIATION - NEMA AMERICAN SOCIETY OF TESTING MATERIALS - ASTM OCCUPATIONAL SAFETY AND HEALTH ACT - OSHA
- ALL WORK SHALL BE DONE IN ACCORDANCE WITH THE CONTRACT DOCUMENTS, PLANS AND THE SPECIFICATIONS, AND SHALL BE PERFORMED WITH THE LATEST INDUSTRY ACCEPTED STANDARDS.
- THE INTENT OF THIS CONSTRUCTION PACKAGE IS TO ILLUSTRATE ALL THE WORK TO BE ACCOMPLISHED TO PROVIDE AN ELECTRICAL INSTALLATION COMPLETE IN EVERY RESPECT. CARE HAS BEEN TAKEN TO INDICATE THE COMPLETE SCOPE OF WORK REQUIRED FOR THIS PROJECT, HOWEVER, IT IS NOT THE INTENT TO INDICATE EVERY CONFLICT WHICH MAY ARISE, AND PROVIDE FOR SUCH ON THESE DOCUMENTS. NO ASSURANCE IS GIVEN THAT THE PLANS COMPLETELY REFLECT ACTUAL JOB SITE CONDITIONS. IF IT IS DISCOVERED IN THE FIELD THAT ACTUAL LOCATIONS OR CONDITIONS DIFFER GREATLY FROM THOSE SHOWN, CONTRACTOR SHALL GET APPROVAL FROM OWNER PRIOR TO COMMENCING WORK.
- CONTRACTOR SHALL VISIT THE SITE AND FIELD VERIFY THE PROPOSED INSTALLATION LOCATION AND ALL WORKING CONDITIONS SUCH AS STARTING TIME, NOISE LIMITATIONS, CONFINED SPACE LIMITATIONS, OFFSETS AND ROUTING ADJUSTMENTS THAT MAY BE REQUIRED, ETC., TO COMPLETE THE WORK. CONTRACTOR SHALL COORDINATE WITH THE OWNER REGARDING OBSTRUCTION OF ROADWAY OR DRIVEWAY AREAS, ON SITE MATERIALS AND EQUIPMENT STORAGE, AND BUILDING ACCESS. SITE INSPECTION SHALL DETERMINE CONDITION OF EXISTING ELEMENTS TO REMAIN AND BE PROTECTED.
- CONTRACTOR SHALL BE RESPONSIBLE FOR ADEQUATELY BRACING AND PROTECTING ALL WORK DURING CONSTRUCTION AGAINST DAMAGE, BREAKAGE, COLLAPSE, AND MISALIGNMENT ACCORDING TO APPLICABLE CODES, STANDARDS, AND GOOD CONSTRUCTION PRACTICES. CONTRACTOR SHALL TAKE PROPER PRECAUTIONS TO PROTECT ALL EXISTING OPERATIONS AND PROPERTY ADJACENT WITH WHICH WORK COMES IN CONTACT, OR OVER OR UNDER WHICH HE MAY TRANSPORT, HOIST, OR MOVE MATERIALS, EQUIPMENT, DEBRIS, ETC. CONTRACTOR SHALL BE RESPONSIBLE FOR REPAIR AND/OR REPLACEMENT IN KIND OF ALL INADVERTENT DAMAGE TO EXISTING SYSTEMS.
- ALL NECESSARY PERMITS, LICENSES, CERTIFICATES, TESTS, ETC., SHALL BE PROCURED AND PAID FOR BY THE CONTRACTOR.
- THE DRAWINGS SHALL NOT BE SCALED FOR CONSTRUCTION INSTALLATION DIMENSIONS. ALL CONDUIT ROUTING ARE SHOWN IN APPROXIMATE LOCATIONS ONLY. THE CONTRACTOR SHALL BE RESPONSIBLE FOR FIELD VERIFICATION OF CONDITIONS, AND SHALL PERFORM FIELD MEASUREMENTS PRIOR TO FABRICATION AND/OR PURCHASE OF ANY EQUIPMENT AND MATERIAL. REFERENCE ALL DETAILS FOR ADDITIONAL CONSTRUCTION REQUIREMENTS. DETAILS MAY NOT BE REFERENCED ON THE DRAWING(S), BUT ARE INTENDED TO BE TYPICAL THROUGHOUT UNLESS OTHERWISE NOTED.
- DO NOT BEGIN WORK IF ANY DISCREPANCIES OR CONFLICTS EXIST OR ARE DISCOVERED BETWEEN SYSTEMS, UTILITIES, UNTIL THE DISCREPANCIES HAVE BEEN RESOLVED. IMMEDIATELY CALL SUCH DISCREPANCIES OR CONFLICTS TO THE ATTENTION OF THE OWNER'S CONSTRUCTION REPRESENTATIVE AND/OR ENGINEER. SHOULD ANY CONFLICTS OR AMBIGUITIES EXIST IN THE DRAWINGS, NOTES, OR SPECIFICATIONS, BRING THESE TO THE ATTENTION OF THE ENGINEER IMMEDIATELY BEFORE PROCEEDING WITH WORK.
- THE CONTRACTOR SHALL BE RESPONSIBLE FOR ENSURING FULL COORDINATION WITH ALL TRADES TO ACCOMPLISH THE WORK AS INDICATED AND NOTED IN CONTRACT DOCUMENTS. COORDINATE WITH OWNER'S REPRESENTATIVE, AND MAINTAIN A SET OF ALL CHANGES BETWEEN THE DRAWINGS AND THE ACTUAL CONSTRUCTION. CONFLICTS ARISING DUE TO LACK OF COORDINATION SHALL BE THE RESPONSIBILITY OF, AND AT THE EXPENSE OF, THE CONTRACTOR. FINAL AS-BUILT DRAWINGS ARE TO BE DELIVERED TO THE OWNER/ENGINEER AND THE FINAL INVOICE FOR THE CONTRACT WILL NOT BE PAID UNTIL THESE AS-BUILT DRAWINGS ARE RECEIVED.
- WORK AREAS ARE TO BE KEPT FREE OF DEBRIS AT ALL TIMES AND ARE TO BE LEFT BROOM CLEAN AT THE END OF EACH WORKING DAY. THE CONTRACTOR SHALL DISPOSE OF OFF-SITE, ALL MATERIALS REMOVED WHICH ARE NOT BE REINSTALLED OR SALVAGED ON THE PROJECT, UNLESS DIRECTED OTHERWISE BY OWNER. DISPOSAL OF MATERIAL SHALL BE IN ACCORDANCE WITH ACCEPTABLE METHODS APPROVED BY OWNER AND COORDINATED THROUGH OWNER'S COORDINATOR.
- THE CONTRACTOR SHALL BE RESPONSIBLE FOR MAINTAINING THE RATING OF ALL PENETRATIONS THROUGH FIRE AND SMOKE RATED SURFACES. THE CONTRACTOR SHALL COMPLY WITH UL LISTING INSTRUCTIONS FOR PENETRATIONS THROUGH RATED SURFACES.
- THE CONTRACTOR SHALL BE RESPONSIBLE FOR TRAINING OF HIS EMPLOYEES AND SUBCONTRACTORS IN THE RECOGNITION AND AVOIDANCE OF UNSAFE CONDITIONS, AND IN THE REGULATIONS AND HAZARDS WHICH APPLY TO THE AREA IN WHICH THE WORK WILL TAKE PLACE. ALL SAFETY EXPOSURES OR VIOLATIONS BROUGHT TO THE ATTENTION OF THE CONTRACTOR SHALL BE RECTIFIED IMMEDIATELY.
- THE CONTRACTOR SHALL BE RESPONSIBLE FOR PROVIDING PROTECTION OF PERSONS AND PROPERTY, AND FOR PROVIDING SAFE WORKING CONDITIONS THROUGHOUT THE WORK PROCESS. CONTRACTOR SHALL PROVIDE TEMPORARY COVERINGS FOR OPENINGS THROUGH WALLS OR FLOORS, AND PROVIDE TEMPORARY BARRIERS, PARTITIONS AND OR DUST BARRIERS WHERE REQUIRED TO MAINTAIN OSHA AND THE OWNER'S SAFETY STANDARDS AND TO PREVENT DAMAGE TO PROPERTY. ALL AREAS ADJACENT TO THE CONSTRUCTION AREA OR AFFECTED BY THE CONSTRUCTION MUST BE PROTECTED FROM DAMAGE, CLEANED AND RESTORED TO THEIR ORIGINAL CONDITION AT THE END OF THE PROJECT. WELDING BLANKETS SHALL BE UTILIZED FOR PROTECTION OF COMBUSTIBLE MATERIALS IN AREA WHERE WELDING OR CUTTING WITH A TORCH IS CONDUCTED.
- ALL WORK SHALL BE GUARANTEED AGAINST DEFECTIVE MATERIALS AND WORKMANSHIP FOR A PERIOD OF NO LESS THAN ONE (1) YEAR AFTER THE DATE OF SUBSTANTIAL COMPLETION OR ACCEPTANCE OF THE WORK. THE CONTRACTOR SHALL REPAIR OR REPLACE, AT HIS OWN EXPENSE, ANY WORK ORDERED TO DO SO. ALL WORK THAT MAY DEVELOP DEFECTS IN MATERIAL OR WORKMANSHIP WITHIN SAID PERIOD OF TIME. ALL EQUIPMENT SHALL BE INSTALLED IN ACCORDANCE WITH MANUFACTURER'S RECOMMENDATIONS FOR SERVICE INTENDED. AS INTERPRETED BY THE ENGINEER, THE INSTALLATION OF ALL EQUIPMENT SHALL BE MADE BY EXPERIENCED CRAFTSMAN IN A NEAT, WORKMANLIKE MANNER. ALL MATERIALS, TOOLS, COSTS, AND SERVICES NECESSARY TO COMPLETELY INSTALL ALL ELECTRICAL WORK SHALL BE PROVIDED BY THE CONTRACTOR.

## CONTROL EQUIPMENT SCHEDULE


UNIT	ITEMS BY OTHERS				ITEMS BY ELECTRICAL CONTRACTOR			CONTROL DEVICES	INST. BY	FURN. BY	NOTES
	DESCRIPTION	VOLTAGE	PHASE	FLA	DISCONNECT						
					DESCRIPTION	AMPS	NEMA ENCLOSURE				
CU-1-1	CONDENSING UNIT	208 V	1	36A	NON-FUSED	60A	NEMA 3R	FCU-1-1	MC	MC	4
CU-2-1	CONDENSING UNIT	208 V	1	32A	NON-FUSED	60A	NEMA 3R	FCU-2-1	MC	MC	4
CU-IT-MAIN	CONDENSING UNIT	208 V	1	34.0	NON-FUSED	60A	NEMA 3R	FCU-IT-MAIN	MC	MC	1, 4
CU-LAB	CONDENSING UNIT	208 V	1	22.0	NON-FUSED	30A	NEMA 3R	FCU-LAB	MC	MC	1, 4
EF-1-1 thru EF-1-3	EXHAUST FAN	120 V	1	1A	MOTOR RATED	15A	NEMA 1	OCCUPANCY SENSOR	EC	EC	2, 4
EF-2-1 & EF-2-2	EXHAUST FAN	120 V	1	1A	MOTOR RATED	15A	NEMA 1	OCCUPANCY SENSOR	EC	EC	2, 4
EW-H-1	ELECTRIC WATER HEATER	208 V	1	12A	MOTOR RATED	20A	NEMA 1	---	--	--	4
FCU-1-1	FAN COIL UNIT	208 V	1	25A	NON-FUSED	30A	NEMA 1	THERMOSTAT	MC	MC	3, 4
FCU-2-1	FAN COIL UNIT	208 V	1	25A	NON-FUSED	30A	NEMA 1	THERMOSTAT	MC	MC	3, 4

### NOTES:

- FCU POWERED BY CU. PROVIDE WIRE AND CONDUIT PER NEC.
- INTERLOCK WITH OCCUPANCY SENSORS IN MEN'S AND WOMEN'S RESTROOMS.
- UNIT PROVIDED WITH DUCT SMOKE DETECTOR, CONNECT TO FIRE ALARM SYSTEM.
- ELECTRICAL CONTRACTOR TO MAKE FINAL CONNECTION AS NOTED IN PLANS.

- ALL PROPOSED EQUIPMENT INSTALLED ON THIS PROJECT SHALL BE NEW AND UNUSED UNLESS NOTED OTHERWISE. ALL EQUIPMENT SHALL BE LABELED AND LISTED FOR THE INTENDED USE. THE ELECTRICAL CONTRACTOR SHALL REMOVE ALL LABELS, DIRT, PAINT SPOTS, GREASE AND STAINS FROM ALL ELECTRICAL EQUIPMENT AND SHALL CLEAN ALL EQUIPMENT AS NECESSARY. NO LOOSE PARTS OR SCRAPS OF EQUIPMENT SHALL BE LEFT ON THE PREMISES. EQUIPMENT LOCATION AND ROUTING IS APPROXIMATE AND SHALL BE PLACED TO PROVIDE PROPER ACCESS AND CLEARANCE FROM OTHER TRADES AND EQUIPMENT.
- ALL WIRING SHALL BE THWN/THHN, 98% CONDUCTIVITY COPPER, STANDARD CONDUCTOR, 600V INSULATION. ALL WIRING SHALL BE INSTALLED IN RIGID CONDUIT AND CONTINUOUS (WITHOUT SPLICES).
- A GREEN GROUNDING CONDUCTOR SHALL BE PROVIDED WITH ALL BRANCH AND FEEDER CIRCUITS. SIZE PER N.E.C. 250-122 UNLESS NOTED OTHERWISE. ALSO PROVIDE A SEPARATE DEDICATED INSULATED AND ISOLATED GROUNDING CONDUCTOR FOR ISOLATED GROUND CIRCUITS. UPON COMPLETION OF THE WORK, ALL PARTS OF THE ELECTRICAL INSTALLATION SHALL BE TESTED AND PROVED TO BE FREE OF UNWANTED GROUNDS AND OTHER DEFECTS.
- ALL EXTERIOR CONDUIT SHALL BE RIGID GALVANIZED STEEL CONDUIT. FITTINGS SHALL BE STEEL THREADED TYPE. MOUNT THE CONDUIT AS HIGH AS POSSIBLE AND RUN PARALLEL AND PERPENDICULAR TO STRUCTURE. ALL OTHER CONDUIT SHALL BE EMT WITH STEEL COMPRESSION OR STEEL SET SCREW FITTINGS, 3/4" MIN., UNLESS NOTED OTHERWISE.
- KEEP RACEWAYS AT LEAST SIX INCHES AWAY FROM PARALLEL RUNS OF FLUES AND STEAM OR HOT WATER PIPES. INSTALL HORIZONTAL RACEWAY RUNS ABOVE WATER AND STEAM PIPING.
- ELECTRICAL CONTRACTOR SHALL PROVIDE AND INSTALL PULL WIRES IN EMPTY RACEWAYS. USE NO. 14 AWG ZINC-COATED STEEL OR MONOFILAMENT PLASTIC LINE HAVING NOT LESS THAN 200-LB TENSILE STRENGTH.
- CHANNEL AND ANGLE SUPPORT SYSTEMS, HANGERS, ANCHORS, SLEEVES, AND FASTENERS SHALL BE DESIGNED TO PROVIDE SECURE SUPPORT FROM THE BUILDING STRUCTURE FOR ELECTRICAL COMPONENTS. SUPPORTING DEVICES SHALL BE HOT DIPPED GALVANIZED STEEL, CONFORM TO MANUFACTURER'S RECOMMENDATIONS FOR SELECTING SUPPORTS. SUPPORT PARALLEL RUNS OF HORIZONTAL RACEWAYS TOGETHER ON TRAPEZE OR BRACKET TYPE HANGERS.
- PULL BOXES SHALL BE GALVANIZED SHEET METAL WITH SCREW-ON COVERS AND WELDED SEAMS, STAINLESS STEEL NUTS, BOLTS, SCREWS AND WASHERS. BOXES SHALL BE SIZED IN ACCORDANCE WITH THE NEC.
- UNLESS OTHERWISE NOTED ALL 120V SINGLE PHASE CIRCUITS WILL REQUIRE A INDIVIDUAL NEUTRAL CONDUCTOR - INCLUDING MULTI-CIRCUITS COMBINED IN SINGLE CONDUIT RUNS.

## INTERIOR BOX MOUNTING HEIGHTS

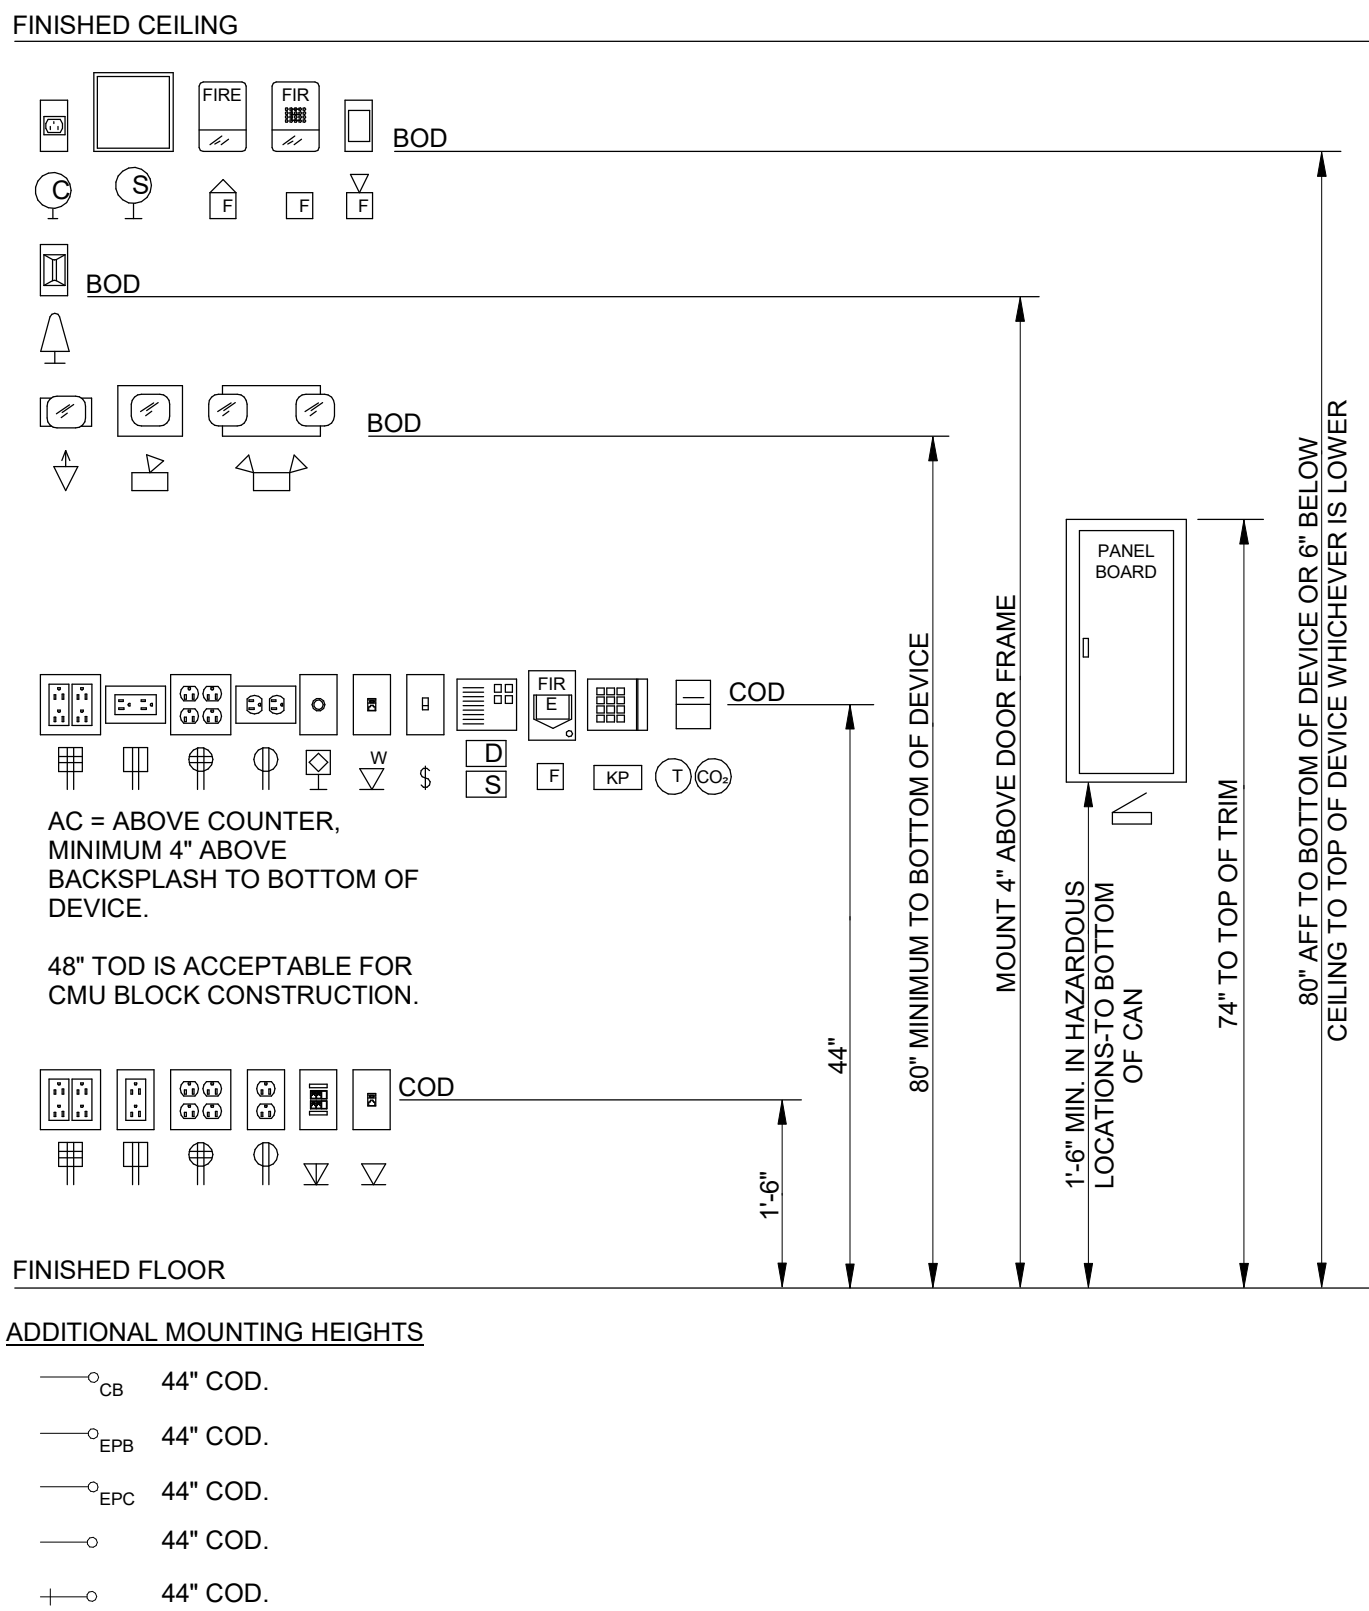

## ELECTRICAL LEGEND

### LIGHTING

SYMBOL	DESCRIPTION
	LAY-IN OR RECESSED FIXTURE, SIZE ON PLANS
	WALL MOUNTED FIXTURE, SIZE ON PLANS
	SURFACE MOUNTED FIXTURE, SIZE ON PLANS
	PENDANT OR SURFACE MOUNTED FIXTURE, SIZE ON PLANS
	PENDANT MOUNTED FIXTURE, SIZE ON PLANS
	SHADED FIXTURE INDICATES FIXTURE IS UNSWITCHED AND ALSO INDICATES EMERGENCY POWER.
	RECESSED DOWNLIGHT FIXTURE
	SURFACE MOUNTED FIXTURE
	WALL MOUNTED FIXTURE
	WALL WASH OR DIRECTIONAL FIXTURE
	WALL SCONCE FIXTURE
	TRACK FIXTURE, SEE PLAN FOR SIZE AND HEADS
	CEILING FAN FIXTURE
	CEILING MOUNTED, WALL MOUNTED EXIT LIGHT (W/ DIRECTIONAL ARROWS)
	1 HEAD REMOTE EMERGENCY LIGHT
	2 HEAD EMERGENCY LIGHT BATTERY PACK
	1 HEAD REMOTE EMERGENCY LIGHT BATTERY PACK
	2 HEAD LIGHT WITH MOTION SENSOR
	SQUARE POLE MOUNTED FIXTURE, EXTERIOR
	ROUND POLE MOUNTED FIXTURE, EXTERIOR
	POST TOP FIXTURE, EXTERIOR
	BOLLARD FIXTURE, EXTERIOR
	DIRECTIONAL INGROUND FIXTURE, EXTERIOR

### FIRE ALARM

SYMBOL	DESCRIPTION
	STROBE (NUMBER INDICATES CANDELA RATING)
	SPEAKER/STROBE (NUMBER INDICATES CANDELA RATING)
	SPEAKER/STROBE (NUMBER INDICATES CANDELA RATING), CEILING MOUNTED
	SPEAKER
	MANUAL PULLSTATION
	INDOOR PROTECTIVE SHIELD
	MAGNETIC DOOR HOLDER, BY DIV 28
	FIRE/SMOKE DAMPER
	SMOKE DETECTOR, SMOKE DETECTOR WALL MOUNTED
	HEAT DETECTOR, HEAT DETECTOR WALL MOUNTED
	CONNECTION TO TAMPER SWITCH, SWITCH BY OTHERS
	CONNECTION TO FLOW SWITCH, SWITCH BY OTHERS
	CONNECTION TO PRESSURE SWITCH, SWITCH BY OTHERS
	BEAM DETECTOR TRANSMITTER
	BEAM DETECTOR RECEIVER
	DUCT SMOKE DETECTOR
	FIRE ALARM REMOTE ANNUNCIATOR
	FIRE ALARM CONTROL PANEL
	FIRE ALARM SIGNAL EXTENDER PANEL

### COMMUNICATIONS

SYMBOL	DESCRIPTION
	CATV JACK, WALL MOUNTED
	CATV JACK CEILING MOUNTED
	MICROPHONE OUTLET
	SPEAKER, SPEAKER WALL MOUNTED
	CLOCK HANGER RECEPTACLE
	EXISTING VOICE/DATA OUTLET
	VOICE/DATA OUTLET - SUBSCRIPT INDICATES NUMBER OF CABLES/JACKS - NO SUBSCRIPT INDICATES 2 CABLES/JACKS
	VOICE/DATA OUTLET MOUNTED IN FLOORBOX - SUBSCRIPT INDICATES NUMBER OF CABLES/JACKS - NO SUBSCRIPT INDICATES 2 CABLES/JACKS
	VOICE OUTLET - WALL MOUNTED
	DATA RACK
	WIRELESS ACCESS POINT, WIRELESS ACCESS POINT WALL MOUNTED - 2 CABLES/JACKS

### ABBREVIATIONS AND MISCELLANEOUS

SYMBOL	DESCRIPTION
AC	ABOVE COUNTER, 4" BACK SPLASH
ATS	AUTOMATIC TRANSFER SWITCH
AFG	ABOVE FINISHED GRADE
AFF	ABOVE FINISHED FLOOR
BLG	BELOW GRADE
BOD	BOTTOM OF DEVICE
C	CONDUIT
CAS	CARD ACCESS SYSTEM
CCTV	CLOSED CIRCUIT TV
CLG	CEILING
COL	CENTER OF DEVICE
CU	COPPER
DVR	DIGITAL VIDEO RECORDER
(E)	EXISTING
EC	ELECTRICAL CONTRACTOR
EF	EXHAUST FAN
GC	GENERAL CONTRACTOR
GND	GROUND
LSI	FIELD ADJUSTABLE LONG TIME, SHORT TIME AND INSTANTANEOUS
LSIG	FIELD ADJUSTABLE LONG TIME, SHORT TIME, INSTANTANEOUS AND GROUND FAULT
MC	MECHANICAL CONTRACTOR
(N)	NEW
NL	NIGHT LIGHT
PTZ	PAN-TILT-ZOOM
QTY	QUANTITY
(R)	RELOCATED
SF	SURFACE
TBB	TELECOMMUNICATIONS BONDING BACKBONE
TC	TEMPERATURE CONTROL CONTRACTOR
TMBG	TELECOMMUNICATIONS MAIN GROUNDING BUS BAR
TTB	TELEPHONE TERMINAL BOARD
TYP	TYPICAL
UG	UNDERGROUND
UON	UNLESS OTHERWISE NOTED
W	WITH
WM	WIRE MOLD
WP	WEATHER PROOF (WHILE IN USE)
XFMR	TRANSFORMER
a.b.c etc	SWITCH DESIGNATION
BN1L-2,4,6	CIRCUIT DESIGNATION, PANEL BN1L, CIRCUITS 2,4,6
1/E501	INDICATES DETAIL 1 ON SHEET E501
①	SHEET WORK NOTE
①	SHEET DEMO WORK NOTE
	HOME RUN TO PANEL
	CONDUIT CONCEALED IN CEILING OR WALL
	CONDUIT CONCEALED UNDER FLOOR
	LOW VOLTAGE CIRCUIT
	FIBER OPTIC CABLE
	CABLE TRAY
	CIRCUIT, NUMBER OF HASH MARKS INDICATES NUMBER OF CONDUCTORS IN CABLE/RACEWAY. GROUND WIRE IS NOT SHOWN BUT SHALL BE INCLUDED. NO HASH MARKS INDICATES 2 CONDUCTORS PLUS GROUND.

### SURVEILLANCE SYSTEM

SYMBOL	DESCRIPTION
	CAMERA, CEILING AND WALL MOUNTED DOME, PTZ
	CAMERA, CEILING AND WALL MOUNTED DOME, FIXED
	CAMERA, CEILING MOUNTED, 360 DEGREE
	CAMERA
	DIGITAL VIDEO RECORDER
	SURVEILLANCE POWER SUPPLY
	MONITOR

### SECURITY SYSTEM

SYMBOL	DESCRIPTION
	CARD READER
	SPEAKER SIGNAL DEVICE
	DOOR CONTROLLER
	DOOR SWITCH CONTACT
	KEYPAD
	POWER TRANSFER SWITCH
	MOTION SENSOR REQUEST TO EXIT
	MANUAL REQUEST TO EXIT
	POWER SUPPLY W/BATTERY, BY DIV 8, INSTALLED AND CONNECTED BY DIV 27
	CONNECTION TO REQUEST TO EXIT & LATCH BOLT MONITORING
	CONNECTION TO PANIC REQUEST TO EXIT
	CONNECTION TO MAGNETIC DOOR LOCK
	CONNECTION TO MAGNETIC DOOR POSITION SWITCH
	CONNECTION TO ELECTRIC DOOR STRIKE
	CONNECTION TO ELECTRIC LATCH
	CONNECTION TO ELECTRIC AUTO OPENER
	CONNECTION TO FIRE ALARM CONTACT
	INDICATES SECURITY DOOR 1
	PANEL
	SECURITY CONTROL PANEL
	SECURITY DOOR CONTROLLERS
	SECURITY CAMERA

### DEVICES AND POWER

SYMBOL	DESCRIPTION
\$	SWITCH - SPST
2	SINGLE POLE, DOUBLE THROW
3	THREEWAY
4	FOURWAY
K	KEY OPERATED
P	PILOT LIGHT
WP	WEATHERPROOF
OS	OCCUPANCY SENSOR (DUAL TECHNOLOGY)
D	DIMMER
MC	SPOT-MOMENTARY CONTACT
LV	LOW VOLTAGE
T	TIMER SWITCH
TS	TEST SWITCH
VS	VACANCY SENSOR (DUAL TECHNOLOGY) WITH DIMMING
	OCCUPANCY SENSOR SWITCH (CEILING) - SUBSCRIPT IS TYPE
	RECEPTACLE - SIMPLEX
	RECEPTACLE - DUPLEX, MOUNTING IN CEILING
	GFI RECEPTACLE - DUPLEX, MOUNTING IN CEILING
	RECEPTACLE - DUPLEX
	GFI RECEPTACLE - DUPLEX (GROUND FAULT INTERRUPT)
	D DEVICE RECEIPT W/2 USB PORTS
	DC DROP CORD
	WP WEATHERPROOF COVER & WEATHER RESISTANT RECEPTACLE
	TAMPER RESISTANT
	SURGE PROTECTED
	ISOLATED GROUND
	FILLED CENTER INDICATES HOSPITAL GRADE EMERGENCY RECEPTACLE
	RECEPTACLE - DOUBLE DUPLEX
	GFI RECEPTACLE - DOUBLE DUPLEX
	- SAME INDICATORS AS SHOWN FOR DUPLEX RECEPTACLE
	RECEPTACLE - 208V
	RANGE - NEMA 14-50R
	DRYER - NEMA 10-30R
	WELDER - NEMA 14-50R
	* NEMA CONFIGURATION AS NOTED
	208V RECEPTACLE IN RECESSED FLOORBOX
	DUPLEX RECEPTACLE/GFI IN RECESSED FLOORBOX
	DOUBLE DUPLEX RECEPTACLE/GFI IN RECESSED FLOORBOX
	J-BOX - BOX INDICATES FLOOR MOUNTING - 4"x4"x2-1/8" DEEP UNLESS OTHERWISE NOTED
	POWER POLE
	THERMOSTAT/TEMPERATURE SENSOR BY MC OR TC, J-BOX AND CONDUIT TO CEILING BY EC
	CARBON MONOXIDE DETECTOR BY MC, J-BOX & CONDUIT TO CEILING BY EC
	MANUAL MOTOR DISCONNECT/STARTER SWITCH
	EMERGENCY PUSHBUTTON
	RELAY
	PHOTOCELL, PHOTOCELL WALL MOUNTED
	SPECIAL PURPOSE CONNECTION - BOX INDICATES FLOOR MOUNTING - WORK AS NOTED
	ELECTRIC MOTOR CONNECTION
	COMBINATION STARTER/DISCONNECT SWITCH
	DISCONNECT SWITCH
	CONTACTOR
	CIRCUIT BREAKER
	VARIABLE FREQUENCY DRIVE
	CONTROL PANEL
	LIGHTING RELAY PANEL
	TEMPERATURE CONTROL PANEL
	GENERATOR ANNUNCIATOR PANEL
	PA CONTROL PANEL
	MED GAS ALARM PANEL
	TIME CLOCK
	EXISTING PANELBOARD, SURFACE MOUNTED
	EXISTING PANELBOARD, FLUSH MOUNTED
	PANELBOARD, SURFACE MOUNTED
	PANELBOARD, FLUSH MOUNTED
	ELECTRIC METER, BUILDING MOUNTED
	TRANSFORMER, INTERIOR
	TRANSFORMER, EXTERIOR














LEVY DYKEM


630 CONGRESS AVENUE  
SUITE 200  
AUSTIN, TEXAS 78701  
512.242.9477  
WWW.LEVYDYKEM.COM

SEAL OF THE STATE OF TEXAS  
OFFICE OF THE COMPTROLLER OF PUBLIC ACCOUNTS  
BUCKLEY H. PARKS  
COMPTROLLER OF PUBLIC ACCOUNTS  
OFFICE OF THE COMPTROLLER OF PUBLIC ACCOUNTS  
OFFICE OF THE COMPTROLLER OF PUBLIC ACCOUNTS  
OFFICE OF THE COMPTROLLER OF PUBLIC



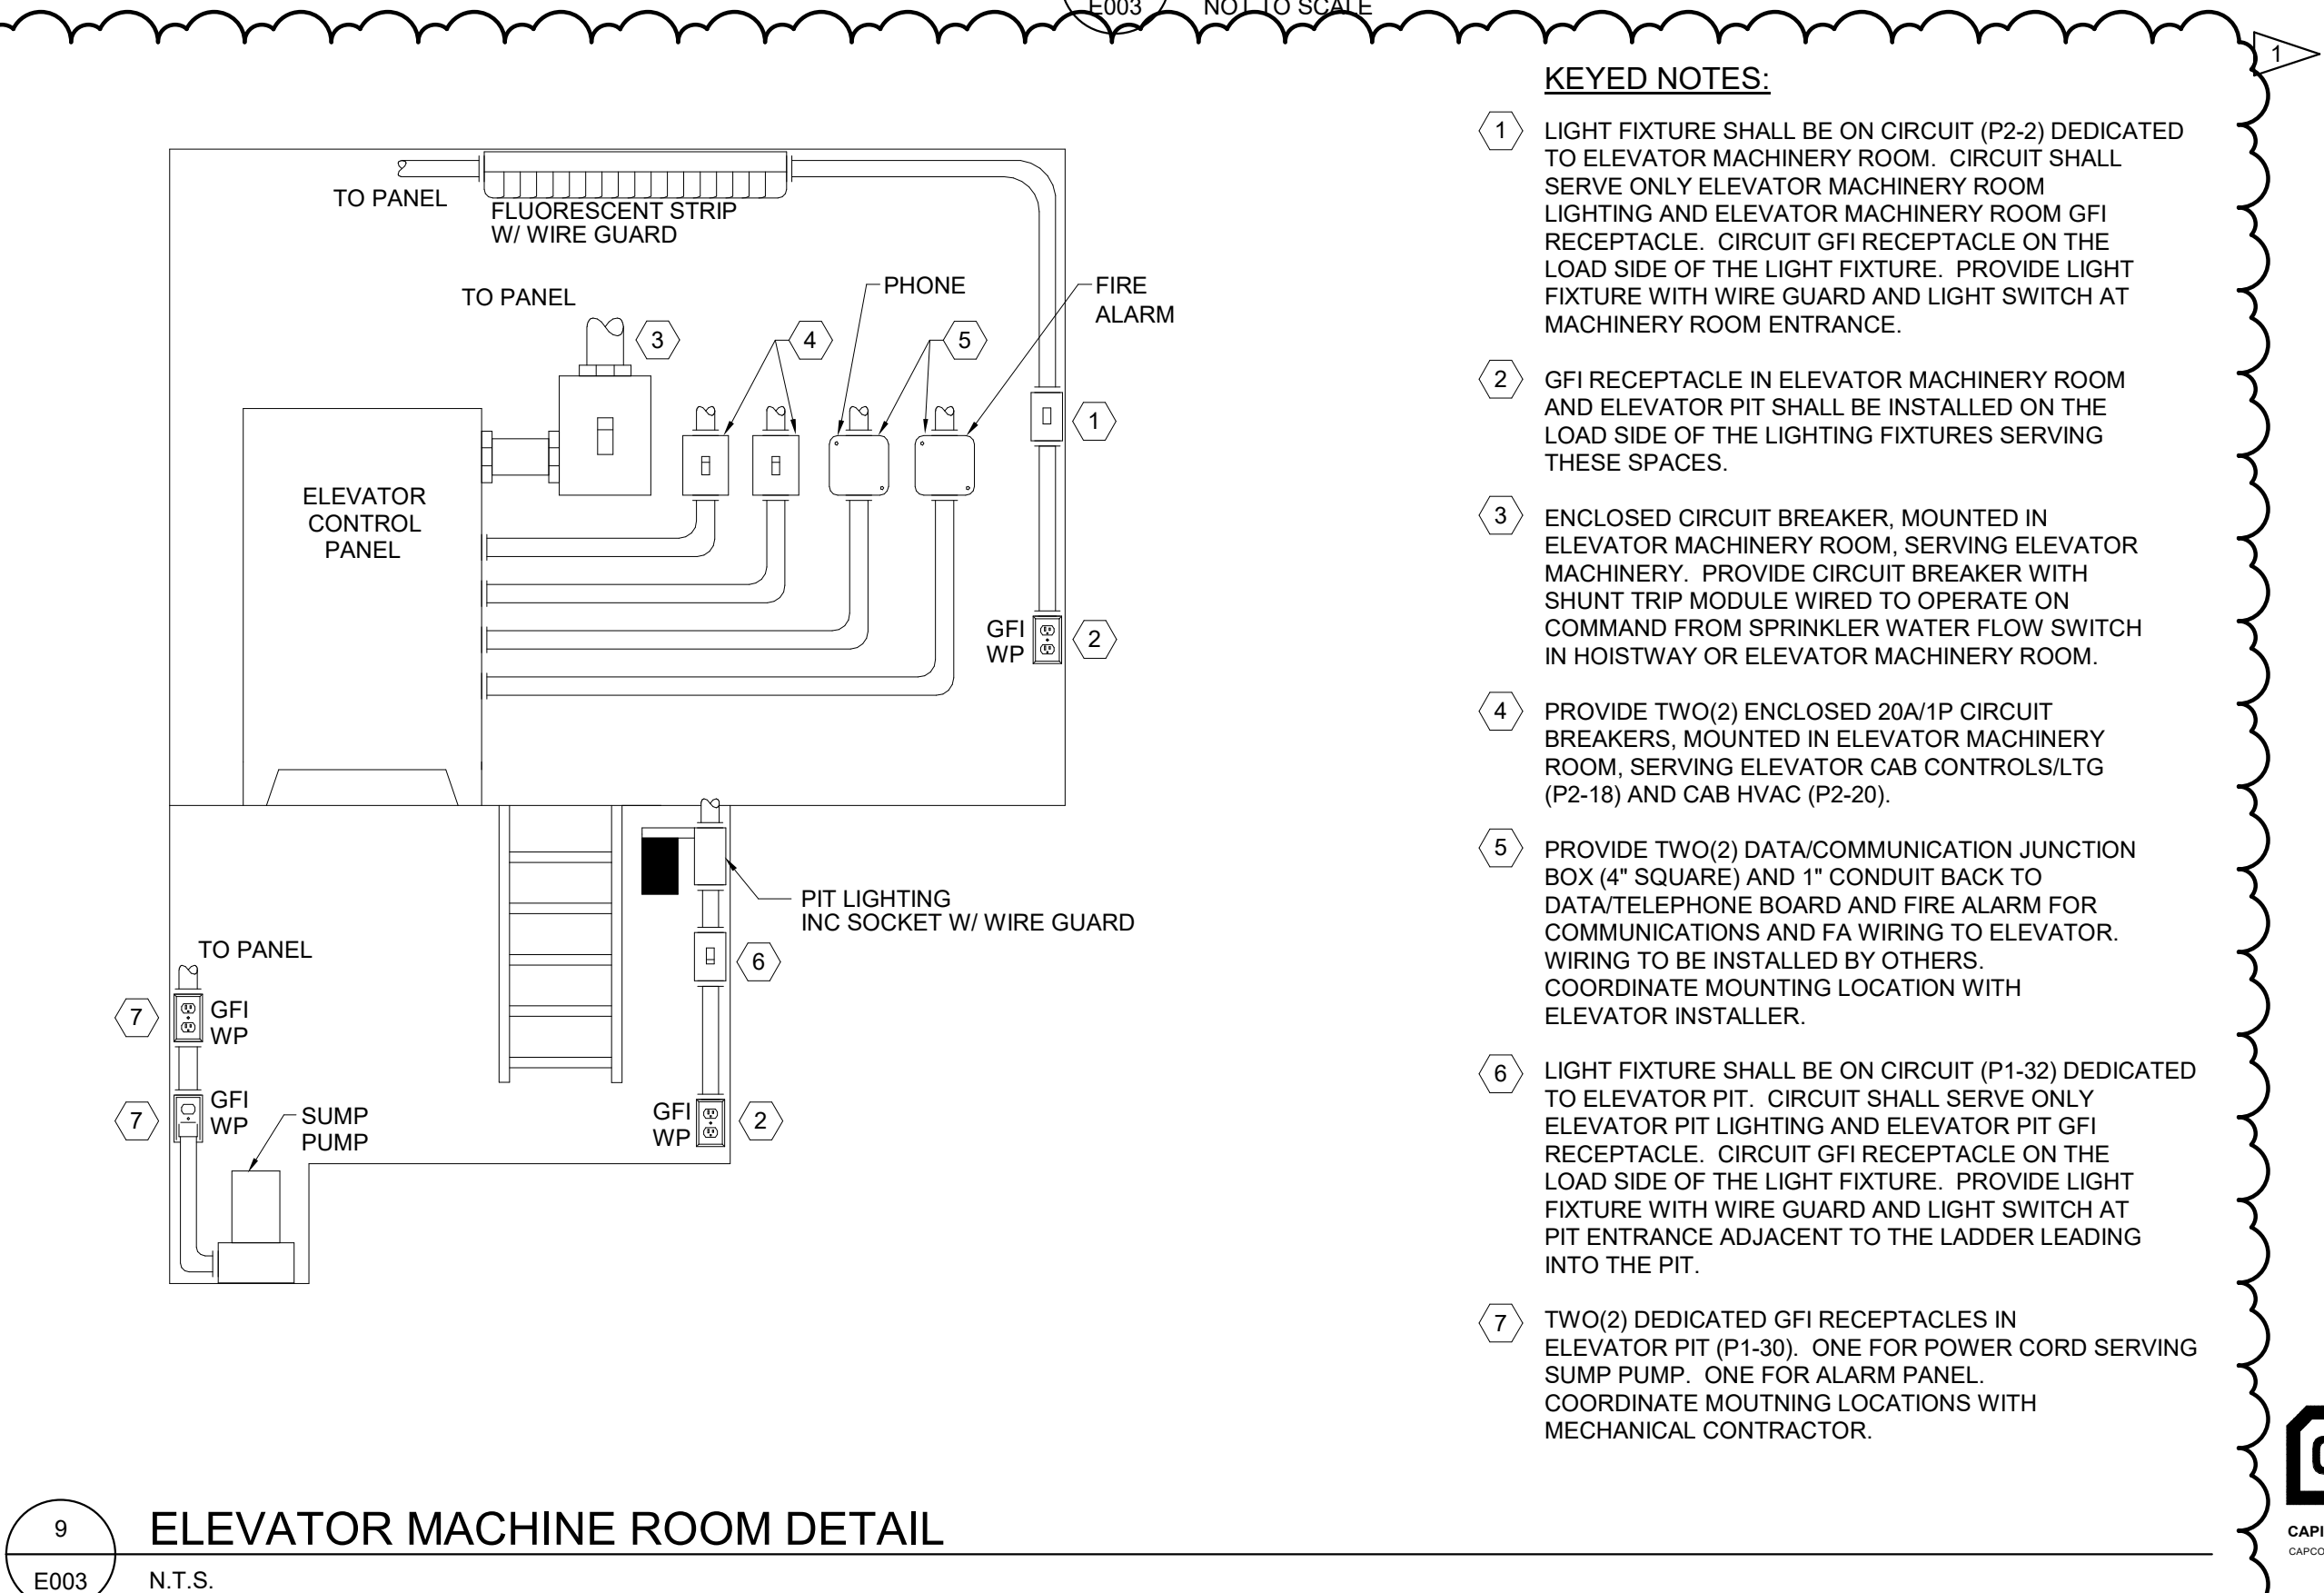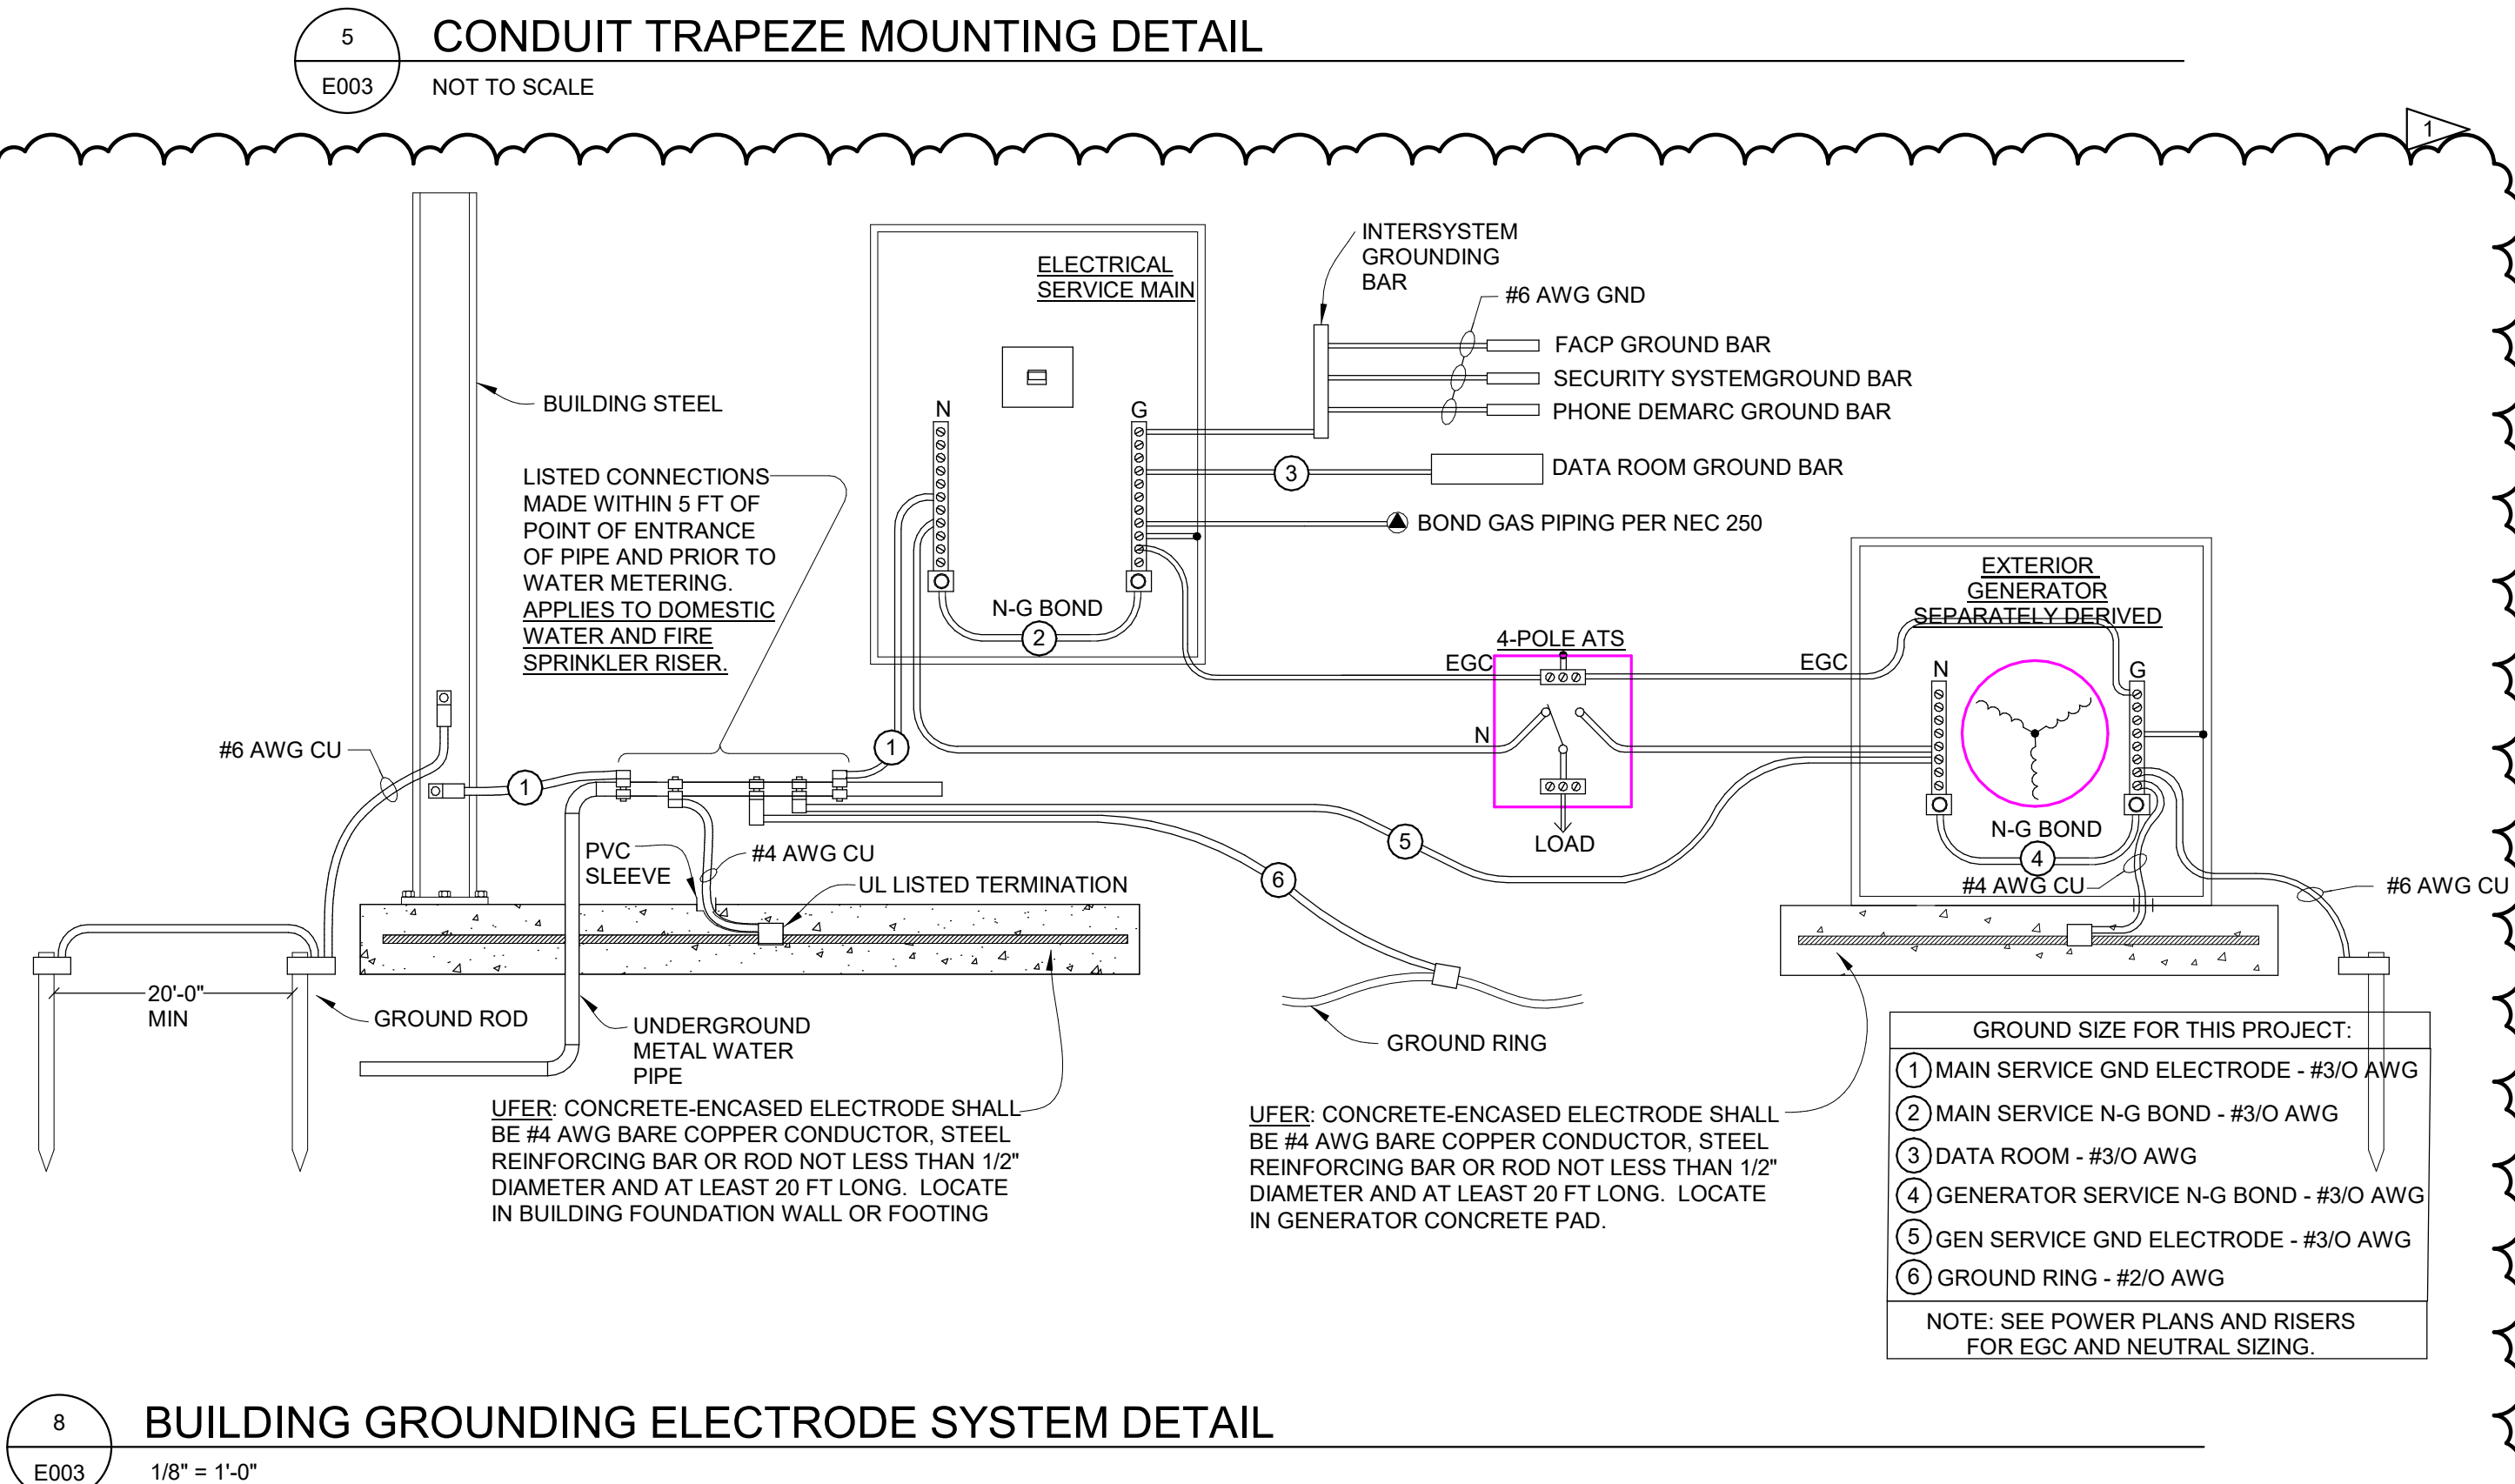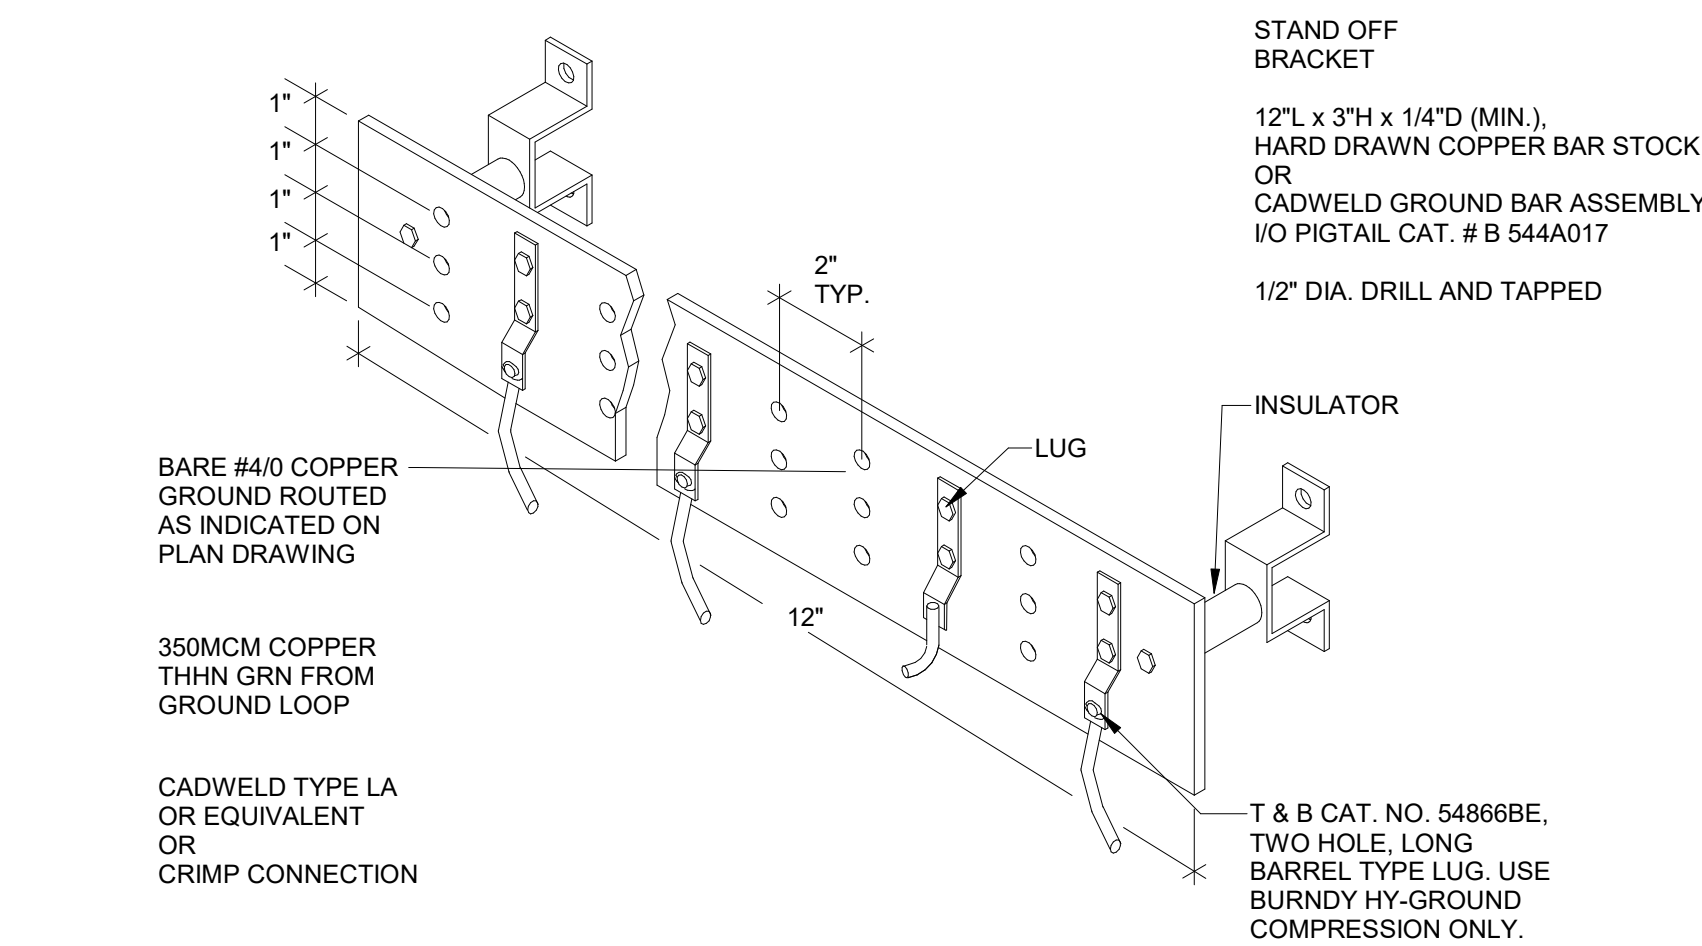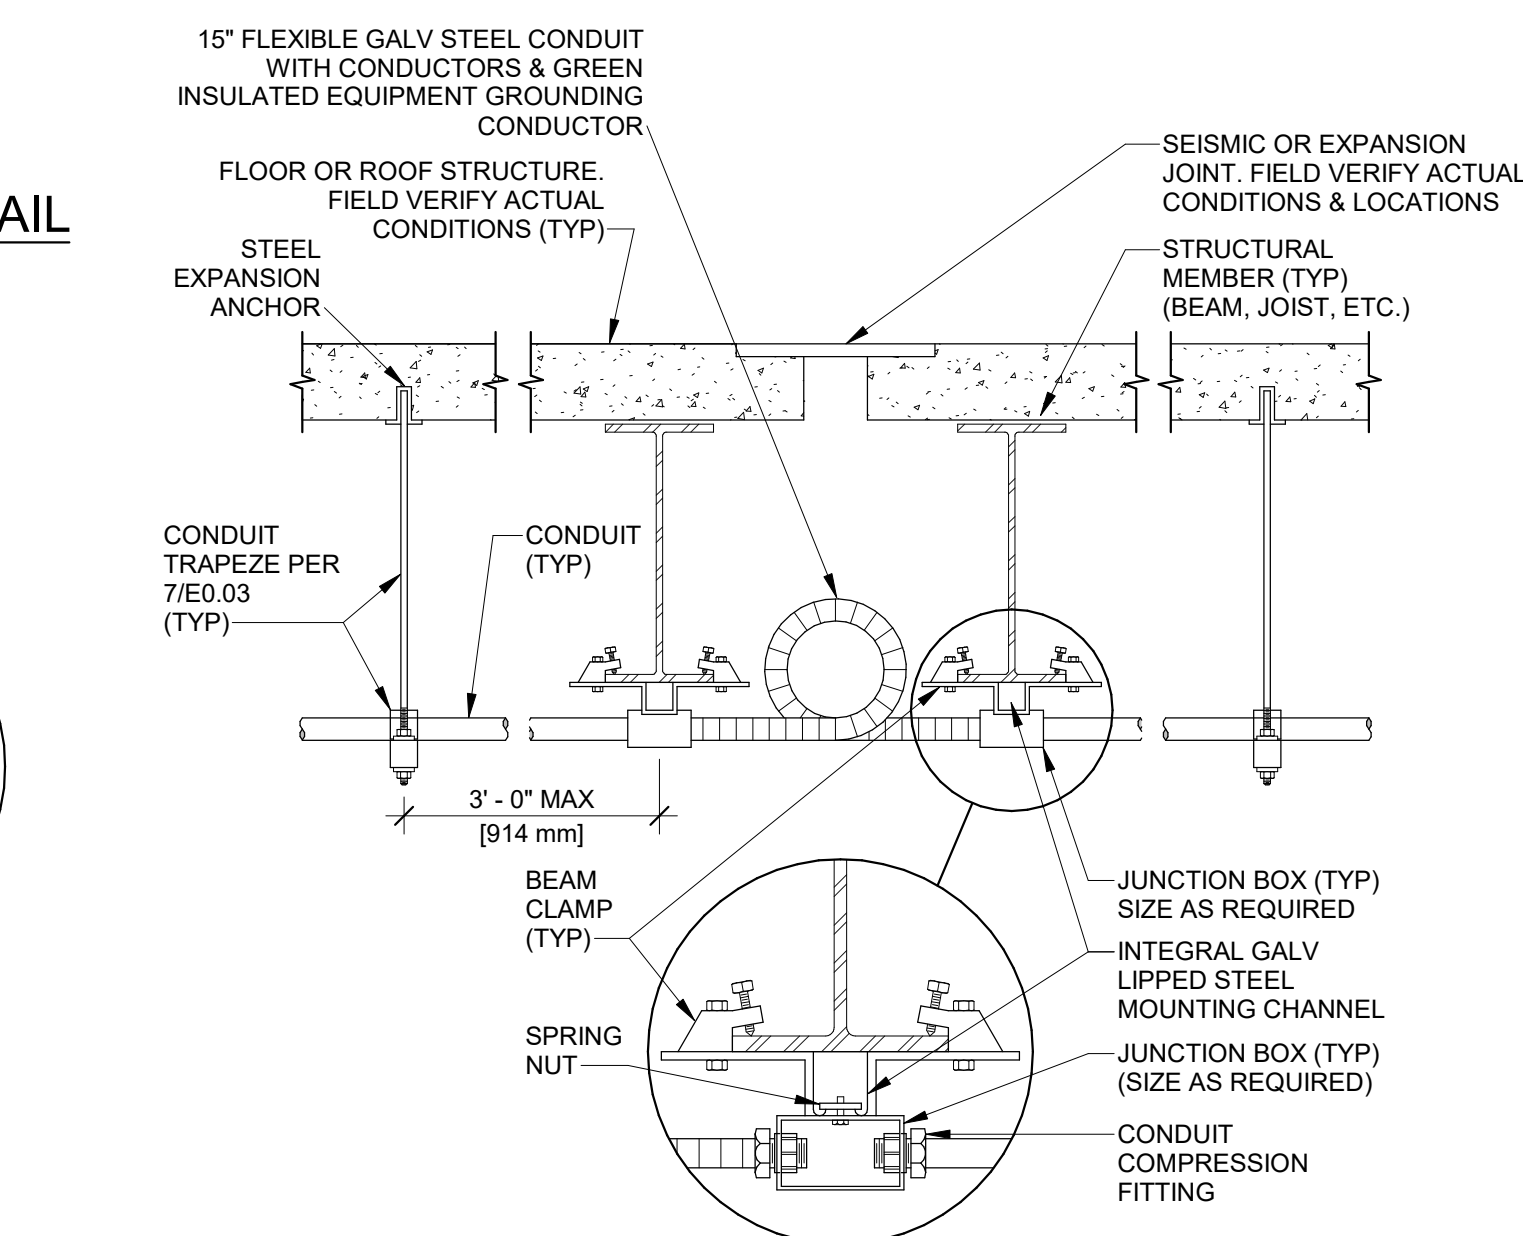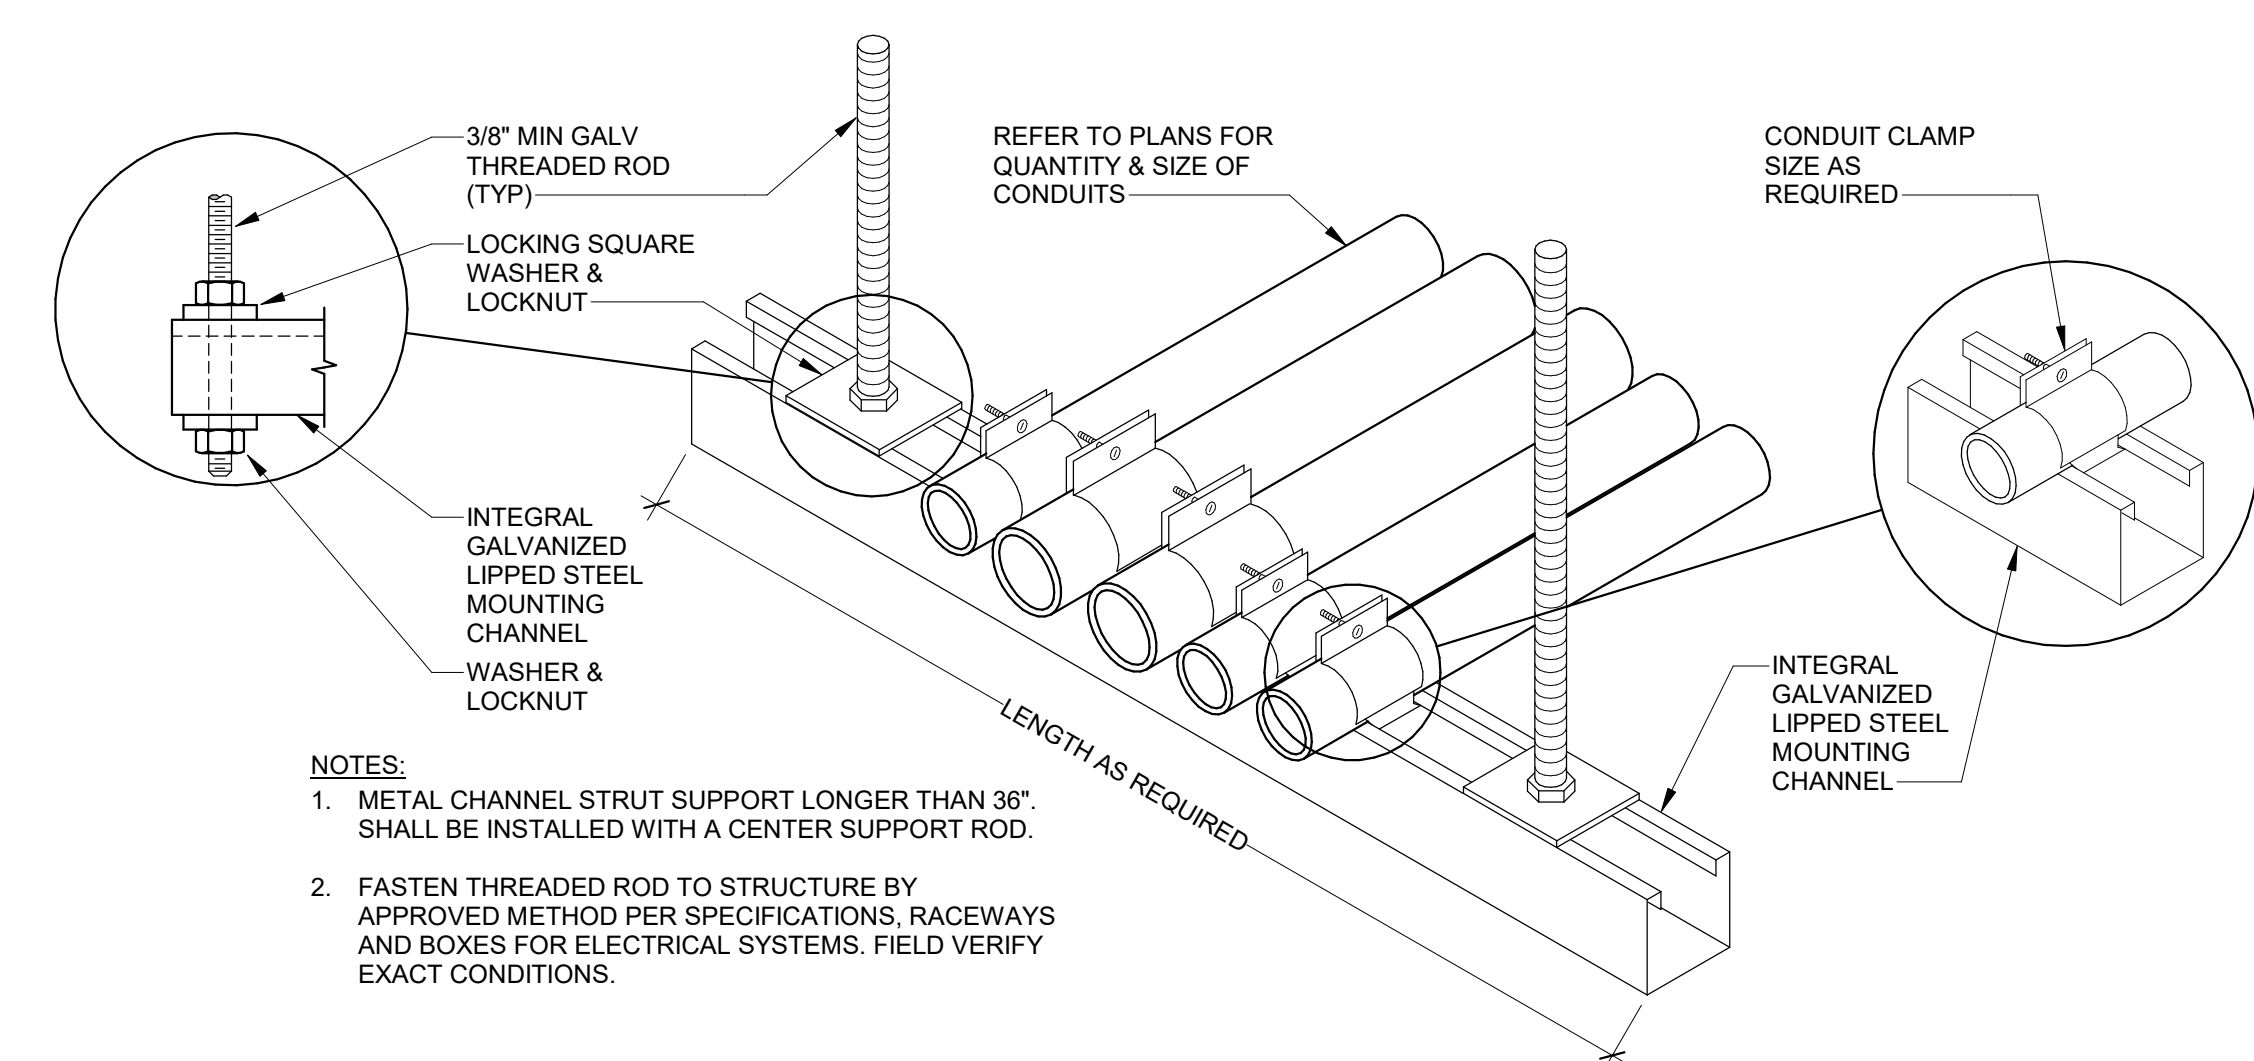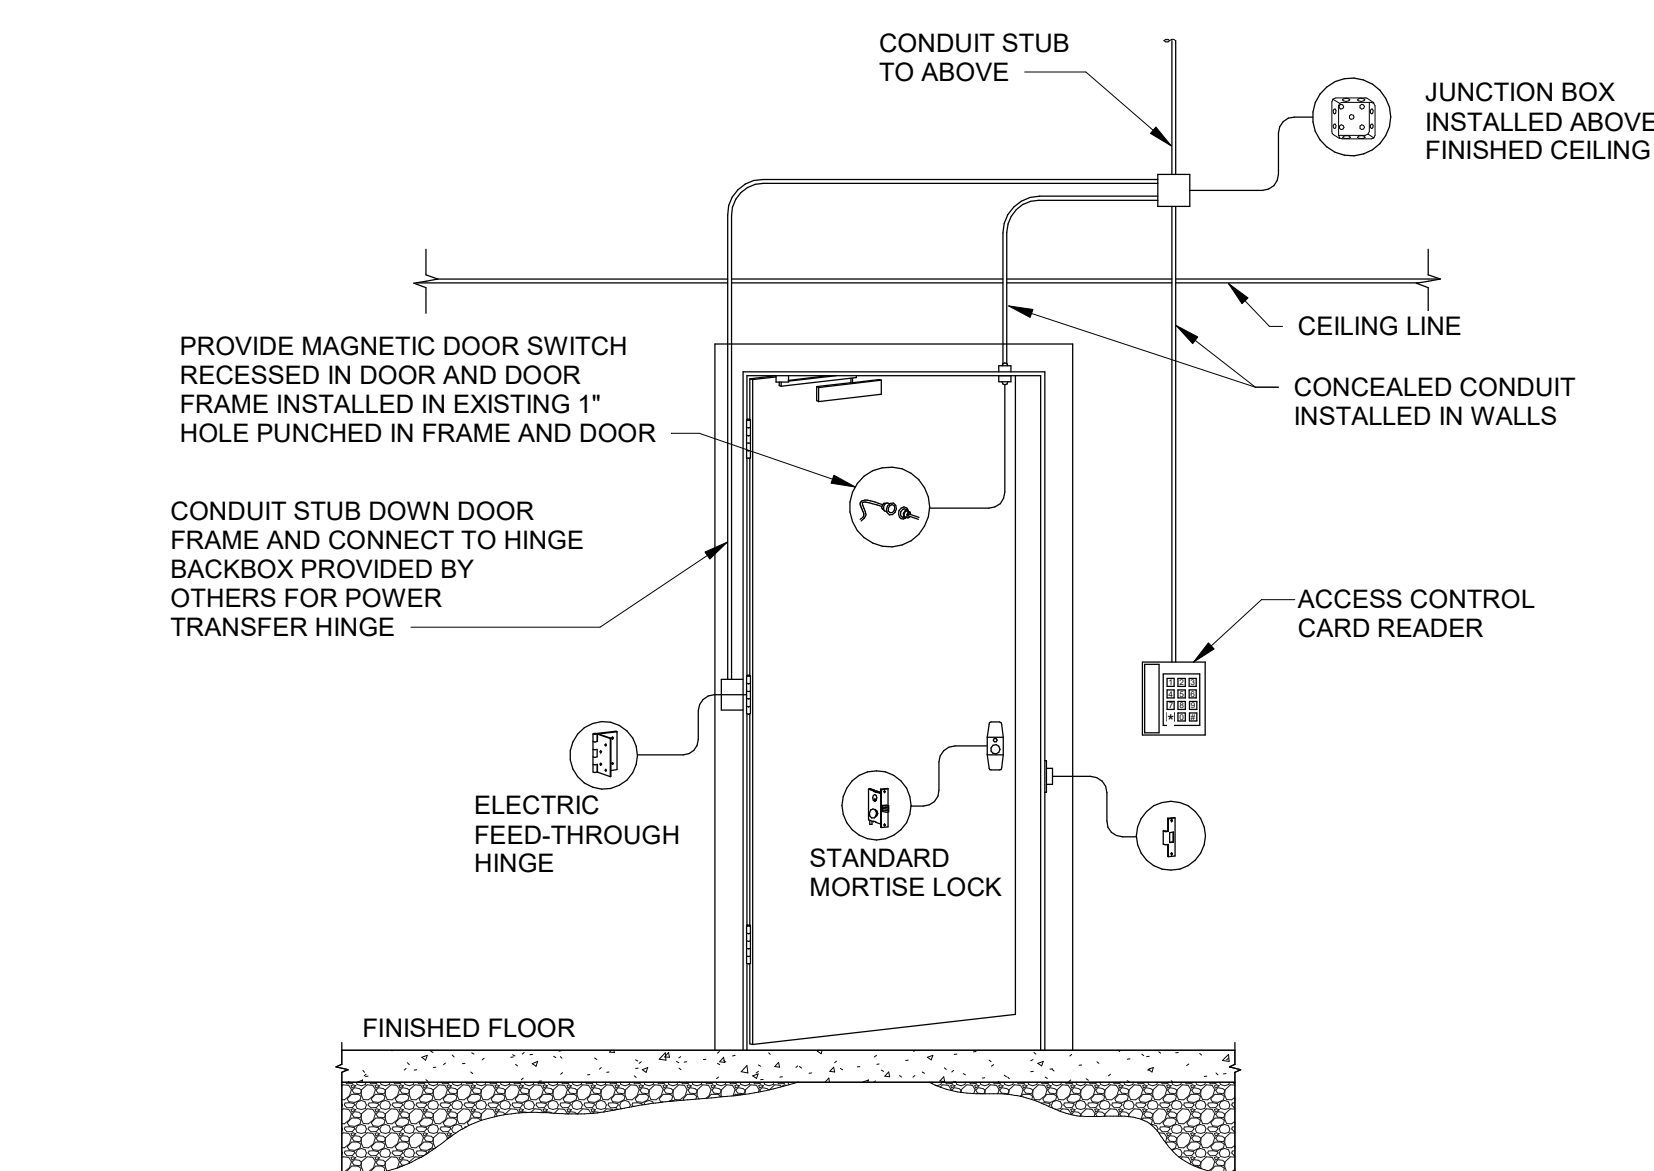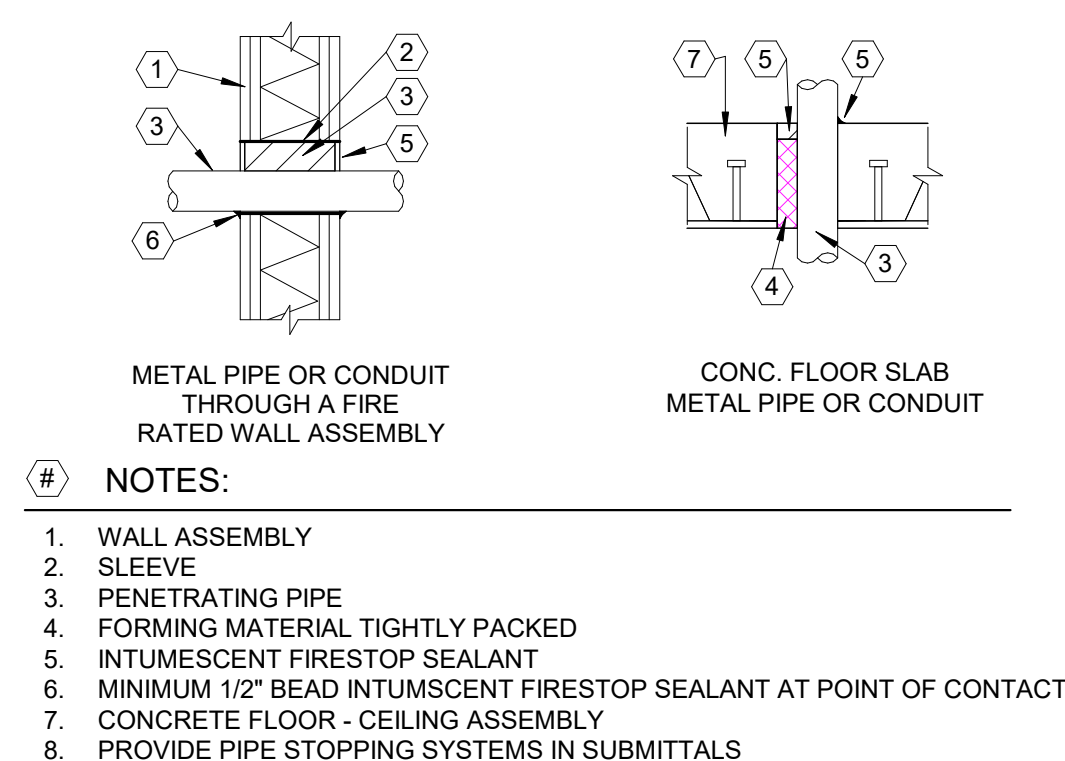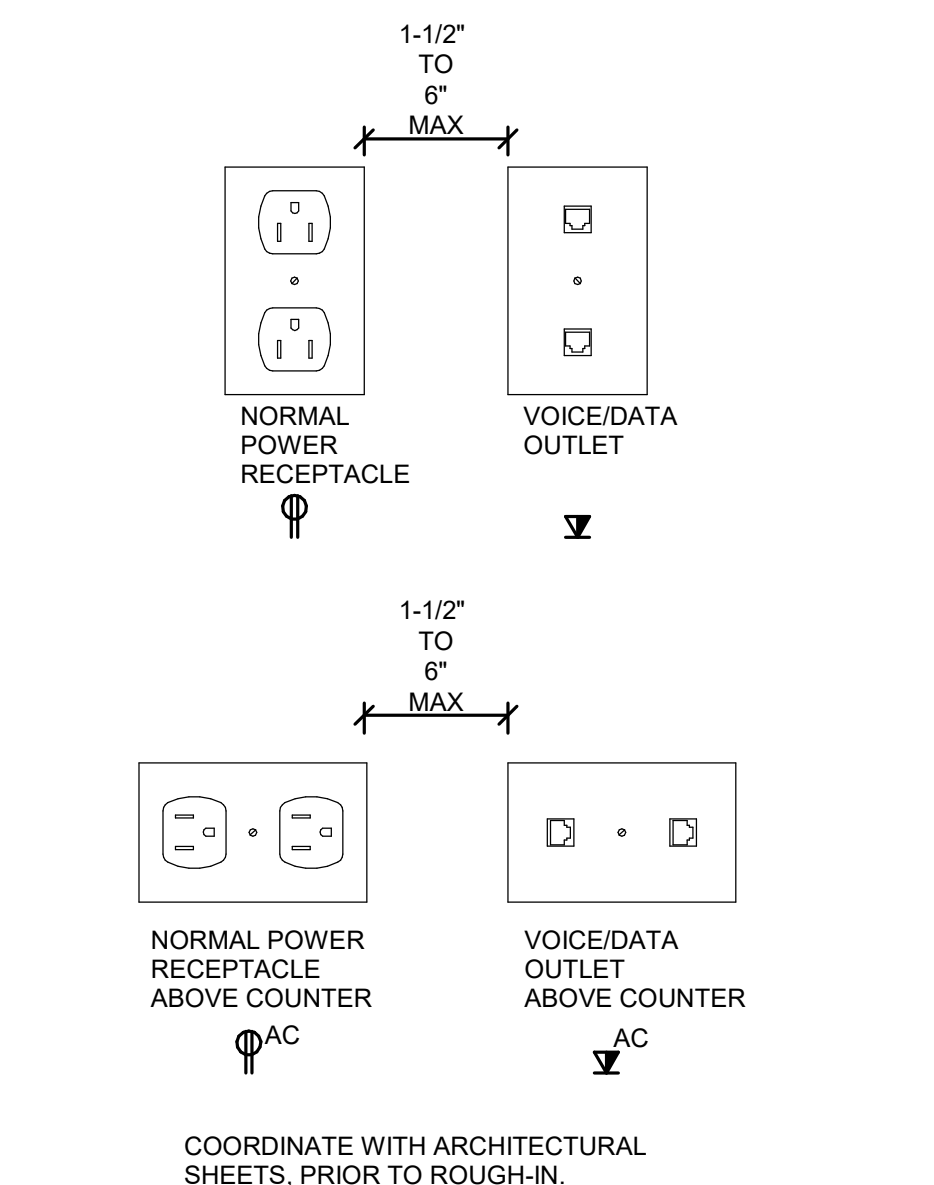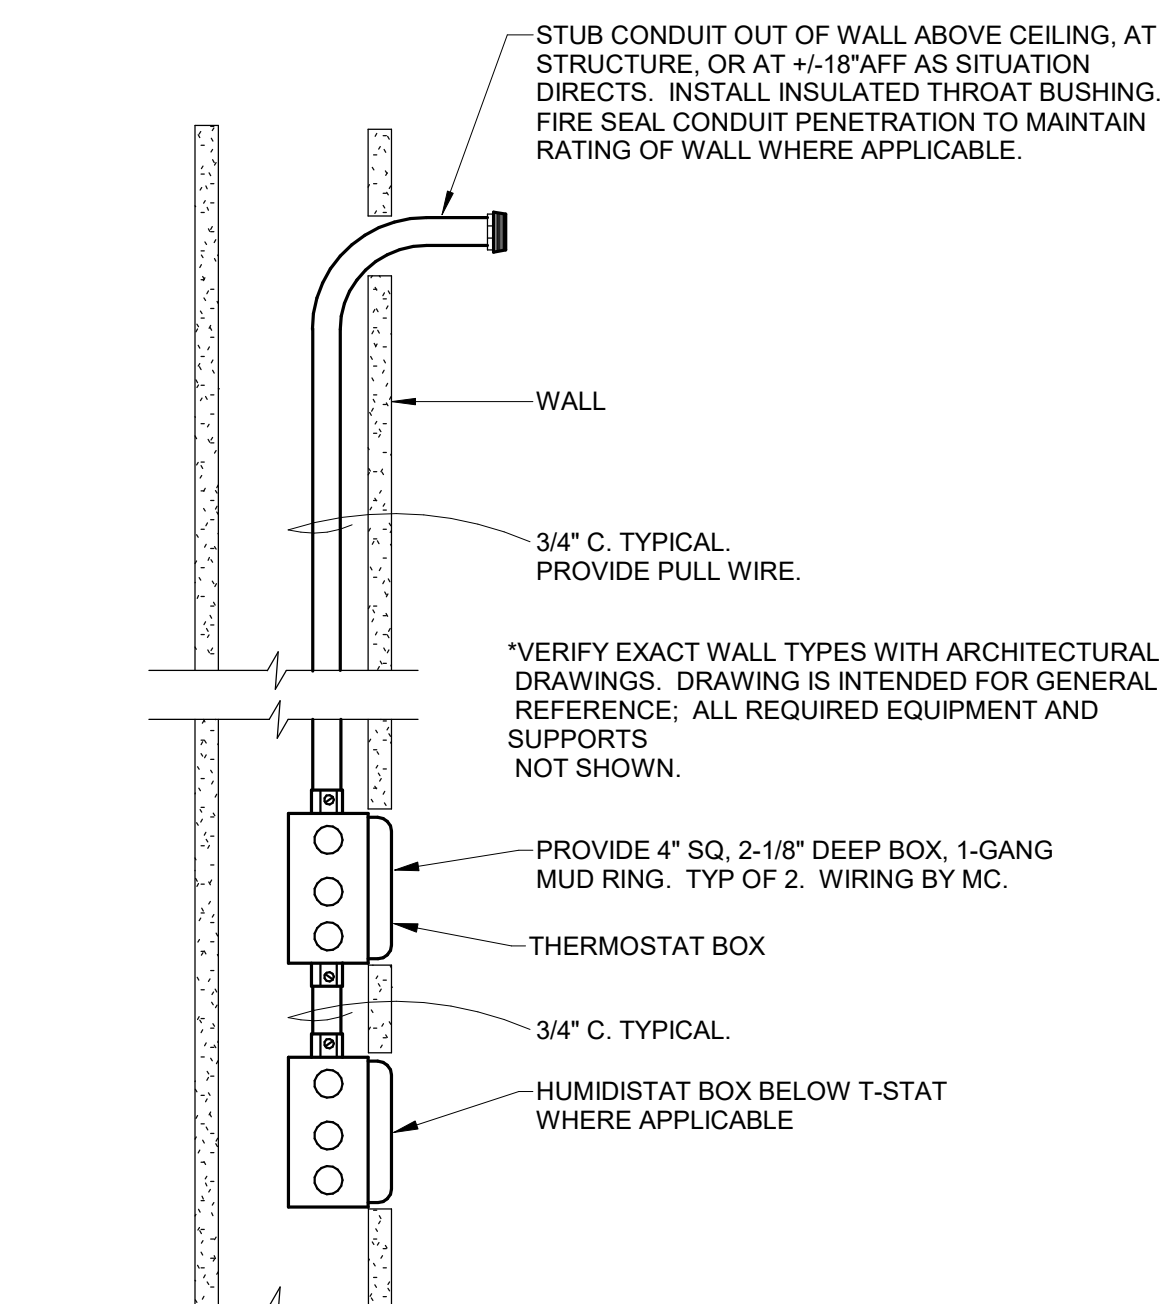



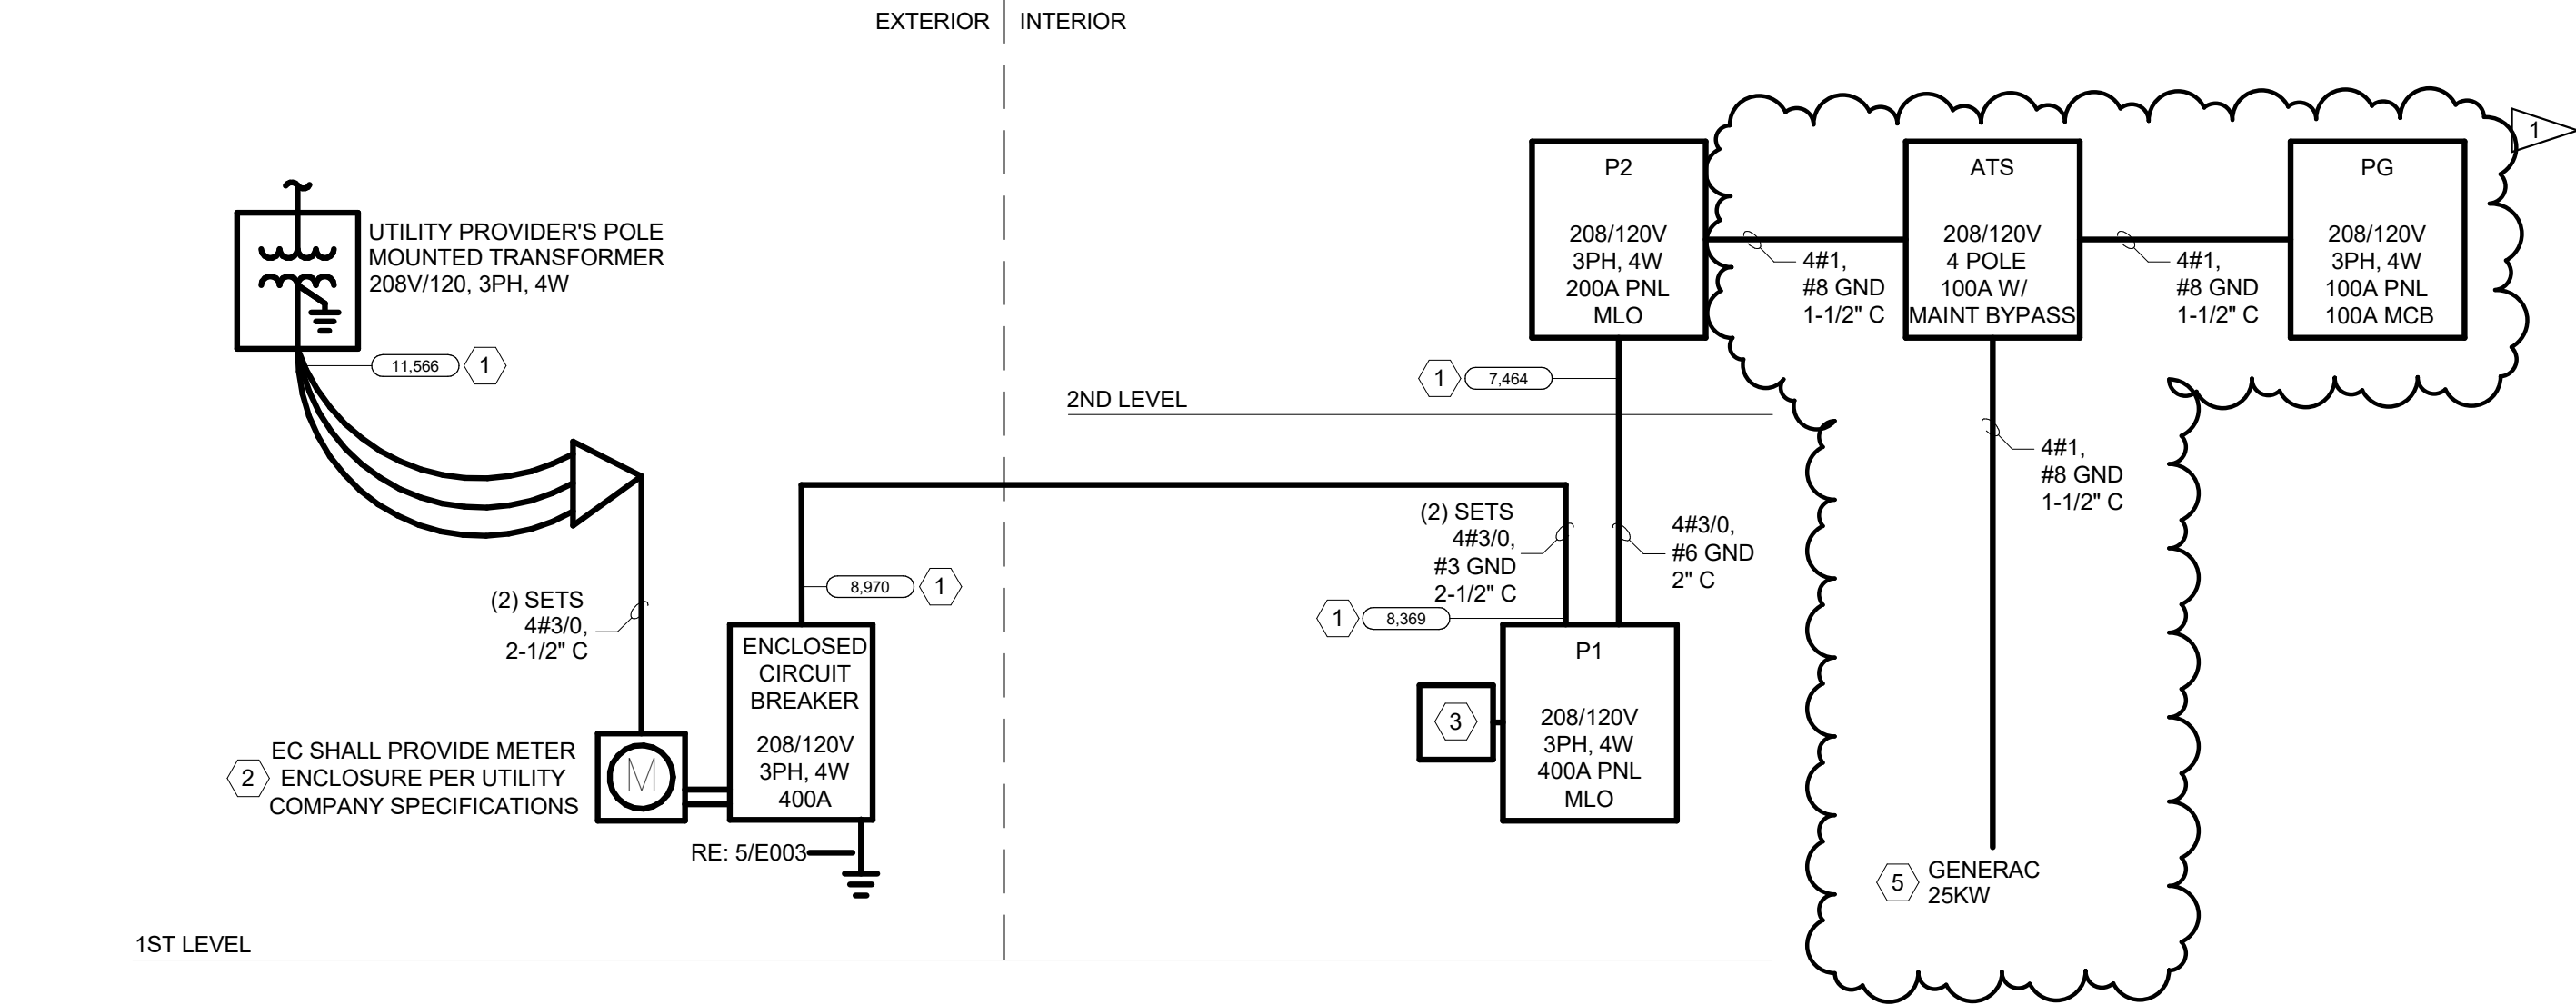

## ELECTRICAL ONE-LINE DIAGRAM

LIGHTING FIXTURE SCHEDULE									
NOTES: 1. UON, ALL LIGHT FIXTURE SPECIFICATIONS AND FINISHES SHALL BE SELECTED AND APPROVED BY THE ARCHITECT AND TENANT PRIOR TO PURCHASE AND INSTALLATION. SUBMITTALS SHALL INCLUDE 2. ACTUAL PAINT FINISH COLOR SAMPLE AND ARCHITECTURAL COLOR PAINT SELECTION BROCHURE FOR OPTIONS. 3. SEE ARCHITECTURAL SHEETS FOR MOUNTING HEIGHT AND DETAILS 4. EMERGENCY FIXTURES SHALL HAVE 90-MINUTE BATTERY PACK/INVERTER PACK INSTALLED. 5. UON, VERIFY LAMP COLOR TEMPERATURE REQUIREMENTS (KELVIN) WITH THE OWNER AND ARCHITECT PRIOR TO PURCHASE. 6. UON, CONTROLS PRICING AND LIGHTING FIXTURE PRICING SHALL BE SEPERATE. UON, WHEN SUBSTITUTING FIXTURES, CONTRACTOR SHALL FURNISH BREAK-OUT PRICING OF BOTH THE SPECIFIED AND SUBSTITUTE FIXTURES FOR COMPARISO...									
TYPE	MFGR	FIXTURE CATALOG NUMBER	MOUNTING TYPE	LAMP	NO.	FIXTURE VOLTAGE	FIXTURE WATTAGE	NOTES	
L1	WILLIAMS	BAR-22-L30-835-DIM-UNV & BAR-22-L30-835-EM/10W-DIM-UNV	LAY IN	LED	1	120-277V	23	4	
L1A	WILLIAMS	BAR-22-L20-835-DIM-UNV & BAR-22-L20-835-EM/10W-DIM-UNV	LAY IN	LED	1	120-277V	23	4	
L2	COOPER	75S-2-LL25-835-DRV-UNV	SURFACE	LED	1	120-277V	18	3	
L3	TECH	SLF-2-L13-935-HIA-DIM-UNV	WALL	LED	1	120-277V	10	3	
L4	WILLIAMS	BAR-24-L40-835-DIM-UNV & BAR-24-L40-835-EM/10W-DIM-UNV	LAY IN	LED	1	120-277V	31	4	
L5	WILLIAMS	6DR-TL-L20-835-EM/10W-DIM-UNV-OW-OF-CS (EM MODE)	RECESSED	LED	1	120-277V	10		
L6	WILLIAMS	LRX4-4-L8-835-BMA-DIM-UNV	WALL	LED	1	120-277V	27	3	
L7E	BEGA-US	LGL-FCW-25-SV-30-N-XX-EM	SURFACE	LED	1	120-277V	25	5	
X	COOPER	EU-X-7-X-R	-	LED	1	120-277V	5		

PANEL: P1																				
LOCATION:			AMPS: 400 A			AIC RATING:			SEE ONE-LINE DIAGRAM			NOTES (NT):								
MANUFACTURER:			SEE SPECIFICATIONS			MOUNTING:			RECESSED											
MODEL TYPE:			PANELBOARD			PHASE:			TYPE 1											
TYPE OF MAIN:			MLO			WIRE: 4			ENCLOSURE:											
TYPE OF MAIN:						FEATURES:														
LOAD NAME	NT	CB	P	WIRE SIZE		C SIZE	CKT NO	A	B	C	CKT NO	C SIZE	WIRE SIZE	P	CB	NT	LOAD NAME			
				H	N GND	(3/4" UON)						(3/4" UON)	N	GND	H					
LIGHTING CONTACTOR		20	1	#12	#12	X	1	500	360		2						RESTROOMS			
1ST FLR LIGHTING		20	1	#10	#10	X	3		954	0	4	--	--	--	1	20	--	SPARE		
EXTERIOR LIGHTING		20	1	#12	#12	X	5				6	--	--	--	1	20	--	SPARE		
CONF. ROOM		20	1	#12	#12	X	7	1080	360		8	X	#12	#12	1	20	--	RESTROOMS		
HALL CORR. RECEPT.		20	1	#12	#12	X	9		900	1000	10	X	#12	#12	1	20	--	REFRIGERATOR		
BRK RM CORR. RECEPT.		20	1	#12	#12	X	11			1260	1260	12	X	#12	#12	1	20	--	OFFICE 123	
WORKSPACE WRKSTN		20	1	#12	#12	X	13	720	180		14	X	#12	#12	1	20	--	PRINTER		
WORKSPACE WRKSTN		20	1	#12	#12	X	15		720	180	16						--	PRINTER		
EF-1-1 thru EF-1-3		20	1	#12	#12	X	17			360	0	17	--	--	--	1	20	--	SPARE	
SPARE	--	20	1	--	--	--	19	0	0		20	--	--	--	--	1	20	--	SPARE	
SPARE	--	20	1	--	--	--	21		0	360		22	X	#12	#12	1	20	--	SYSTEM FURNITURE	
SPARE	--	20	1	--	--	--	23			0	360	24	X	#12	#12	1	20	--	SYSTEM FURNITURE	
SPARE	--	20	1	--	--	--	25	0	360		26	X	#12	#12	1	20	--	SYSTEM FURNITURE		
SPARE	--	20	1	--	--	--	27		0	360	28	X	#12	#12	1	20	--	SYSTEM FURNITURE		
SPARE	--	20	1	--	--	--	29			0	360	30	X	#12	#12	1	20	--	GFCI SUMP PUMP	
SPARE	--	20	1	--	--	--	31	0	500		32	X	#12	#12	1	20	--	ELEVATOR PIT LIGHTING		
SPARE	--	20	1	--	--	--	33		0	0	34	--	--	--	--	1	20	--	SPARE	
SPARE	--	20	1	--	--	--	35			0	0	36	--	--	--	--	1	20	--	SPARE
SPARE	--	20	1	--	--	--	37	0	0		38	--	--	--	--	1	20	--	SPARE	
SPARE	--	20	1	--	--	--	39		0	0	40	--	--	--	--	1	20	--	SPARE	
SPARE	--	20	1	--	--	--	41			0	0	42	--	--	--	--	1	20	--	SPARE
SPARE	--	20	1	--	--	--	43	0	0		44	--	--	--	--	1	20	--	SPARE	
SPARE	--	20	1	--	--	--	45		0	0	46	--	--	--	--	1	20	--	SPARE	
SPARE	--	20	1	--	--	--	47			0	0	48	--	--	--	--	1	20	--	SPARE
SPARE	--	20	1	--	--	--	49	1250	0		50	--	--	--	--	1	20	--	SPARE	
SPARE	--	20	1	--	--	--	51		2600	0	52	--	--	--	--	1	20	--	SPARE	
SPARE	--	20	1	--	--	--	53			2600	0	54	--	--	--	--	1	20	--	SPARE
SPARE	--	20	1	--	--	--	55	209	0		56	--	--	--	--	1	20	--	SPARE	
SPARE	--	20	1	--	--	--	57		26439	0	58	--	--	--	--	1	20	--	SPARE	
SPARE	--	20	1	--	--	--	59			270	0	60	--	--	--	--	1	20	--	SPARE
							26261	33513	34504											
							219 A	289 A	297 A											
LOAD CLASSIFICATION				CONNECTED LOAD				DEMAND FACTOR				ESTIMATED DEMAND				PANEL TOTALS				
EQUIPMENT				9000				100.00%				9000				TOTAL CONNECTED LOAD: 94278				
LIGHTING				2300				100.00%				2300				TOTAL CONNECTED AMPS: 262 A				
MOTORS				39627				100.00%				39627								
RECEPTACLES				40850				62.24%				25425								
CONTINUOUS				2500				125.00%				3125				TOTAL ESTIMATED DEMAND: 79478				
																	TOTAL EST DEMAND AMPS 221 A			

PANEL: P2																		
LOCATION:		ELEV. MACH. RM....		AMPS: 200 A		AIC RATING:		SEE ONE-LINE DIAGRAM		NOTES (NT):								
MANUFACTURER:		SEE.....		VOLTS: 208Y/120		MOUNTING:		RECESSED										
MODEL TYPE:		PANELBOARD		PHASE: 3		ENCLOSURE:		TYPE 1										
TYPE OF MAIN:		MLO		WIRE: 4		FEATURES:												
LOAD NAME	NT	CB	P	WIRE SIZE H GND N	C SIZE (3/4" UON)	CKT NO	A	B	C	CKT NO	C SIZE (3/4" UON)	WIRE SIZE N GND H	P	CB	NT	LOAD NAME		
2ND FLR LIGHTING	20	1	#10	#10	X	1	703	211		2		X #12	#12	1	20	ELEVATOR ROOM LTG & GFCI		
BREAKRM & RR'S GFCI	20	1	#12	#12	X	3		900	3307	4		X #8	#8	2	35	CU-1-1		
OFFICE RECEPITS	20	1	#12	#12	X	5			1620	3307	6	--	--	--	--	--		
CORR & STORAGE RECEPITS	20	1	#12	#12	X	7	1080	2600		8		X #10	#8	2	25	FCU-2-1		
CONF. RM RECEPITS	20	1	#12	#12	X	9		1440	2600	10	--	--	--	--	--	CU-2-1		
OFFICE RECEPITS	20	1	#12	#12	X	11			1440	3754	12	X #8	#8	2	40	CU-2-1		
FRIDGE	20	1	#12	#12	X	13	1000	3754		14								
SYSTEM FURNITURE	20	1	#12	#12	X	15		360	720			X #12	#12	1	20	LAB QUAD		
SYSTEM FURNITURE	20	1	#12	#12	X	17			360	1000		X #12	#12	1	20	ELEVATOR CAB LTG		
SYSTEM FURNITURE	20	1	#12	#12	X	19	360	1500		20		X #12	#12	1	20	ELEVATOR CAB HVAC		
SYSTEM FURNITURE	20	1	#12	#12	X	21		360	720	22		X #12	#12	1	20	LAB QUAD		
LAB QUAD	20	1	#12	#12	X	23			720	0	24	--	--	--	1	20	SPARE	
LAB QUAD	20	1	#12	#12	X	25	720	0		26		--	--	--	1	20	SPARE	
SPARE	--	20	1	--	--	--	27	0	0	28		--	--	--	1	20	SPARE	
SPARE	--	20	1	--	--	--	29		0	0	30		--	--	--	1	20	SPARE
SPARE	--	20	1	--	--	--	31	0	0	32		--	--	--	1	20	SPARE	
SPARE	--	20	1	--	--	--	33		0	0	34		--	--	--	1	20	SPARE
SPARE	--	20	1	--	--	--	35			0	240	36	X #12	#12	1	20	EF-2-1 & 2-2	
PANEL 'PG' VIA 'ATS'	100	3	#1	#4	X	37	7022	2000		38		X #10	#10	3	40	ELEVATOR		
--	--	--	--	--	--	--	39			40	--	--	--	--	--	--		
--	--	--	--	--	--	--	41			42	--	--	--	--	--	--		
							20951	26439	27004									
							175 A	227 A	232 A									
LOAD CLASSIFICATION				CONNECTED LOAD		DEMAND FACTOR		ESTIMATED DEMAND		PANEL TOTALS								
EQUIPMENT				8500		100.00%		8500		TOTAL CONNECTED LOAD: 74394								
LIGHTING				797		100.00%		797		TOTAL CONNECTED AMPS: 206 A								
MOTORS				33707		100.00%		33707										
RECEPTACLES				31390		65.93%		20695		TOTAL ESTIMATED DEMAND: 63699								
										TOTAL EST DEMAND AMPS 177 A								

PANEL: PG																	
LOCATION:		ELEV. MACH. RM....		AMPS: 100 A		AIC RATING:		SEE ONE-LINE DIAGRAM		NOTES (NT):							
MANUFACTURER:		SEE...		VOLTS: 208Y/120		MOUNTING:		RECESSED									
MODEL TYPE:		PANELBOARD		PHASE: 3		ENCLOSURE:		Type 1									
TYPE OF MAIN:		MCB		WIRE: 4		FEATURES:											
LOAD NAME	NT	CB	P	WIRE SIZE H GND N	C SIZE (3/4" UON)	CKT NO	A	B	C	CKT NO	C SIZE (3/4" UON)	WIRE SIZE N GND H	P	CB	NT	LOAD NAME	
SERVER RM LIGHTING	20	1	#12	#12	X	1	62	2750		2		X #10 #10	1	30		SERVER RM 5-30R	
SERVER RM 5-30R	30	1	#10	#10	X	3		2750	2750	4		X #10 #10	1	30		SERVER RM 5-30R	
SERVER RM 5-30R	30	1	#10	#10	X	5			2750	1100	6	X #12 #12	2	20		SERVER RM 6-20R	
SERVER RM 5-30R	30	1	#10	#10	X	7	2750	1100		8	--	--	--	--	--		
SERVER RM 6-20R	20	2	#12	#12	X	9		1100	180	10		X #10 #12	1	30		SERVER RM 5-30R	
--	--	--	--	--	--	--	11			1100	180	12	X #10 #12	1	30	SERVER RM 5-30R	
SERVER RM 5-30R	30	1	#12	#10	X	13	180	180		14		X #10 #12	1	30		SERVER RM 5-30R	
SERVER RM 5-30R	30	1	#12	#10	X	15		180	0	16	--	--	--	1	20	SPARE	
SERVER RM QUAD	20	1	#12	#12	X	17			360	0	18	--	--	--	1	20	
SPARE	--	20	1	--	--	--	19	0	0		20	--	--	--	1	20	
SPARE	--	20	1	--	--	--	21		0	0	22	--	--	--	1	20	
SPARE	--	20	1	--	--	--	23			0	0	24	--	--	--	1	20
SPARE	--	20	1	--	--	--	25	0	0		26	--	--	--	1	20	
SPARE	--	20	1	--	--	--	27		0	0	28	--	--	--	1	20	
SPARE	--	20	1	--	--	--	29			0	0	30	--	--	--	1	20
SPARE	--	20	1	--	--	--	31	0	0		32	--	--	--	1	20	
SPARE	--	20	1	--	--	--	33		0	0	34	--	--	--	1	20	
SPARE	--	20	1	--	--	--	35			0	0	36	--	--	--	1	20
SPARE	--	20	1	--	--	--	37	0	0		38	--	--	--	1	20	
FCU & CU/IT-MAIN	50	2	#6	#10	X	39		3536		40		X #10 #6	2	50		FCU & CUT-IT-BACKUP	
--	--	--	--	--	--	--	41			42	--	--	--	--	--	--	
							7022	14032	12862								
							59 A	124 A	112 A								
LOAD CLASSIFICATION						CONNECTED LOAD		DEMAND FACTOR		ESTIMATED DEMAND		PANEL TOTALS					
LIGHTING						62		100.00%		62							
MOTORS						14144		100.00%		14144		TOTAL CONNECTED LOAD: 33616					
RECEPTACLES						19410		75.76%		14705		TOTAL CONNECTED AMPS: 93 A					
												TOTAL ESTIMATED DEMAND: 28911					
												TOTAL EST DEMAND AMPS 80 A					



## GENERAL NOTES



- A. REFER TO SPECIFICATIONS, SCHEDULES, DETAILS AND GENERAL NOTES SHEET FOR ADDITIONAL LIGHTING INSTALLATION REQUIREMENTS.
- B. CONTRACTOR SHALL COORDINATE LUMINAIRE LOCATIONS WITH THE ARCHITECTURAL ELEVATIONS AND RCP PRIOR TO INSTALLATION. VERIFY LOCATIONS AND MOUNTING METHODS AND MATERIALS THAT ARE UNCLEAR PRIOR TO ORDERING OR INSTALLING LUMINAIRES.
- C. CIRCUIT NUMBER AND FIXTURE TAG SHOWN ADJACENT TO EACH LUMINAIRE.
- D. CIRCUIT EXIT SIGNS (UNSWITCHED) WITH THE ADJACENT LIGHTING IN THE ROOM.

SHEET WORK NOTES

1. UON, CIRCUIT ALL LIGHTING IN THIS AREA TO PANEL 'P1'.
2. UON, CIRCUIT ALL LIGHTING IN THIS AREA TO PANEL 'P2'.
3. LUMINAIRES SHOWN HATCHED OR TAGGED 'X'E AND ALL EXIT SIGNS SHALL BE PROVIDED WITH INTEGRAL BATTERY PACKS FOR 90 MIN OF EMERGENCY OPERATION. PROVIDE WITH VISIBLE BATTERY STATUS INDICATOR, TYPICAL.
4. LOWER CASE LETTER ADJACENT TO LUMINAIRE INDICATES SWITCH-LEG TO SERVE LUMINAIRE.
5. LUMINAIRES SHALL BE SWITCHED BY A CONTACTOR CONTROLLED BY A 24 HOUR, 7 DAY ASTRONOMICAL TIME CLOCK WITH HOLIDAY SCHEDULING. CONTACTOR AND TIME CLOCK TO BE MOUNTED ADJACENT TO PANEL.
6. PROVIDE SWITCH MOUNTED DUAL TECHNOLOGY OCCUPANCY SENSOR WITH INTEGRAL ON/OFF CONTROL SWITCH AND DUAL DELAYS FOR LIGHTING AND EXHAUST FAN, TYPICAL.


## LIGHTING CONTROLS SYMBOLS LEGEND

\$os	WALL MOUNTED OCCUPANCY SENSOR (DUAL TECH)
\$vs	WALL MOUNTED VACANCY SENSOR WITH DIMMING
OS	CEILING MOUNTED OCCUPANCY SENSOR (DUAL TECH)
VS	CEILING MOUNTED VACANCY SENSOR WITH DIMMING
OS	CORNER MOUNTED OCCUPANCY SENSOR (DUAL TECH)
VS	CORNER MOUNTED VACANCY SENSOR WITH DIMMING

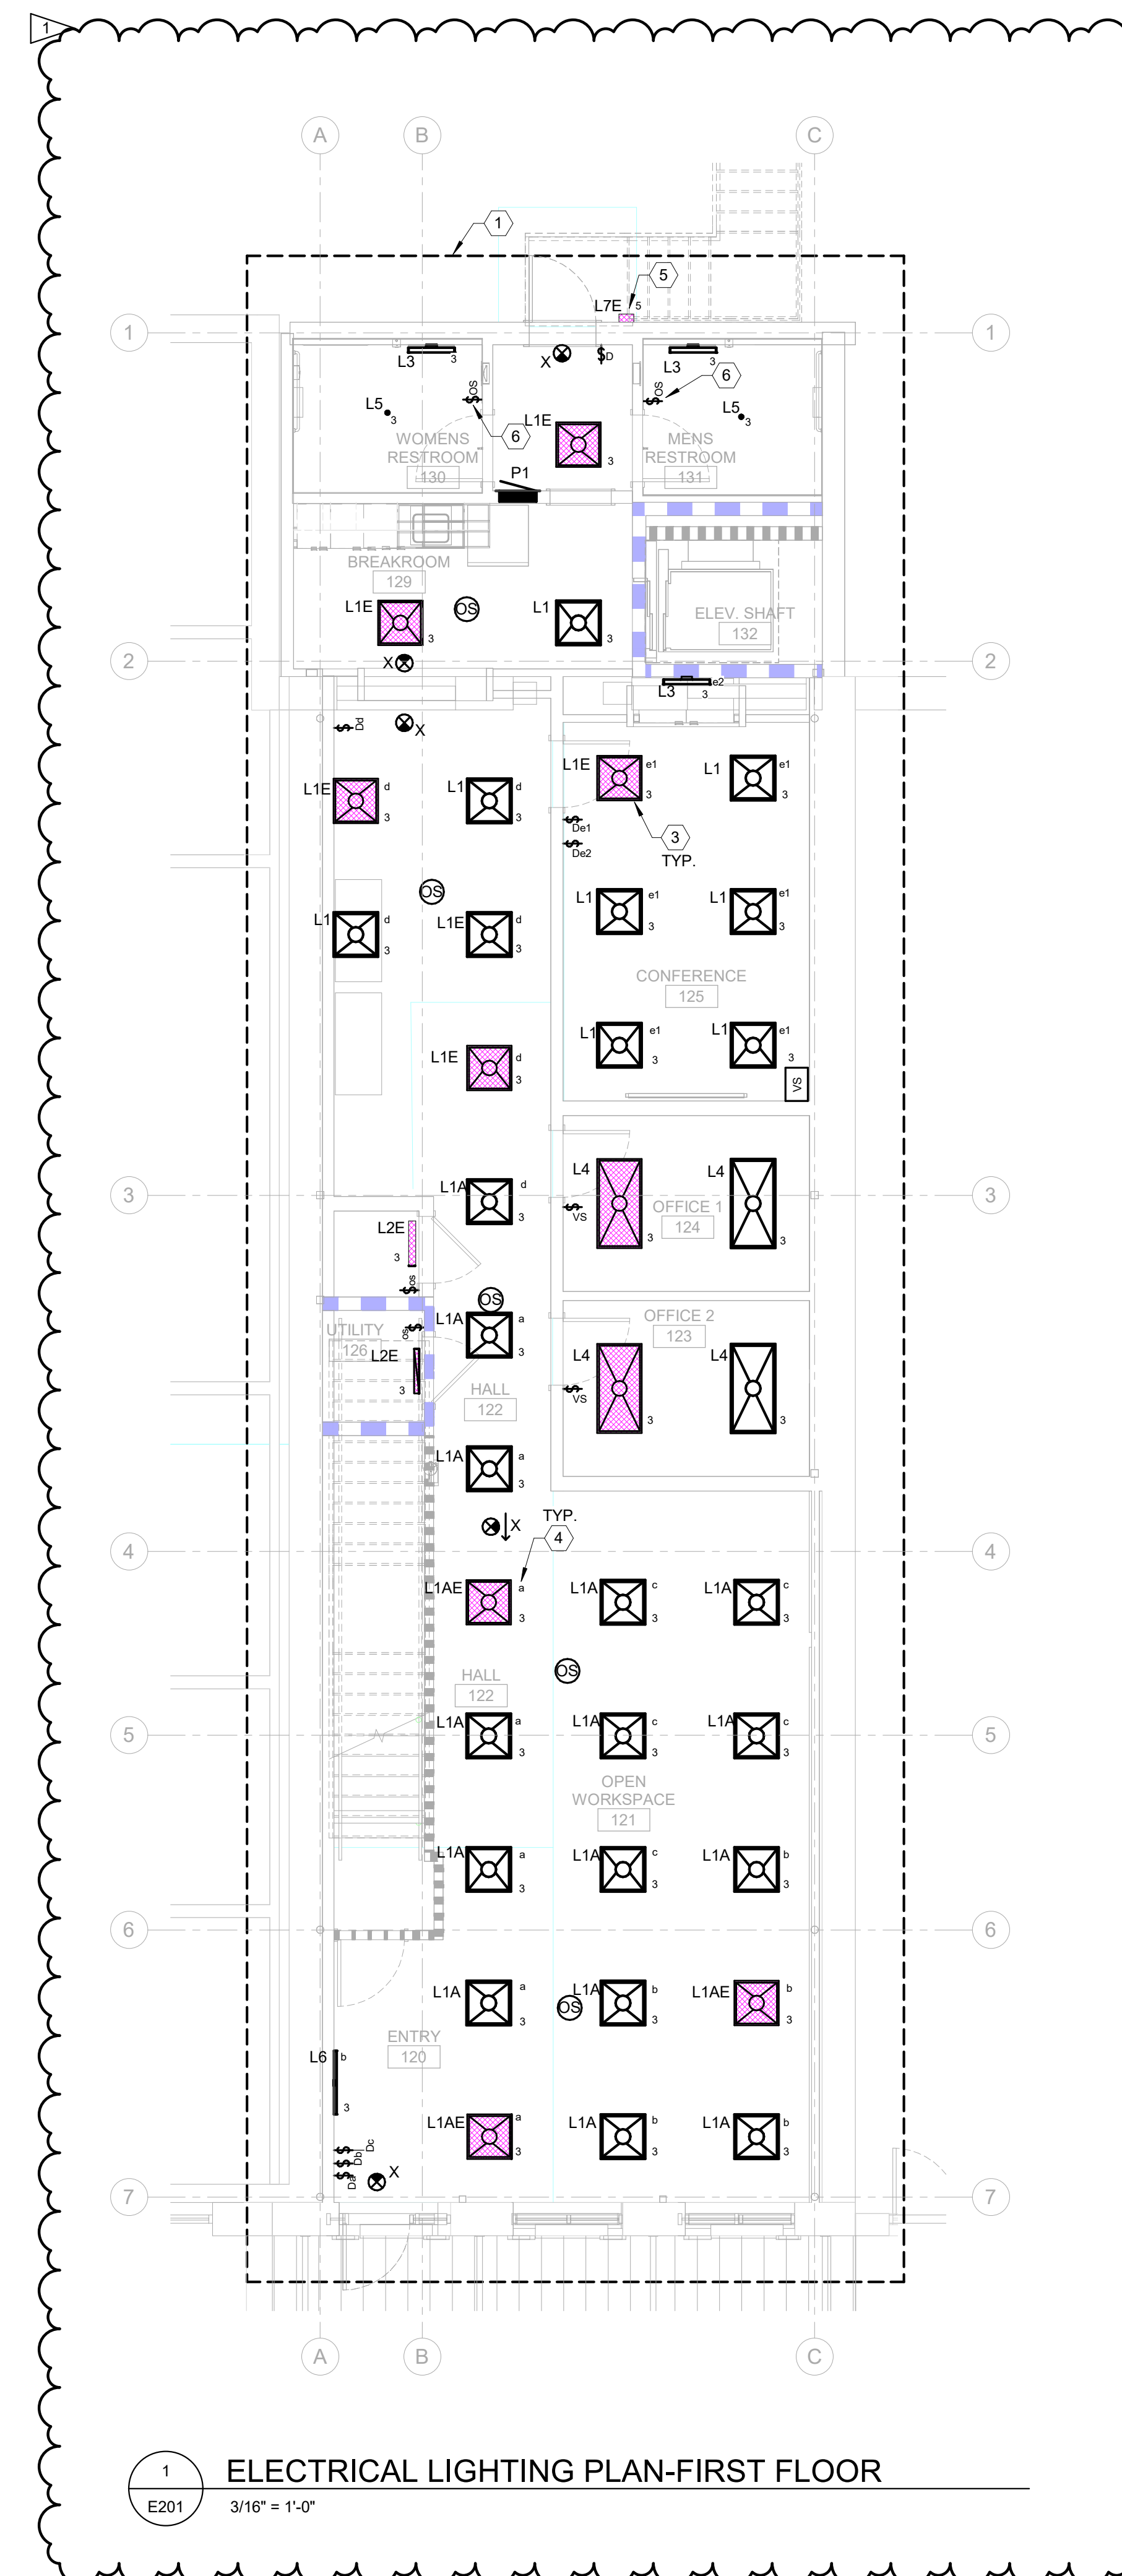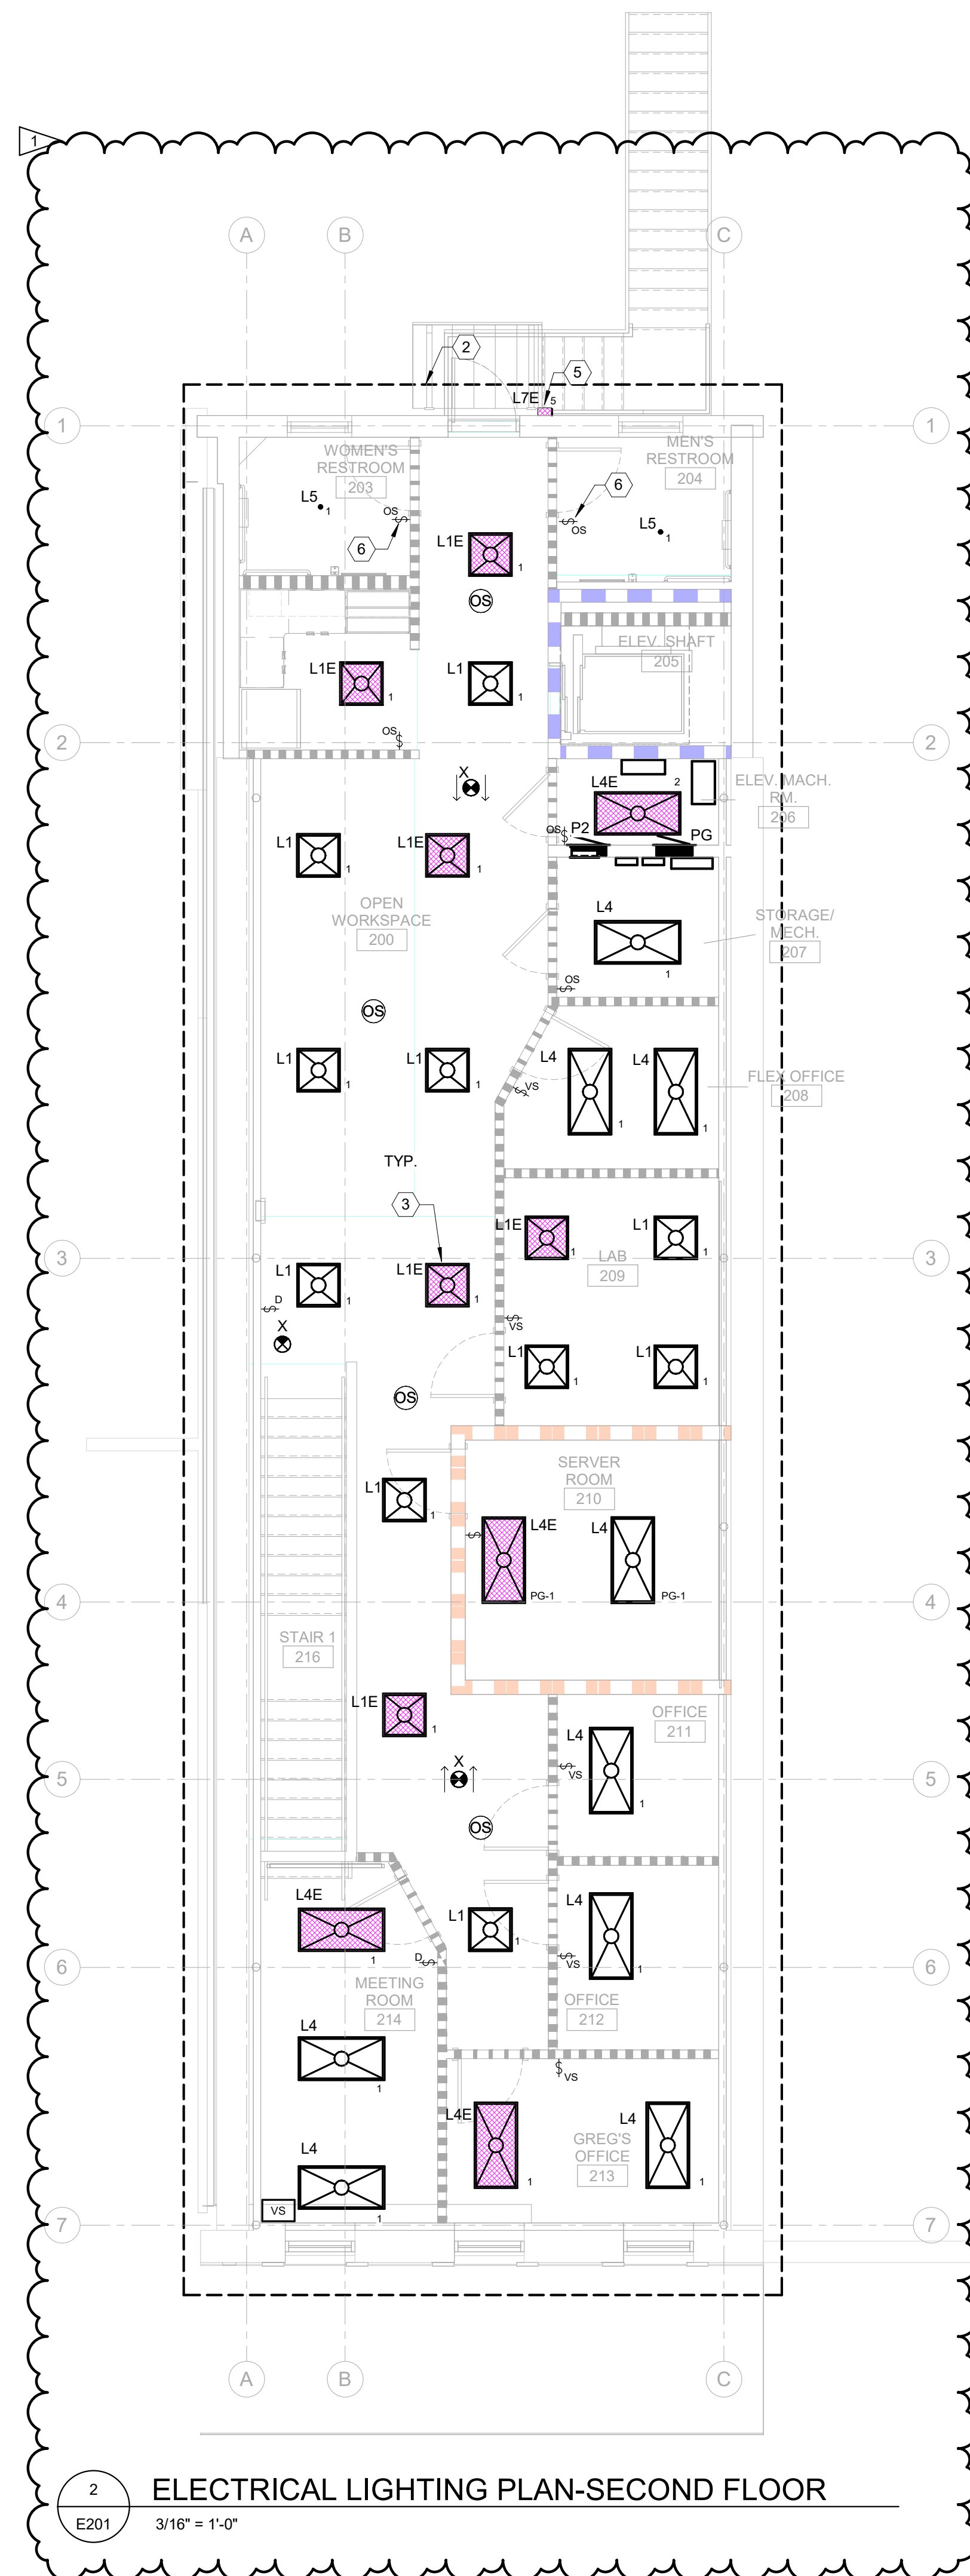




Autodesk Docs/733-1408 Burnet County Annex/Burnet County\_ELEC\_IV22.rvt

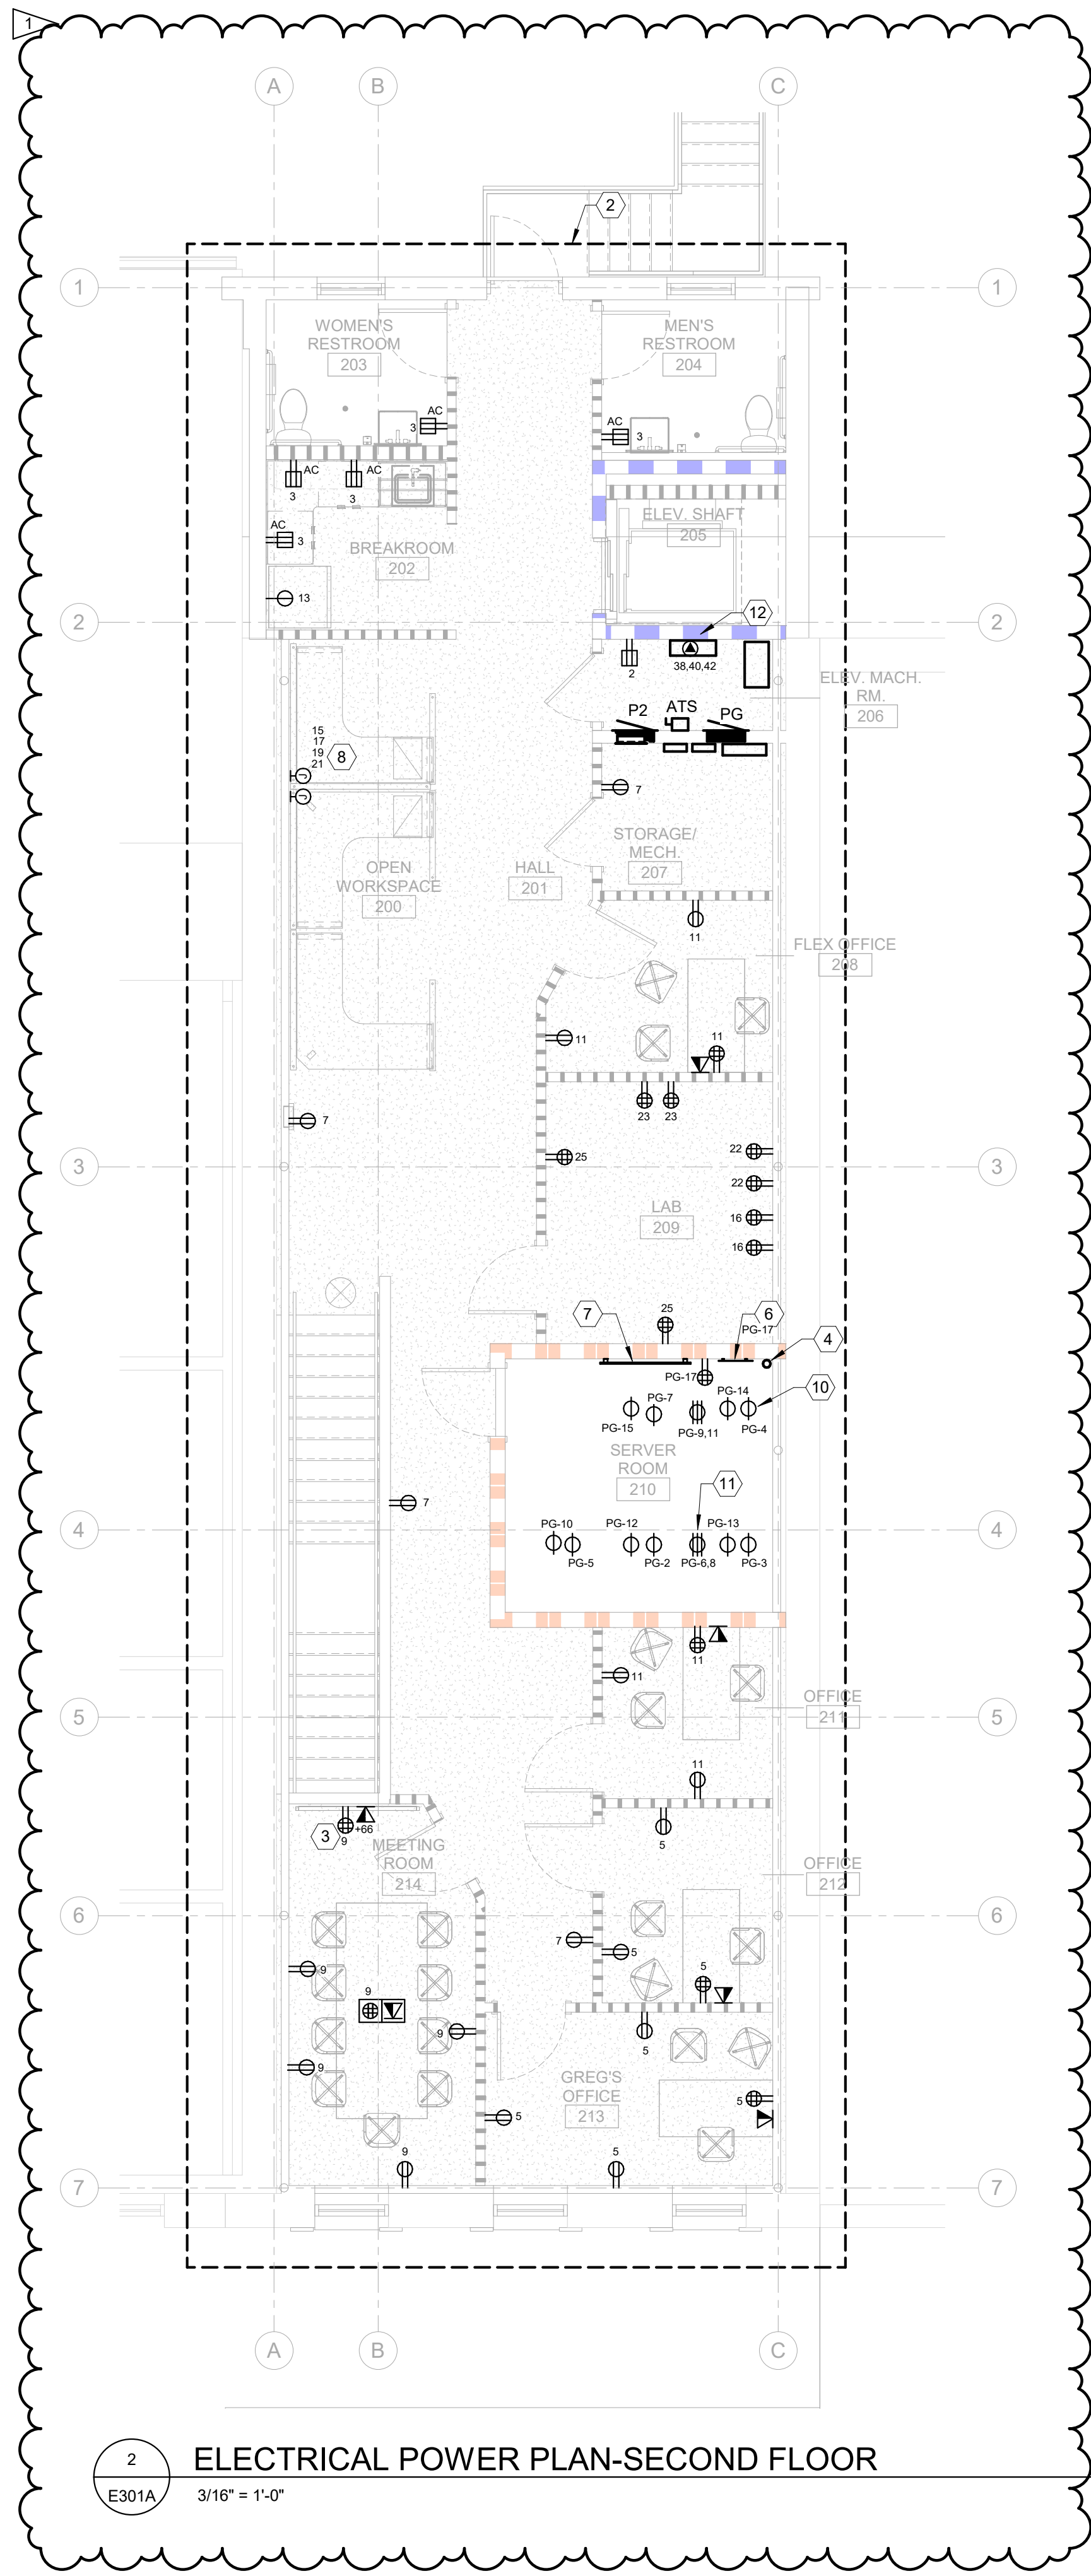

2 ELECTRICAL POWER PLAN-SECOND FLOOR  
E301A 3/16" = 1'-0"

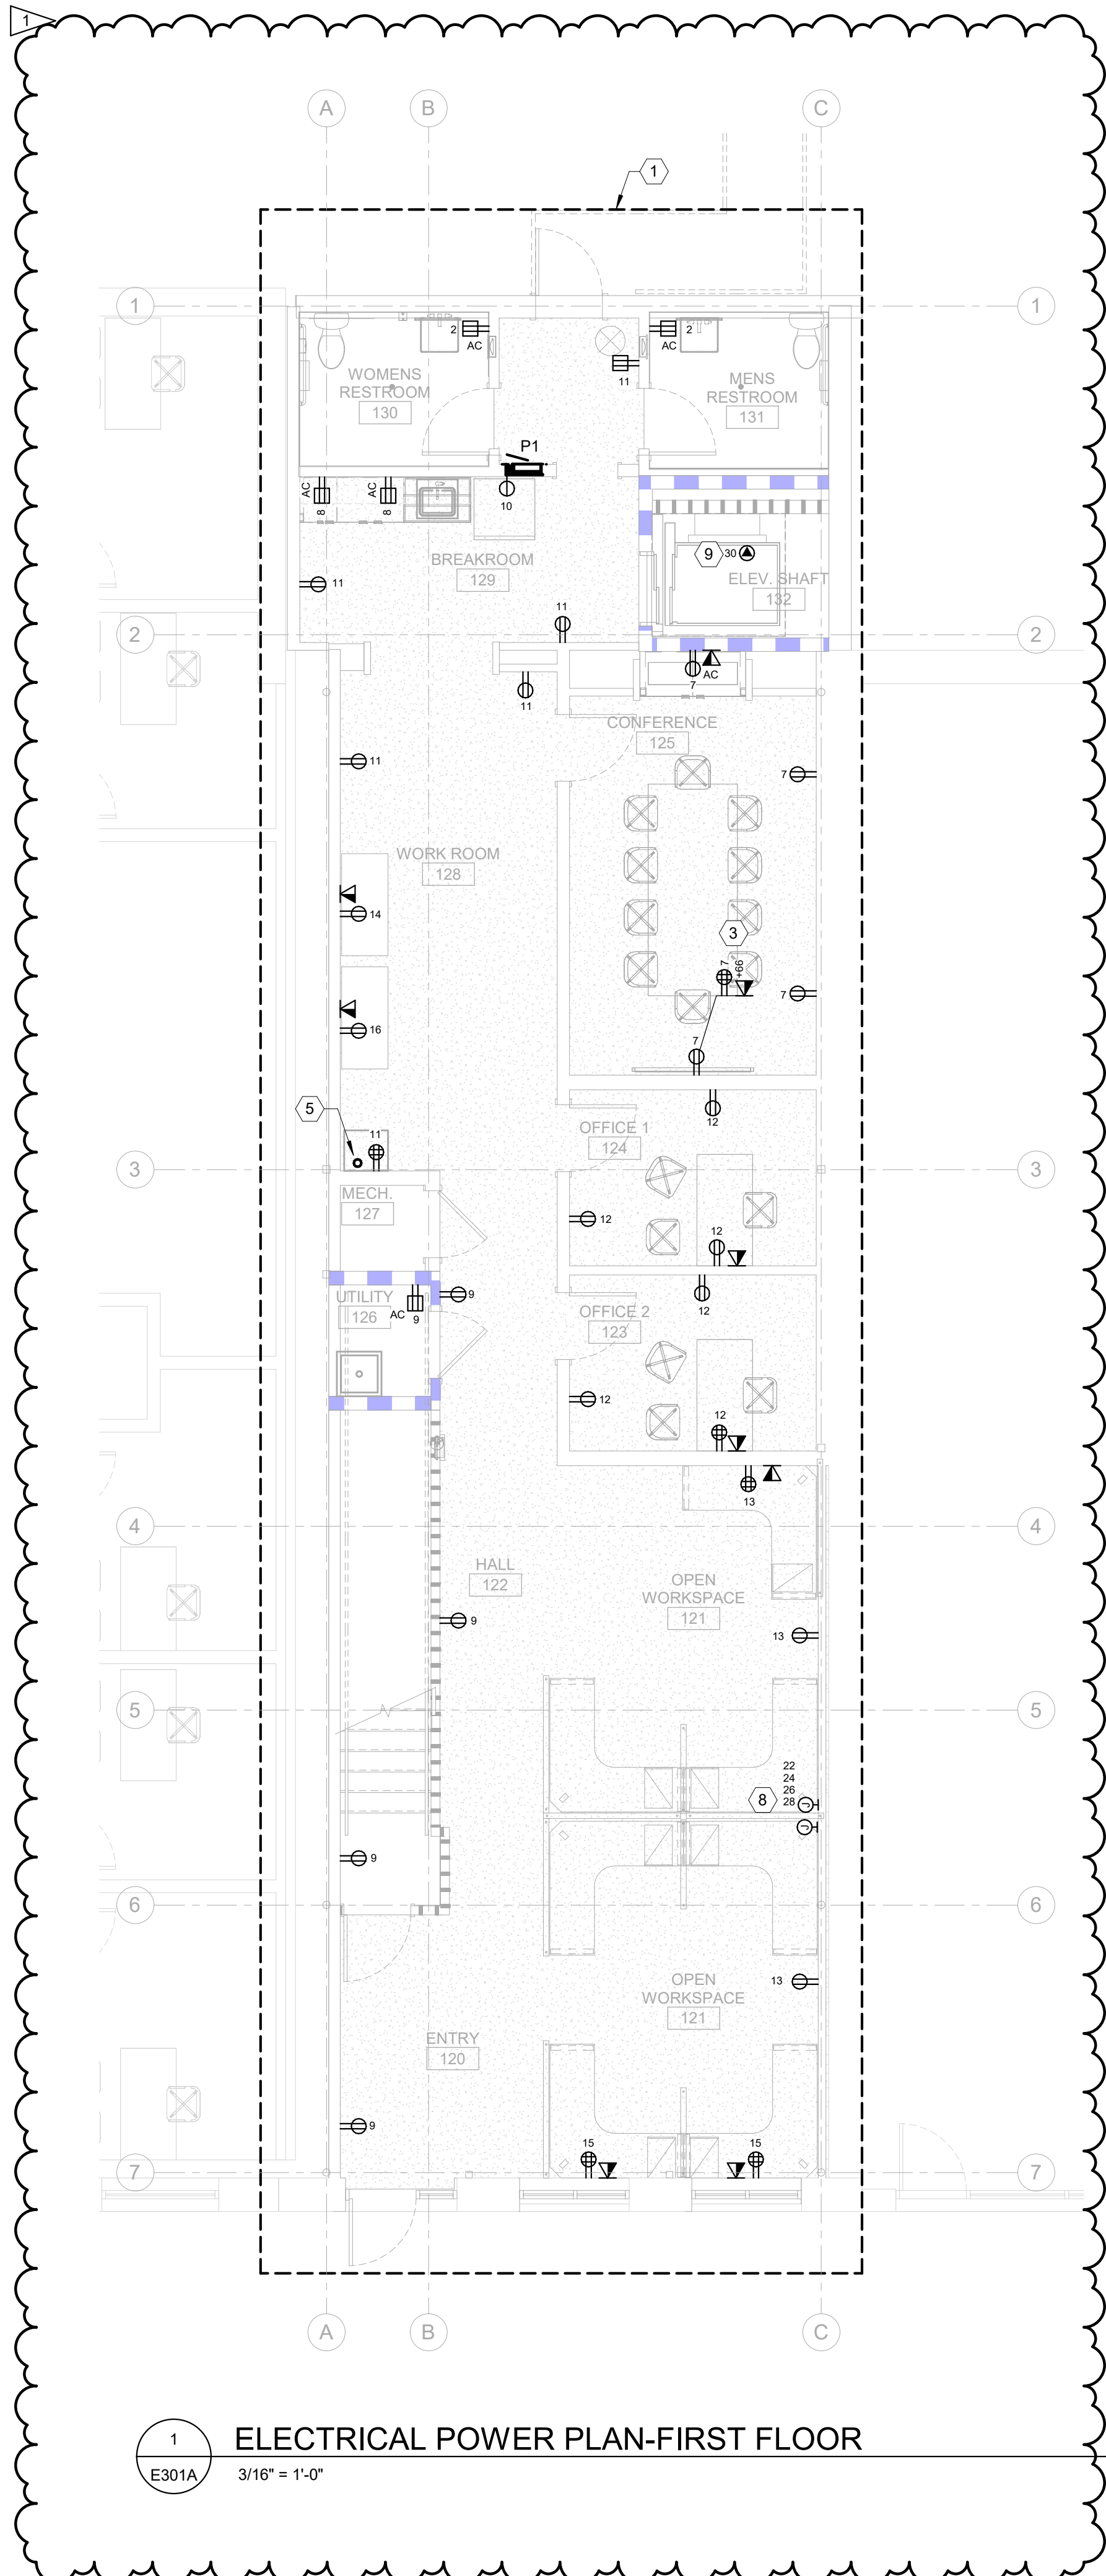

1 ELECTRICAL POWER PLAN-FIRST FLOOR  
E301A 3/16" = 1'-0"

## GENERAL NOTES

- REFER TO SPECIFICATIONS, SCHEDULES, DETAILS AND GENERAL NOTES SHEET FOR ADDITIONAL ELECTRICAL EQUIPMENT AND SYSTEM INSTALLATION REQUIREMENTS.
- CONTRACTOR SHALL PROVIDE POWER TO ALL ITEMS SHOWN FROM THE PANEL AND CIRCUIT NUMBERS THAT ARE SHOWN ADJACENT TO THE LOAD (RECEPTACLE, DISCONNECT, JBOX, EQUIPMENT CONNECTION POINT, ETC). SIZE CIRCUIT PER PANEL SCHEDULE. PROVIDE NEUTRAL AND GROUND, U.N.O.
- EC'S SCOPE INCLUDES RACEWAY INFRASTRUCTURE FOR ALL ITEMS SHOWN ON THE SPECIAL SYSTEMS PLANS. RACEWAY REQUIREMENTS ARE DEFINED IN SPECIFICATION NOTES AND DETAILS, BUT SHALL BE FIELD VERIFIED BEFORE WORK.
- ALL IT CABLING, JACKS, EQUIPMENT RACKS, A/V AND NETWORKING EQUIPMENT WILL BE PROVIDED AND INSTALLED BY OTHERS. EC RESPONSIBLE FOR ALL ROUGH IN WORK AND POWER CONNECTIONS.
- COORDINATE TELECOMMUNICATIONS INFRASTRUCTURE REQUIREMENTS WITH OWNER'S IT REPRESENTATIVE PRIOR TO STARTING WORK.

## # SHEET WORK NOTES

- UON, ALL CIRCUITS SHOWN IN THIS AREA WILL BE FED FROM PANEL 'P1'.
- UON, ALL CIRCUITS SHOWN IN THIS AREA WILL BE FED FROM PANEL 'P2'.
- TV MOUNTED ON WALL AT THIS LOCATION. PROVIDE (1) CHIEF PAC525 BOX BEHIND TELEVISION. (1) CHIEF BOX SHALL HAVE (1) QUAD AND (2) DATA DROPS WITH (2) 1-1/2" CONDUITS TO ABOVE ACCESSIBLE CEILING. COORDINATE ELEVATION WITH ARCHITECT AND INSTALLATION WITH TELEVISION BLOCKING AND MOUNTING EQUIPMENT. COORDINATE DETAILS WITH A/V CONTRACTORS DRAWINGS PRIOR TO ROUGH-IN.
- PROVIDE ONE 2" CONDUIT (WITH PULL STRING) FROM THIS LOCATION TO EXTERIOR COMMUNICATION JUNCTION BOX. REFER TO ARCHITECTURAL PLANS TO DETERMINE CONDUIT RUN LENGTHS AND ROUTING. COORDINATE EXACT TERMINATION POINT WITH COMMUNICATIONS CONTRACTORS.
- PROVIDE ONE 1" CONDUIT (WITH PULL STRING) FROM THIS LOCATION TO SECOND FLOOR DATA CLOSET. REFER TO ARCHITECTURAL PLANS TO DETERMINE CONDUIT RUN LENGTHS AND ROUTING. COORDINATE EXACT TERMINATION POINT WITH COMMUNICATIONS CONTRACTORS.
- PROVIDE A GROUND LUG AND TERMINAL STRIP WITH A #4 ISOLATED GROUND CONDUCTOR BONDED TO THE BUILDING GROUNDING ELECTRODE.
- PROVIDE 3/4" FIRE RATED PLYWOOD BACKBOARD FOR MOUNTING COMMUNICATIONS EQUIPMENT ON ALL SERVER RM WALLS. WIDTH OF PANEL SHALL BE COORDINATED WITH INFORMATION TECHNOLOGIES CONTRACTOR. PAINT TO MATCH WALL TO WHICH BOARD IS ATTACHED.
- PROVIDE ONE POWER AND ONE DATA JUNCTION BOX IN WALL AT THIS LOCATION FOR BRANCH CIRCUIT AND DATA/VOICE TO SERVE SYSTEM FURNITURE THAT IS PROVIDED WITH INTEGRAL RECEPTACLES. PROVIDE COVER PLATE WITH ANGLE CONNECTOR AND FLEXIBLE METAL CONDUIT (FMC) FROM EACH JUNCTION BOX IN WALL TO CONNECTION POINT ON FURNITURE. PROVIDE POWER CONDUCTORS, AND MAKE ALL ELECTRICAL TERMINATIONS. COORDINATE JUNCTION BOX LOCATION AND INSTALLATION OF CONDUCTORS WITH FURNITURE PROVIDER. COORDINATE CIRCUIT COUNT WITH FURNITURE PRIOR TO ROUGH-IN. PROVIDE (4) DEDICATED CIRCUITS ACROSS A MAXIMUM OF (8) WORKSTATIONS. PROVIDE DEDICATED NEUTRAL AND GROUND WITH EACH CIRCUIT. PROVIDE CREDIT TO TENANT IF CIRCUIT COUNT IS LESS THAN 4. PROVIDE 1-1/2" CONDUIT FOR DATA JUNCTION BOX.
- PROVIDE DEDICATED GFI RECEPTACLE MOUNTED IN PIT ADJACENT TO SUMP PUMP FOR CONNECTION TO SUMP PUMP.
- PROVIDE NEMA 5-30R. COORDINATE INSTALLATION WITH COMMUNICATIONS CONTRACTOR. RECEPTACLE SHALL BE MOUNTED TO OWNER FURNISHED, OWNER INSTALLED LADDER RACK ABOVE TELECOM RACK. TYPICAL OF 10.
- PROVIDE NEMA 6-20R. COORDINATE INSTALLATION WITH COMMUNICATIONS CONTRACTOR. RECEPTACLE SHALL BE MOUNTED TO OWNER FURNISHED, OWNER INSTALLED LADDER RACK ABOVE TELECOM RACK. COORDINATE FINAL LOCATIONS WITH OWNER PRIOR TO ROUGH-IN. TYPICAL OF 2.
- ENCLOSED CIRCUIT BREAKER WITH LOTO PROVISIONS, SERVING ELEVATOR POWER UNIT. CIRCUIT BREAKER WITH SHUNT TRIP MODULE WIRED TO OPERATE ON COMMAND FROM SPRINKLER WATER FLOW SWITCH IN HOISTWAY OR ELEVATOR MACHINERY ROOM.




#	DATE	ISSUE
1	08/21/2025	ADDENDUM 1


Project Number: 33-1408  
© 2024 LEVY DYKEMA  
ELECTRICAL POWER PLANS



Autodesk Docs/233-1408 Burnet County Annex/Burnet County\_ELEC\_IV22.rvt

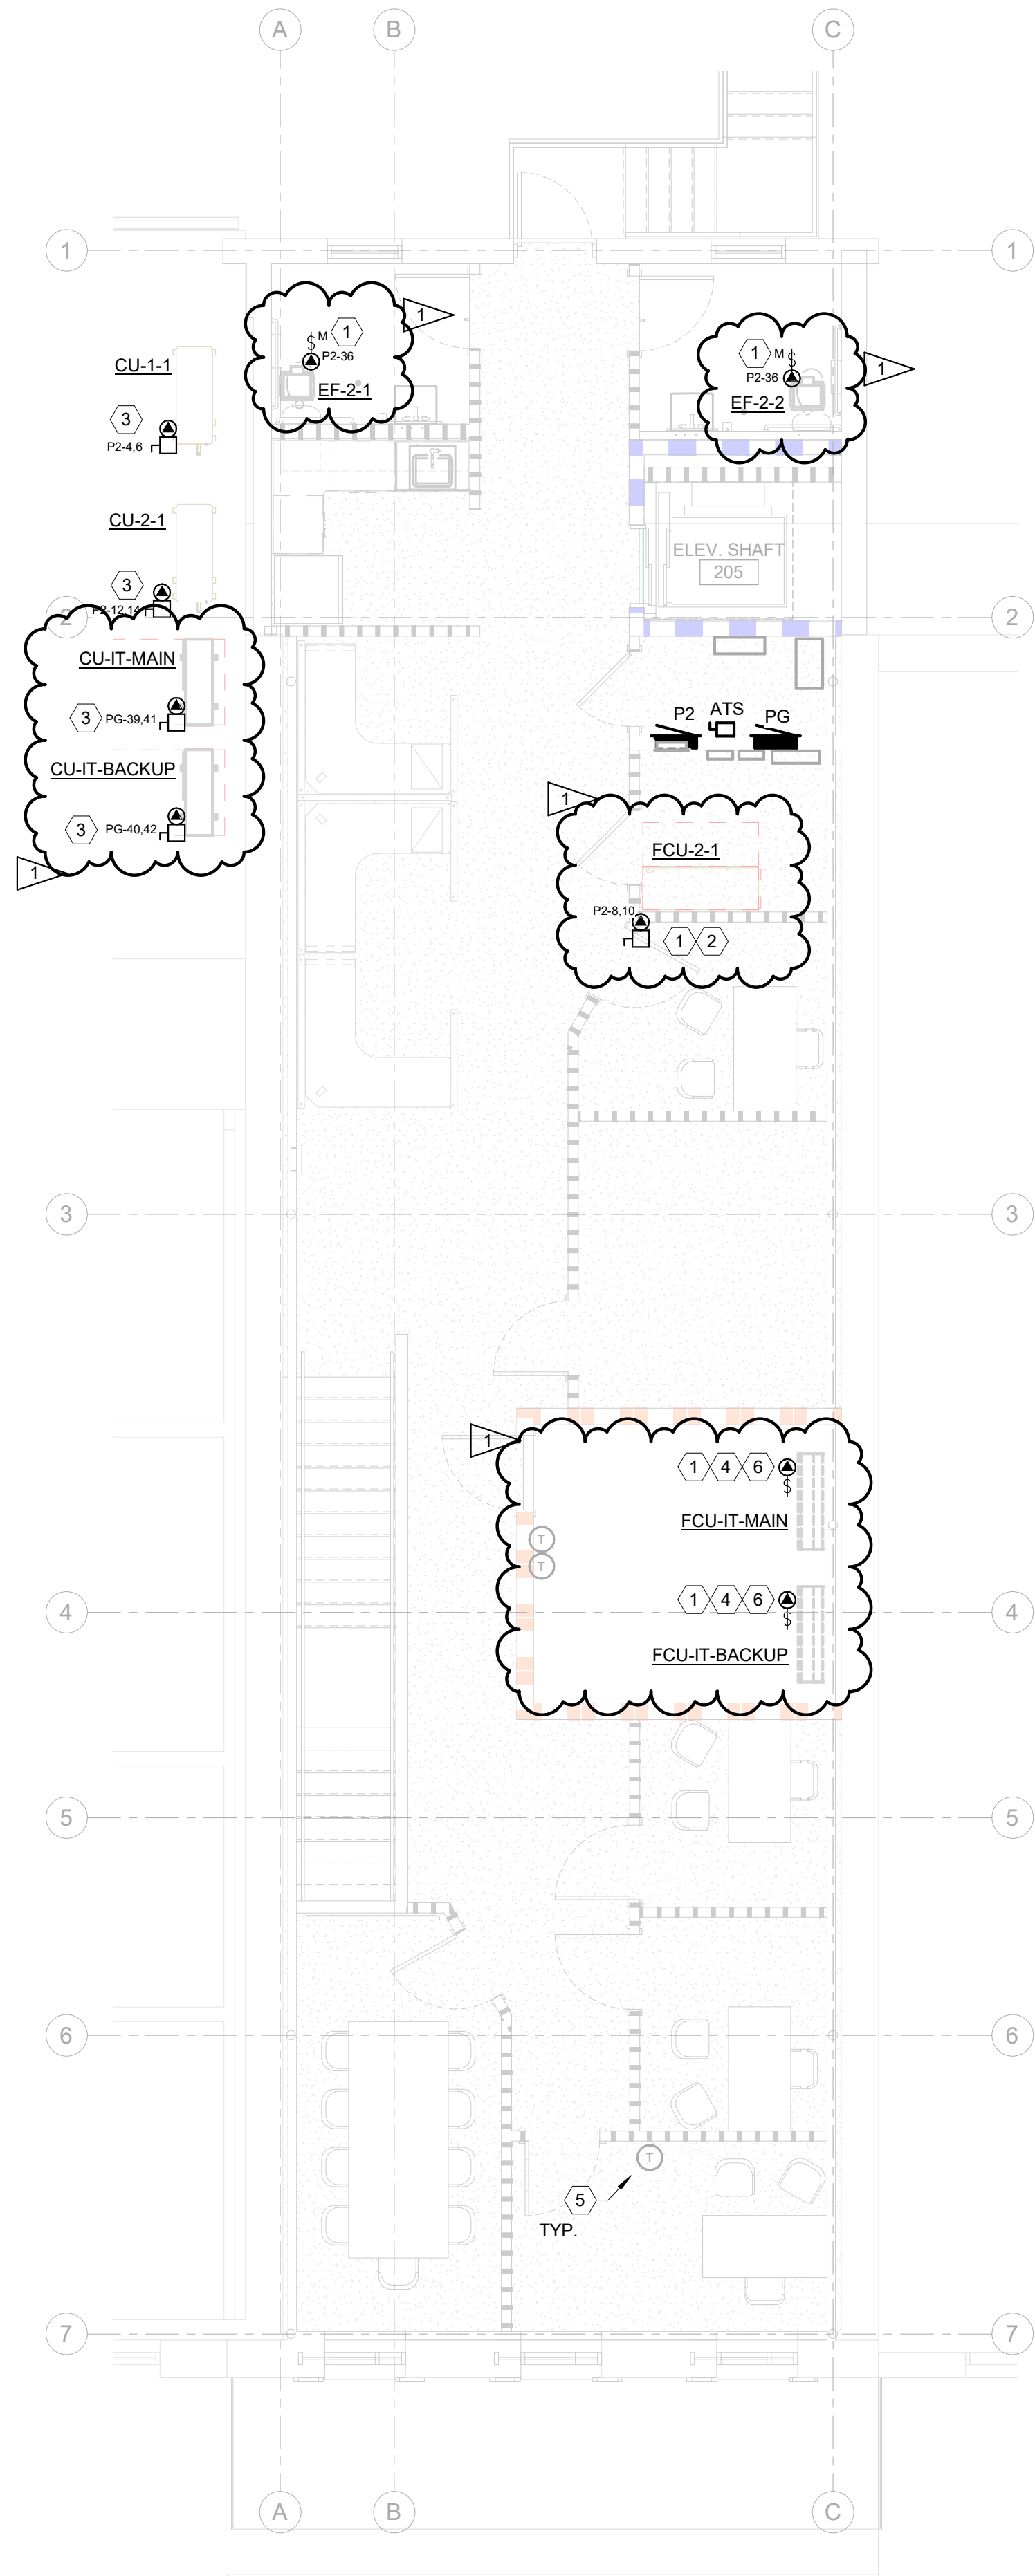

2 ELECTRICAL HVAC POWER PLAN-SECOND FLOOR  
E301B 3/16" = 1'-0"

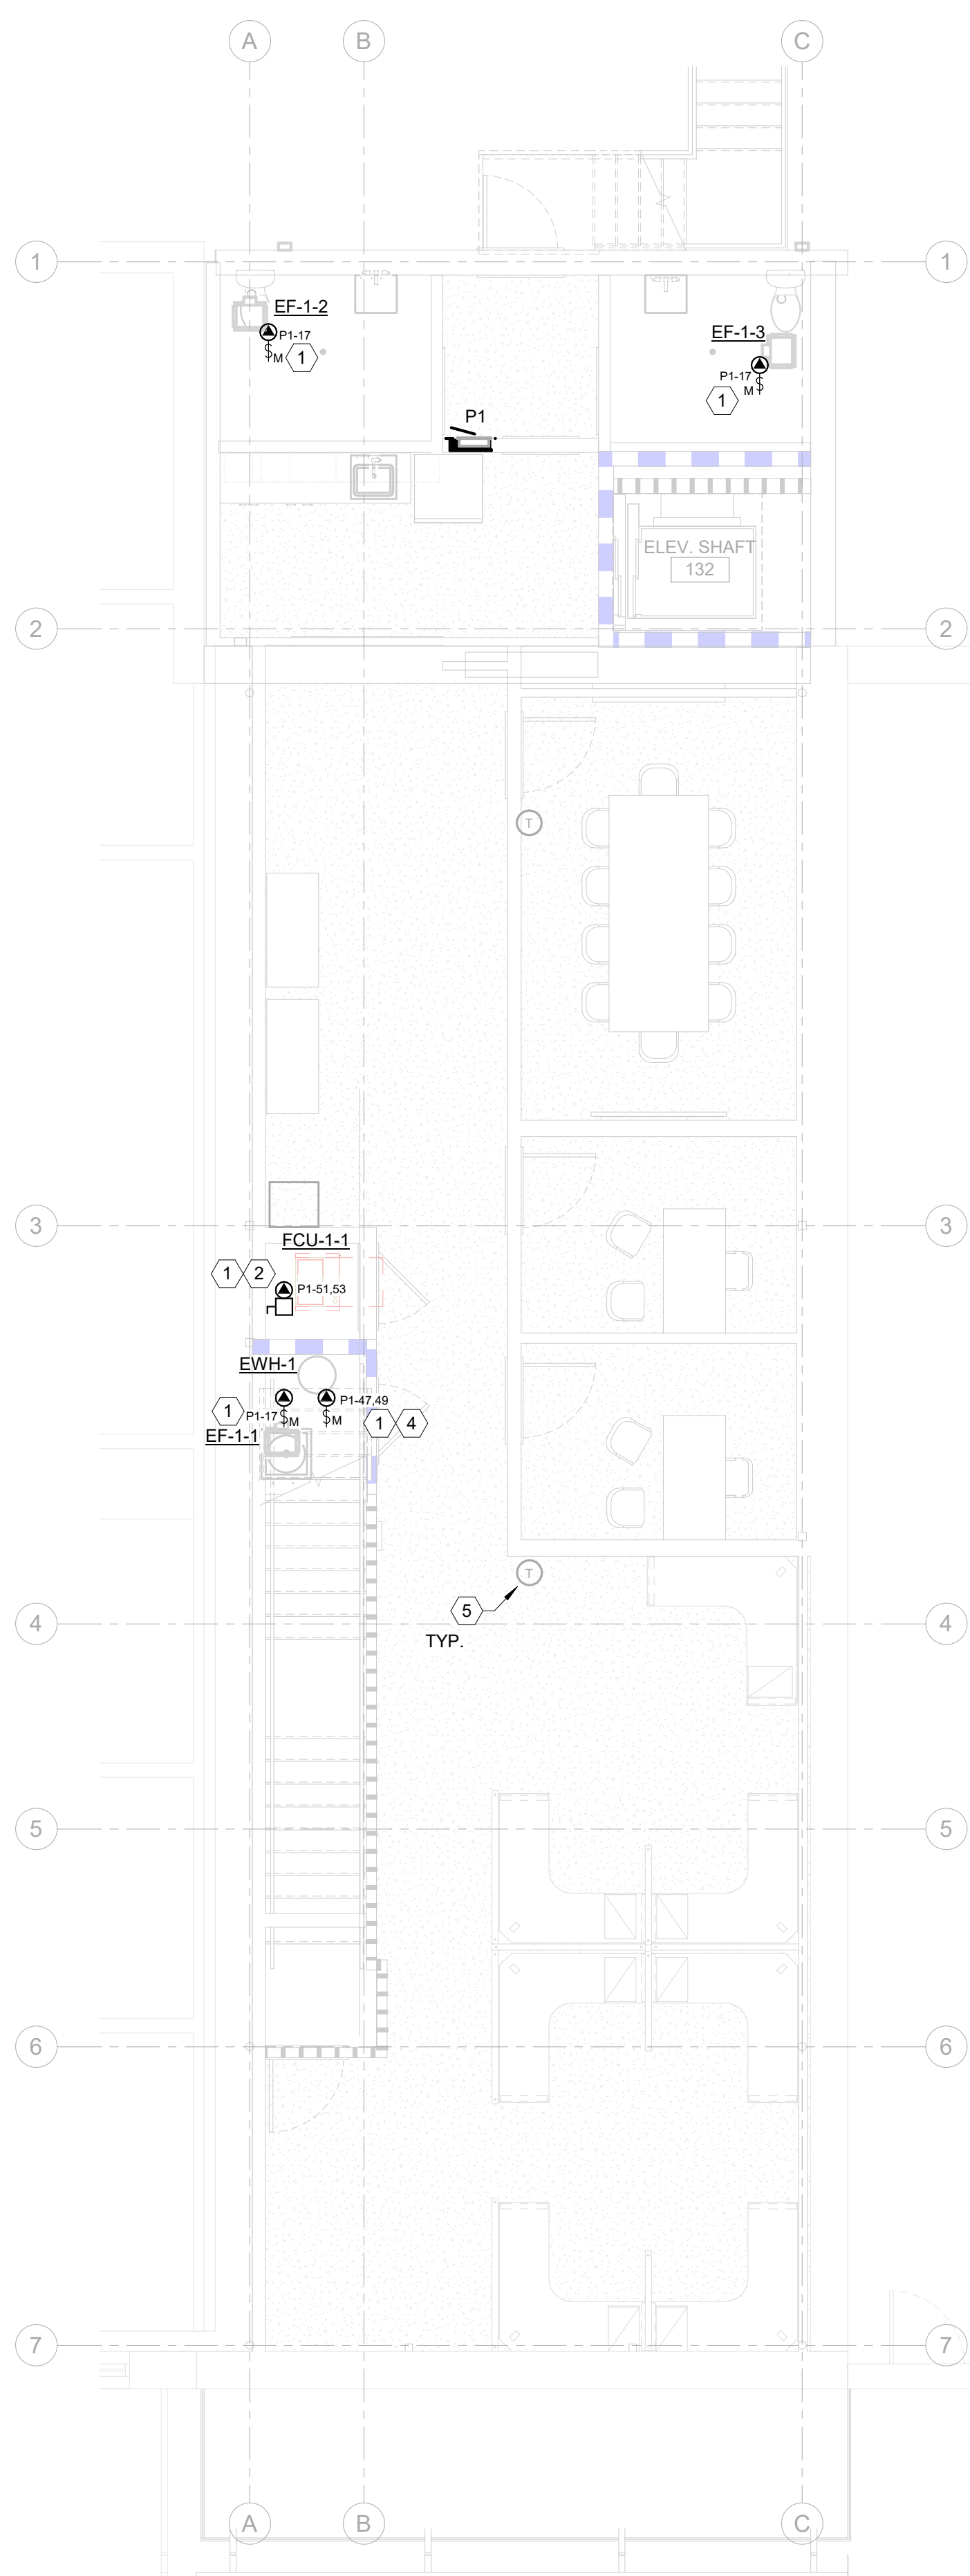

1 ELECTRICAL HVAC POWER PLAN-FIRST FLOOR  
E301B 3/16" = 1'-0"

## GENERAL NOTES

- REFER TO SPECIFICATIONS, SCHEDULES, DETAILS AND GENERAL NOTES SHEET FOR ADDITIONAL ELECTRICAL EQUIPMENT AND SYSTEM INSTALLATION REQUIREMENTS.
- REFER TO ELECTRICAL EQUIPMENT SCHEDULE FOR DISCONNECT AND CONTROLS REQUIREMENTS.
- CONTRACTOR SHALL PROVIDE POWER TO ALL ITEMS SHOWN FROM THE PANEL AND CIRCUIT NUMBERS THAT ARE SHOWN ADJACENT TO THE LOAD. SIZE CIRCUIT PER PANEL SCHEDULE. PROVIDE NEUTRAL AND GROUND, U.N.O.

## # SHEET WORK NOTES

- MOUNT EQUIPMENT TO STRUCTURE ABOVE CEILING ADJACENT TO LOAD TO BE SERVED, IN A VISIBLE AND ACCESSIBLE LOCATION, AND PROVIDED WITH WORKING SPACE. COORDINATE LOCATION WITH OTHER TRADES PRIOR TO ROUGH-IN. PROVIDE GFCI RECEPTACLE MOUNTED BELOW DISCONNECT. RECEPTACLE SHALL BE CIRCUITED TO NEAREST GENERAL PURPOSE CIRCUIT.
- PROVIDE DUCT MOUNTED SMOKE DETECTOR IN AIR DUCT OF HVAC UNIT. DUCT DETECTOR TO BE WIRED TO SHUT DOWN UNIT UPON DETECTION OF SMOKE. PROVIDE DUCT DETECTOR WITH LED ALARM INDICATOR REMOTE MOUNTED TO BOTTOM OF CEILING BELOW UNIT SERVED. PROVIDE CONTROL POWER FOR DUCT DETECTOR FROM UNIT SERVED. COORDINATE REQUIREMENTS AND INSTALLATION WITH MECHANICAL CONTRACTOR AND INTERFACE WITH FIRE ALARM SYSTEM WITH FIRE ALARM CONTRACTOR.
- MOUNT EQUIPMENT ON WALL ADJACENT TO LOAD TO BE SERVED, IN A VISIBLE AND ACCESSIBLE SPACE, AND PROVIDED WITH NEC REQUIRED CLEARANCES. COORDINATE LOCATION WITH OTHER TRADES PRIOR TO ROUGH-IN. PROVIDE GFCI RECEPTACLE MOUNTED BELOW DISCONNECT. RECEPTACLE SHALL BE CIRCUITED TO NEAREST GENERAL PURPOSE CIRCUIT.
- PROVIDE 120V CONNECTION AND MOTOR RATED SWITCH FOR IT CIRCULATION PUMP. CIRCUIT TO NEAREST GENERAL PURPOSE CIRCUIT.
- COORDINATE WITH MECHANICAL DRAWINGS FOR NEW THERMOSTAT LOCATIONS.
- INDOOR UNIT IS POWERED BY OUTDOOR UNIT. PROVIDE 3#12'S IN 3/4" C. FROM INDOOR UNIT TO OUTDOOR UNIT. COORDINATE CONDUIT ROUTING WITH REFRIGERANT PIPING.





Autodesk Docs/233-1408 Burnet County Annex/Burnet County\_M00p 3/02/24.rvt

MECHANICAL LEGEND AND SYMBOLS		MECHANICAL DESIGN CRITERIA		GENERAL NOTES	MECHANICAL GENERAL NOTES	
<div><div>SYMBOL</div><div>DRAIN</div><div>HEATING WATER SUPPLY</div><div>HEATING WATER RETURN</div><div>CHILLED WATER SUPPLY</div><div>CHILLED WATER RETURN</div><div>REFRIGERANT SUCTION LINE</div><div>REFRIGERANT LIQUID LINE</div><div>REFRIGERANT HOT GAS LINE</div><div>FUEL OIL SUPPLY</div><div>FUEL OIL RETURN</div><div>FUEL OIL VENT</div><div>DRY FLUID SUPPLY</div><div>DRY FLUID RETURN</div><div>LOW PRESSURE STEAM SUPPLY</div><div>STEAM CONDENSATE RETURN</div><div>GATE VALVE</div><div>BALL VALVE</div><div>BUTTERFLY VALVE</div><div>GLOBE VALVE</div><div>TRIPLE DUTY VALVE</div><div>SWING CHECK VALVE</div><div>STRAINER</div><div>FLEX CONNECTOR</div><div>HOSE END DRAIN VALVE</div><div>PRESSURE REDUCING VALVE</div><div>SAFETY RELIEF VALVE</div><div>UNION</div><div>MOTORIZED T.C. VALVE / 2-WAY</div><div>MOTORIZED T.C. VALVE / 3-WAY</div><div>ECCENTRIC PLUG BALANCING VALVE</div><div>VALVE IN RISER</div><div>TEE UP</div><div>TEE DOWN</div><div>ELBOW UP</div><div>ELBOW DOWN</div><div>PIPE SIZE CHANGE</div><div>MANUAL FLOW BALANCING VALVE (CIRCUIT SETTER)</div><div>AUTOMATIC FLOW BALANCING VALVE</div><div>PIPE GUIDE</div><div>PIPE ANCHOR</div><div>PRESSURE / TEMP. TEST PLUG</div><div>DIAL THERMOMETER</div></div>	<div><div>SYMBOL</div><div>THERMOSTAT/TEMPERATURE SENSOR</div><div>REVERSE ACTING THERMOSTAT</div><div>THERMOSTAT/TEMPERATURE SENSOR W/ GUARD</div><div>HUMIDISTAT</div><div>CARBON MONOXIDE SENSOR</div><div>CARBON DIOXIDE SENSOR</div><div>NITROGEN DIOXIDE SENSOR</div><div>ACOUSTICALLY LINED SHEET METAL DUCT</div><div>MANUAL BALANCING DAMPER</div><div>FLEX CONNECTOR</div><div>ACCESS DOORS</div><div>FIRE DAMPER</div><div>FIRE/SMOKE DAMPER</div><div>MOTORIZED DAMPER</div><div>TURNING VANE ELBOW</div><div>45° LOW-LOSS TAKE-OFF FITTING W/ DAMPER &amp; FLEX DUCT</div><div>45° LOW-LOSS TAKE-OFF FITTING W/ DAMPER &amp; RIGID ROUND DUCT</div><div>RECTANGULAR/ROUND DUCT WITH 45° HIGH EFFICIENCY TAKE-OFF</div><div>SUPPLY DIFFUSER W/ FLEX DUCT, THROW PATTERN SHOWN ON PLANS</div><div>LAY-IN SUPPLY DIFFUSER W/ FLEX DUCT, THROW PATTERN SHOWN ON PLANS</div><div>RETURN GRILLE</div><div>EXHAUST GRILLE</div><div>CONNECT NEW WORK TO EXISTING</div><div>PRESSURE GAUGE W/ SNUBBER</div><div>COMMON</div><div>EXISTING</div></div>	<p>MECHANICAL DESIGN CONDITIONS:</p> <p>PROJECT LOCATION: BURNET, TEXAS CLIMATE ZONE: 2A</p> <p>SUMMER: OUTDOOR DESIGN: 98°F DB / 74°F WB INDOOR DESIGN: 75°F DB / 50% RH</p> <p>WINTER: OUTDOOR DESIGN: 25°F DB INDOOR DESIGN: 72°F DB</p> <p>BUILDING WALL &amp; ROOF CONSTRUCTION INFORMATION:</p> <p>ROOF: U-VALUE = 0.047 WALLS: U - VALUE = 0.064 FRONT GLASS: U - VALUE: 0.75 SHADE COEFF: 0.29</p> <p>INTERIOR LOADS BASED ON ACTUAL LIGHTING, OCCUPANT AND EQUIPMENT LOADS.</p>	<p>1. FURNISH AND INSTALL ALL ITEMS NECESSARY TO PROVIDE FULLY FUNCTIONING SYSTEMS AS INDICATED BY THE DESIGN AND THE EQUIPMENT SPECIFIED. ELEMENTS OF THE WORK SHALL INCLUDE, BUT ARE NOT LIMITED TO, MATERIALS, LABOR, SUPERVISION, SUPPLIES, EQUIPMENT, TRANSPORTATION, HOISTING/RIGGING, STORAGE, UTILITIES, AND ALL REQUIRED PERMITS AND LICENSES.</p> <p>2. DRAWINGS ARE SCHEMATIC IN NATURE AND DO NOT REFLECT ALL WORK AND MATERIALS REQUIRED TO COMPLETE PROJECT. CONTRACTOR SHALL PROVIDE ALL MATERIALS, LABOR AND EQUIPMENT AS REQUIRED TO COMPLETE PROJECT WITHIN DESIGN. CONTRACTOR SHALL REQUEST ADDITIONAL INFORMATION AND DETAILS WHERE SCOPE IS UNCLEAR.</p> <p>3. ALL WORK SHALL COMPLY WITH THE MOST RECENT ADOPTED VERSION OF ALL APPLICABLE LAWS, RULES, REGULATIONS AND ORDINANCES OF ALL FEDERAL, STATE AND LOCAL AUTHORITIES. IF CONFLICT BETWEEN THE CONTRACT DOCUMENTS AND THE LOCAL ENFORCING AUTHORITY EXISTS, THE LOCAL ENFORCING AUTHORITY SHALL APPLY. ANY MODIFICATIONS TO THE DESIGN SHALL BE MADE WITHOUT ADDITIONAL COST TO THE OWNER OR ARCHITECT/ENGINEER. THE CONTRACTOR SHALL REPORT TO THE ARCHITECT/ENGINEER AND SECURE HIS APPROVAL BEFORE PROCEEDING WITH ANY MODIFICATIONS.</p> <p>4. WHERE THE REQUIREMENTS OF THE CONTRACT DOCUMENTS EXCEED THE REQUIREMENTS OF THE CODES, THE CONTRACT DOCUMENTS SHALL TAKE PRECEDENCE PROVIDED THAT THEY ARE NOT IN CONFLICT WITH THE CODES.</p> <p>5. BEFORE SUBMITTING BIDS, EACH CONTRACTOR SHALL PERFORM A SITE VISIT AND UNDERSTAND THE CONDITIONS TO BE MET IN INSTALLING THE WORK, AND SHALL MAKE PROVISIONS FOR THE CONDITIONS IN HIS FINAL BID. FAILURE ON THE PART OF THE CONTRACTOR TO COMPLY WITH THIS REQUIREMENT SHALL NOT BE CONSIDERED JUSTIFICATION FOR THE OMISSION OR FAULTY INSTALLATION OF ANY WORK COVERED BY THE CONTRACT DOCUMENTS.</p> <p>6. MISUNDERSTANDING OF THE SCOPE OR AMOUNT OF WORK TO BE PERFORMED SHALL BE THE RESPONSIBILITY OF THE CONTRACTOR, AND NOT THE RESULT OF ANY ADDITIONAL COST TO THE OWNER. TENDER OF A PROPOSAL CONVEYS FULL CONTRACTOR AGREEMENT OF THE ITEMS AND CONDITIONS SPECIED AND/OR INDICATED, SCHEDULED, OR IMPLIED ON THE CONTRACT DOCUMENTS, AND/OR REQUIRED BY THE NATURE OF THIS WORK.</p> <p>7. ALL WORK SHALL BE CARRIED OUT IN A NEAT, WELL ORGANIZED MANNER. ALL SERVICES SHALL BE ROUTED PARALLEL AND PERPENDICULAR TO THE PRIMARY LINES OF THE BUILDING. LOCATE ALL EQUIPMENT TO PROVIDE ACCESS AND ARRANGE ALL WORK WITH ADEQUATE ACCESS FOR OPERATION AND MAINTENANCE, AND TO MAINTAIN PROPER CODE AND MANUFACTURER'S CLEARANCES.</p> <p>8. ALL EQUIPMENT AND MATERIAL TO BE FURNISHED AND INSTALLED ON THIS PROJECT SHALL BE UL OR ETL LISTED, IN ACCORDANCE WITH THE AUTHORITY HAVING JURISDICTION, AND SUITABLE FOR ITS INTENDED USE ON THIS PROJECT.</p> <p>9. THE CONTRACTOR SHALL PROVIDE SUBMITTALS FOR ALL NEW EQUIPMENT, CONTROLS, AND FIXTURES TO BE PROVIDED AND INSTALLED.</p> <p>10. THE FOLLOWING SUBMITTAL DATA SHALL BE FURNISHED AND SHALL INCLUDE BUT NOT BE LIMITED TO:</p> <p>A. EQUIPMENT AND MATERIALS SHOP DRAWINGS B. COORDINATION DRAWINGS C. RECORD DRAWINGS D. OPERATING AND MAINTENANCE MANUALS E. FIRE STOP MATERIALS AND DETAIL</p> <p>11. THE GENERAL CONTRACTOR AND ALL SUBCONTRACTORS SHALL COORDINATE THE INSTALLATION OF DUCTWORK, PIPING, CONDUIT, CABLE, ETC., WITH LIGHTING FIXTURES, SPECIAL CEILING CONSTRUCTION, AIR DISTRIBUTION EQUIPMENT, AND THE STRUCTURE. PROVIDE ADDITIONAL RISES AND OFFSETS AS REQUIRED. IF, AFTER INSTALLED, NEW DUCTWORK, PIPING, CONDUIT, CABLE, ETC., IS FOUND TO BE IN CONFLICT WITH THE ARCHITECTURE, STRUCTURE OR OTHER TRADE WORK, WHICH IS EITHER SHOWN ON THE CONTRACT DOCUMENTS, THE DUCTWORK, PIPING, CONDUIT, CABLE, ETC., SHALL BE RELOCATED WITHOUT ADDITIONAL COST TO THE OWNER/TENANT. COORDINATE ALL WORK WITH ALL OTHER TRADES PRIOR TO INSTALLATION.</p> <p>12. MATERIALS AND EQUIPMENT SHALL BE NEW AND IN GOOD CONDITION. THE COMMERCIAL STANDARD ITEMS OF EQUIPMENT AND THE SPECIFIC NAMES ARE INTENDED TO IDENTIFY STANDARDS OF QUALITY. MATERIALS AND EQUIPMENT PERFORMANCE NECESSARY FOR THE PROPER FUNCTIONING OF THE WORK. MATERIALS AND EQUIPMENT, WHICH ARE FOUND TO HAVE FACTORY DEFECTS SHALL BE REPLACED OR REPAIRED IN A MANNER ACCEPTABLE TO THE OWNER/TENANT AND ENGINEER AT NO ADDITIONAL COST TO THE OWNER/TENANT.</p> <p>13. DAMAGE CAUSED DURING CONSTRUCTION TO EXISTING MATERIALS/EQUIPMENT WILL BE REPAIRED OR REPLACED AT NO ADDITIONAL COST TO OWNER. RE-SUPPORT ANY REMAINING PIPING OR DEVICES THAT WERE SUPPORTED BY WALLS BEING REMOVED.</p> <p>14. THE WARRANTY PERIOD SHALL BE NO LESS THAN ONE (1) FULL YEAR, UNLESS SPECIFIED OTHERWISE AND SHALL INCLUDE AT LEAST ONE HEATING SEASON. ONE (1) FULL COOLING SEASON. DURING THE WARRANTY PERIOD THE CONTRACTOR SHALL GUARANTEE THE FOLLOWING IN A FORM SATISFACTORY TO THE OWNER/TENANT:</p> <p>A. ALL WORK INSTALLED SHALL BE FREE FROM ANY AND ALL DEFECTS IN WORKMANSHIP AND/OR MATERIALS. B. ALL APPARATUS WILL DEVELOP CAPACITIES AND PERFORMANCE CHARACTERISTICS SPECIFIED. C. THE SYSTEMS SHALL OPERATE WITHOUT MALFUNCTION.</p> <p>15. THE START OF THE CONTRACTOR'S WARRANTY PERIOD SHALL COMMENCE ON THE DATE OF "SUBSTANTIAL COMPLETION" AS AGREED TO BY THE OWNER/TENANT.</p> <p>16. AREAS OF THE EXISTING BUILDING WILL BE OCCUPIED DURING CONSTRUCTION OF THIS PROJECT. NOISY, DUSTY, AND/OR OTHER CONSTRUCTION OPERATIONS REQUIRED FOR WORK WHICH DISTURB OR CAUSE COMPLAINTS BY THE EXISTING BUILDING OCCUPANTS SHALL NOT BE ACCEPTABLE. ALL AFTER-HOUR OR OVERTIME WORK REQUIRED BY THE CONTRACTOR TO AVOID DISRUPTION OF EXISTING OCCUPANTS WILL BE PROVIDED AT NO COST TO THE OWNER/TENANT. THE CONTRACTOR SHALL USE CONSTRUCTION METHODS AND MATERIALS WHICH SHALL NOT ADVERSELY AFFECT THE INDOOR AIR QUALITY OF THE EXISTING OCCUPIED AREAS.</p> <p>17. PORTIONS OF THE BUILDING WILL BE IN USE AND OCCUPIED DURING THE CONSTRUCTION PERIOD OF THIS PROJECT. ALL BUILDING SERVICES, UTILITIES, POWER, CHILLED WATER, FIRE PROTECTION, AND DOMESTIC COLD AND HOT WATER WHICH WILL BE REQUIRED FOR THIS PROJECT MAY NOT BE DISRUPTED FOR ANY REASON WITHOUT PRIOR COORDINATION WITH A REPRESENTATIVE OF BUILDING MANAGEMENT AND THE OWNER AND A WRITTEN AUTHORIZATION FROM THE BUILDING MANAGER AND OWNER DESIGNATING A DATE, TIME, AND DURATION THAT ARE APPROVED BY THE BUILDING MANAGER AND OWNER FOR SUCH DISRUPTION. AN ADDITIONAL ADVANCE NOTIFICATION OF SEVEN (7) DAYS SHALL BE GIVEN TO THE BUILDING MANAGER AND OWNER PRIOR TO EACH DISRUPTION.</p> <p>18. THIS BUILDING MAY HAVE A STRUCTURAL SYSTEM UTILIZING POST-TENSIONED CABLES. THE CONTRACTOR SHALL DETERMINE THE EXISTING STRUCTURAL SYSTEM PRIOR TO CUTTING, DRILLING, OR CORING. THE CONTRACTOR SHALL X-RAY ALL PENETRATIONS PRIOR TO CUTTING THE FLOOR SLAB.</p> <p>19. THIS CONTRACTOR SHALL SECURE ALL PERMITS, LICENSES AND INSPECTIONS REQUIRED FOR HIS WORK, AND SHALL PAY ALL FEES IN CONNECTION WITH SUCH PERMITS, LICENSES AND INSPECTIONS.</p> <p>20. IN THE EVENT OF A CONFLICT BETWEEN DRAWINGS AND/OR SPECIFICATIONS, THE CONTRACTOR SHALL PROVIDE PRICING REFLECTING THE GREATEST COST. THE CONFLICT SHALL BE BROUGHT TO THE ATTENTION OF THE ENGINEER FOR CLARIFICATION.</p> <p>21. PENETRATIONS THROUGH FLOORS OR FIRE-RATED CONSTRUCTION SHALL BE FIRE RATED TO COMPLY WITH ASTM E-814 (UL 1479), AND THE LOCAL AUTHORITY HAVING JURISDICTION.</p> <p>22. UPON COMPLETION OF THE PROJECT, THE CONTRACTOR SHALL SUBMIT TO THE ENGINEER, A COMPLETE SET OF "AS BUILT" DRAWINGS PORTAL ACTIONS OF THE MECHANICAL, ELECTRICAL, PLUMBING AND FIRE PROTECTION WORK. SUBMISSION SHALL CONSIST OF ONE SET OF PAPER COPIES AND ONE SET OF CAD FILES IN AUTOCAD (CONTRACTOR SHALL UTILIZE OWNER'S LAYER STANDARDS IF EXISTING).</p> <p>23. IN THE EVENT THAT MATERIALS, PRODUCTS, AND/OR PROCESSES BEING PROPOSED FOR THIS PROJECT CONTAIN, OR MAY EMIT, ANY VOLATILE ORGANIC COMPOUNDS (VOC), FORMALDEHYDE FORMULATIONS, OR HAZARDOUS ODOR-GASSING, AS DETERMINED BY THE MANUFACTURER, A MATERIALS SAFETY DATA SHEET SHALL BE SUBMITTED AS PART OF THE SHOP DRAWING PROCESS FOR REVIEW BY THE ARCHITECT/ENGINEER/ OWNER.</p> <p>24. THE CONTRACTOR SHALL TAKE NOTE THAT THE DRAWINGS ARE SCHEMATIC IN NATURE AND INDICATE THE APPROXIMATE LOCATIONS OF THE HVAC AND PLUMBING SYSTEMS. LOCATE ALL ITEMS IN THE FIELD. COORDINATE WITH OTHER TRADES TO ENSURE PROPER FIT AND ACCESS TO ALL ITEMS.</p> <p>25. THE CONTRACTOR SHALL PROTECT THE WORK, EQUIPMENT, AND MATERIALS FROM DAMAGE BY HIS WORK OR HIS PERSONNEL, AND SHALL CORRECT ALL DAMAGE CAUSED WITHOUT ADDITIONAL COST TO THE OWNER. THE CONTRACTOR SHALL BE RESPONSIBLE FOR ALL WORK, MATERIALS, AND EQUIPMENT UNTIL FINAL ACCEPTANCE BY THE OWNER. PROTECT ALL WORK AGAINST THEFT, INJURY, OR DAMAGE. CAREFULLY STORE ALL MATERIALS AND EQUIPMENT RECEIVED ON SITE WHICH IS NOT IMMEDIATELY INSTALLED. THE CONTRACTOR SHALL CLOSE OPEN ENDS OF WORK WITH TEMPORARY COVERS OR PLUGS DURING CONSTRUCTION TO PREVENT THE ENTRY OF DUST, DIRT, AND OBSTRUCTING MATERIAL. .</p>	<p>1. ALL EXISTING DUCTWORK AND PIPING SIZES AND LOCATIONS SHOWN ARE FROM EXISTING RECORDS, DOCUMENTS, AND SITE OBSERVATIONS. MECHANICAL CONTRACTOR SHALL FIELD VERIFY ALL EXISTING CONDITIONS AND SHALL INCLUDE IN HIS BID THE COST OF REPLACEMENT, REPAIR, RELOCATION, OR REMOVAL OF EXISTING MEP ITEMS AS REQUIRED TO COMPLETE THE INSTALLATION OF ALL MECHANICAL SYSTEMS SHOWN ON THESE DRAWINGS PRIOR TO SUBMITTING A BID.</p> <p>2. THE CONTRACTOR SHALL VERIFY THAT ALL EXISTING AND NEW TERMINAL UNITS ARE MOUNTED SO THAT ALL REQUIRED SERVICING AND MAINTENANCE CLEARANCES ARE MAINTAINED AT THE BOTTOM AND SIDES OF EACH UNIT. COORDINATE WITH ALL NEW ARCHITECTURAL WALLS TO STRUCTURE AND RELOCATE TERMINAL UNITS AS REQUIRED TO MAINTAIN PROPER CLEARANCES.</p> <p>3. IT IS ACCEPTABLE TO REUSE EXISTING AIR DEVICES IF THEY MATCH THE SCHEDULED MANUFACTURER AND MODEL NUMBER, NECK SIZE AND PERFORMANCE INDICATED IN THIS DRAWING SET. CONTRACTOR SHALL FIELD VERIFY EXISTING CONDITIONS AND TAKE INVENTORY OF EXISTING AIR DEVICES WITHIN THE SPACE PRIOR TO SUBMITTING A BID. ALL REUSED AIR DEVICES SHALL BE CLEANED AND REPAINTED AS REQUIRED TO RETURN TO "LIKE-NEW" CONDITIONS.</p> <p>4. EXISTING TAKE-OFF CONNECTIONS MAY BE REUSED IF LOCATED WITHIN 3'-0" OF NEW CONNECTION SHOWN ON DRAWING. ALL TAKE-OFF CONNECTIONS NOT USED SHALL BE REMOVED AND DUCTWORK SHALL BE PATCHED WITH SHEET METAL, SEALED AND RE-INSULATED TO MATCH EXISTING.</p> <p>5. NO FAN POWERED TERMINAL UNITS SHALL HAVE SPRINKLER PIPING BLOCKING BOTTOM-MOUNTED ACCESS PANELS. OFFSET NEW AND EXISTING SPRINKLER PIPING AS REQUIRED. EXISTING FAN POWERED TERMINAL BOXES MOUNTED ABOVE OR ADJACENT TO WALLS WHERE ACCESS IS OBSTRUCTED SHALL BE RELOCATED AS REQUIRED.</p> <p>6. MECHANICAL CONTRACTOR SHALL COORDINATE WITH ALL OTHER MEP TRADES TO MAINTAIN A MINIMUM OF 9" CLEAR SPACE FOR TENANT EQUIPMENT, CABLE TRAY, WIRING, ETC.</p> <p>7. PROVIDE REMOTE DAMPER OPERATORS FOR ALL SPIN-IN DAMPERS LOCATED ABOVE INACCESSIBLE CEILINGS. OPERATORS SHALL BE ROTARY TWIST (OR APPROVED EQUAL) CABLE-TYPE OPERATORS, CONCEALED WITHIN DUCT RUN-OUT TO DEVICE, AND ACCESSIBLE FOR BALANCING FROM FACE OF AIR DEVICE. PROVIDE REQUIRED CABLE LENGTHS, MOUNTING CLIPS, AND ALL OTHER REQUIRED COMPONENTS FOR PROPER INSTALLATION AND OPERATION.</p> <p>8. PRIMARY AND SECONDARY DUCTWORK SHALL HAVE EXTERNAL INSULATION INSTALLED ON TOP SIDE OF DUCTWORK PRIOR TO HANGING DUCTWORK TO ALLOW DUCT TO BE SUSPENDED WITH INSULATION TIGHT TO STRUCTURE. DO NOT COMPRESS INSULATION.</p> <p>9. IT SHALL BE THE CONTRACTOR'S RESPONSIBILITY TO BRING TO THE ENGINEER'S ATTENTION ANY WALLS THAT EXTEND FROM THE FINISHED FLOOR TO STRUCTURE AND REQUIRE RETURN AIR PATHWAYS. RETURN AIR BOOTS SHALL BE INSTALLED TO PROVIDE CROSS SECTIONAL AREA EQUIVALENT TO 500 FPM OF AIRFLOW BASED ON THE SUPPLY CFM TO THE ROOM ENCLOSED BY THE FULL HEIGHT WALLS.</p> <p>10. FINAL LOCATION OF ALL NEW EQUIPMENT SHALL BE APPROVED BY BUILDING OWNER OR PROJECT MECHANICAL ENGINEER PRIOR TO INSTALLATION.</p> <p>11. ROOF PENETRATIONS SHALL BE PERFORMED TO MAINTAIN THE WARRANTY ON THE ROOF. COORDINATE PENETRATIONS WITH THE ROOF MEMBRANE MANUFACTURER.</p> <p>12. MOUNT ALL TEMPERATURE CONTROL DEVICES 48" ABOVE FINISHED FLOOR TO THE CENTER OF THE DEVICE TO COMPLY WITH THE REQUIREMENTS OF THE AMERICANS WITH DISABILITIES ACT ANSI A117.1.</p> <p>13. DURING CONSTRUCTION, SEAL ALL OPEN DUCTS WITH PLASTIC TO PREVENT DUST/DIRT. CLEAN ALL INTERIOR DUCT SURFACES PRIOR TO DUCT INSTALLATION. ALL VAV TERMINAL UNIT FILTERS SHALL BE MAINTAINED DURING CONSTRUCTION AND REPLACED AT THE END OF CONSTRUCTION. PROVIDE CONSTRUCTION FILTERS OVER AIR HANDLING UNIT INTAKES AND MAINTAIN FILTER MEDIA DURING CONSTRUCTION. REPLACE ALL FILTERS AT END OF CONSTRUCTION. ALL RETURN AIR INTAKES TO MECHANICAL ROOM SHALL BE COVERED WITH FILTER MEDIA DURING CONSTRUCTION. REMOVE UPON COMPLETION.</p> <p>14. SEAL ALL NEW AND EXISTING PIPE, CONDUIT, AND DUCT PENETRATIONS THRU FIRE RATED WALLS WITH FIRE CAULKING. FIRE CAULKING SHALL BE EQUAL TO 3M BRAND CP25WP FIRE CAULK. INSTALL CAULKING IN STRICT ACCORDANCE WITH ALL MANUFACTURER'S RECOMMENDATIONS AND WRITTEN INSTRUCTIONS AND IN ACCORDANCE WITH ALL APPLICABLE UL DETAILS.</p> <p>15. CONTRACTOR SHALL MAINTAIN A SET OF CONSTRUCTION DOCUMENTS FOR THE SOLE PURPOSE OF INDICATING CONDITIONS. SET SHALL NOT BE USED FOR ANY OTHER PURPOSE. AS-BUILT REVISIONS SHALL BE INDICATED USING RED PENCIL AND BE CLEARLY DRAWN AND LABELED TO BE LEGIBLE. ILLEGIBLE ENTRIES SHALL BE REVISED BY THE CONTRACTOR. PROVIDE AS-BUILT SET TO THE OWNER AT SUBSTANTIAL COMPLETION.</p> <p>16. CONTRACTOR SHALL COMPLETE START-UP FORMS AND CHECK-OUT UTILIZING MANUFACTURER CERTIFIED START-UP TECHNICIANS. EQUIPMENT START-UP AND CHECK-OUT FORMS SHALL BE INCLUDED IN THE O&amp;M MANUALS.</p> <p>17. RADIUS ELBOWS 2 TIMES THE DUCT DIMENSION AND LARGER DO NOT REQUIRE SPLITTER VANES; PROVIDE SPLITTER VANES FOR ALL RADIUS ELBOWS 1.5 TIMES AND SMALLER. SPLITTER VANES SHALL BE LOCATED AND SECURED IN ACCORDANCE WITH SMACNA "HVAC DUCT CONSTRUCTION STANDARDS - METAL AND FLEXIBLE."</p> <p>18. RECTANGULAR ELBOWS SHALL INCORPORATE TURNING VANES. VANES SHALL BE SINGLE-THICKNESS GALVANIZED STEEL VANES SET IN GALVANIZED STEEL RUNNERS. VANES AND RUNNERS SHALL BE CONSTRUCTED AND SECURED IN ACCORDANCE WITH SMACNA "HVAC DUCT CONSTRUCTION STANDARDS - METAL AND FLEXIBLE."</p>		
MECHANICAL ABBREVIATIONS				SHEET LIST		
<div><div>AFF</div><div>ABOVE FINISHED FLOOR</div><div>ACFM</div><div>ACTUAL CFM</div><div>AHU</div><div>AIR HANDLING UNIT</div><div>ANSI</div><div>AMERICAN NATIONAL STANDARDS INSTITUTE</div><div>AMP</div><div>AMPERE (AMP, AMPS)</div><div>APD</div><div>AIR PRESSURE DROP</div><div>APPROX</div><div>APPROXIMATE</div><div>BHP</div><div>BRAKE HORSEPOWER, BOILER HORSEPOWER</div><div>BTU</div><div>BRITISH THERMAL UNIT</div><div>BOD</div><div>BOTTOM OF DUCT</div><div>MBH</div><div>BTU PER HOUR (THOUSAND)</div><div>C</div><div>COMMON</div><div>CU FT</div><div>CUBIC FEET</div><div>CU IN</div><div>CUBIC INCH</div><div>CFM</div><div>CUBIC FEET PER MINUTE</div><div>COD</div><div>CENTER OF DUCT</div><div>SCFM</div><div>CFM, STANDARD CONDITIONS</div><div>DB</div><div>DECIBEL</div><div>DIA</div><div>DIAMETER</div><div>ID</div><div>DIAMETER, INSIDE</div><div>OD</div><div>DIAMETER, OUTER</div><div>DBT</div><div>DRY-BULB TEMPERATURE</div><div>EAT</div><div>ENTERING AIR TEMPERATURE</div><div>EC</div><div>ELECTRICAL CONTRACTOR</div><div>EDR</div><div>EQUIVALENT DIRECT RADIATION</div><div>EXP</div><div>EXPANSION</div><div>EWT</div><div>ENTERING WATER TEMPERATURE</div><div>F</div><div>FAHRENHEIT</div><div>FPM</div><div>FEET PER MINUTE</div><div>FPS</div><div>FEET PER SECOND</div><div>FT</div><div>FOOT OR FEET</div><div>HZ</div><div>FREQUENCY</div><div>GA</div><div>GAGE OR GAUGE</div><div>GAL</div><div>GALLONS</div><div>G.C.</div><div>GENERAL CONTRACTOR</div><div>GPH</div><div>GALLONS PER HOUR</div><div>GPM</div><div>GALLONS PER MINUTE</div><div>GPD</div><div>GALLONS PER DAY</div><div>HD</div><div>HEAD</div><div>HGT</div><div>HEIGHT</div><div>HP</div><div>HORSEPOWER</div><div>RH</div><div>HUMIDITY, RELATIVE</div><div>KW</div><div>KILOWATT</div><div>KWH</div><div>KILOWATT HOUR</div><div>LAT</div><div>LEAVING AIR TEMPERATURE</div></div>	<div><div>LWT</div><div>LEAVING WATER TEMPERATURE</div><div>LF</div><div>LINEAR FEET</div><div>MAX</div><div>MAXIMUM</div><div>MC</div><div>MECHANICAL CONTRACTOR</div><div>MIN</div><div>MINIMUM</div><div>NO</div><div>NORMALLY OPEN</div><div>NC</div><div>NORMALLY CLOSED</div><div>N/A</div><div>NOT APPLICABLE</div><div>NIC</div><div>NOT IN CONTRACT</div><div>NTS</div><div>NOT TO SCALE</div><div>NO</div><div>NUMBER</div><div>OBD</div><div>OPPOSED BLADE DAMPER</div><div>OA</div><div>OUTSIDE AIR</div><div>%</div><div>PERCENT</div><div>PH</div><div>PHASE (ELECTRICAL)</div><div>LBS</div><div>POUNDS</div><div>PSI</div><div>POUNDS PER SQUARE INCH</div><div>PSIA</div><div>PSI ABSOLUTE</div><div>PD</div><div>PRESSURE DROP</div><div>PSIG</div><div>PSI GAUGE</div><div>R/O</div><div>RUN OUT</div><div>RA</div><div>RETURN AIR</div><div>RPM</div><div>REVOLUTIONS PER MINUTE</div><div>SH</div><div>SENSIBLE HEAT</div><div>SPEC</div><div>SPECIFICATION</div><div>SP VOL</div><div>SPECIFIC VOLUME</div><div>STD</div><div>STANDARD</div><div>SP</div><div>STATIC PRESSURE</div><div>SUCT</div><div>SUCTION</div><div>SA</div><div>SUPPLY AIR</div><div>TEMP</div><div>TEMPERATURE</div><div>TD</div><div>TEMPERATURE DIFFERENCE</div><div>T STAT</div><div>THERMOSTAT</div><div>TOD</div><div>TOP OF DUCT</div><div>TONS</div><div>TONS OF REFRIGERATION</div><div>TC</div><div>TEMPERATURE CONTROL</div><div>VACUUM</div><div>VACUUM</div><div>VAV</div><div>VARIABLE AIR VOLUME</div><div>VEL</div><div>VELOCITY</div><div>V</div><div>VOLT</div><div>VOL</div><div>VOLUME</div><div>VFD</div><div>VARIABLE FREQUENCY DRIVE</div><div>WPD</div><div>WATER PRESSURE DROP</div><div>W/</div><div>WITH</div></div>				<div><div>DRAWING</div><div>M001</div><div>M002</div><div>M003</div><div>M201</div><div>M301</div></div>	<div><div>SHEET TITLE</div><div>MECHANICAL COVER SHEET</div><div>MECHANICAL DETAILS</div><div>MECHANICAL SCHEDULES</div><div>MECHANICAL HVAC PLANS</div><div>MECHANICAL ROOF PLAN</div></div>

LEVY DYKEMA

STATE OF TEXAS  
BRIAN D. HOCKMAN  
108645  
LICENSED PROFESSIONAL ENGINEER

08/26/2025

127 E JACKSON ST. BURNET TX 78611

Project Number: 33-1408


© 2024 LEVY DYKEMA

MECHANICAL COVER SHEET


M001




Autodesk Docs/233-1408 Burnet County Annex/Burnet County\_M002.rvt

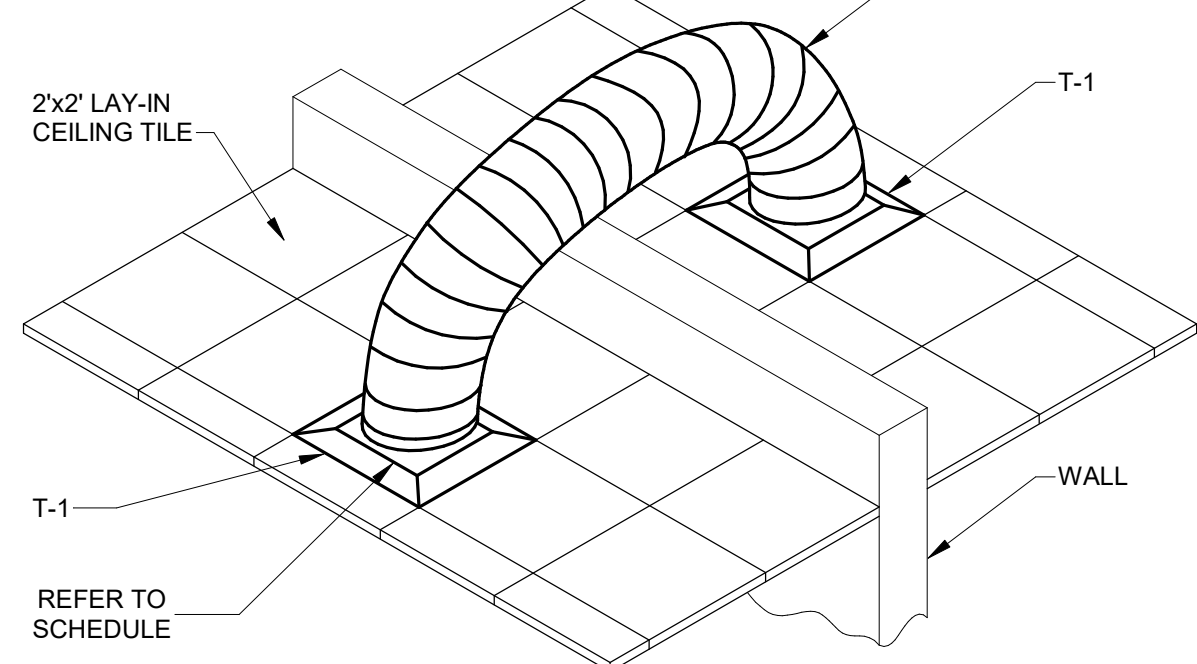


**H** **TRANSFER DUCT DETAIL**  
M002 NOT TO SCALE

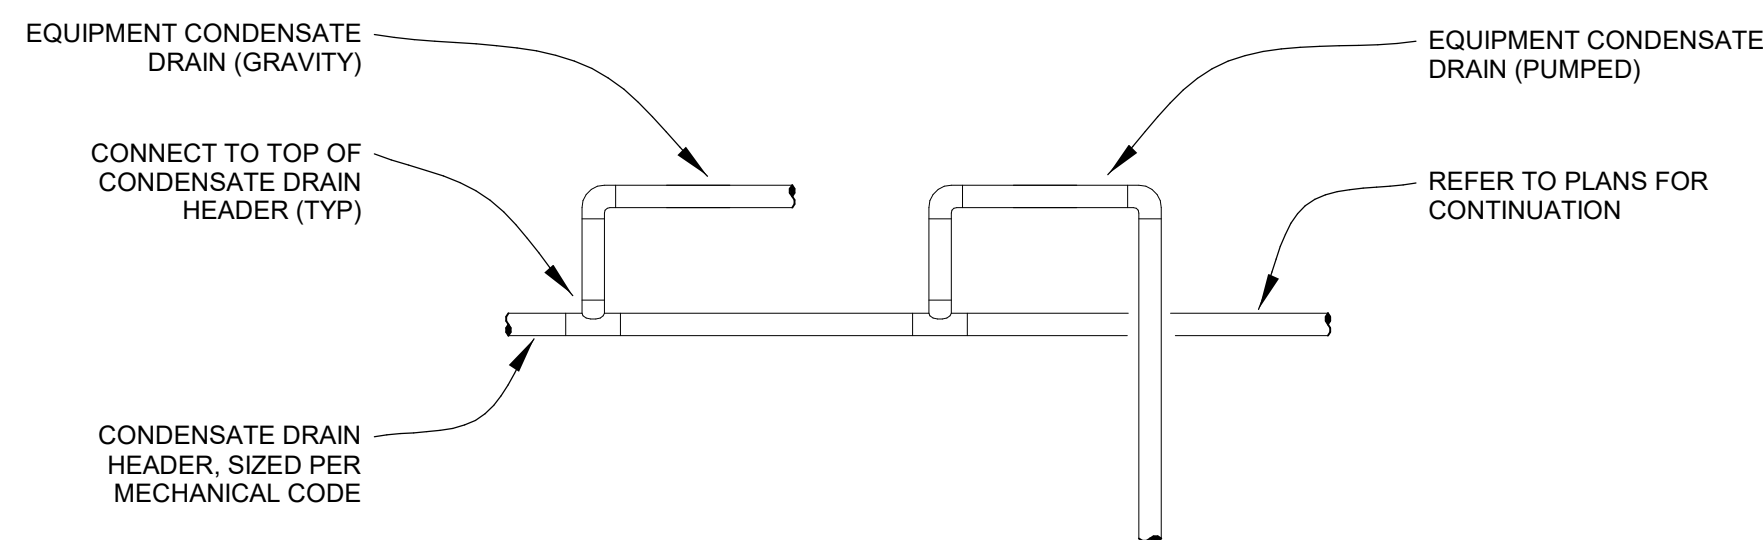


**J** **DIFFUSER IN LAY-IN CEILING DETAIL**  
M002 NOT TO SCALE

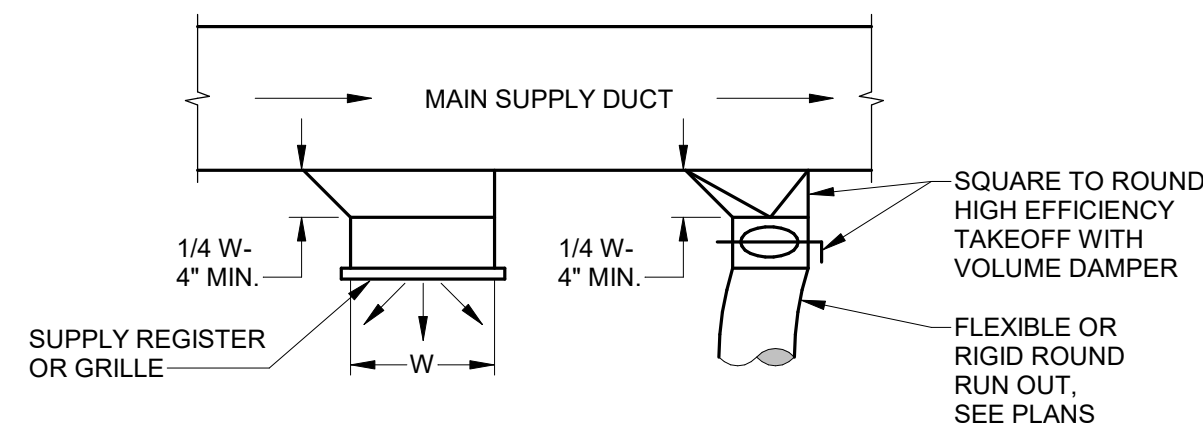

**SUPPLY REGISTER & RUN OUT TAKEOFF**

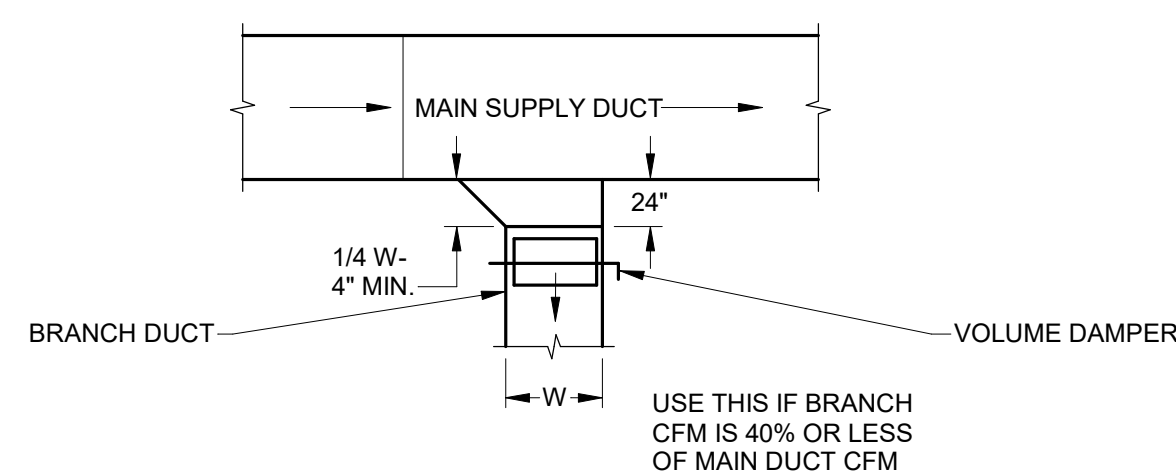


**BRANCH DUCT TAKEOFF**

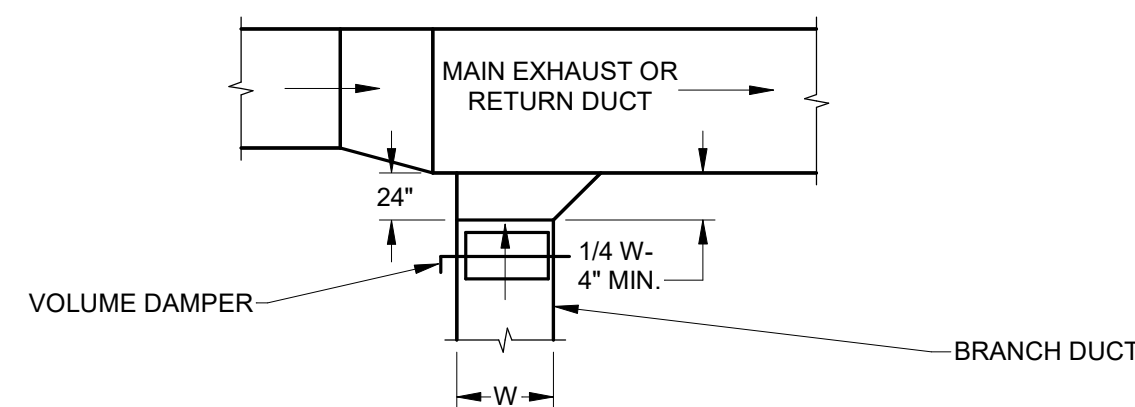


**EXHAUST AND/OR RETURN BRANCH DUCT**

**K** **LOW VELOCITY DUCT DETAILS**  
M002 NOT TO SCALE

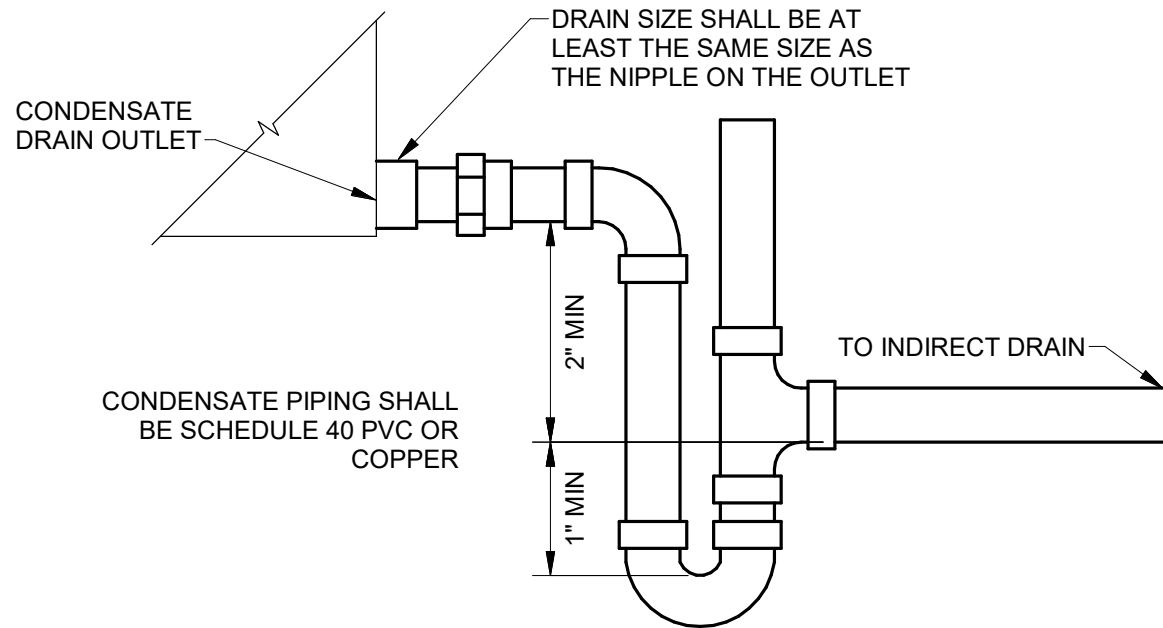


**D** **CONDENSATE TRAP**  
M002 NOT TO SCALE

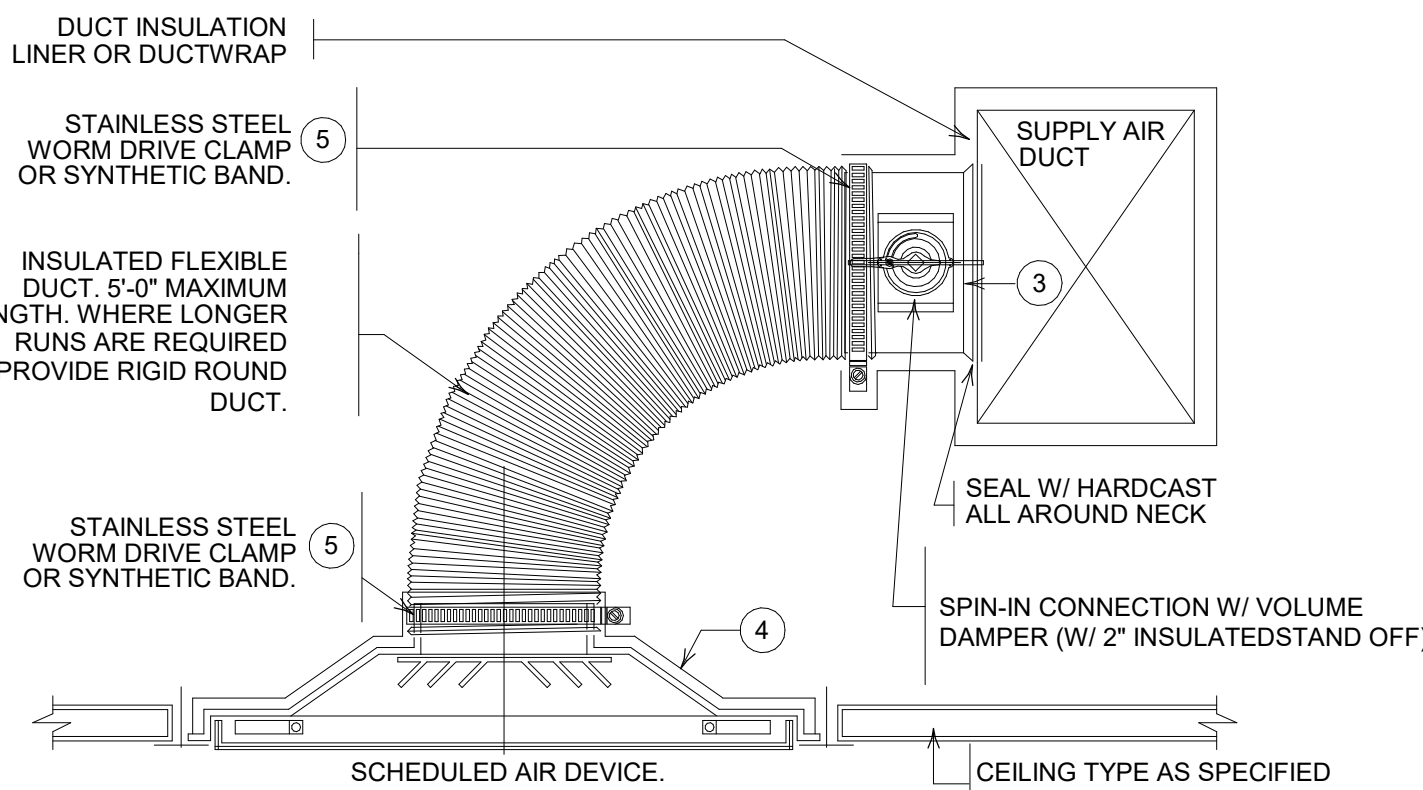


- NOTES:
1. CEILING DIFFUSER SHALL BE INSTALLED SUCH THAT THE FACE OF DIFFUSER IS FLUSH WITH CEILING.
  2. SUPPORT FLEXIBLE DUCT FROM STRUCTURE. FLEXIBLE DUCT SHALL NOT KINK, SAG OR REST ON LIGHT FIXTURE, CEILING SUPPORT "TEES" OR CEILING TILE.
  3. PROVIDE SQUARE TO ROUND TAP WHERE FLEXIBLE DUCT SIZE EXCEEDS DIMENSION OF RECTANGULAR DUCT. (SEE DET. FOR ADDITIONAL INFORMATION.)
  4. FOR UNCONDITIONED CEILING PLENUMS, INSULATE ENTIRE BACK OF CEILING DIFFUSER WITH 2" DUCT WRAP AND SEAL WITH VAPOR BARRIER TAPE.
  5. EXTEND INSULATION AND OUTER JACKET OVER THE SECURE CLAMP/BAND AND TAPE DOWN TO SLEEVE/COLLAR TO MAINTAIN VAPOR BARRIER INTEGRITY. (TYPICAL)


**E** **DIFFUSER DETAIL**  
M002 NOT TO SCALE

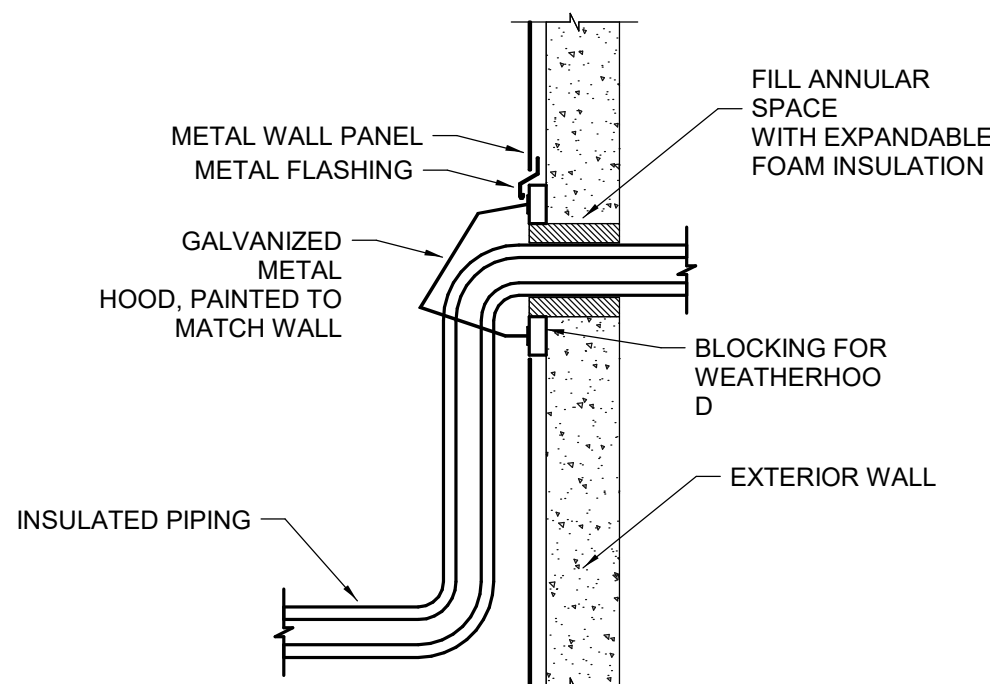


**G** **EXHAUST FAN DETAIL**  
M002 NOT TO SCALE

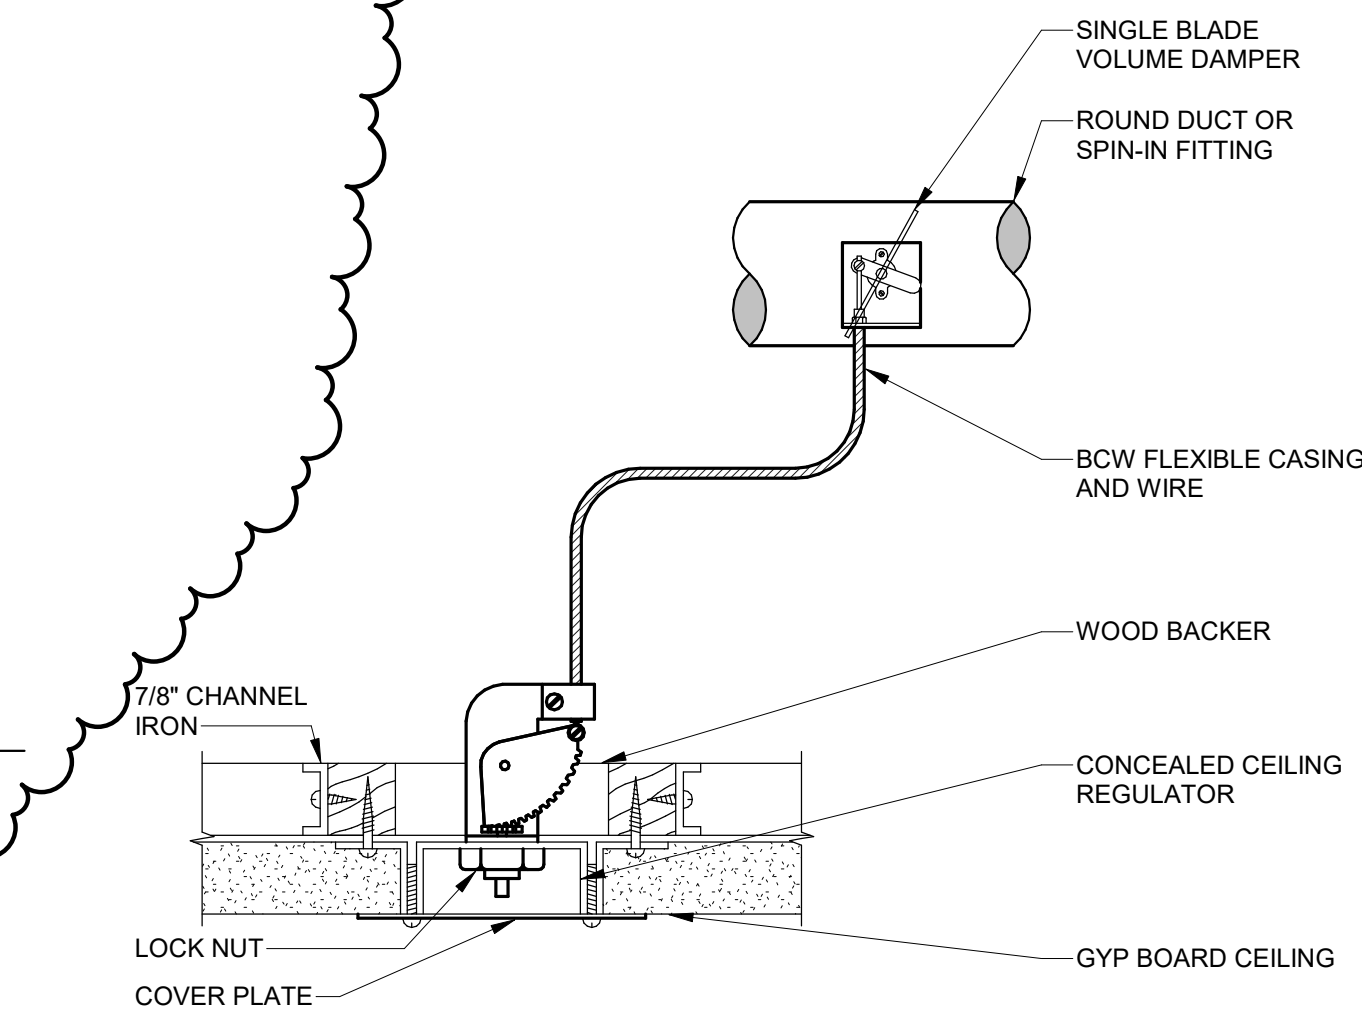


**F** **REMOTE DAMPER DETAIL**  
M002 NOT TO SCALE

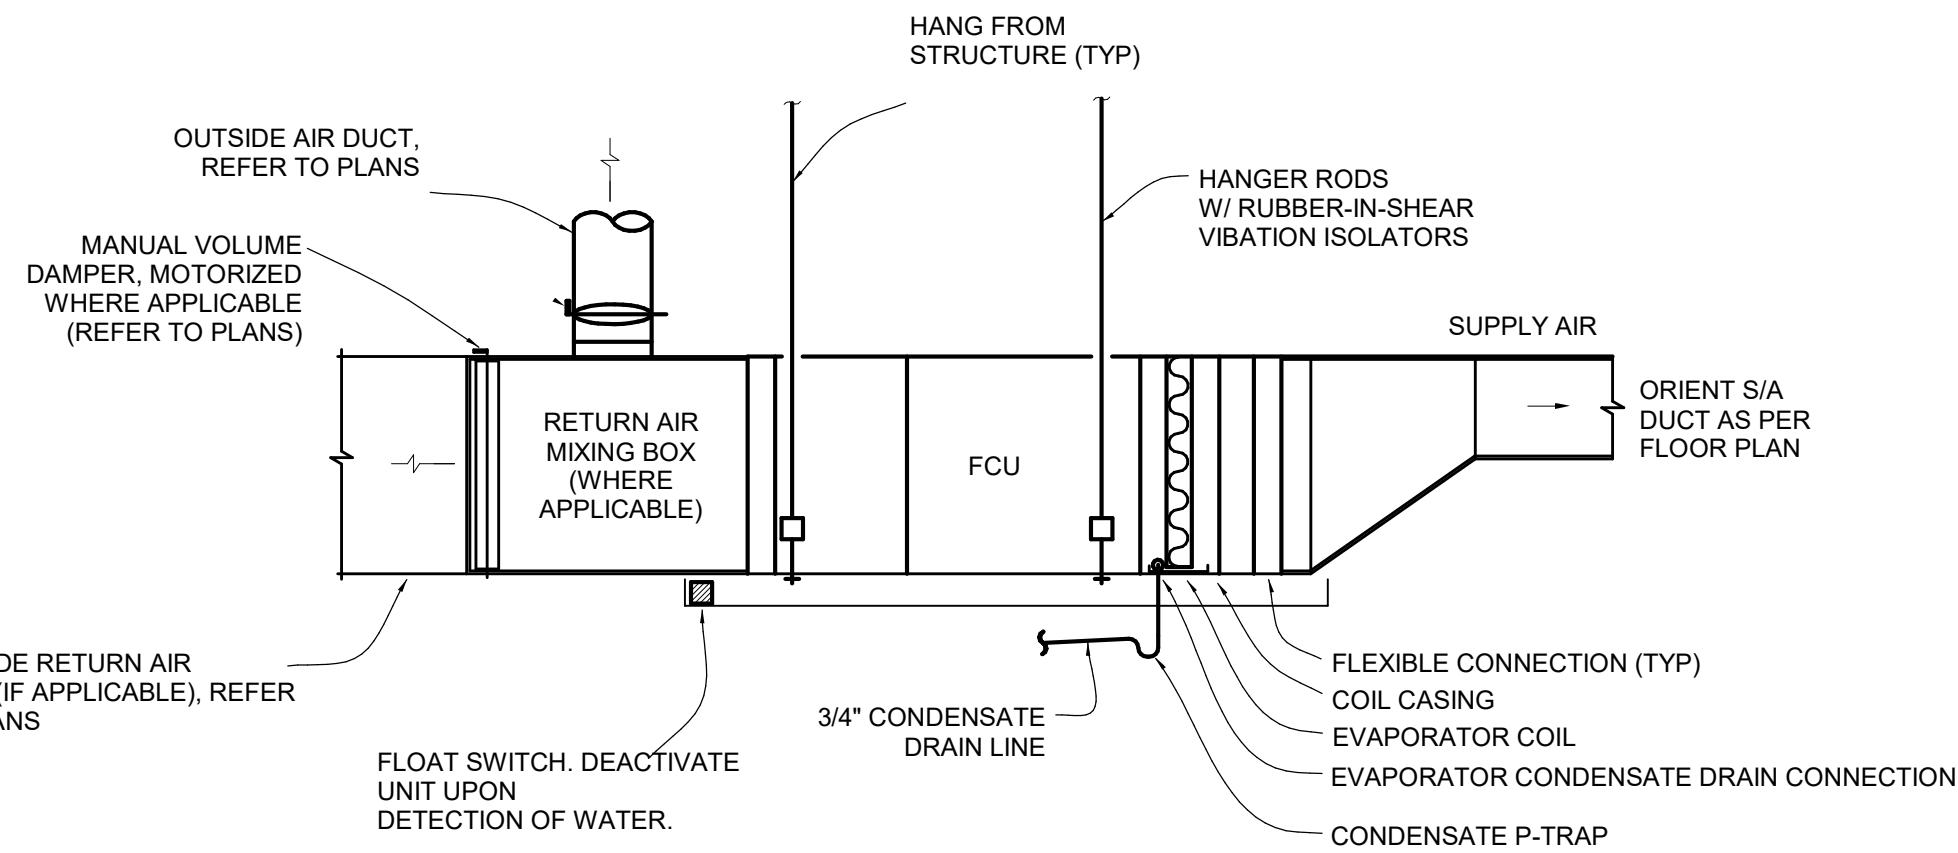

**A** **FAN COIL UNIT - RETURN BOOT**  
M002 NOT TO SCALE

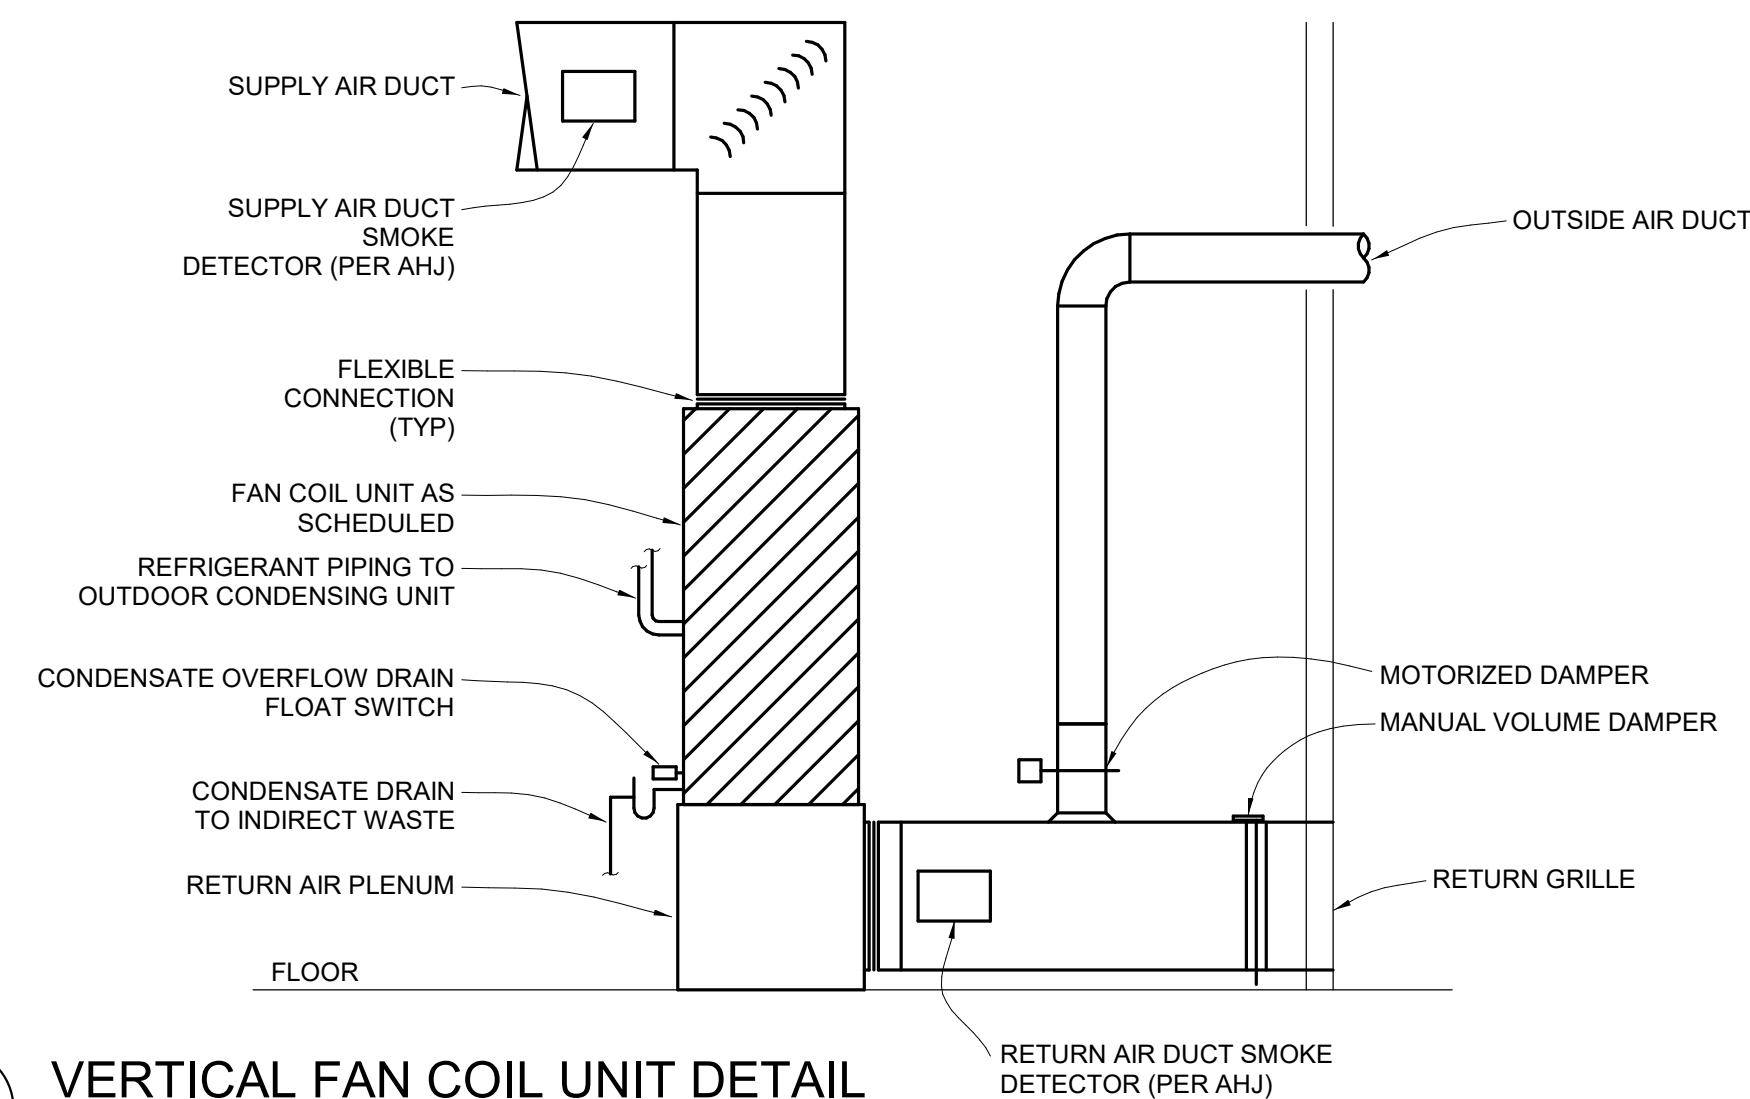

**B** **VERTICAL FAN COIL UNIT DETAIL**  
M002 NOT TO SCALE

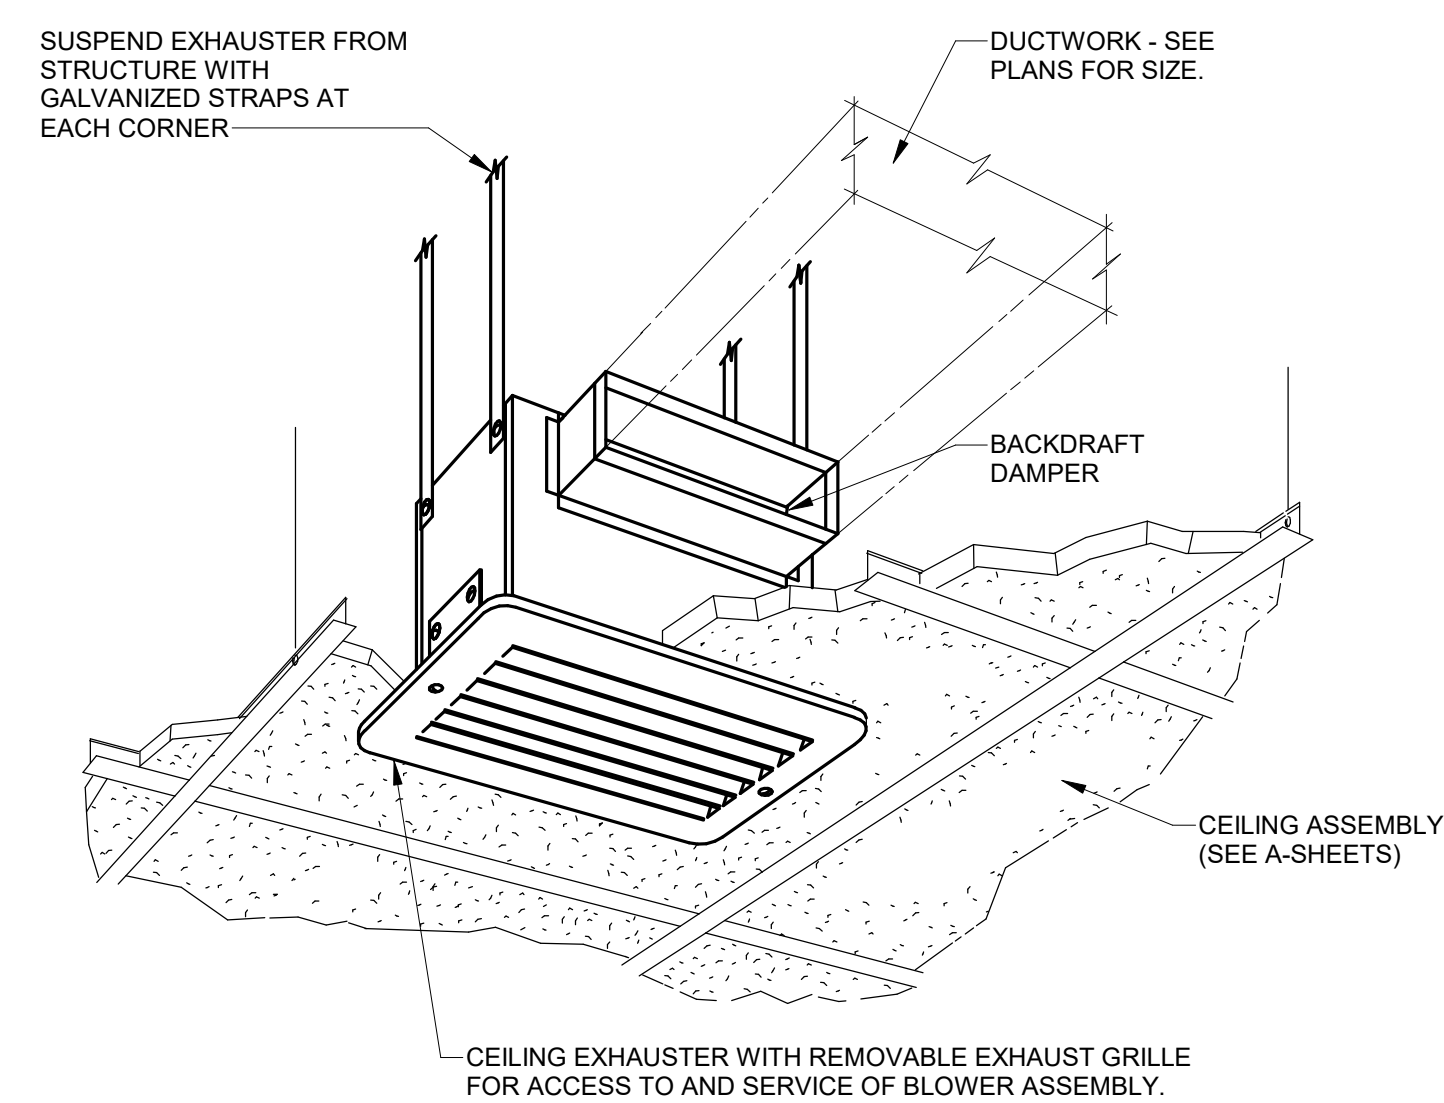

**C** **CEILING MOUNTED EXHAUST FAN**  
M002 NOT TO SCALE

#	DATE	ISSUE
1	08/21/2025	Addendum 1



Autodesk Docs/233-1408 Burnet County Annex/Burnet County\_Maps\_BV022.rvt

VENTILATION / PRESSURE CALCS - 1ST FLOOR				
OUTSIDE AIR INTAKE		BUILDING EXHAUST		
TAG	AIR FLOW (CFM)	TAG	SERVICE	AIR FLOW (CFM)
FCU-1-1	210	EF-1-1	126 UTILITY	0
		EF-1-2	130 WOMEN'S RESTROOM	75
		EF-1-3	131 MEN'S RESTROOM	75
TOTAL OA (CFM)	210		TOTAL EXHAUST (CFM)	150
REQUIRED MIN. VENTILATION RATE (CFM)				207
TOTAL BUILDING PRESSURIZATION (CFM)				60
BUILDING PRESSURIZATION RATE (CFM/SF)				0.04
<b>NOTES:</b> (1) TOTAL APPROXIMATE AREA 1,560 SQUARE FT (2) *INTERMITTENT USAGE, TWO FAN OPERATIONAL SIMULTANEOUSLY.				
VENTILATION / PRESSURE CALCS - 2ND FLOOR				
OUTSIDE AIR INTAKE		BUILDING EXHAUST		
TAG	AIR FLOW (CFM)	TAG	SERVICE	AIR FLOW (CFM)
FCU-2-1	220	EF-2-1	203 WOMEN'S RESTROOM	75
		EF-2-2	204 MEN'S RESTROOM	75
TOTAL OA (CFM)	220		TOTAL EXHAUST (CFM)	150
REQUIRED MIN. VENTILATION RATE (CFM)				219
TOTAL BUILDING PRESSURIZATION (CFM)				70
BUILDING PRESSURIZATION RATE (CFM/SF)				0.04
<b>NOTES:</b> (1) TOTAL APPROXIMATE AREA 1,767 SQUARE FT (2) *INTERMITTENT USAGE, TWO FAN OPERATIONAL SIMULTANEOUSLY.				

AIR DEVICE SCHEDULE											
TAG	MANUFACTURER	MODEL	DUCT SIZE (IN)	NOM. FACE SIZE (IN)	MAX AIRFLOW (CFM)	THROW (@50 FPM)	NC AT MAX AIRFLOW	MATERIAL	FINISH	MOUNTING	NOTES
<b>SUPPLY GRILLE</b>											
S-1	TITUS	OMNI	6"Ø	12x12	135	11	17	ALUMINUM	WHITE	SURFACE	1 - 6
S-2	TITUS	OMNI	6"Ø	12x12	135	11	17	STEEL	WHITE	SURFACE	1 - 6
S-3	TITUS	OMNI	6"Ø	24x24	135	6	NC < 10	STEEL	WHITE	LAY-IN	1 - 6
S-4	TITUS	OMNI	8"Ø	24x24	245	10	12	STEEL	WHITE	LAY-IN	1 - 6
S-5	TITUS	OMNI	10"Ø	24x24	435	14	20	STEEL	WHITE	LAY-IN	1 - 6
<b>RETURN GRILLE</b>											
R-1	TITUS	350RL	18x18	20x20	1450	-	28	STEEL	WHITE	WALL	1 - 4
R-2	TITUS	350RL	24x20	26x22	2180	-	30	STEEL	WHITE	WALL	1 - 4
<b>TRANSFER GRILLE</b>											
T-1	TITUS	PAR	22x10	24x12	765	-	-	STEEL	WHITE	LAY-IN	1 - 6
<b>NOTES:</b> (1) COORDINATE WITH ARCHITECTURAL DRAWINGS FOR REQUIRED MOUNTING TYPES. (2) COORDINATE WITH ARCHITECT AND GC FOR FINAL COLOR OF AIR DEVICE. (3) AIR DEVICES FROM ALTERNATE MANUFACTURER EQUAL TO SCHEDULED MODELS ARE ACCEPTABLE (PRICE, METALAIRE, ETC.). (4) AIR DEVICES LOCATED IN INACCESSIBLE CEILINGS TO BE PROVIDED WITH REMOTE OPERARABLE SINGLE BLADE AIR DAMPERS. (5) PLAQUE AIR DEVICES TO BE PROVIDED WITH BACKPAN INSULATION. (6) MECHANICAL CONTRACTOR TO SIZE BRANCH DUCTWORK TO MAINTAIN AT LEAST ≤ 800 FPM OR AS INDICATED ON PLANS.											

EXHAUST FAN SCHEDULE												
TAG	MANUFACTURER	MODEL	SERVICE	LOCATION	FAN TYPE	DRIVE TYPE	AIR VOLUME (CFM)	EXT. STATIC PRESSURE (IN WG)	ELEC		WEIGHT (LBS)	NOTES
									POWER	MOTOR SIZE		
EF-1-1, 2, & 3 EF-2-1 & 2	GREENHECK	SP-A50-90-VG	REFER TO PLANS	CEILING	CENTRIFUGAL	DIRECT	75	0.25	120/60/1	6 W	12	1 - 3
<b>NOTES:</b> (1) FANS PROVIDED AND INSTALLED BY MECHANICAL CONTRACTOR. (2) PROVIDE MANUFACTURER'S INTEGRAL BACKDRAFT DAMPER, VIBRATION ISOLATION KIT, AND DECORATIVE GRILLE. (3) COORDINATE WITH ELECTRICAL CONTRACTOR FOR INSTALLATION AND WIRING OF DISCONNECTING MEANS. ELECTRICAL TO INTERLOCK WITH LIGHTS. PROVIDE LIGHT SWITCH WITH TIME-DELAY RELAY. (4) ALTERNATE MANUFACTURERES: COOK, METALAIRE												
<b>ACCESSORIES:</b> (1) NEMA-3R DISCONNECT SWITCH PROVIDED WITH EQUIPMENT, WIRED BY EC												

SPLIT SYSTEM SCHEDULE				
INDOOR UNIT	TAG	FCU-1-1	FCU-2-1	FCU-IT-MAIN & BACKUP
	MANUFACTURER	TRANE	TRANE	MITSUBISHI
	MODEL	TEM8A0C48V41+TDR	TEM8A0D60V51+TDR	PKA-A36AKA8
	TYPE	DX SPLIT HEAT PUMP	DX SPLIT HEAT PUMP	DX SPLIT COOLING ONLY
	SIZE	4 TON	5 TON	3 TON
	ORIENTATION	MULTIPOSITION	MULTIPOSITION	WALL MOUNT
	WEIGHT (LBS)	174	174	46
	SUPPLY FAN SECTION			
	DESIGN AIRFLOW (CFM)	1530	2010	830
	DESIGN OUTSIDE AIRFLOW (CFM)	210	220	-
	DESIGN ESP (IN WTR)	0.5	0.5	N/A
	MOTOR RATING (HP)	3/4	3/4	74 WATTS
	FLA (AMPS)	5.7	5.7	0.6
	COOLING SECTION			
	AMBIENT (°F)	95	95	95
	MIXED AIR (EAT) DESIGN CONDITIONS DB/WB (°F)	80 / 67	80 / 67	80 / 67
COOL CAPACITY (AHRI TOTAL MBH)	48.00	58.50	33.40	
HEAT PUMP HEATING				
AMBIENT (°F)	17	17	N/A	
CAPACITY (MBH)	31.4	37.8	N/A	
HSPF2 (AHRI 210/240 - 2023)	9.00	8.70	N/A	
ELECTRICAL				
VOLTAGE/PH	208-230/60/1	208-230/60/1	POWERED BY OUTDOOR UNIT	
AUX. HEATER CAPACITY (208/240)	3.60 / 4.80	3.60 / 4.80	-	
AMPS	17.3 / 20.0	17.3 / 20.0	-	
MCA (AMPS) (208/230)	25.0 / 29.0	25.0 / 29.0	-	
MOCP (AMPS) (208/230)	25 / 30	25 / 30	-	
NOTES / ACCESSORIES	(1 - 7)	(1 - 7)	(1 - 6, & 8)	
OUTDOOR UNIT	TAG	CU-1-1	CU-2-1	CU-IT-MAIN & BACKUP
	MANUFACTURER	TRANE	TRANE	MITSUBISHI
	MODEL	4TWL9048A1	4TWL9060A1	PUY-AK36NL
	TYPE	HEAT PUMP	HEAT PUMP	COOLING ONLY HEAT PUMP
	SIZE	4.0 TON	5.0 TON	3.0 TON
	WEIGHT (LBS)	245	245	224
	COMPRESSOR INFORMATION			
	NO./TYPE	1 / SCROLL	1 / TWIN ROTARY	1 / TWIN ROTARY
	REFRIGERANT	R-410A	R-410A	R-454B
	STAGES	VARIABLE	VARIABLE	VARIABLE
	EFFICIENCY (AHRI 210/243)			
	AMBIENT DB	105.0	105.0	105.0
	EER2/SEER2 (AHRI 210/240 - 2023)	12.0 / 19.0	11.0 / 19.0	12.0 / 20.3
	ELECTRICAL			
	VOLTAGE/PH	208-230/60/1	208-230/60/1	208-230/60/1
	MCA	31.8	36.1	34.0
MOCP	35	40	56	
NOTES / ACCESSORIES	(9 - 11)	(9 - 11)	(9 - 11)	
NOTES / ACCESSORIES:				
(1) NEMA 1 DISCONNECT PROVIDED AND INSTALLED BY ELECTRICAL CONTRACTOR				
(2) MANUFACTURER WIRED CONTROLS				
(3) AUXILIARY DRAIN PAN WITH FLOAT SWITCH W/ AUTOMATIC SHUT DOWN UPON DETECTION OF WATER				
(4) FILTER RACK AND FILTER				
(5) MANUFACTURER'S 7-DAY PROGRAMMABLE THERMOSTAT				
(6) COORDINATE DISCONNECT SIZE AND REQUIREMENTS WITH ELECTRICAL CONTRACTOR. ELECTRICAL CONTRACTOR TO PROVIDE AND INSTALL.				
(7) PROVIDE AND INSTALL LITTLE GIANT MODEL #553201, 1/18 HP MOTOR, 115V/1PH WITH CORDED PLUG. MINIMUM PERFORMANCE 1.7 GPM AT 20-FT OF HEAD.				
(8) PROVIDE AND INSTALL MANUFACTURER'S PREFERRED CONDENSATE PUMP BLUEDIAMOND #MAXIBLUE				
(9) PROVIDE LOCKING REFRIGERANT PORT CAPS				
(10) HAIL GUARDS, ANTI-SHORT CYCLE TIMER, HIGH PRESSURE SWITCH				
(11) DEFROST CONTROL				

OA SCHEDULE							
Outside air shall be provided in accordance with ASHRAE Standard 62.1-2022 as follows:							
	Rp	Pz	Ra	Az			
BREAK	5	25	0.12	1,000			
CORRIDOR	-	-	0.06	1,000			
EXHAUSTED	-	-	-	-			
OFFICE SPACE	5	5	0.06	1,000			
STORAGE	5	2	0.06	1,000			
Vbz	=	RpPz + RaAz					
Ez	=	0.8					
Voz	=	Vba / Ez					
Room	Qty.	Rp (CFM/P)	Pz (People)	Ra (CFM/SF)	Az (SF)	Vbz (CFM)	Voz (CFM)
FCU-1-1							
120 ENTRY	1	5	2	0.06	261	25.7	32.1
121 OPEN WORKSPACE	1	5	5	0.06	340	45.4	56.8
122 HALL	1	0	0	0.06	71	4.3	5.3
123 OFFICE 2	1	5	1	0.06	87	10.2	12.8
124 OFFICE 1	1	5	1	0.06	87	10.2	12.8
125 CONFERENCE*	1	5	10	0.06	196	36.8	46.0
126 UTILITY	1	0	0	0.00	20	0.0	0.0
127 MECH	1	0	0	0.00	14	0.0	0.0
128 WORKROOM*	1	5	2	0.06	223	18.4	23.0
129 BREAKROOM	1	5	1	0.06	115	11.9	14.9
129 BREAKROOM (EXIT)	1	0	0	0.06	46	2.8	3.4
130 WOMENS RESTROOM	1	0	0	0.00	46	0.0	0.0
131 MENS RESTROOM	1	0	0	0.00	54	0.0	0.0
Total			22.0		1,560.0		207.0
					PROVIDED	210.0	
FCU-2-1							
200 OPEN SPACE	1	5	3	0.06	152	24.1	30.2
201 HALL	1	0	0	0.06	653	39.2	49.0
202 BREAKROOM*	1	5	1	0.06	61	6.2	7.7
203 WOMENS RESTROOM	1	0	0	0.00	50	0.0	0.0
204 MENS RESTROOM	1	0	0	0.00	64	0.0	0.0
206 ELEV & MECH RM	1	0	0	0.00	41	0.0	0.0
207 STORAGE	1	0	0	0.06	38	2.3	2.8
208 FLEX OFFICE	1	5	1	0.06	70	9.2	11.5
209 LAB	1	10	1	0.18	140	35.2	44.0
211 OFFICE	1	5	1	0.06	57	8.4	10.5
212 OFFICE	1	5	1	0.06	64	8.8	11.1
213 GREGS OFFICE*	1	5	2	0.06	102	11.1	13.9
214 MEETING ROOM*	1	5	9	0.06	136	30.7	38.3
Total			19.0		1,628.0		219.0
					PROVIDED	220.0	
*Intermittent occupancy reduced 50%							
					TOTAL OA REQUIRED	425.9	
					TOTAL OA PROVIDED	430.0	



127 E JACKSON ST. BURNET TX 78611

BURNET COUNTY ANNEX


#	DATE	ISSUE
1	08/21/2025	Issued

Project Number: 33-1408  
© 2024 LEVY DYKEMA  
MECHANICAL SCHEDULES


M003



Autodesk Docs/33-1408 Burnet County Annex/Burnet County, M&P, 3/16/24.rvt

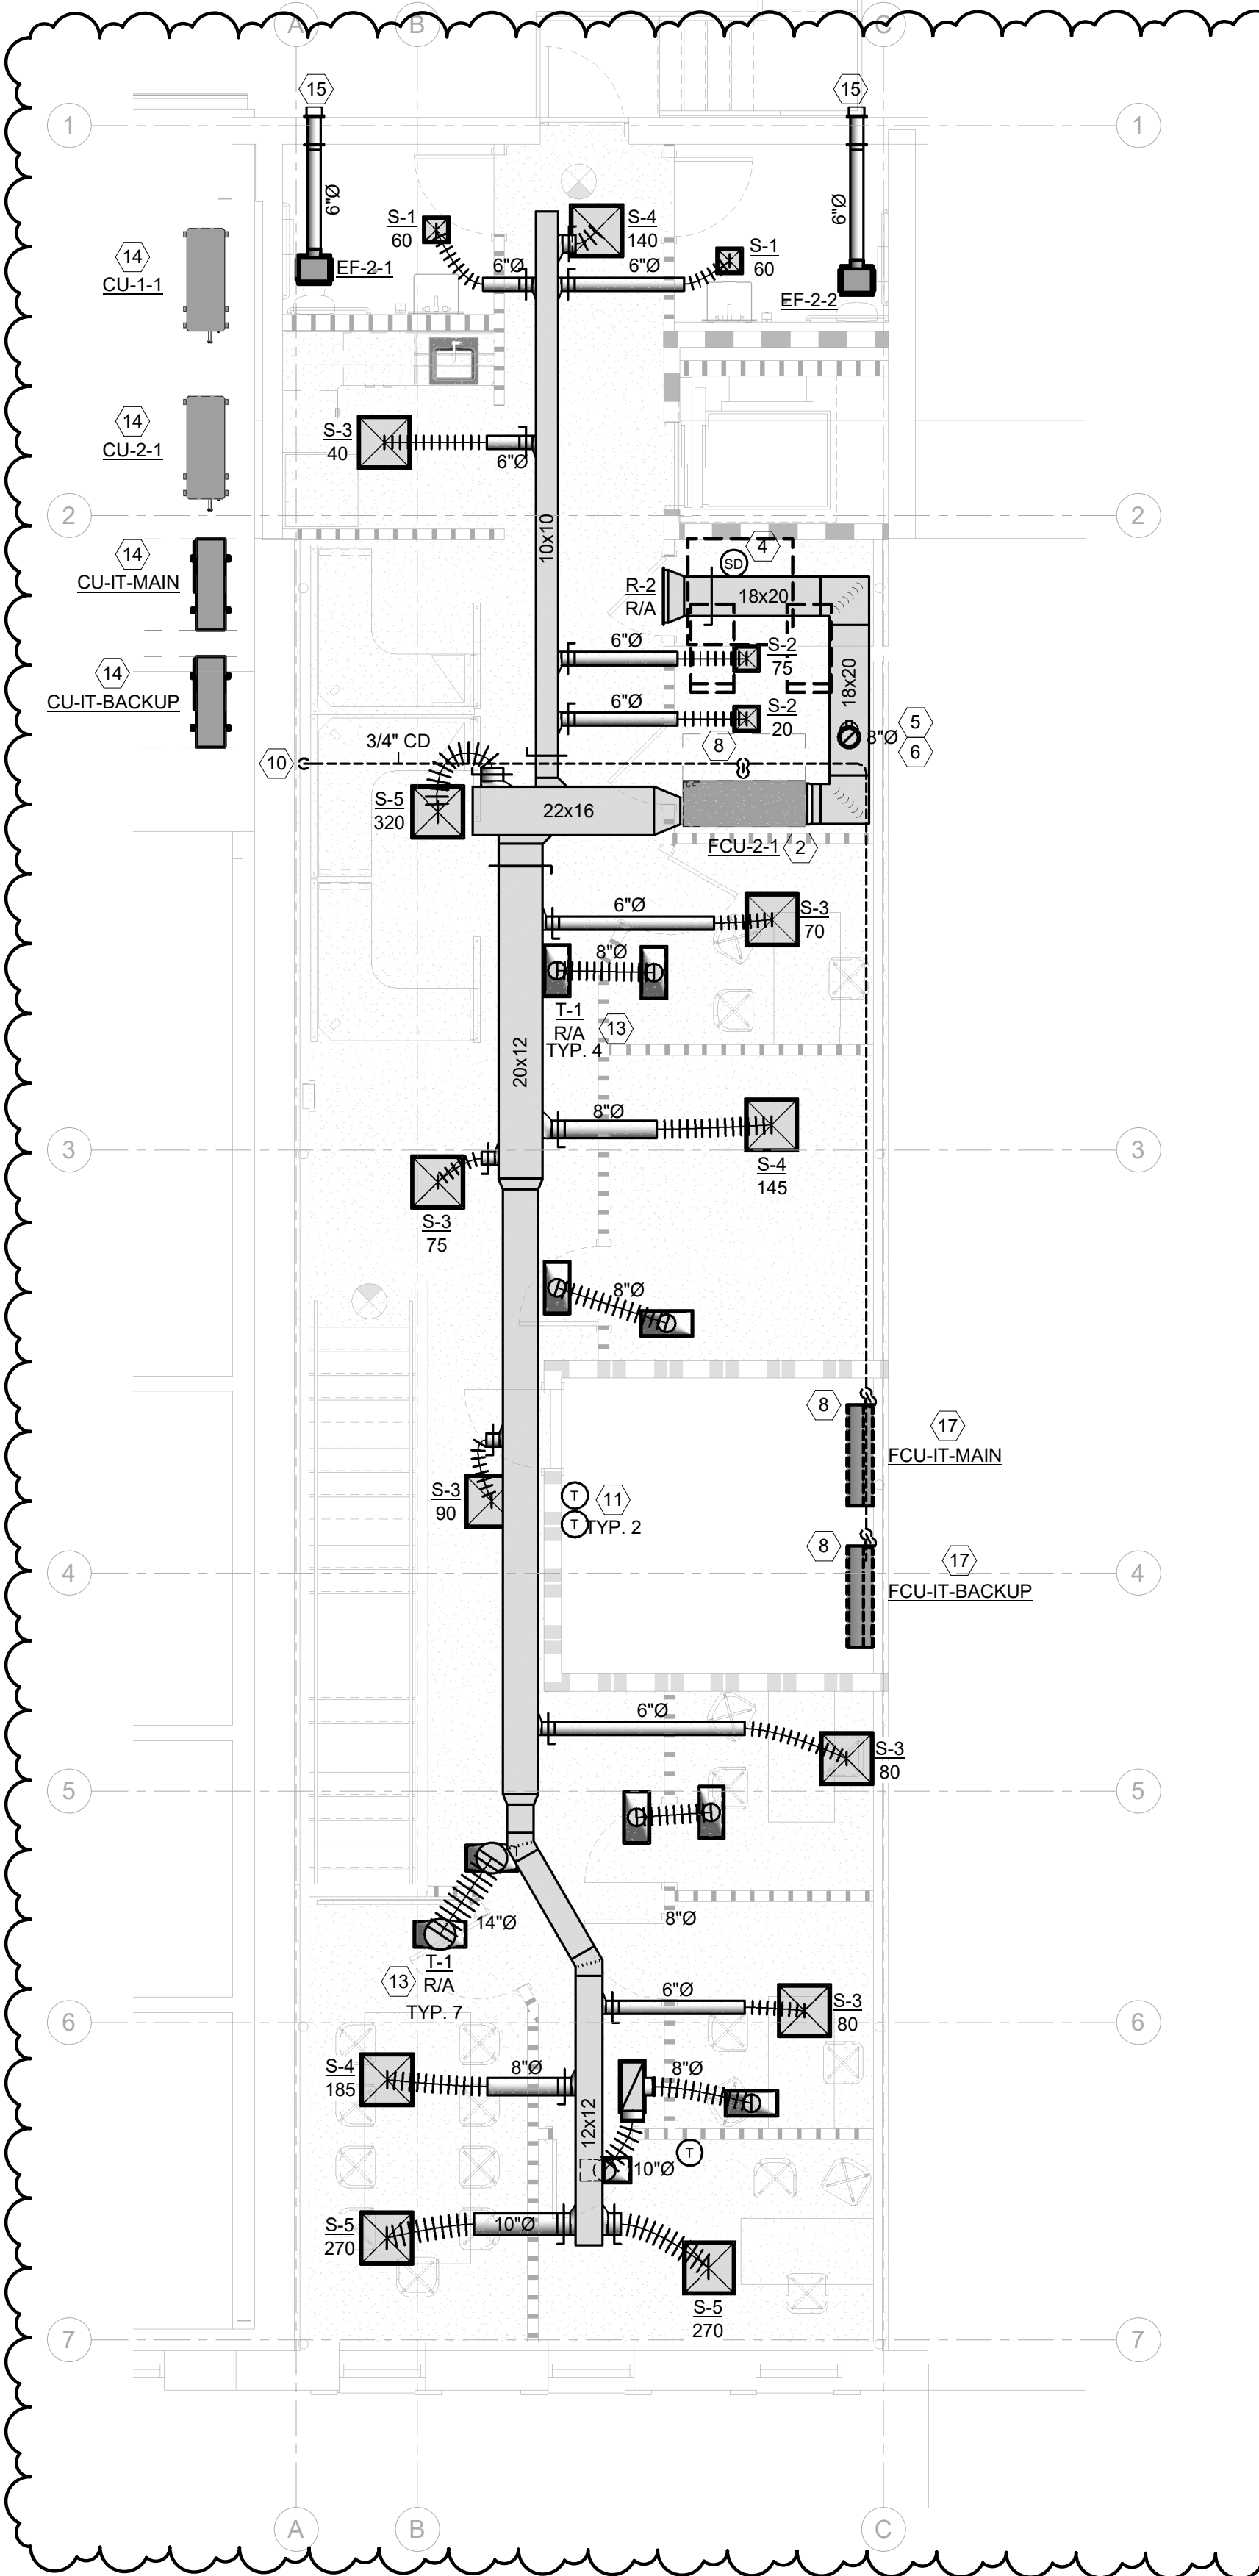

2 MECHANICAL HVAC PLAN-SECOND FLOOR  
M201 3/16" = 1'-0"

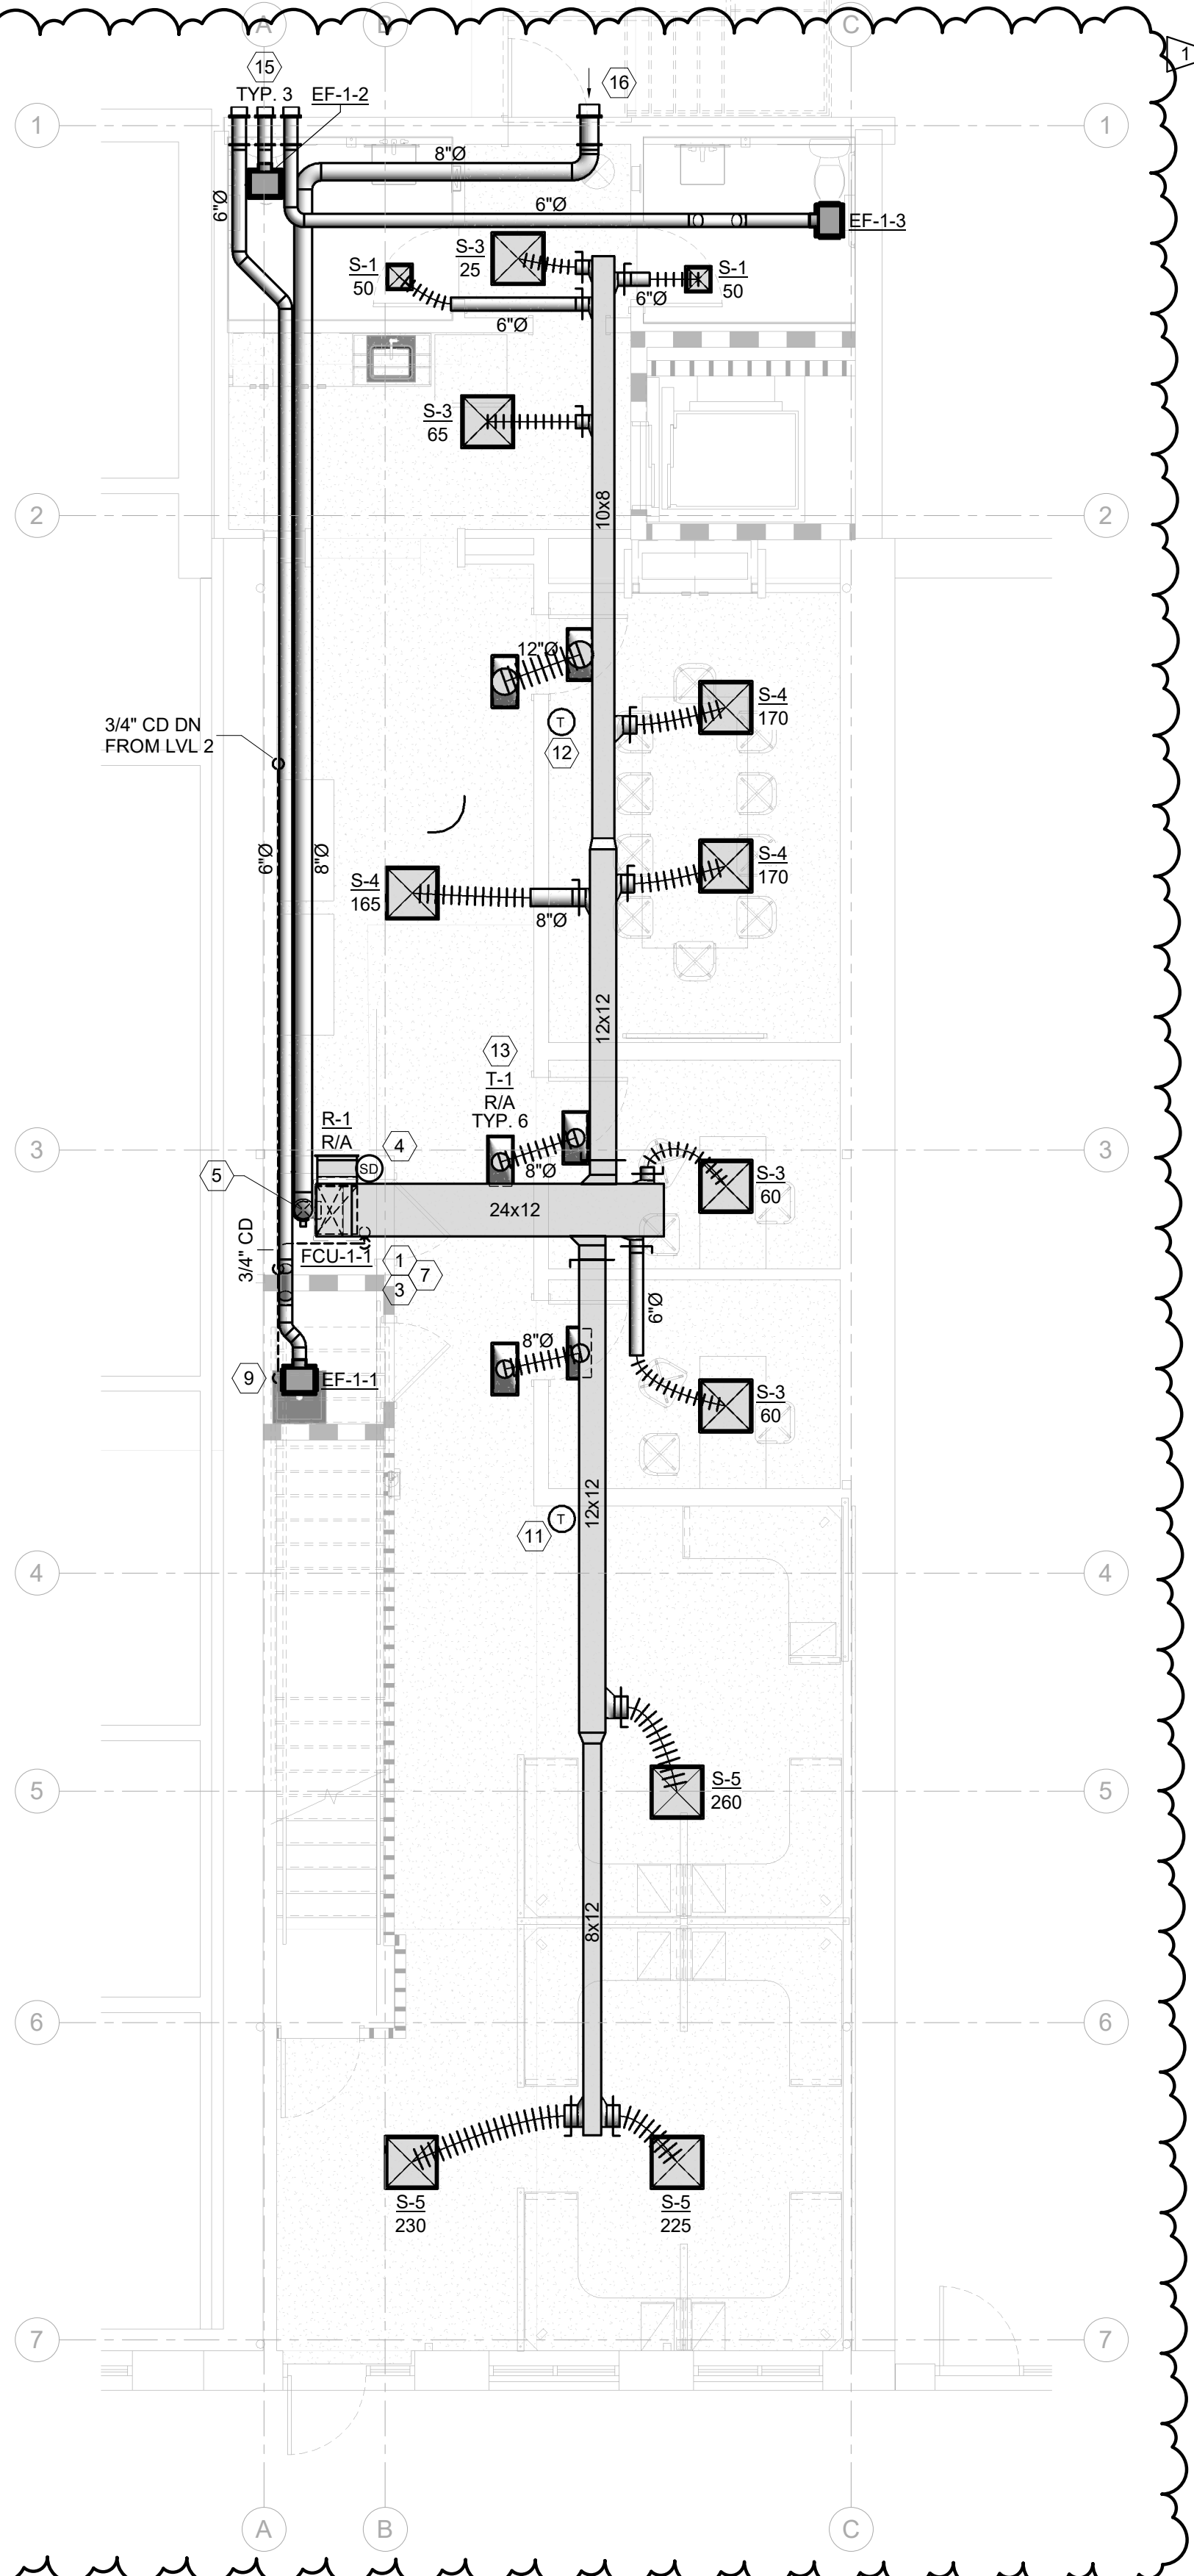

1 MECHANICAL HVAC PLAN-FIRST FLOOR  
M201 3/16" = 1'-0"

#### FLEXIBLE DUCT SIZE TABLE

AIRFLOW (CFM)	FLEXIBLE DUCT SIZE
0 - 100	6" RND
101 - 225	8" RND
226 - 400	10" RND
401 - 650	12" RND
651 - 925	14" RND

**NOTES:**  
FLEXIBLE DUCTWORK EQUIVALENT TO FLEXMASTER 6M

#### GENERAL NOTES

- REFER TO MECHANICAL COVER SHEET DRAWING FOR SYMBOLS, ABBREVIATIONS, SPECIFICATIONS, AND ADDITIONAL INFORMATION.
- DUE TO DRAWING SCALE, IT IS NOT POSSIBLE TO INDICATE ALL OFFSETS, FITTINGS, AND ACCESSORIES WHICH MAY BE REQUIRED. THE CONTRACTOR SHALL EXAMINE FIELD CONDITIONS AND FURNISH THE NECESSARY FITTINGS WHICH MAY BE REQUIRED TO COMPLETE THE INSTALLATION.
- FINAL LOCATION OF ALL NEW EQUIPMENT, PRIOR TO EQUIPMENT INSTALLATION, SHALL BE APPROVED BY BUILDING OWNER AND PROJECT MECHANICAL ENGINEER IF LOCATION DIFFERS FROM CONSTRUCTION DOCUMENTS.
- MAINTAIN CODE REQUIRED AND MANUFACTURER'S RECOMMENDED CLEARANCES FOR ALL NEW EQUIPMENT.
- MECHANICAL CONTRACTOR SHALL BE RESPONSIBLE FOR COORDINATING ALL FINAL AIR DEVICE/LOUVER COLORS TO MATCH ARCHITECTURAL CEILING FINISHES.
- COORDINATE INSTALLATION OF ALL EQUIPMENT, DUCTWORK, AIR DEVICES, AND ACCESSORIES WITH ALL OTHER TRADES SO AS TO AVOID INSTALLATION CONFLICTS.
- DUCTWORK SHALL BE KEPT TIGHT TO STRUCTURE, WHERE APPLICABLE, RUN BRANCH DUCTWORK WITHIN ROOF TRUSSES, COORDINATE WITH NEW PLUMBING, ELECTRICAL AND FIRE UTILITIES TO AVOID CONFLICTS.

#### # SHEET WORK NOTES

- PROVIDE AND INSTALL FAN COIL UNIT (FCU) VERTICALLY WITH RETURN AIR PLENUM/SUPPORT BELOW AIR HANDLER IN SECONDARY CONTAINMENT PAN. FIELD COORDINATE FINAL INSTALLATION LOCATION AND ORIENTATION WITH ALL OTHER TRADES. REFER TO VERTICAL AIR HANDLER UNIT DETAIL FOR ADDITIONAL INFORMATION.
- PROVIDE AND INSTALL FAN COIL UNIT (FCU) HORIZONTALLY IN SECONDARY CONTAINMENT PAN. FIELD COORDINATE FINAL INSTALLATION LOCATION AND HEIGHT WITH OTHER TRADES. REFER TO HORIZONTAL AIR HANDLER UNIT DETAIL FOR ADDITIONAL INFORMATION.
- PROVIDE P-TRAP AT EQUIPMENT CONNECTION PER DETAILS AND PROVIDE INTEGRAL FLOAT SWITCH IN CONDENSATE DRAIN PAN. INTEGRAL FLOAT SWITCH TO AUTOMATICALLY SHUT OFF FAN COIL UNIT (FCU) UPON DETECTION OF WATER.
- PROVIDE AND INSTALL DEDICATED SMOKE DETECTOR AS REQUIRED BY CODE AND LOCAL AHJ. IN THE RETURN DUCT OF UNITS 2,000 CFM OR GREATER OR WHERE COMBINED CFM OF SHARED RETURN CFM EXCEEDS 2,000 CFM. DETECTORS SHALL BE CONNECTED TO THE ALARM SYSTEM TO GENERATE SUPERVISORY NOTIFICATION. UPON DETECTION, UNIT SHALL SHUT DOWN AUTOMATICALLY AND ALARM. COORDINATE WITH FIRE ALARM CONTRACTOR.
- PROVIDE MOTORIZED BACKDRAFT DAMPER. UPON UNIT FAN, ENERGIZING, DAMPER SHALL OPEN AND PROVIDE CODE MINIMUM OA PER SCHEDULE. OUTSIDE AIR DUCT TO CONNECT TO FAN COIL UNIT (FCU) RETURN AIR PLENUM, DOWNSTREAM OF RETURN AIR BALANCING DAMPER.
- ROUTE 8"Ø OUTSIDE AIR DUCT UP TO ROOF. TERMINATE AT ROOF WITH ROOF CAP EQUAL TO LUXURY METAL #5JV826. COORDINATE WITH ROOFING CONTRACTOR FOR INSTALLATION AND FLASHING SO AS NOT TO VOID ROOF WARRANTY. TRANSITION AS REQUIRED TO DUCT CONNECTION SIZE AT OUTSIDE AIR INTAKE. REFER TO M301 FOR CONTINUATION.
- ROUTE 3/4" CONDENSATE DRAIN PIPE FROM FAN COIL UNIT (FCU) TO MOP SINK AS SHOWN. REFER TO MANUFACTURER'S AHU INSTALLATION REQUIREMENTS. ALL PIPING SHALL BE INSULATED AND SLOPED AT MINIMUM 1/8"/FT. TERMINATE INSULATED CONDENSATE DRAIN PIPING WITH INDIRECT CONNECTION. COORDINATE WITH PLUMBING CONTRACTOR FOR FINAL TERMINATION.
- ROUTE PUMPED CONDENSATE DRAIN PIPE FROM FAN COIL UNIT (FCU) DRAIN CONNECTION TIGHT TO STRUCTURE AND CONTINUE TO GRAVITY HEADER (REFER TO DETAILS). ROUTE CONDENSATE DRAIN AS HIGH AS POSSIBLE TO ACCOMMODATE FALL TO DISCHARGE LOCATION. REFER TO FCU MANUFACTURER'S INSTALLATION REQUIREMENTS. ALL PIPING SHALL BE INSULATED AND SLOPED AT MINIMUM 1/8"/FT.
- 3/4" INSULATED CONDENSATE DRAIN SHALL TERMINATE AT MOP SINK RIM WITH 1" AIR GAP. COORDINATE WITH PLUMBING CONTRACTOR FOR FINAL TERMINATION.
- ROUTE 3/4" INSULATED CONDENSATE DOWN FROM LEVEL 2 TO LEVEL 1, AND TIE INTO 3/4" INSULATED CONDENSATE FROM FCU-1-1.
- PROVIDE AND INSTALL THERMOSTAT WITH REMOTE SENSOR 54" A.F.F. COORDINATE WITH ELECTRICAL CONTRACTOR TO PROVIDE EMPTY J-BOX AND CONDUIT FOR THERMOSTAT LOCATION. UTILIZE TEMPERATURE AVERAGING FOR FCU-1-1 UNIT CONTROL.
- PROVIDE AND INSTALL THERMOSTAT WITH REMOTE SENSOR 54" A.F.F. COORDINATE WITH ELECTRICAL CONTRACTOR TO PROVIDE EMPTY J-BOX AND CONDUIT FOR THERMOSTAT LOCATION.
- PROVIDE AND INSTALL AIR TRANSFER DUCT/DEVICES PER SCHEDULES AND DETAILS. REFER TO DETAILS AND SCHEDULES FOR ADDITIONAL INFORMATION.
- PROVIDE AND INSTALL CONDENSING UNIT ON WALL OF ANNEX, ACCESSIBLE FROM ADJACENT ROOF STRUCTURE. COORDINATE WITH MANUFACTURER TO PROVIDE WALL MOUNTING BRACE FOR CONDENSING UNITS. ROUTE REFRIGERANT PIPING THROUGH WATERTIGHT PENETRATION TO SERVE FAN COIL UNIT INDOORS. ALL INSULATED REFRIGERANT PIPING EXPOSED TO THE ELEMENTS SHALL BE PROVIDED WITH ALUMINUM METAL JACKET FOR PROTECTION.
- TERMINATE EXHAUST AT EXTERIOR WALL WITH MANUFACTURER'S WALL CAP. MAINTAIN CODE REQUIRED MINIMUM 10-FT CLEARANCE TO ALL OUTSIDE AIR INTAKES. TYPICAL.
- PROVIDE AND INSTALL 8"Ø OUTSIDE AIR INTAKE EQUAL TO BROAN 643FA WITH INSECT SCREEN ON INTAKE. ROUTE 8" ROUND OUTSIDE AIR DUCT TIGHT TO STRUCTURE TO RETURN OF FAN COIL UNIT.
- INSTALL FAN COIL UNIT (FCU) ON WALL AT APPROX. 9'-0" A.F.F. PER MANUFACTURER'S INSTALLATION INSTRUCTIONS.




Autodesk Docs://33-1408 Burnet County Annex/Burnet County\_Mepl\_R022.rvt

1  
M301

MECHANICAL ROOF PLAN

1/8" = 1'-0"

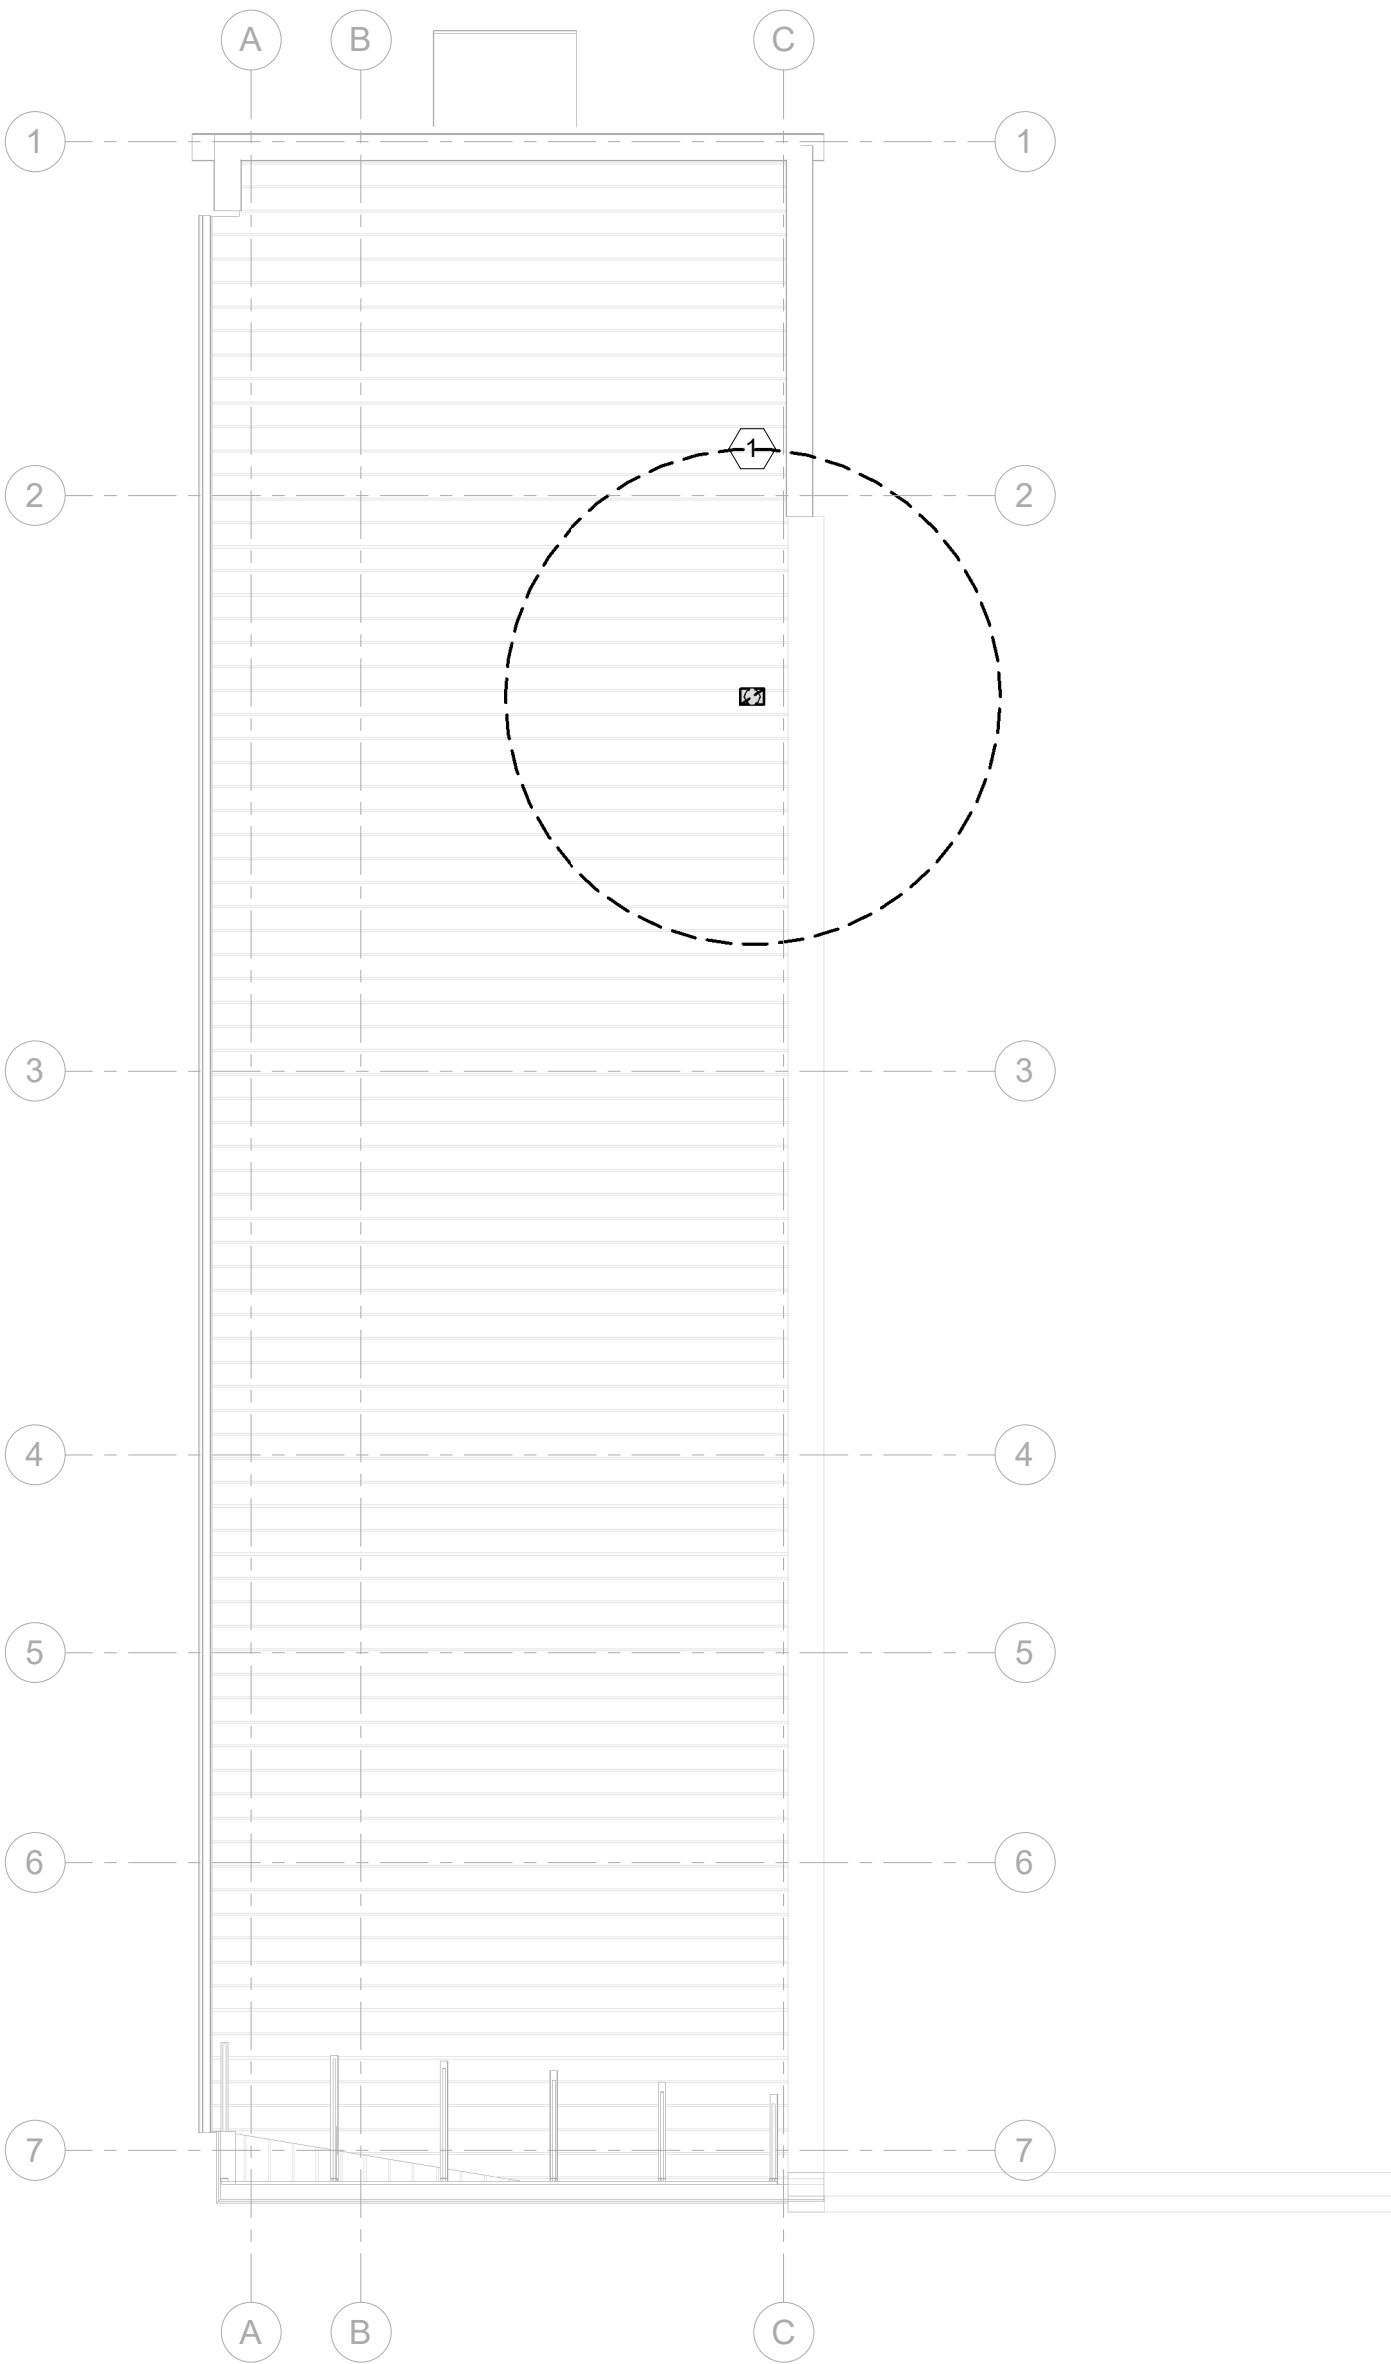


GENERAL NOTES

- A. REFER TO MECHANICAL COVER SHEET DRAWING FOR SYMBOLS, ABBREVIATIONS, SPECIFICATIONS, AND ADDITIONAL INFORMATION.
- B. DUE TO DRAWING SCALE, IT IS NOT POSSIBLE TO INDICATE ALL OFFSETS, FITTINGS, AND ACCESSORIES WHICH MAY BE REQUIRED. THE CONTRACTOR SHALL EXAMINE FIELD CONDITIONS AND FURNISH THE NECESSARY FITTINGS WHICH MAY BE REQUIRED TO COMPLETE THE INSTALLATION.
- C. FINAL LOCATION OF ALL NEW EQUIPMENT, PRIOR TO EQUIPMENT INSTALLATION, SHALL BE APPROVED BY BUILDING OWNER AND PROJECT MECHANICAL ENGINEER IF LOCATION DIFFERS FROM CONSTRUCTION DOCUMENTS.
- D. MAINTAIN CODE REQUIRED AND MANUFACTURER'S RECOMMENDED CLEARANCES FOR ALL NEW EQUIPMENT.
- E. MECHANICAL CONTRACTOR SHALL BE RESPONSIBLE FOR COORDINATING ALL FINAL AIR DEVICE/LOUVER COLORS TO MATCH ARCHITECTURAL CEILING FINISHES.
- F. COORDINATE INSTALLATION OF ALL EQUIPMENT, DUCTWORK, AIR DEVICES, AND ACCESSORIES WITH ALL OTHER TRADES SO AS TO AVOID INSTALLATION CONFLICTS.
- G. DUCTWORK SHALL BE KEPT TIGHT TO STRUCTURE. WHERE APPLICABLE, RUN BRANCH DUCTWORK WITHIN ROOF TRUSSES. COORDINATE WITH NEW PLUMBING, ELECTRICAL AND FIRE UTILITIES TO AVOID CONFLICTS.

# SHEET WORK NOTES

1. PROVIDE AND INSTALL ROOF CAP EQUAL TO LUXURY METAL #SJV826. COORDINATE WITH ROOFING CONTRACTOR FOR INSTALLATION AND FLASHING SO AS NOT TO VOID ROOF WARRANTY. ROOF CAP TO BE LOCATED 10'-0" OR GREATER FROM ANY EXHAUST OUTLET AND PLUMBING VENT.

LEVY  
DYKEMA  
100 CONGRESS AVENUE  
SUITE 200  
AUSTIN, TX 78701  
WWW.LEVYDYKEMA.COM

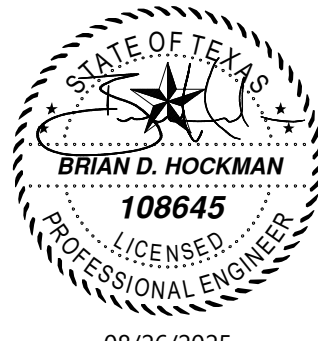


08/26/2025

127 E JACKSON ST. BURNET TX 78611

BURNET COUNTY ANNEX

#	DATE	ISSUE
1	08/21/2025	Addendum 1

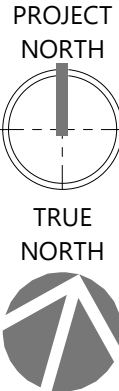

Project Number: 33-1408

© 2024 LEVY DYKEMA

MECHANICAL ROOF  
PLAN

1  
M301




Autodesk Docs/231-1408 Burnet County Annex/Burnet County\_M09p\_002.rvt

PLUMBING LEGEND AND SYMBOLS				GENERAL NOTES		PLUMBING GENERAL NOTES		2015 IECC ENERGY CODE COMPLIANCE	
SYMBOL	DESCRIPTION	SYMBOL	DESCRIPTION	<div>1. FURNISH AND INSTALL ALL ITEMS NECESSARY TO PROVIDE FULLY FUNCTIONING SYSTEMS AS INDICATED BY THE DESIGN AND THE EQUIPMENT SPECIFIED. ELEMENTS OF THE WORK SHALL INCLUDE, BUT ARE NOT LIMITED TO, MATERIALS, LABOR, SUPERVISION, SUPPLIES, EQUIPMENT, TRANSPORTATION, HOISTING/RIGGING, STORAGE, UTILITIES, AND ALL REQUIRED PERMITS AND LICENSES.</div> <div>2. DRAWINGS ARE SCHEMATIC IN NATURE AND DO NOT REFLECT ALL WORK AND MATERIALS REQUIRED TO COMPLETE PROJECT. CONTRACTOR SHALL PROVIDE ALL MATERIALS, LABOR AND EQUIPMENT AS REQUIRED TO COMPLETE PROJECT WITHIN DESIGN. CONTRACTOR SHALL REQUEST ADDITIONAL INFORMATION AND DETAILS WHERE SCOPE IS UNCLEAR.</div> <div>3. ALL WORK SHALL COMPLY WITH THE MOST RECENT ADOPTED VERSION OF ALL APPLICABLE LAWS, RULES, REGULATIONS AND ORDINANCES OF ALL FEDERAL, STATE AND LOCAL AUTHORITIES. IF CONFLICT BETWEEN THE CONTRACT DOCUMENTS AND THE LOCAL ENFORCING AUTHORITY EXISTS, THE LOCAL ENFORCING AUTHORITY SHALL APPLY. ANY MODIFICATIONS TO THE DESIGN SHALL BE MADE WITHOUT ADDITIONAL COST TO THE OWNER OR ARCHITECT/ENGINEER. THE CONTRACTOR SHALL REPORT TO THE ARCHITECT/ENGINEER AND SECURE HIS APPROVAL BEFORE PROCEEDING WITH ANY MODIFICATIONS.</div> <div>4. WHERE THE REQUIREMENTS OF THE CONTRACT DOCUMENTS EXCEED THE REQUIREMENTS OF THE CODES, THE CONTRACT DOCUMENTS SHALL TAKE PRECEDENCE PROVIDED THAT THEY ARE NOT IN CONFLICT WITH THE CODES.</div> <div>5. BEFORE SUBMITTING BIDS, EACH CONTRACTOR SHALL PERFORM A SITE VISIT AND UNDERSTAND THE CONDITIONS TO BE MET IN INSTALLING THE WORK, AND SHALL MAKE PROVISIONS FOR THE CONDITIONS IN HIS FINAL BID. FAILURE ON THE PART OF THE CONTRACTOR TO COMPLY WITH THIS REQUIREMENT SHALL NOT BE CONSIDERED JUSTIFICATION FOR THE OMISSION OR FAULTY INSTALLATION OF ANY WORK COVERED BY THE CONTRACT DOCUMENTS.</div> <div>6. MISUNDERSTANDING OF THE SCOPE OR AMOUNT OF WORK TO BE PERFORMED SHALL BE THE RESPONSIBILITY OF THE CONTRACTOR, AND SHALL NOT RESULT IN ANY ADDITIONAL COST TO THE OWNER. TENDER OF A PROPOSAL CONVEYS FULL CONTRACTOR AGREEMENT OF THE ITEMS AND CONDITIONS SPECIFIED AND/OR INDICATED, SCHEDULED, OR IMPLIED ON THE CONTRACT DOCUMENTS, AND/OR REQUIRED BY THE NATURE OF THIS WORK.</div> <div>7. ALL WORK SHALL BE CARRIED OUT IN A NEAT, WELL ORGANIZED MANNER. ALL SERVICES SHALL BE ROUTED PARALLEL AND PERPENDICULAR TO THE PRIMARY LINES OF THE BUILDING. LOCATE ALL EQUIPMENT TO PROVIDE ACCESS AND ARRANGE ALL WORK WITH ADEQUATE ACCESS FOR OPERATION AND MAINTENANCE, AND TO MAINTAIN PROPER CODE AND MANUFACTURER'S CLEARANCES.</div> <div>8. ALL EQUIPMENT AND MATERIAL TO BE FURNISHED AND INSTALLED ON THIS PROJECT SHALL BE UL OR ETL LISTED, IN ACCORDANCE WITH THE AUTHORITY HAVING JURISDICTION, AND SUITABLE FOR ITS INTENDED USE ON THIS PROJECT.</div> <div>9. THE CONTRACTOR SHALL PROVIDE SUBMITTALS FOR ALL NEW EQUIPMENT, CONTROLS, AND FIXTURES TO BE PROVIDED AND INSTALLED.</div> <div>10. THE FOLLOWING SUBMITTAL DATA SHALL BE FURNISHED AND SHALL INCLUDE BUT NOT BE LIMITED TO:<div>A. EQUIPMENT AND MATERIALS SHOP DRAWINGS</div><div>B. COORDINATION DRAWINGS</div><div>C. RECORD DRAWINGS</div><div>D. OPERATING AND MAINTENANCE MANUALS</div><div>E. FIRE STOP MATERIALS AND DETAILS</div></div> <div>11. THE GENERAL CONTRACTOR AND ALL SUBCONTRACTORS SHALL COORDINATE THE INSTALLATION OF DUCTWORK, PIPING, CONDUIT, CABLE, ETC., WITH LIGHTING FIXTURES, SPECIAL CEILING CONSTRUCTION, AIR DISTRIBUTION EQUIPMENT, AND THE STRUCTURE. PROVIDE ADDITIONAL RISES AND OFFSETS AS REQUIRED. IF, AFTER INSTALLED, NEW DUCTWORK, PIPING, CONDUIT, CABLE, ETC., IS FOUND TO BE IN CONFLICT WITH THE ARCHITECTURE, STRUCTURE OR OTHER TRADE WORK, WHICH IS EITHER EXISTING OR SHOWN ON THE CONTRACT DOCUMENTS, THE DUCTWORK, PIPING, CONDUIT, CABLE, ETC., SHALL BE RELOCATED WITHOUT ADDITIONAL COST TO THE OWNER/TENANT. COORDINATE ALL WORK WITH ALL OTHER TRADES PRIOR TO INSTALLATION.</div> <div>12. MATERIALS AND EQUIPMENT SHALL BE NEW AND IN GOOD CONDITION. THE COMMERCIALLY STANDARD ITEMS OF EQUIPMENT AND THE SPECIFIC NAMES INDICATED ARE INTENDED TO IDENTIFY STANDARDS OF QUALITY AND PERFORMANCE NECESSARY FOR THE PROPER FUNCTIONING OF THE WORK. MATERIALS AND EQUIPMENT WHICH ARE FOUND TO HAVE FACTORY DEFECTS SHALL BE REPLACED OR REPAIRED IN A MANNER ACCEPTABLE TO THE OWNER/TENANT AND ENGINEER AT NO ADDITIONAL COST TO THE OWNER/TENANT.</div> <div>13. DAMAGE CAUSED DURING CONSTRUCTION TO EXISTING MATERIALS/EQUIPMENT WILL BE REPAIRED OR REPLACED AT NO ADDITIONAL COST TO OWNER. RE-SUPPORT ANY REMAINING PIPING OR DEVICES THAT WERE SUPPORTED BY WALLS BEING REMOVED.</div> <div>14. THE WARRANTY PERIOD SHALL BE NO LESS THAN ONE (1) FULL YEAR, UNLESS SPECIFIED OTHERWISE AND SHALL INCLUDE AT LEAST ONE (1) FULL HEATING SEASON AND ONE (1) FULL COOLING SEASON. DURING THE WARRANTY PERIOD THE CONTRACTOR SHALL GUARANTEE THE FOLLOWING IN A FORM SATISFACTORY TO THE OWNERTENANT:<div>A. ALL WORK INSTALLED SHALL BE FREE FROM ANY AND ALL DEFECTS IN WORKMANSHIP AND/OR MATERIALS.</div><div>B. ALL APPARATUS WILL DEVELOP CAPACITIES AND PERFORMANCE CHARACTERISTICS SPECIFIED.</div><div>C. THE SYSTEMS SHALL OPERATE WITHOUT MALFUNCTION.</div></div> <div>15. THE START OF THE CONTRACTOR'S WARRANTY PERIOD SHALL COMMENCE ON THE DATE OF "SUBSTANTIAL COMPLETION" AS AGREED TO BY THE OWNER/TENANT.</div> <div>16. THIS BUILDING MAY HAVE A STRUCTURAL SYSTEM UTILIZING POST-TENSIONED CABLES. THE CONTRACTOR SHALL DETERMINE THE EXISTING STRUCTURAL SYSTEM PRIOR TO CUTTING, DRILLING, OR CORING. THE CONTRACTOR SHALL X-RAY ALL PENETRATIONS PRIOR TO CUTTING THE FLOOR SLAB.</div> <div>17. THIS CONTRACTOR SHALL SECURE ALL PERMITS, LICENSES AND INSPECTIONS REQUIRED FOR HIS WORK, AND SHALL PAY ALL FEES IN CONNECTION WITH SUCH PERMITS, LICENSES AND INSPECTIONS.</div> <div>18. IN THE EVENT OF A CONFLICT BETWEEN DRAWINGS AND/OR SPECIFICATIONS, THE CONTRACTOR SHALL PROVIDE PRICING REFLECTING THE GREATEST COST. THE CONFLICT SHALL BE BROUGHT TO THE ATTENTION OF THE ENGINEER FOR CLARIFICATION.</div> <div>19. PENETRATIONS THROUGH FLOORS OR FIRE-RATED CONSTRUCTION SHALL BE FIRE RATED TO COMPLY WITH ASTM E-814 (UL 1479), AND THE LOCAL AUTHORITY HAVING JURISDICTION.</div> <div>20. UPON COMPLETION OF THE PROJECT, THE CONTRACTOR SHALL SUBMIT TO THE ENGINEER, A COMPLETE SET OF "AS BUILT" DRAWINGS PORTRAYING ACTUAL SITE CONDITIONS OF THE MECHANICAL, ELECTRICAL, PLUMBING AND FIRE PROTECTION WORK. SUBMISSION SHALL CONSIST OF ONE SET OF PAPER COPIES AND ONE SET OF CAD FILES IN AUTOCAD (CONTRACTOR SHALL UTILIZE OWNER'S LAYER STANDARDS IF EXISTING).</div> <div>21. IN THE EVENT THAT MATERIALS, PRODUCTS, AND/OR PROCESSES BEING PROPOSED FOR THIS PROJECT CONTAIN, OR MAY EMIT, ANY VOLATILE ORGANIC COMPOUNDS (VOC), FORMALDEHYDE FORMULATIONS, OR HAZARDOUS OUT-GASSING, AS DETERMINED BY THE MANUFACTURER, A MATERIALS SAFETY DATA SHEET SHALL BE SUBMITTED AS PART OF THE SHOP DRAWING PROCESS FOR REVIEW BY THE ARCHITECT/ENGINEER/OWNER.</div> <div>22. VERIFY LOCATIONS OF EXISTING VALVES LOCATED WITHIN SCOPE OF WORK. MODIFY EXISTING OR PROVIDE NEW MEANS OF ACCESS WHERE REQUIRED BECAUSE OF NEW CONSTRUCTION.</div> <div>23. PLUMBING EQUIPMENT SHALL BE IDENTIFIED BY MEANS OF NAMEPLATES PERMANENTLY ATTACHED TO THE EQUIPMENT. NAMEPLATES SHALL BE BLACK SURFACE, WHITE CORE LAMINATED WITH ENGRAVED LETTERS. PLATES SHALL BE A MINIMUM OF 3" LONG BY 1" WIDE WITH WHITE LETTERS 1/4" HIGH.</div> <div>24. THE CONTRACTOR SHALL TAKE NOTE THAT THE DRAWINGS ARE SCHEMATIC IN NATURE AND INDICATE THE APPROXIMATE LOCATIONS OF THE HVAC AND PLUMBING SYSTEMS. LOCATE ALL ITEMS IN THE FIELD. COORDINATE WITH OTHER TRADES TO ENSURE PROPER FIT AND ACCESS TO ALL ITEMS.</div> <div>25. AFTER COMPLETION OF INSTALLATION, BUT PRIOR TO SUBSTANTIAL COMPLETION, CONTRACTOR SHALL CERTIFY IN WRITING THAT PRODUCTS AND MATERIALS INSTALLED AND PROCESSES USED DO NOT CONTAIN ASBESTOS OR POLYCHLORINATED BIPHENYL (PCB).</div> <div>26. THE CONTRACTOR SHALL PROTECT THE WORK, EQUIPMENT, AND MATERIALS FROM DAMAGE BY HIS WORK OR HIS PERSONNEL, AND SHALL CORRECT ALL DAMAGE THUS CAUSED WITHOUT ADDITIONAL COST TO THE OWNER. THE CONTRACTOR SHALL BE RESPONSIBLE FOR ALL WORK, MATERIALS, AND EQUIPMENT UNTIL FINAL ACCEPTANCE BY THE OWNER. PROTECT ALL WORK AGAINST THEFT, INJURY, OR DAMAGE AND CAREFULLY STORE MATERIAL AND EQUIPMENT RECEIVED ON SITE WHICH IS NOT IMMEDIATELY INSTALLED. THE CONTRACTOR SHALL CLOSE OPEN ENDS OF WORK WITH TEMPORARY COVERS OR PLUGS DURING CONSTRUCTION TO PREVENT THE ENTRY OF DUST, DIRT, AND OBSTRUCTING MATERIAL. THE CONTRACTOR SHALL PROTECT ALL EQUIPMENT AND MATERIALS FROM DAMAGE DUE TO WATER, SPRAY-ON FIREPROOFING, CONSTRUCTION DEBRIS, ETC. IN A MANNER ACCEPTABLE TO THE ENGINEER AND/OR OWNER.</div>	<div>1. REFER TO THE ARCHITECTURAL PLANS AND DETAILS FOR EXACT LOCATIONS AND MOUNTING HEIGHTS OF ALL PLUMBING FIXTURES.</div> <div>2. REFER TO THE ARCHITECTURAL PLANS AND DETAILS FOR EXACT LOCATIONS OF ALL FLOOR DRAINS.</div> <div>3. ALL SANITARY AND VENT PIPING SHALL BE ROUTED AT A SLOPE OF NOT LESS THAN 1/4" PER FOOT, UNLESS OTHERWISE NOTED.</div> <div>4. THE PLUMBING CONTRACTOR SHALL COORDINATE EXACT ROUTING OF ALL PIPING WITH THE WORK OF ALL OTHER TRADES. PROVIDE OFFSETS IN PIPING WHERE REQUIRED BY COORDINATION OF TRADES.</div> <div>5. INSTALL ALL FLOOR DRAINS AND FLOOR SINKS SUCH THAT GRATING IS FLUSH WITH ADJACENT FLOORING SURFACE. FLOOR SHALL SLOPE TO DRAIN. COORDINATE ALL REQUIREMENTS WITH ARCHITECT AND GENERAL CONTRACTOR PRIOR TO INSTALLATION.</div> <div>6. THE PLUMBING CONTRACTOR SHALL CLEAN, FLUSH, AND DISINFECT ALL COLD WATER AND HOT WATER PIPING AND ALL FIXTURES PRIOR TO COMPLETION OF WORK.</div> <div>7. VENTS THROUGH ROOF TO BE LOCATED A MINIMUM OF 15'-0" HORIZONTALLY AWAY FROM OUTSIDE AIR INTAKES.</div> <div>8. FLOOR DRAINS NOT RECEIVING REGULAR-USE DRAINAGE ARE TO BE TRAP PRIMED.</div> <div>9. PROVIDE BACKFLOW PREVENTION AS REQUIRED BY THE LOCAL CROSS CONNECTION CONTROL DEPT. STANDARDS WHERE NOT PROVIDED OR INADEQUATELY PROVIDED BY EQUIPMENT MANUFACTURER.</div> <div>10. INSTALL PIPING AS HIGH AS POSSIBLE UNLESS OTHERWISE NOTED.</div> <div>11. VERIFY DIMENSIONS FROM ARCHITECTURAL DRAWINGS AND FROM ACTUAL MEASUREMENTS AT JOBSITE.</div> <div>12. PROVIDE SADDLES AND SHIELDS FOR SUPPORT OF INSULATED PIPING TO PREVENT CRUSHING.</div> <div>13. PIPING PENETRATIONS THROUGH PERIMETER BEAMS, FOUNDATION ON GRADE, AND STRUCTURAL FLOORS SHALL BE SLEEVED. COORDINATE SLEEVE LOCATIONS AND SIZES WITH STRUCTURAL PRIOR TO POUR.</div> <div>14. PROVIDE DIELECTRIC UNIONS AT DISSIMILAR MATERIALS.</div> <div>15. PROVIDE ESCUTCHEONS AT ALL FINISHED WALL AND CEILING PIPING PENETRATIONS.</div> <div>16. ALL PIPING SHALL BE IDENTIFIED AS TO TYPE OF USE, SERVICE, AND DIRECTION OF FLOW. LOCATE MARKERS AT EACH VALVE, AT ENTRIES TO WALLS, AND ON 20' CENTERS ON STRAIGHT RUNS OF PIPE. PROVIDE A FLOW ARROW AT EACH IDENTIFICATION MARKER. PIPE MARKERS SHALL BE SETON "SETMARK" OR EQUAL.</div> <div>17. COORDINATE WORK COMPLETELY WITH ALL OTHER TRADES.</div> <div>18. INSTALL PIPING FREE OF SAGS AND BENDS. PROVIDE NON-METALLIC COATED HANGERS WHERE IN DIRECT CONTACT WITH COPPER PIPING.</div> <div>19. PROVIDE ENGINEERED WATER HAMMER ARRESTERS SIZED AND PLACED IN ACCORDANCE WITH STANDARD PDI-WH 201. AIR CHAMBERS SHALL NOT BE ALLOWED.</div> <div>20. PROVIDE FLEXIBLE EXPANSION FITTINGS SUITABLE FOR SANITARY (DWV) AND RAINWATER PIPING WHERE PIPING ENTERS EXPANSIVE SOILS TO ALLOW FOR 4" OF DIFFERENTIAL MOVEMENT.</div> <div>21. ALL FLOOR PENETRATIONS MUST BE SEALED WITH FIRE CAULK.</div> <div>22. MAKE ALL NECESSARY EXCAVATIONS, CUTTING OF PAVING, CONCRETE, ETC., REMOVAL OF UNUSABLE SPOIL MATERIAL, ALL BACKFILLING WITH STABILIZED FILL, AND PERFORM TEMPORARY PATCH PAVING REPAIRS NECESSARY FOR PROPER EXECUTION OF THE WORK. BACKFILL SHALL BE MECHANICALLY COMPACTED TO A DENSITY OF 95% OF THE MAXIMUM DRY DENSITY AT OPTIMUM MOISTURE CONTENT AS DETERMINED BY THE STANDARD PROCTOR COMPACTION TEST.</div> <div>23. PROVIDE MINIMUM 1" AIR GAP AT DRAIN DISCHARGE FOR ALL INDIRECT WASTE PIPING.</div> <div>24. DISCHARGE PIPING FROM A DISHWASHER SHALL BE LOOPED UP AND SECURELY FASTENED TO THE UNDERSIDE OF THE COUNTER OR AN APPROVED DISHWASHER AIR-GAP FITTING IS REQUIRED.</div> <div>25. COMPRESSION TANKS SUPPLIED AT EACH WATER HEATER SHALL BE SECURED TO A WALL WITH (2) 1" x 14 GA. GALVANIZED STRAPS. PROVIDE LAG BOLTS AND BLOCKING AS REQUIRED.</div> <div>26. AN ATMOSPHERIC VACUUM BREAKER OR OTHER APPROVED BACKFLOW PREVENTION DEVICE MUST BE INSTALLED ON ALL THREADED HOSE BIBB, WALL HYDRANT, OR FAUCET CONNECTIONS LOCATED INSIDE OR OUTSIDE THE BUILDING.</div>	<div><b>REQUIREMENTS SPECIFIC TO WATER HEATING:</b><div>1. HEAT TRAPS SHALL BE PROVIDED ON NONCIRCULATING WATER HEATING SYSTEMS ON BOTH INLET AND OUTLET CONNECTIONS. HEAT TRAPS MAY BE PRE-FABRICATED OR FIELD-FABRICATED BY CREATING A LOOP OR INVERTED U-SHAPED ARRANGEMENT ON THE INLET AND OUTLET PIPES. REFER TO WATER HEATER DETAIL.</div><div>2. PIPE INSULATION FOR THE SPECIFIED NONCIRCULATING SERVICE HOT WATER SYSTEM IS REQUIRED FOR ALL PIPING IN THE FOLLOWING CATEGORIES:<div>a) THE FIRST 8' OF OUTLET PIPING FROM ANY CONSTANT-TEMPERATURE, NONCIRCULATING STORAGE SYSTEM.</div><div>b) THE INLET PIPING BETWEEN THE STORAGE TANK AND A HEAT TRAP IN A NONCIRCULATING STORAGE SYSTEM.</div></div><div>3. INSULATION SHALL COMPLY WITH PIPE INSULATION SPECIFICATIONS AS INDICATED ON THIS DRAWING PER TABLE C403.2.10 MINIMUM PIPE INSULATION THICKNESS.</div></div> <div><b>GENERIC PLUMBING REQUIREMENTS:</b><div>1. SERVICE WATER HEATING EQUIPMENT SHALL MEET MINIMUM FEDERAL EFFICIENCY REQUIREMENTS INCLUDED IN THE NATIONAL APPLIANCE ENERGY CONSERVATION ACT AND THE ENERGY POLICY ACT OF 1992, WHICH MEET OR EXCEED 2015 IECC AND ASHRAE 90.1 FOR ENERGY EFFICIENCY AND STANDBY LOSS.</div><div>2. WATER-HEATING EQUIPMENT SHALL BE PROVIDED WITH CONTROLS THAT ALLOW THE USER TO SET THE WATER TEMPERATURE TO 140°F.</div></div>			
PLUMBING ABBREVIATIONS							PLUMBING PIPING & MATERIALS		
<div>AB.C ABOVE CEILING</div> <div>AFF ABOVE FINISHED FLOOR</div> <div>AV ACID VENT</div> <div>AW ACID WASTE</div> <div>BFF BELOW FINISHED FLOOR</div> <div>BG BELOW GRADE</div> <div>CA COMPRESSED AIR</div> <div>CD CONDENSATE DRAIN</div> <div>C.I.N.H. CAST IRON NO HUB</div> <div>CO CLEANOUT</div> <div>CKV CHECK VALVE</div> <div>CW COLD WATER</div> <div>CON CONNECT TO EXISTING</div> <div>(A) PIPE DROP</div> <div>DN PIPE DROP TO NEXT LEVEL</div> <div>DTL DETAIL</div> <div>(E) EXISTING</div> <div>F FIRE SERVICE</div> <div>FCO FLOOR CLEANOUT</div> <div>FND FOUNDATION DRAIN</div> <div>GCO GRADE CLEANOUT</div> <div>HW HOT WATER</div> <div>HWC HOT WATER CIRCULATION</div> <div>IDW INDIRECT WASTE</div> <div>I.E. INVERT ELEVATION</div> <div>IRR IRRIGATION</div> <div>LPG LIQUEFIED PETROLEUM GAS</div> <div>LWCO LOW WATER CUTOFF</div>	<div>MAX MAXIMUM</div> <div>MIN MINIMUM</div> <div>NG NATURAL GAS</div> <div>(N) NEW</div> <div>NO NORMALLY OPEN (VALVE)</div> <div>NC NORMALLY CLOSED (VALVE)</div> <div>OH OVER HEAD</div> <div>OFL OVERFLOW RAIN LEADER</div> <div>(R) PIPE RISE</div> <div>RIO ROUGH-IN ONLY</div> <div>RWL RAIN WATER LEADER</div> <div>SHT SHEET</div> <div>SCW SOFT COLD WATER</div> <div>SOC SHUT OFF COCK (GAS)</div> <div>SOV SHUT OFF VALVE</div> <div>TPL TRAP PRIMER LINE</div> <div>UG UNDERGROUND</div> <div>UP PIPE RISE TO NEXT LEVEL</div> <div>US UNDER SLAB</div> <div>UTR UP THRU ROOF</div> <div>V VENT</div> <div>VA VALVE</div> <div>VTR VENT THRU ROOF</div> <div>W WALL CLEANOUT</div> <div>WCO WASTE</div>	<div><b>DOMESTIC WATER PIPING</b></div> <div>ABOVE GRADE:<div>ASTM B88, TYPE L HARD DRAWN COPPER TUBING, WITH SOLDERED JOINTS,</div><div>ASME B16.22, WROUGHT COPPER AND BRONZE FITTINGS,</div><div>OR PRESSURE SEALED FITTINGS AND JOINTS COMPLYING WITH ASTM B584</div></div> <div>BELOW GRADE:<div>ASTM D1785, SCHEDULE 80 PVC, WITH SOLVENT WELDS.</div></div> <div>TO CARBONATORS:<div>ASTM A312, TYPE 304 SCHEDULE 40 STAINLESS STEEL, WITH THREADED FITTINGS.</div></div> <div><b>VENT PIPING ABOVE CEILINGS:</b></div> <div>ALL VENT PIPING ABOVE CEILINGS SHALL BE SERVICE WEIGHT, NO-HUB CAST IRON PIPE AND DRAINAGE FITTINGS WITH HEAVY DUTY COUPLINGS.</div> <div>WHEN CEILING CAVITY IS A RETURN AIR PLENUM, PROVIDE TRANSITION TO PVC WASTE AND VENT PIPING AS REQUIRED, PRIOR TO ENTERING PLENUM (IF APPLICABLE). PVC SHALL NOT BE EXPOSED IN A RETURN AIR PLENUM.</div> <div><b>WASTE &amp; VENT PIPING</b></div> <div>ABOVE GRADE:<div>ASTM A74, HUBLESS CAST IRON, WITH CISPI 301 SPIGOT BEAD ENDS FOR COUPLING ASSEMBLY.</div><div>ASTM D2665, SCHEDULE 40 PVC JOINED WITH SOLVENT WELDS.</div></div> <div>BELOW GRADE:<div>ASTM A74, CAST IRON, HUB AND SPIGOT TYPE, JOINED WITH ASTM C564 NEOPRENE COMPRESSION GASKETS.</div><div>ASTM D2665, SCHEDULE 40 PVC JOINED WITH SOLVENT WELDS.</div></div> <div><b>SOFTDRING TUBING CONDUIT:</b></div> <div>BELOW GRADE:<div>ASTM D2665, SCHEDULE 40 PVC JOINED WITH SOLVENT WELDS. PROVIDE LONG RADIUS FITTINGS AND PULL STRING.</div></div> <div><b>DOMESTIC WATER VALVES:</b></div> <div>DOMESTIC WATER: BALL VALVES, 2" AND SMALLER, ASTM B 584, BRONZE BODY AND BONNET, 2-PIECE CONSTRUCTION, CHROME-PLATED BRASS BALL, FULL PORT, BLOWOUT PROOF, BRASS OR BRONZE STEM, TEFLON SEAT AND SEALS, STEM EXTENSION FOR VALVES INSTALLED IN INSULATED PIPING, AND THREADED ENDS.</div>							
PLUMBING DESIGN CRITERIA								SHEET LIST	
<div><b>GENERAL GUIDELINES:</b></div> <div>ALL PLUMBING WORK AND MATERIALS SHALL COMPLY WITH THE 2015 IPC WITH CITY OF BURNET AMENDMENTS.</div> <div><b>SANITARY DRAINAGE AND VENT PIPING</b></div> <div>SIZED PER TABLE 710.1(1) OF THE 2015 IPC.</div> <div>DRAIN PIPE SHALL SLOPE PER 2015 IPC SECTION 704.1.</div> <div><b>DRAINAGE FIXTURE UNITS</b></div> <div>SIZED PER TABLE 709.1 OF THE 2015 IPC.</div> <div><b>WATER SUPPLY FIXTURE UNITS</b></div> <div>SIZED PER TABLE E103.3(2) OF THE 2015 IPC.</div> <div><b>WATER SUPPLY PIPE SIZING</b></div> <div>SIZED PER TABLE E103.3(5) OF THE 2015 IPC.</div>								<div><div>DRAWING</div><div>SHEET TITLE</div><div>P001 PLUMBING COVER SHEET</div><div>P002 PLUMBING DETAILS</div><div>P003 PLUMBING SCHEDULES</div><div>P101 PLUMBING DWV PLANS</div><div>P201 PLUMBING DOMESTIC WATER PLANS</div><div>P301 PLUMBING RISER DIAGRAMS</div></div>	




Autodesk Docs/733-1408 Burnet County Annex/Burnet County\_Maps\_RV022.rvt

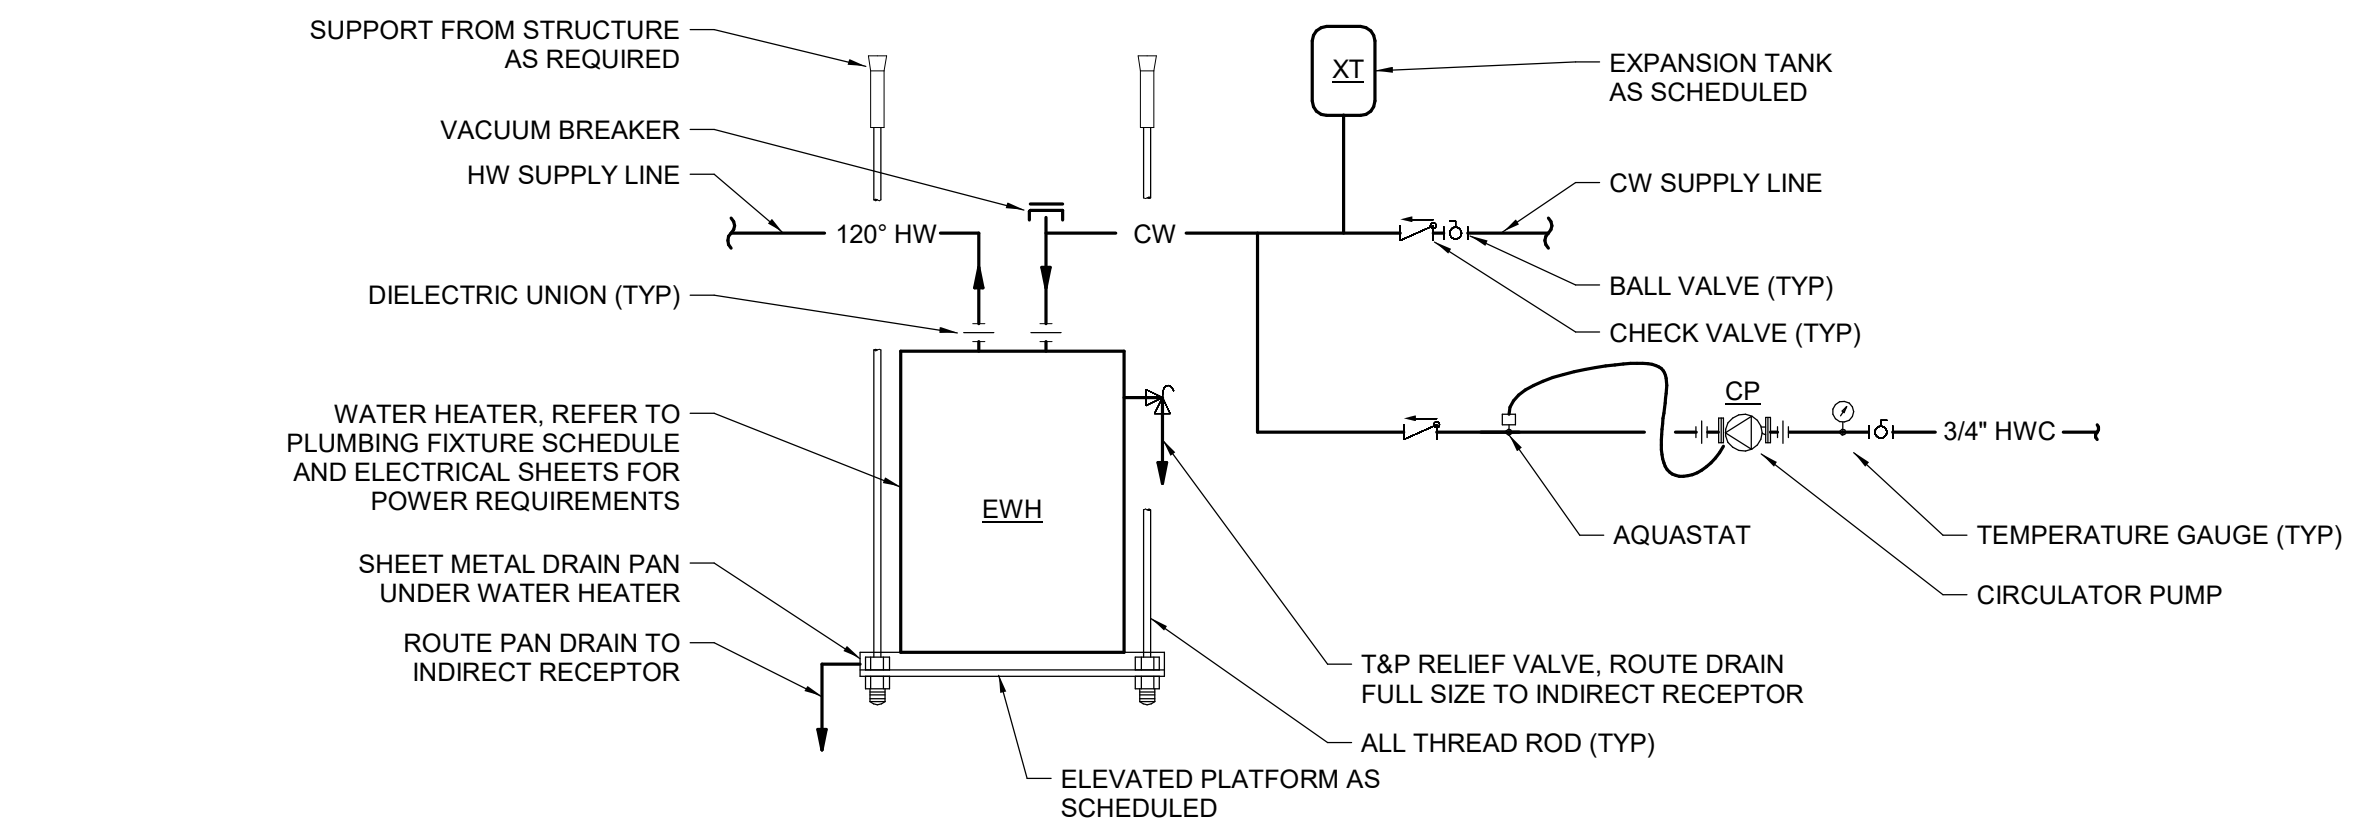

D WATER HEATER DETAIL


NOT TO SCALE

NOTE: WATER HAMMER ARRESTOR BY SIOUX CHIEF 650 - 660 SERIES HYDRA-RESTER, REQUIRED IN PIPING SYSTEMS. WATER HAMMER ARRESTERS SHALL HAVE SUFFICIENT VOLUME OF AIR TO DISSIPATE THE CALCULATED KINETIC ENERGY GENERATED IN THE PIPING SYSTEM. ARRESTERS SHALL BE EFFECTIVE WHEN INSTALLED AT ANY ANGLE. ARRESTERS SHALL BE APPROVED FOR INSTALLATION WITH NO ACCESS PANEL REQUIRED. WATER HAMMER ARRESTERS SHALL BE SIZED AND PLACED PER MANUFACTURER'S INSTRUCTIONS.

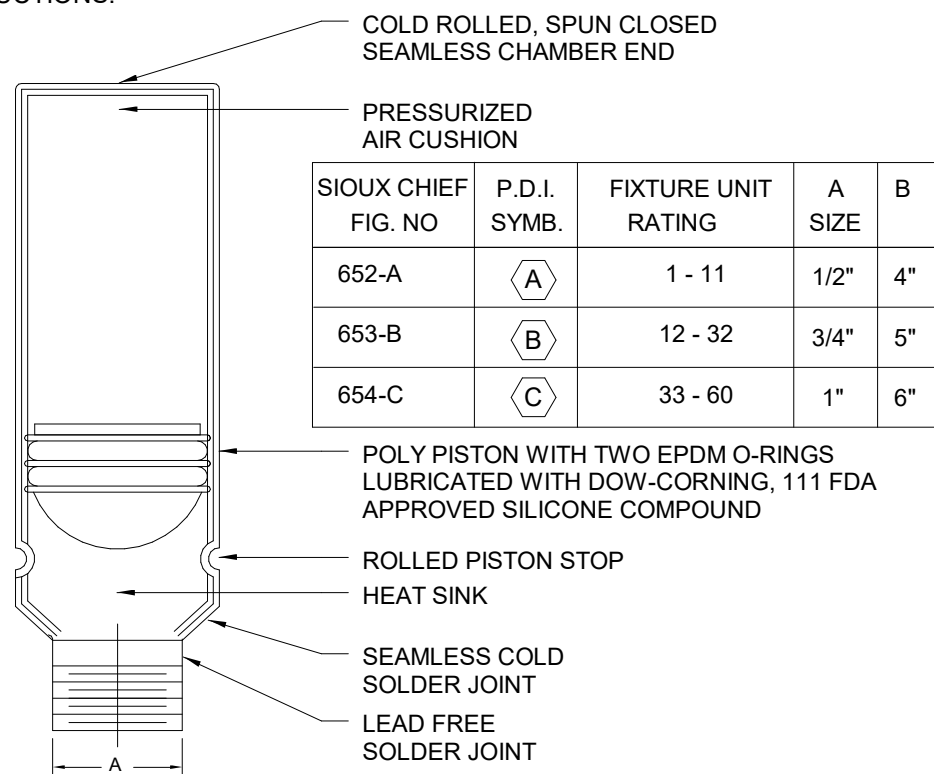

H Sioux Chief WHA


NOT TO SCALE

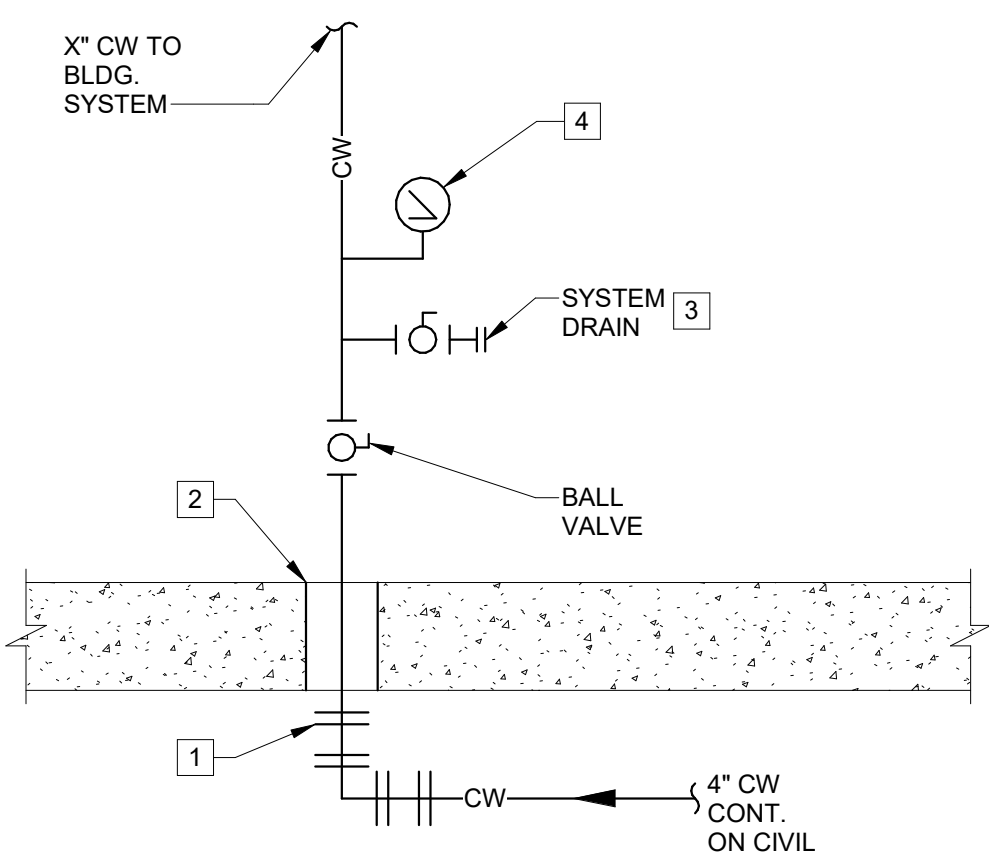

- NOTES:
- 1 MEGA-LUG THRUST RESTRAINT SYSTEM UNDER BUILDING SLAB.
  - 2 SLEEVE AND SEAL WATER TIGHT THRU FLOOR.
  - 3 1" BALL VALVE WITH 3/4" MALE HOSE THREAD.
  - 4 3 1/2"Ø PRESSURE GAUGE READS 0-100 PSI.


I WATER ENTRANCE DETAIL

NOT TO SCALE

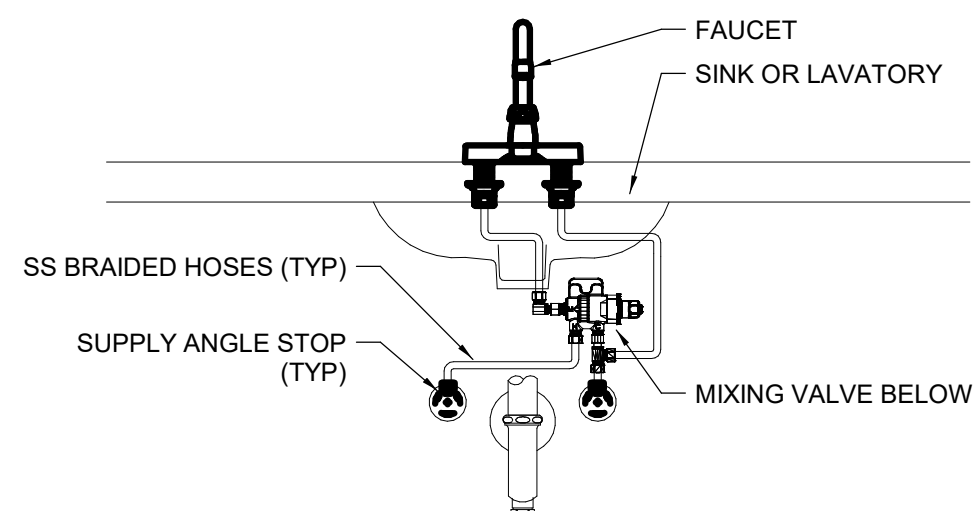


E Lavatory TMV

NOT TO SCALE

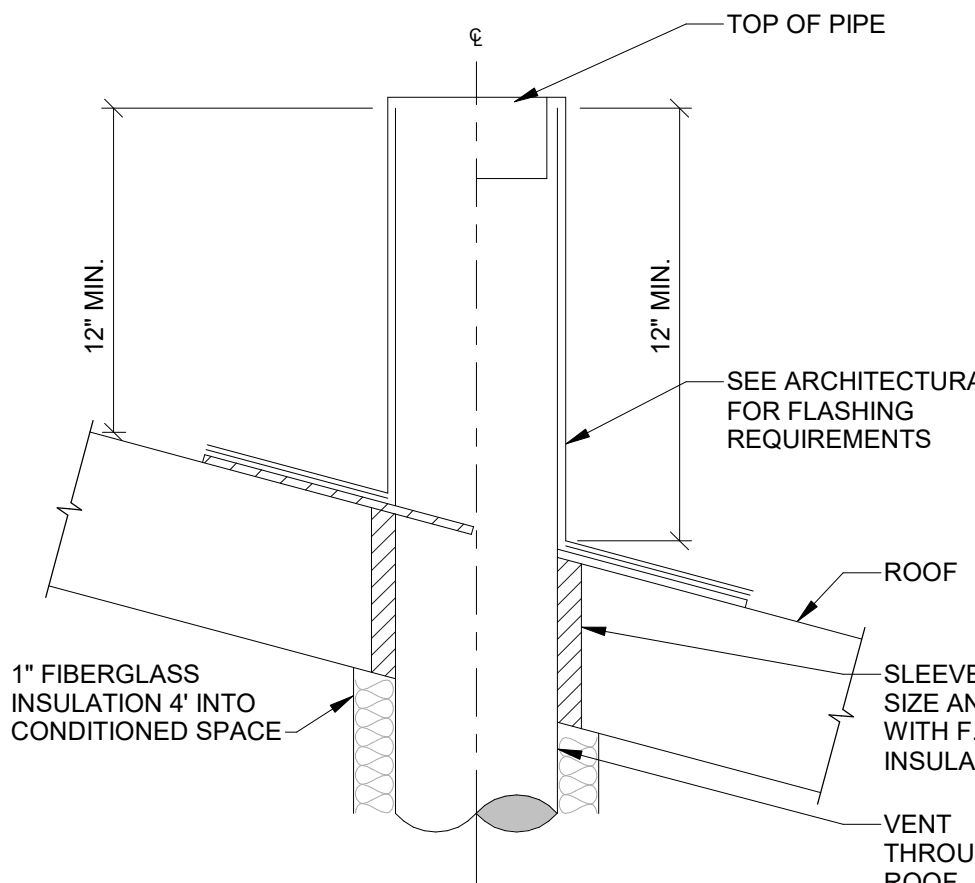



F VENT THROUGH ROOF DETAIL 2

NOT TO SCALE

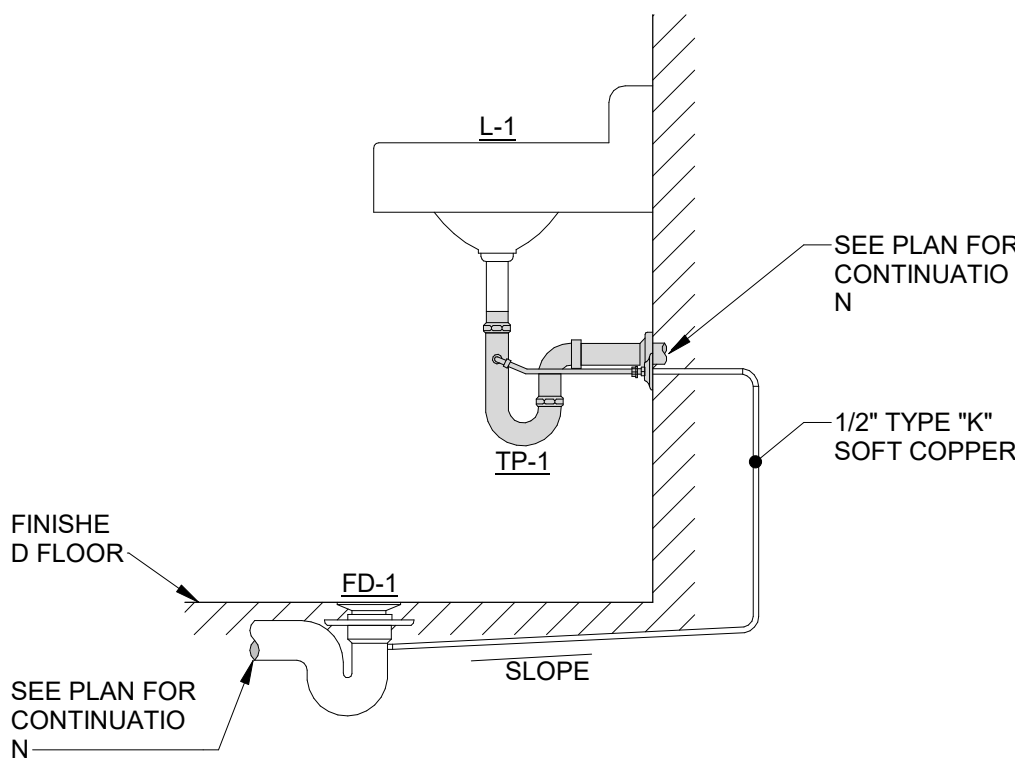

G TRAP PRIMER DETAIL


NOT TO SCALE

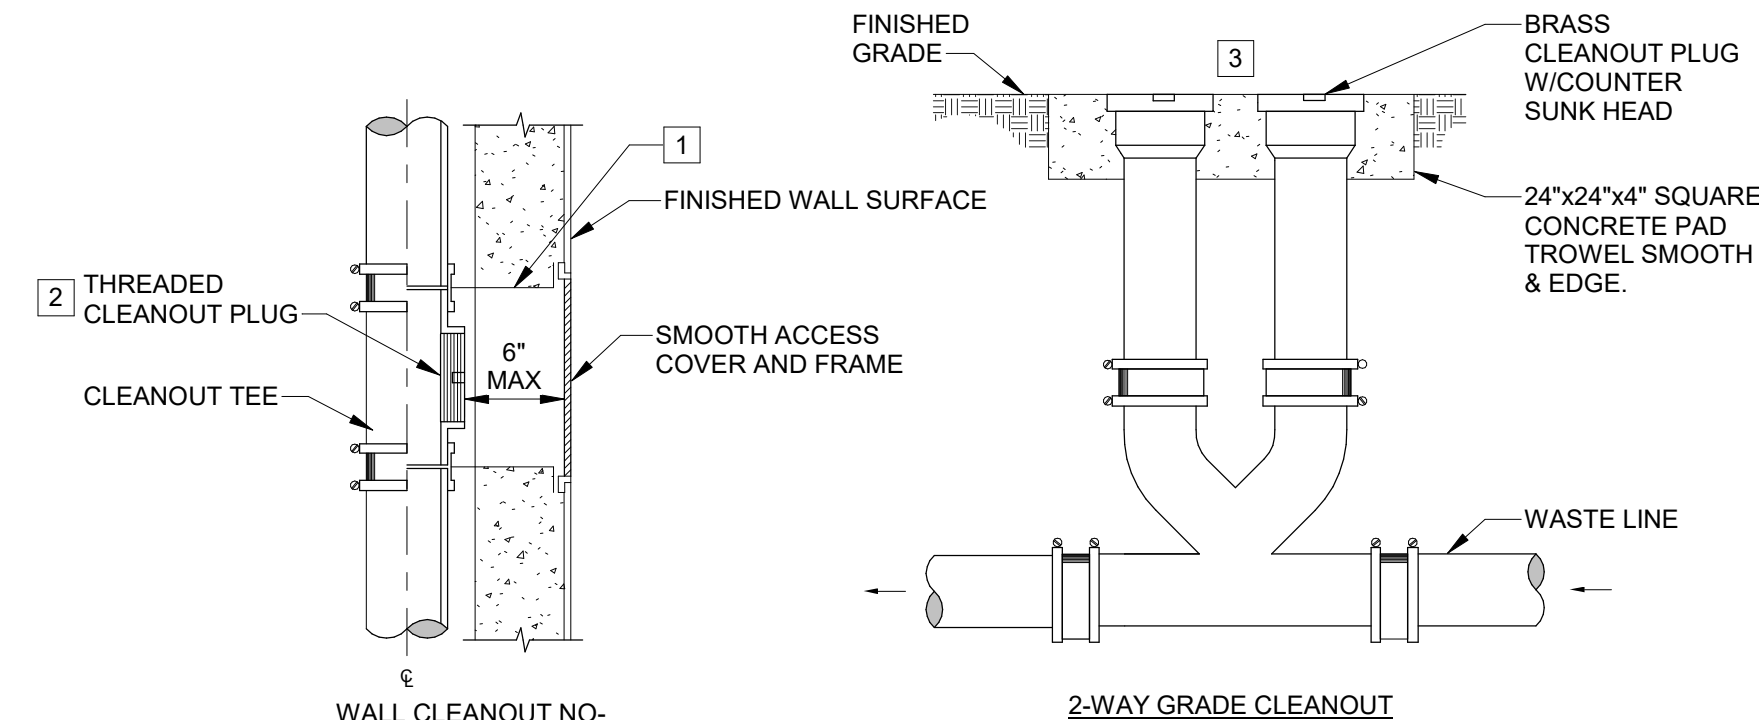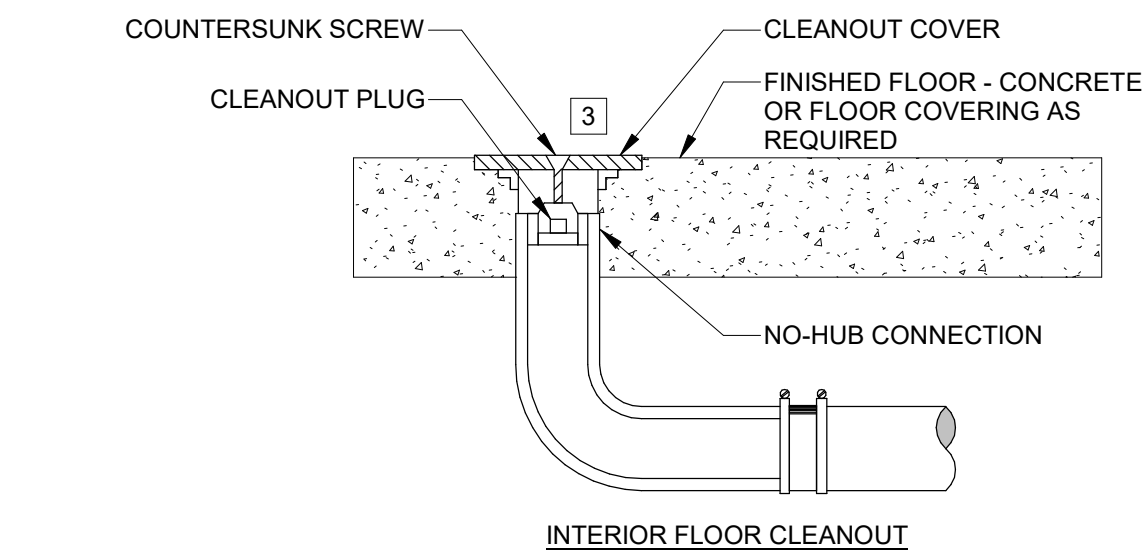

- NOTES:
- 1 WHERE WCO OCCURS IS SOLID CONCRETE OR GROUTED CMU WALL, USE SLEEVE BETWEEN PIPE AND COVER PLATE TO KEEP ACCESS TO PLUG OPEN.
  - 2 USE EXTENSIONS BETWEEN TEE AND ACCESS COVER AS NEEDED.
  - 3 WHERE A CLEANOUT SHALL BE CLEARLY IDENTIFIED WITH A LABEL STATING "BACKWATER VALVE DOWNSTREAM"


A CLEANOUT DETAIL

NOT TO SCALE

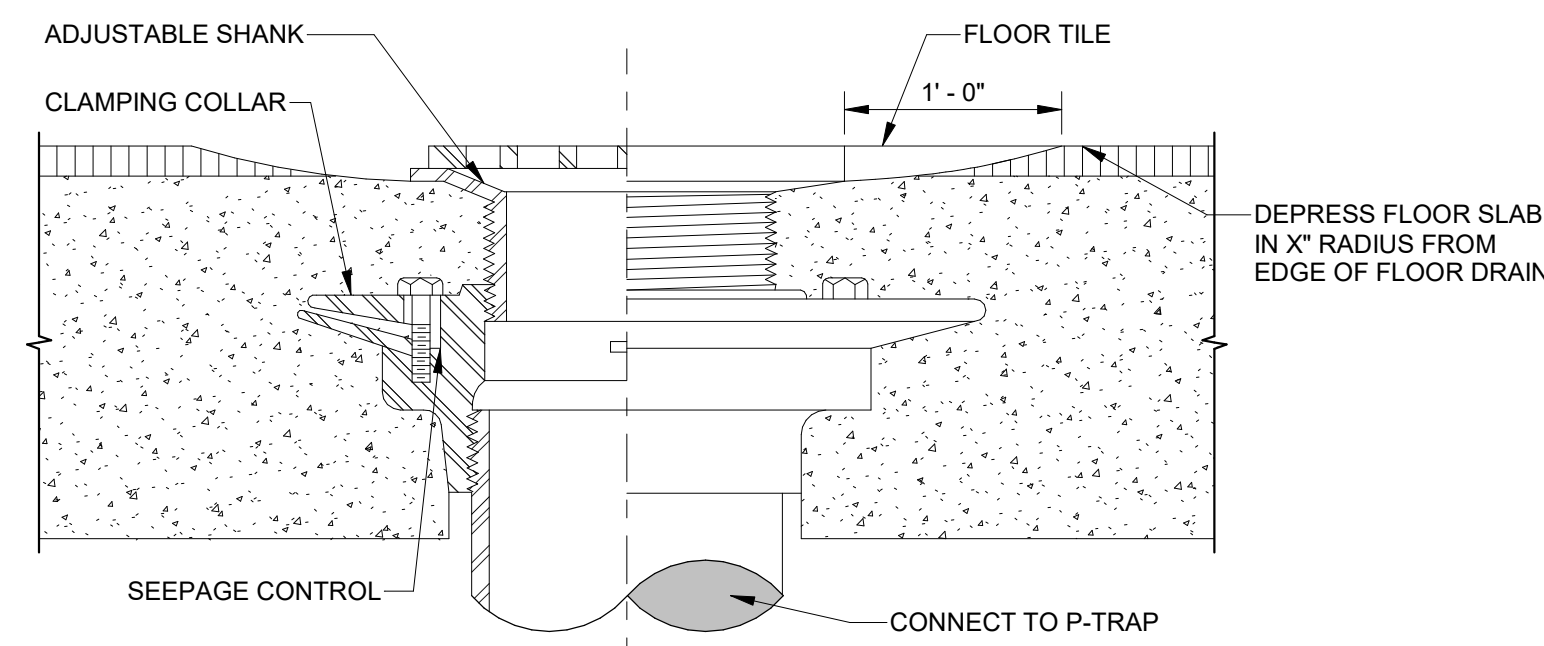

B FLOOR DRAIN DETAIL

NOT TO SCALE

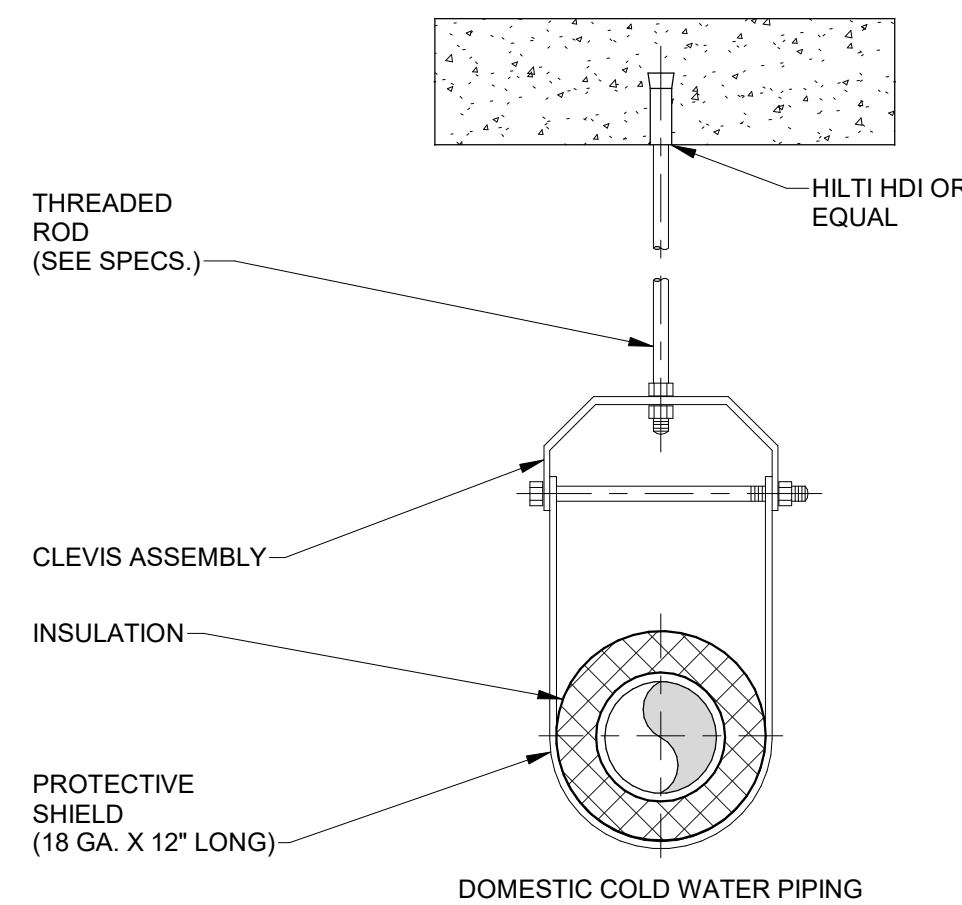

MAXIMUM PIPE/TUBING SUPPORT SPACING, FEET										
NOM. SIZE	THRU 3/4"	1"	1-1/4"	1-1/2"	2"	2-1/2"	3"	4"	6"	8"
COPPER	5	6	7	8	8	9	10	12	14	16

C PIPE HANGER DETAIL

NOT TO SCALE

#	DATE	ISSUE



Autodesk Docs/733-1408 Burnet County Annex/Burnet County\_Maps\_BV022.rvt

PLUMBING FIXTURE SCHEDULE								
TAG	DESCRIPTION	MANUFACTURER - MODEL	TRIM & ACCESSORIES	CONNECTIONS (INCHES)				DESCRIPTION AND NOTES
				HW	CW	W	V	
CP-1	CIRCULATION PUMP	TACO #003B	PROVIDE WITH TACO #265-3 DIGITAL TIMER AND AQUASTAT FOR PUMP CONTROL	3/4	-	-	-	1/40 HP, 120/1/60, 0.5 GPM @ 4 FT HEAD, BRONZE CONSTRUCTION. COORDINATE OPERATING TIMES WITH OWNER
EWB-1	ELECTRIC WATER HEATER	A.O. SMITH DEL-10S-2.5	CONTAINMENT PAN W/ DRAIN, WALL MOUNT, (HOLDRITE 30-SWHP-WM OR EQUAL), CP-1 AND XT-1 AS SCHEDULED	3/4	3/4	-	-	10 GALLON ELECTRIC STORAGE WATER HEATER, 2.5 KW, 10 GPH AT 100 DEG F RISE, T&P RELIEF ASSEMBLY, SET AT 120 DEG F DISCHARGE, PROVIDE XT-1 EXPANSION TANK, 208V1PH, 25 FLA
FCO	FLOOR CLEANOUT	JAY R. SMITH #4020	FLANGE W/ FLASHING CLAMP	-	-	-	-	CAST IRON BODY, ABS CLEANOUT PLUG WITH GASKET, NICKEL BRONZE COVER, ADJUSTABLE HOUSING FOR FLUSH INSTALLATION, REFER TO PLANS FOR PIPE SIZE
L-1	LAVATORY (ADA)	KOHLER SOHO #K-2053-N	FAUCET: KOHLER #K-23484-4N-CP, TRAP, S.S. BRAIDED HOSES, 1/4 TURN ANGLE STOPS, WALL ESCUTCHEONS, TRUEBRO PIPE GUARDS	1/2	1/2	2	2	WHITE VITREOUS CHINA WALL MOUNT SINK, 0.5 GPM THREEE HOLE COUNTER MOUNT FAUCET IN CHROME, BASKET STRAINER, CHROME TAILPIECE AND P-TRAP. ADA COMPLIANT
MS-1	MOP SINK	FIAT #MSB2424	FAUCET: FIAT #830-AA, MOP HANGER	1/2	1/2	3	2	24"x24"x12" MOLDED STONE MOP SINK, CHROME PLATED SERVICE FAUCET WITH VACUUM BREAKER, WALL BRACE, PAIL HOOK, AND HOSE THREAD
SA-1	SHOCK ARRESTOR	SIOUX CHIEF HYDRARESTER 650 SERIES	-	-	*	-	-	FACTORY PRECHARGED WATER HAMMER ARRESTOR. *REFER TO MANUFACTURER LITERATURE FOR SIZING CRITERIA AND MODEL SELECTION
SK-1	BREAK ROOM SINK	ELKAY LUSTERTONE #LRAD221965	FAUCET: KOHLER #K-7505-CP, TRAP, S.S. BRAIDED HOSES, 1/4 TURN ANGLE STOPS, WALL ESCUTCHEONS	1/2	1/2	2	2	18 GA STAINLESS STEEL SINGLE BOWL COUNTERMOUNT SINK, 6" DEEP, 1.5 GPM SINGLE HOLE COUNTER MOUNT FAUCET IN CHROME, BASKET STRAINER, CHROME TAILPIECE AND P-TRAP.
SP-1	ELEVATOR SUMP PUMP	BELL & GOSSETT #ELKT2EC0311L	HIGH WATER FLOAT ALARM SWITCH	-	-	2	-	AUTOMATIC OPERATION ELEVATOR SUMP PUMP, 1/3 HP, 120V/1PH, 50 GPM AT 17 FT HEAD. PROVIDE HIGH ALARM FLOAT. COORDINATE INSTALLATION OF ALARM PANEL WITH ARCH.
TMV-1	TEMPERATURE MIXING VALVE	WATTS #LFUSG-B	-	1/2	1/2	-	-	THERMOSTATIC MIXING VALVE, LEAD FREE BRASS BODY, 0.35 GPM, INTEGRAL CHECK VALVES, SET AT 110°F OUTLET TEMPERATURE, INSTALL AT ALL LAV-1 FIXTURES
TP-1	TRAP PRIMER	PRECISION PLUMBING PRODUCTS #LTP-1500	-	-	1/2	-	-	BRASS CONSTRUCTION, FULLY AUTOMATIC TRAP PRIMER. PROVIDE WITH SHUTOFF VALVE FOR MAINTENANCE.
WCO	WALL CLEANOUT	JAY R. SMITH #4402C	-	-	-	-	-	STAINLESS STEEL COVER, REFER TO PLANS FOR SIZE
WB-1	REFRIGERATOR WALL BOX	IPS WATER TITE	-	-	1/2	-	-	WALL BOX WITH 1/4 TURN ANGLE STOP, WALL FLANGE, AND INTEGRAL WATER HAMMER ARRESTOR
WC-1	WATER CLOSET (ADA)	KOHLER KINGSTON #K-25087	-	-	1/2	4	2	VITREOUS CHINA, TWO PIECE FLOOR MOUNTED WITH ELONGATED BOWL, GRAVITY SIPHON JET, 1.28 GPF, MATCHING SEAT WITH STAINLESS STEEL POSTS, ADA COMPLIANT HEIGHT
WH-1	WALL HYDRANT	WOODFORD #B65	-	-	3/4	-	-	ANTI-SIPHON FREEZELESS WALL HYDRANT, CHROME WITH ANTI-SIPHON VACUUM BREAKER HOSE THREAD, STAINLESS STEEL STEM WITH KEY OPERATOR, CONCEALED RECTANGULAR BOX
XT-1	EXPANSION TANK	AMTROL #ST-5-C	-	-	3/4	-	-	2 GALLON EXPANSION TANK, 0.45 ACCEPTANCE FACTOR, CERTIFIED FOR POTABLE WATER USAGE

WATER CALCULATIONS (2015 IPC) - SERVICE SIZE			
			PSI
AVAILABLE WATER PRESSURE			60.0
PRESSURE LOSS AT METER			15.0
ELEVATION OF MIN. PRESSURE REQUIRED (FLUSH TANK)			8.0
HIGHEST FIXTURE			14
(FEET)			6.0
STATIC PRESSURE LOSS (ELEV)			31.0
TOTAL AVAILABLE PRESSURE			
DISTANCE TO LAST FIXTURE (IN FT.)			60
TOTAL DEVELOPED LENGTH (IN FT.)			72
PEAK FLOW (IN GPM)			24
ALLOWABLE FRICTION LOSS/100 FT			43.0
FIXTURE	QTY	WSFU EA.	TOTAL WSFU
WATER CLOSET (FLUSH TANK)	4.0	5.00	20.0
LAVATORY	4.0	1.50	6.0
BREAK SINK	2.0	2.00	4.0
MOP SINK	1.0	3.00	3.0
TOTAL WSFU			33.0
EQUIVALENT GPM			24.3
METER SIZE:			3/4"
BUILDING SUPPLY SIZE:			1"



#	DATE	ISSUE
1	08/21/2025	addendum 1

Project Number: 33-1408  
© 2024 LEVY DYKEMA  
PLUMBING SCHEDULES

LEVY  
DYKEMA


STATE OF TEXAS  
BRIAN D. HOCKMAN  
108645  
LICENSED PROFESSIONAL ENGINEER  
08/26/2025

127 E JACKSON ST. BURNET TX 78611


BURNET COUNTY ANNEX



Autodesk Docs/33-1408 Burnet County Annex/Burnet County\_Maps\_RV02.rvt

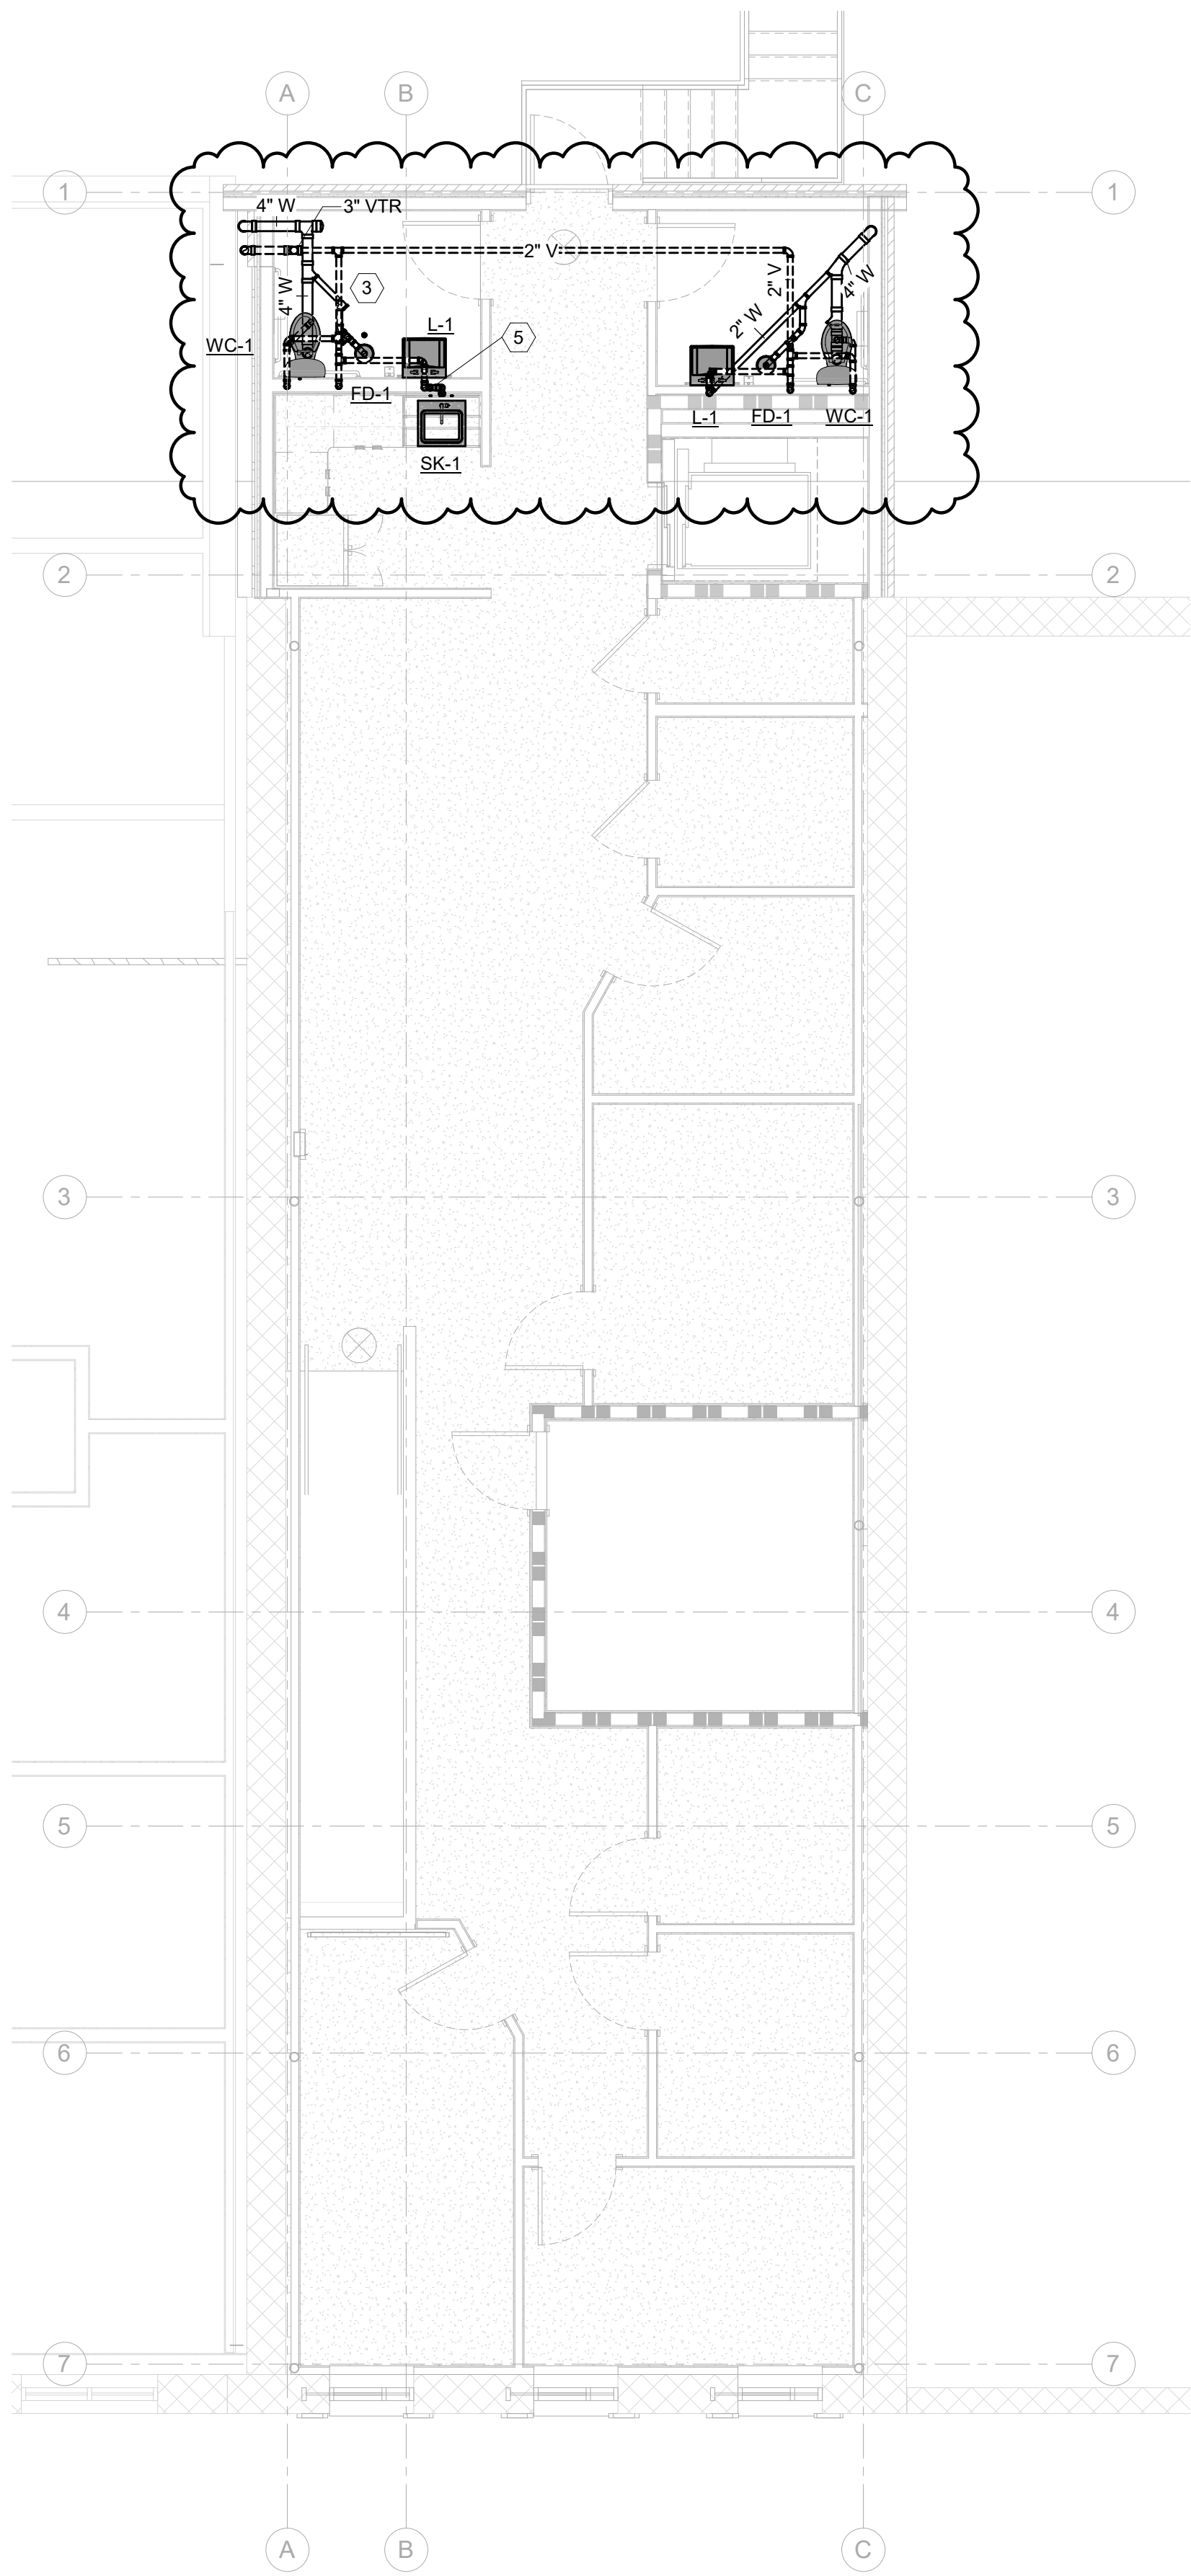

2 PLUMBING DWV PLAN-SECOND FLOOR  
P101 3/16" = 1'-0"

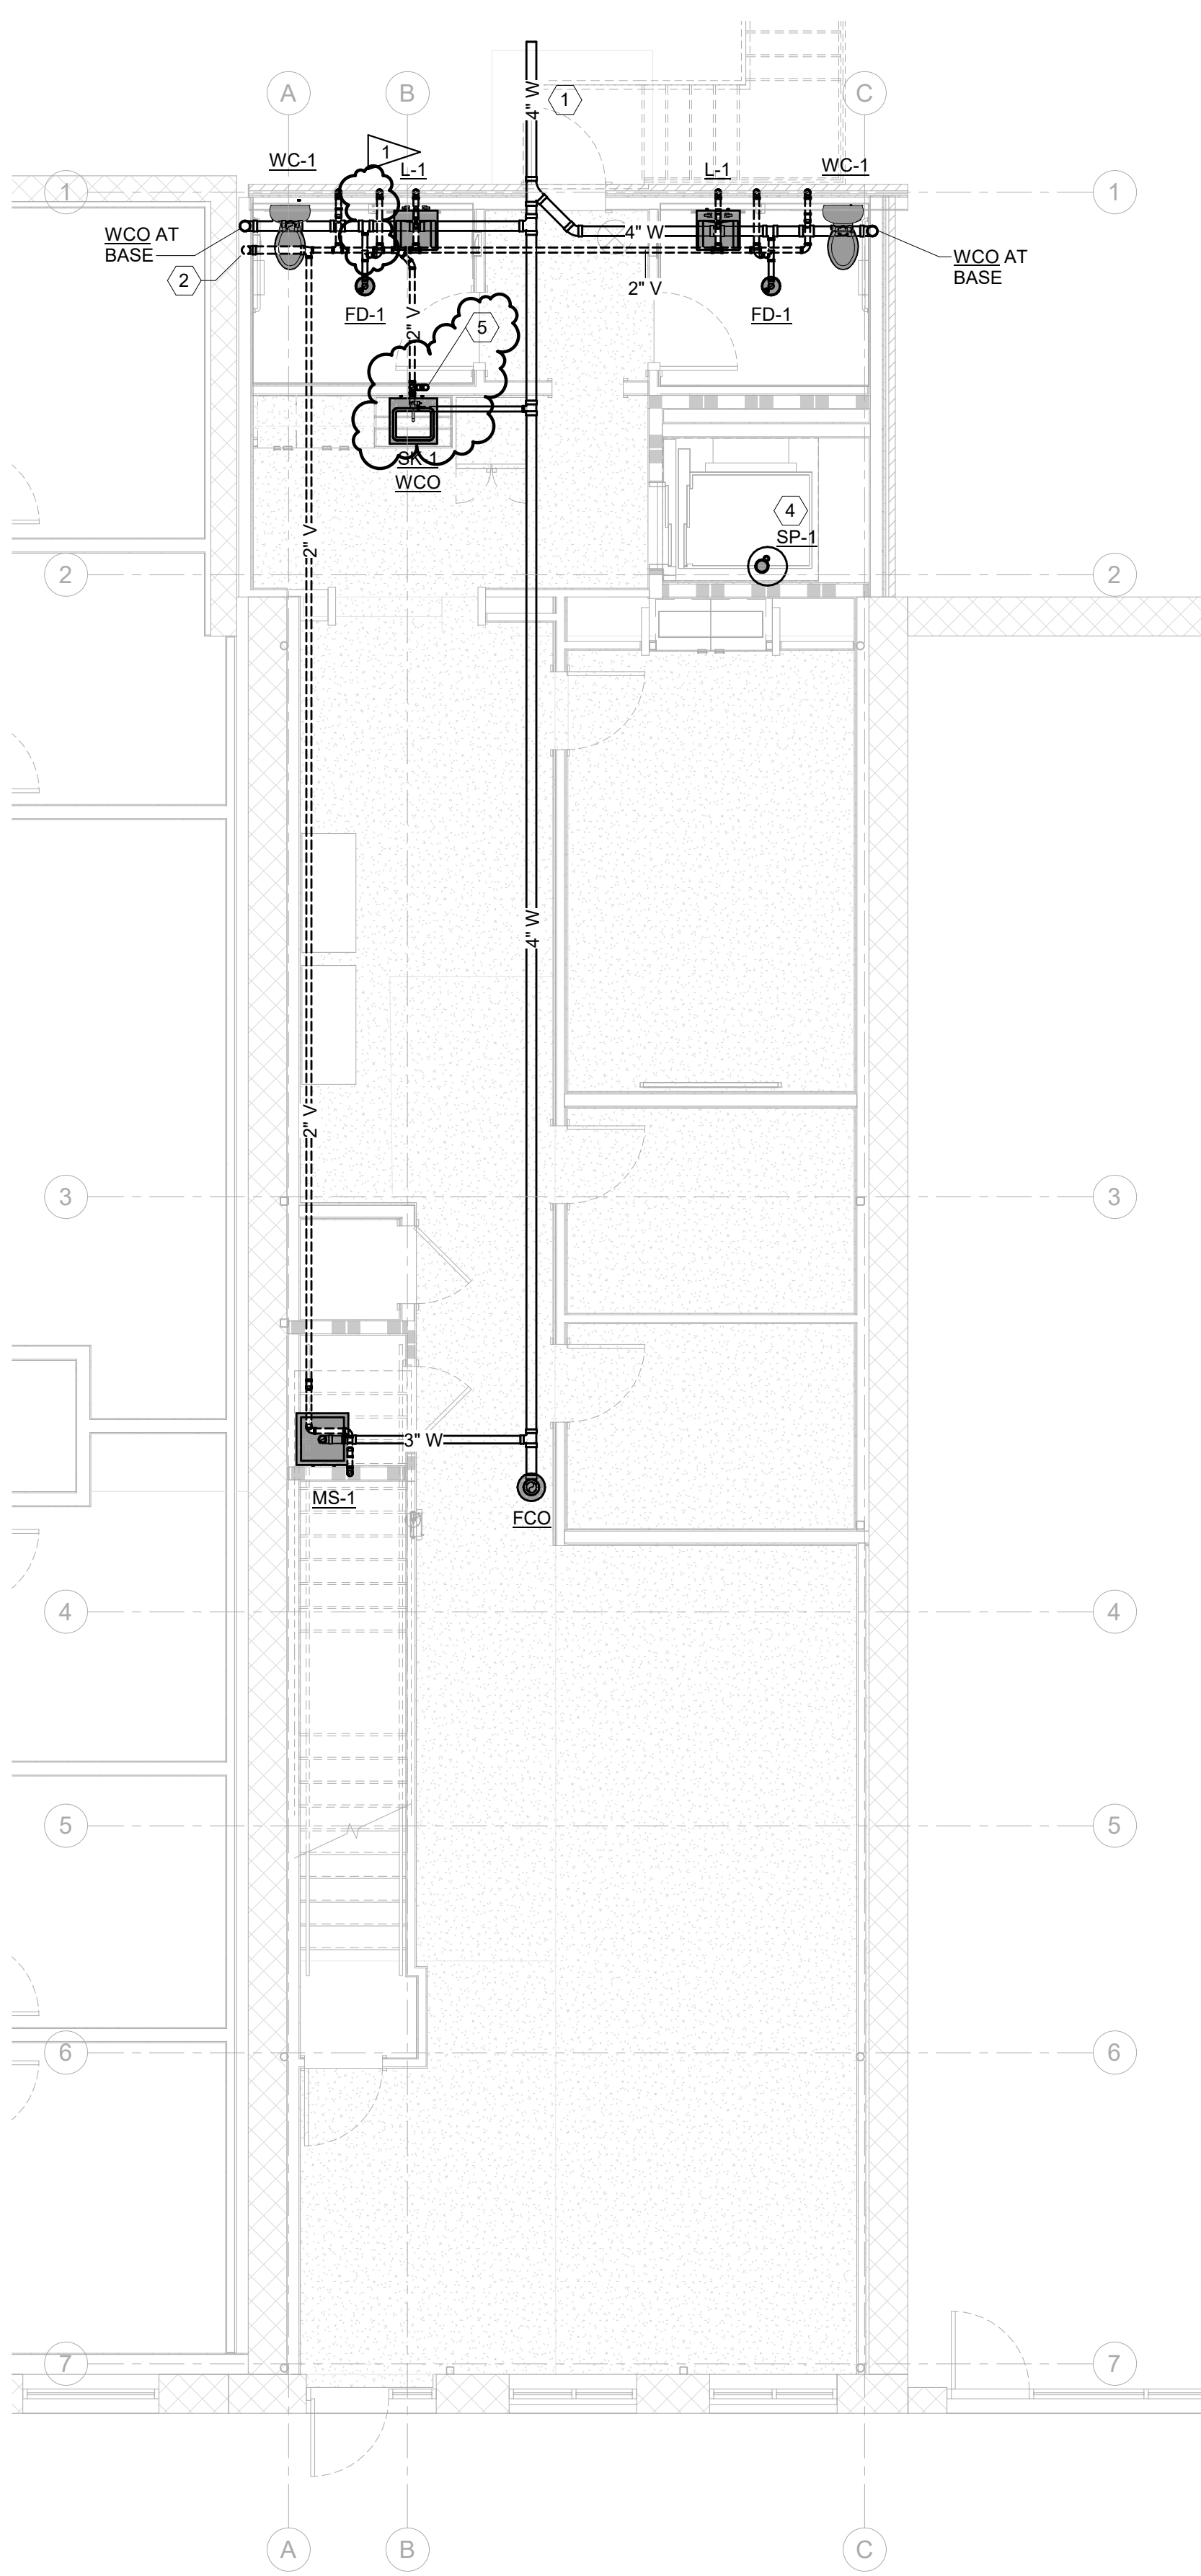

1 PLUMBING DWV PLAN-FIRST FLOOR  
P101 3/16" = 1'-0"

## GENERAL NOTES

- REFER TO PLUMBING COVER SHEET DRAWING FOR SYMBOLS, ABBREVIATIONS, SPECIFICATIONS, AND ADDITIONAL INFORMATION.
- DUE TO DRAWING SCALE IT IS NOT POSSIBLE TO INDICATE ALL OFFSETS, FITTINGS AND ACCESSORIES WHICH MAY BE REQUIRED.
- THE CONTRACTOR SHALL EXAMINE FIELD CONDITIONS AND FURNISH THE NECESSARY FITTINGS WHICH MAY BE REQUIRED TO COMPLETE THE INSTALLATION.
- FINAL LOCATION OF ALL NEW EQUIPMENT PRIOR TO EQUIPMENT INSTALLATION SHALL BE APPROVED BY BUILDING OWNER OR PROJECT MECHANICAL ENGINEER.
- MAINTAIN CODE REQUIRED AND MANUFACTURER'S RECOMMENDED CLEARANCES FOR ALL NEW EQUIPMENT.
- PLUMBING CONTRACTOR SHALL VERIFY ALL UTILITY LOCATIONS IN THE FIELD. ROUTE NEW SANITARY WASTE AND DOMESTIC WATER PIPING TO EXISTING.


## # SHEET WORK NOTES

- 4" SANITARY WASTE TO SITE. CONNECT TO EXISTING SANITARY WASTE MAIN IN ALLEY. CONTRACTOR SHALL VERIFY IN THE FIELD THE EXACT LOCATION AND DEPTH OF LINE PRIOR TO INSTALLATION OF NEW PLUMBING. CONFIRM ADEQUATE DEPTH AND PIPE SIZE.
- 3" VENT UP TO LEVEL 2.
- 3" VENT TO ROOF. COORDINATE WITH ROOFING CONTRACTOR FOR FINAL TERMINATION AND FLASHING.
- PROVIDE AND INSTALL SUMP PUMP IN ELEVATOR PIT. ROUTE 2" SUMP PUMP DISCHARGE PIPING TO APPROVED DISCHARGE LOCATION. COORDINATE ROUTING OF PIPING WITH ARCHITECTURAL AND IN THE FIELD.
- 2" SANITARY WASTE FROM LAVATORY AND BREAK SINK ON LVL 2 DOWN IN WALL. CONNECT TO 2" SANITARY WASTE PIPING FOR BREAK SINK ON LVL 1.


#	DATE	ISSUE
1	08/21/2025	Issued



Autodesk Docs/233-1408 Burnet County Annex/Burnet County\_M&P\_RV02.rvt

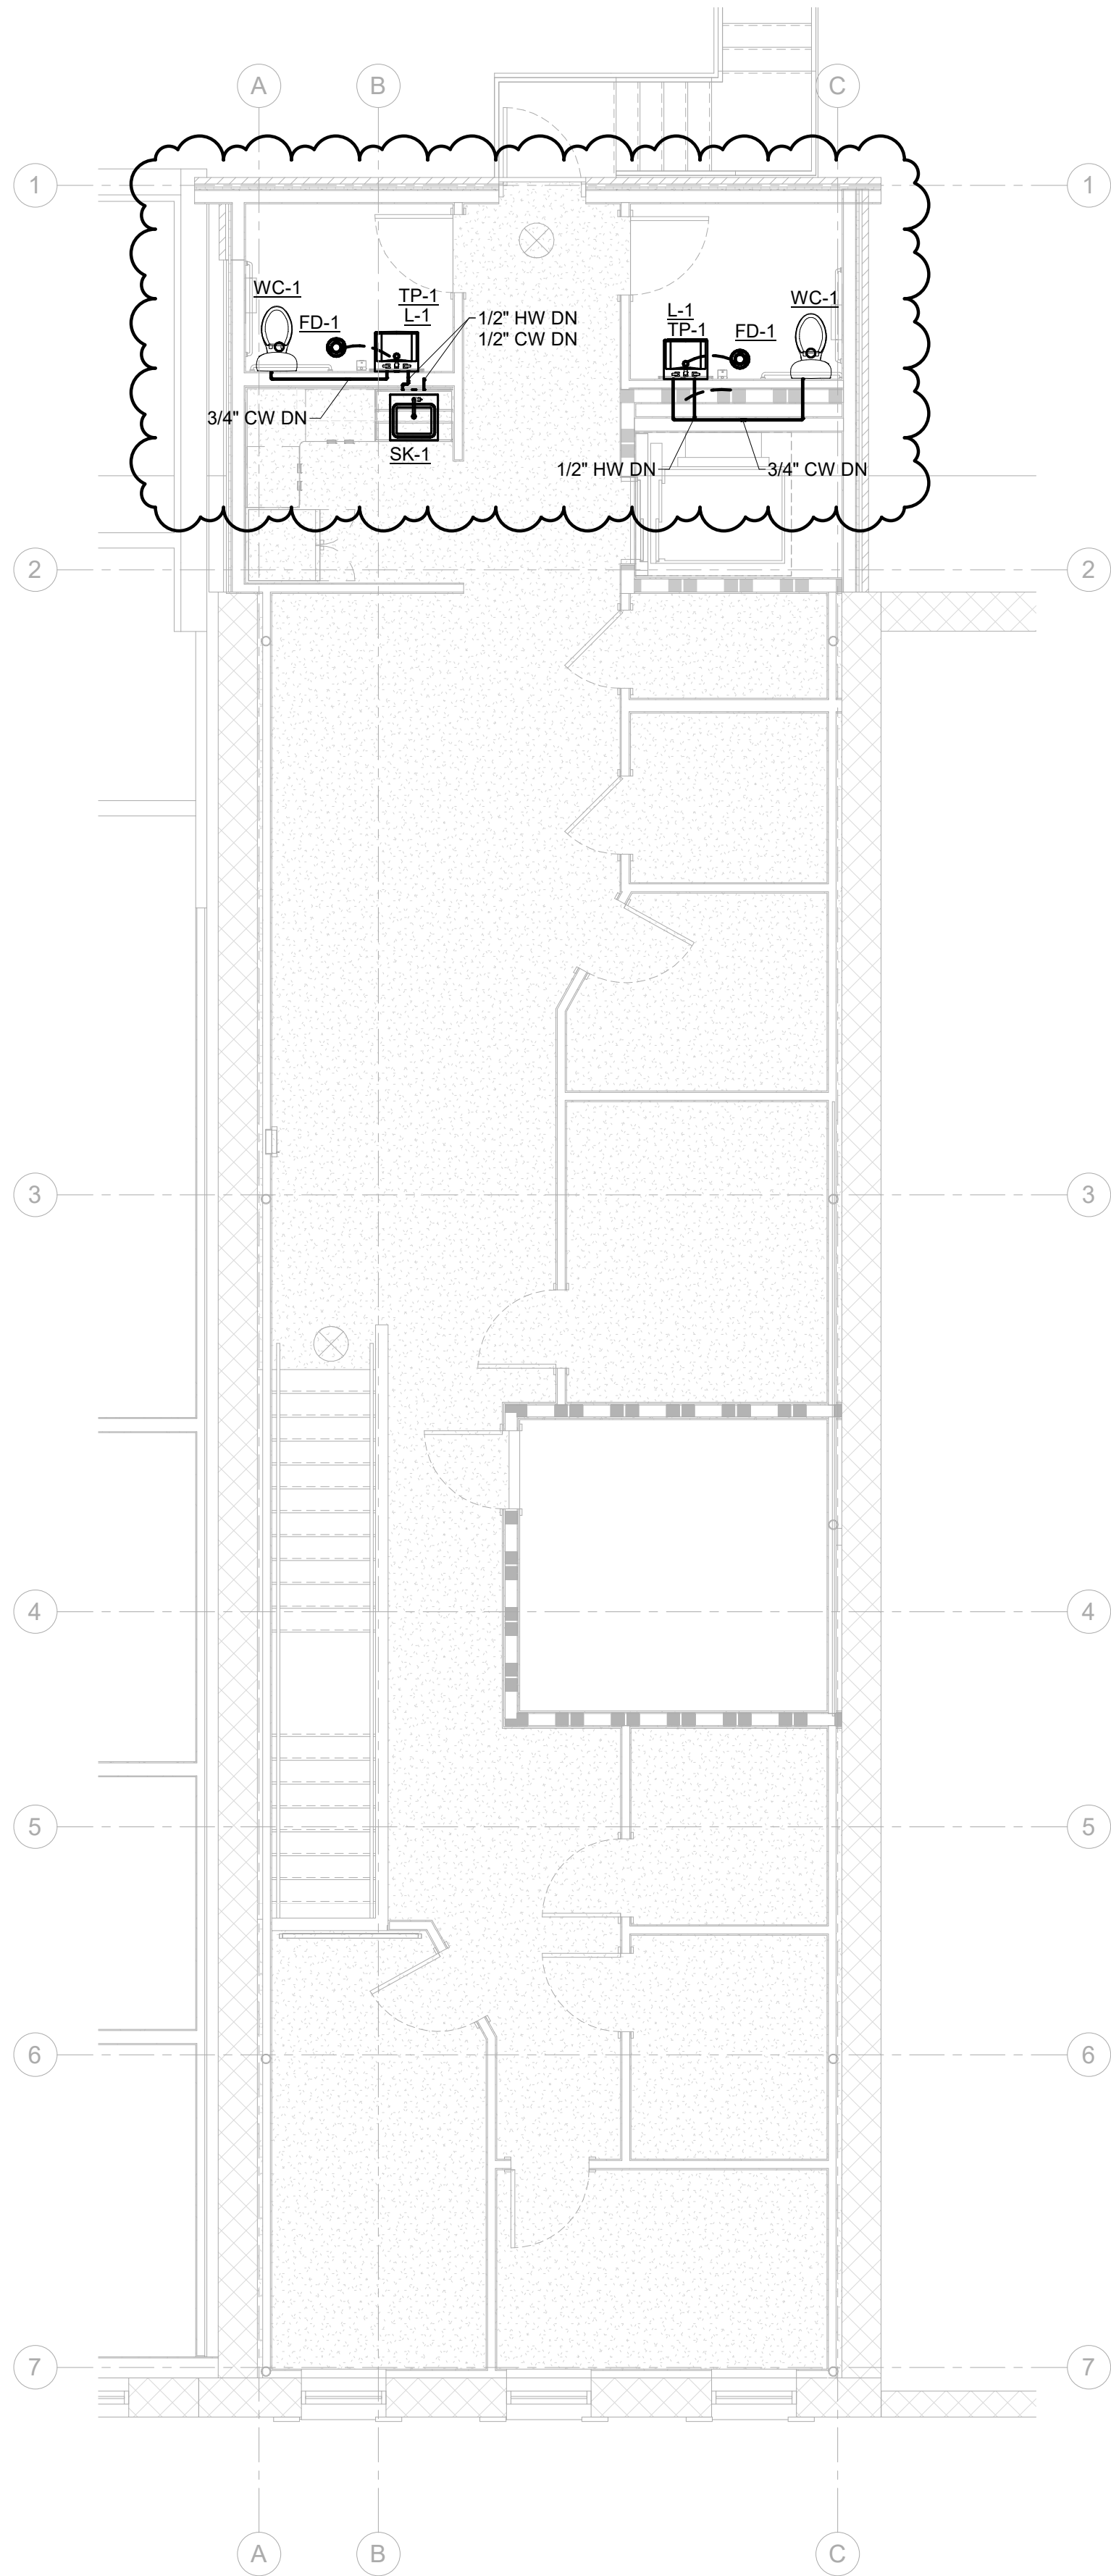

2 PLUMBING DOMESTIC W&G PLAN-SECOND FLOOR  
P201 3/16" = 1'-0"

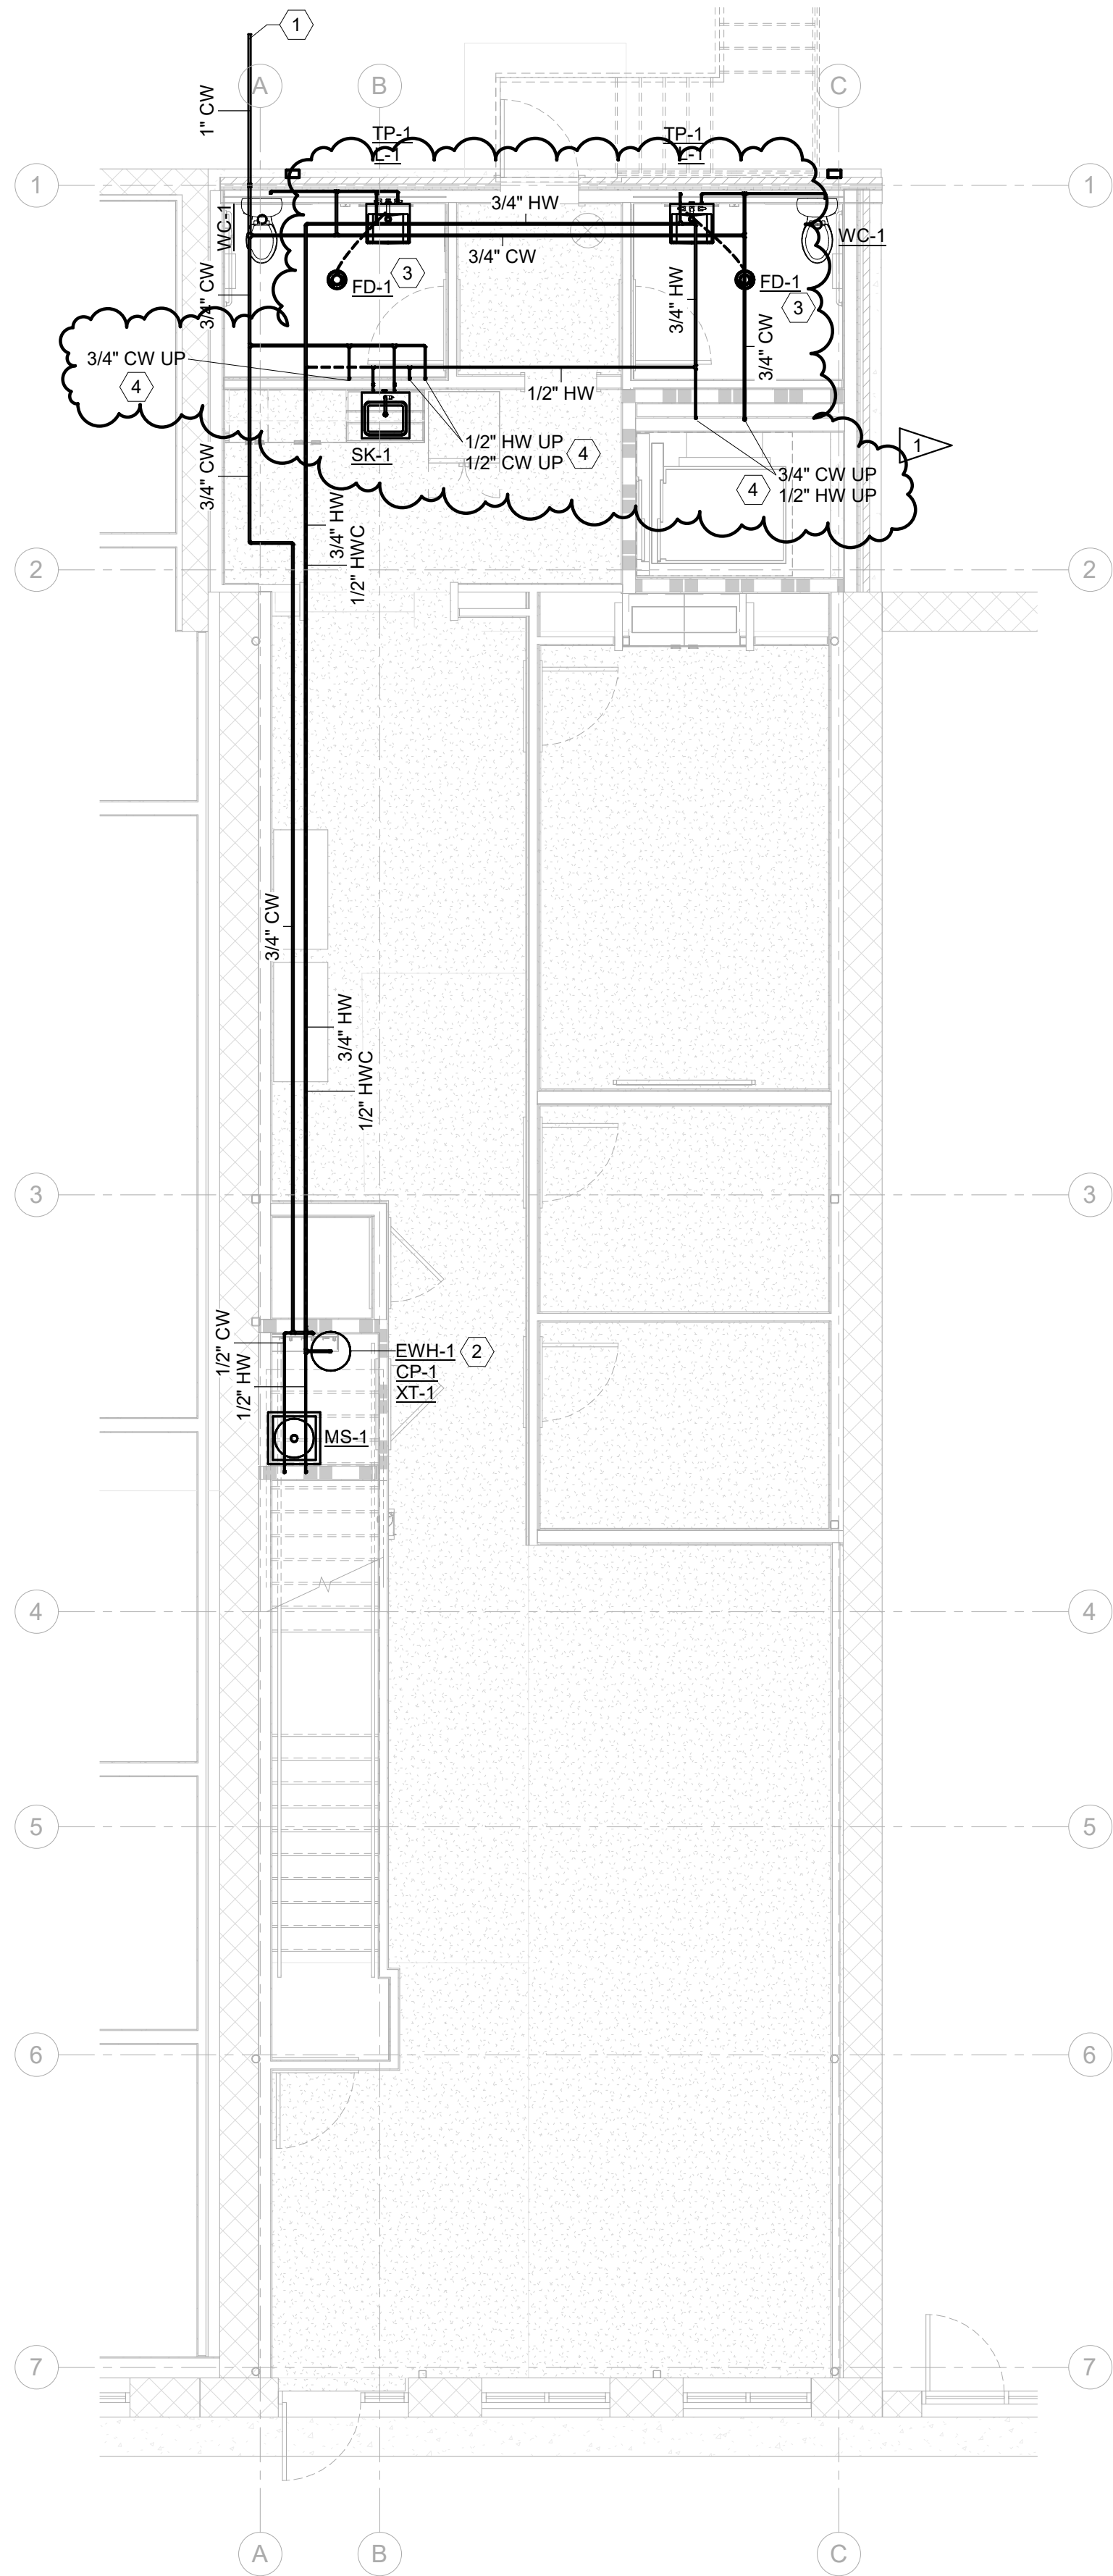

1 PLUMBING DOMESTIC W&G PLAN-FIRST FLOOR  
P201 3/16" = 1'-0"

## GENERAL NOTES




- REFER TO PLUMBING COVER SHEET DRAWING FOR SYMBOLS, ABBREVIATIONS, SPECIFICATIONS, AND ADDITIONAL INFORMATION.
- DUE TO DRAWING SCALE IT IS NOT POSSIBLE TO INDICATE ALL OFFSETS, FITTINGS AND ACCESSORIES WHICH MAY BE REQUIRED.
- THE CONTRACTOR SHALL EXAMINE FIELD CONDITIONS AND FURNISH THE NECESSARY FITTINGS WHICH MAY BE REQUIRED TO COMPLETE THE INSTALLATION.
- FINAL LOCATION OF ALL NEW EQUIPMENT PRIOR TO EQUIPMENT INSTALLATION SHALL BE APPROVED BY BUILDING OWNER OR PROJECT MECHANICAL ENGINEER.
- MAINTAIN CODE REQUIRED AND MANUFACTURER'S RECOMMENDED CLEARANCES FOR ALL NEW EQUIPMENT.
- PLUMBING CONTRACTOR SHALL VERIFY ALL UTILITY LOCATIONS IN THE FIELD. ROUTE NEW SANITARY WASTE AND DOMESTIC WATER PIPING TO EXISTING.

## # SHEET WORK NOTES


- PLUMBING CONTRACTOR SHALL COORDINATE WITH WATER UTILITY PROVIDER TO RELOCATE EXISTING WATER METER TO NEW LOCATION OUTSIDE OF NEW BUILDING FOOTPRINT. PROVIDE AND INSTALL METER AND 1" LINE SIZE AS REQUIRED PER WATER CALCULATION ON SHEET P003.
- WATER HEATER MOUNTED TIGHT TO STRUCTURE ABOVE CUSTODIAN CLOSET DOOR. COORDINATE WITH GENERAL CONTRACTOR FOR INSTALLTION OF WALL SUPPORT.
- ROUTE 1/2" TRAP PRIMER LINE FROM LAVATORY SINK TAILPIECE, BELOW SLAB TO FLOOR DRAIN TRAP PRIMER CONNECTION.
- COLD WATER AND HW UP TO LEVEL 2 BATHROOMS. COORDINATE EXACT ROUTING IN THE FIELD.



Autodesk Docs/733-1408 Burnet County Annex/Burnet County\_M89\_RV02.rvt

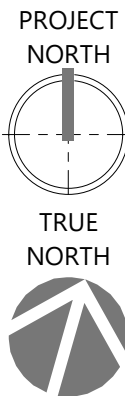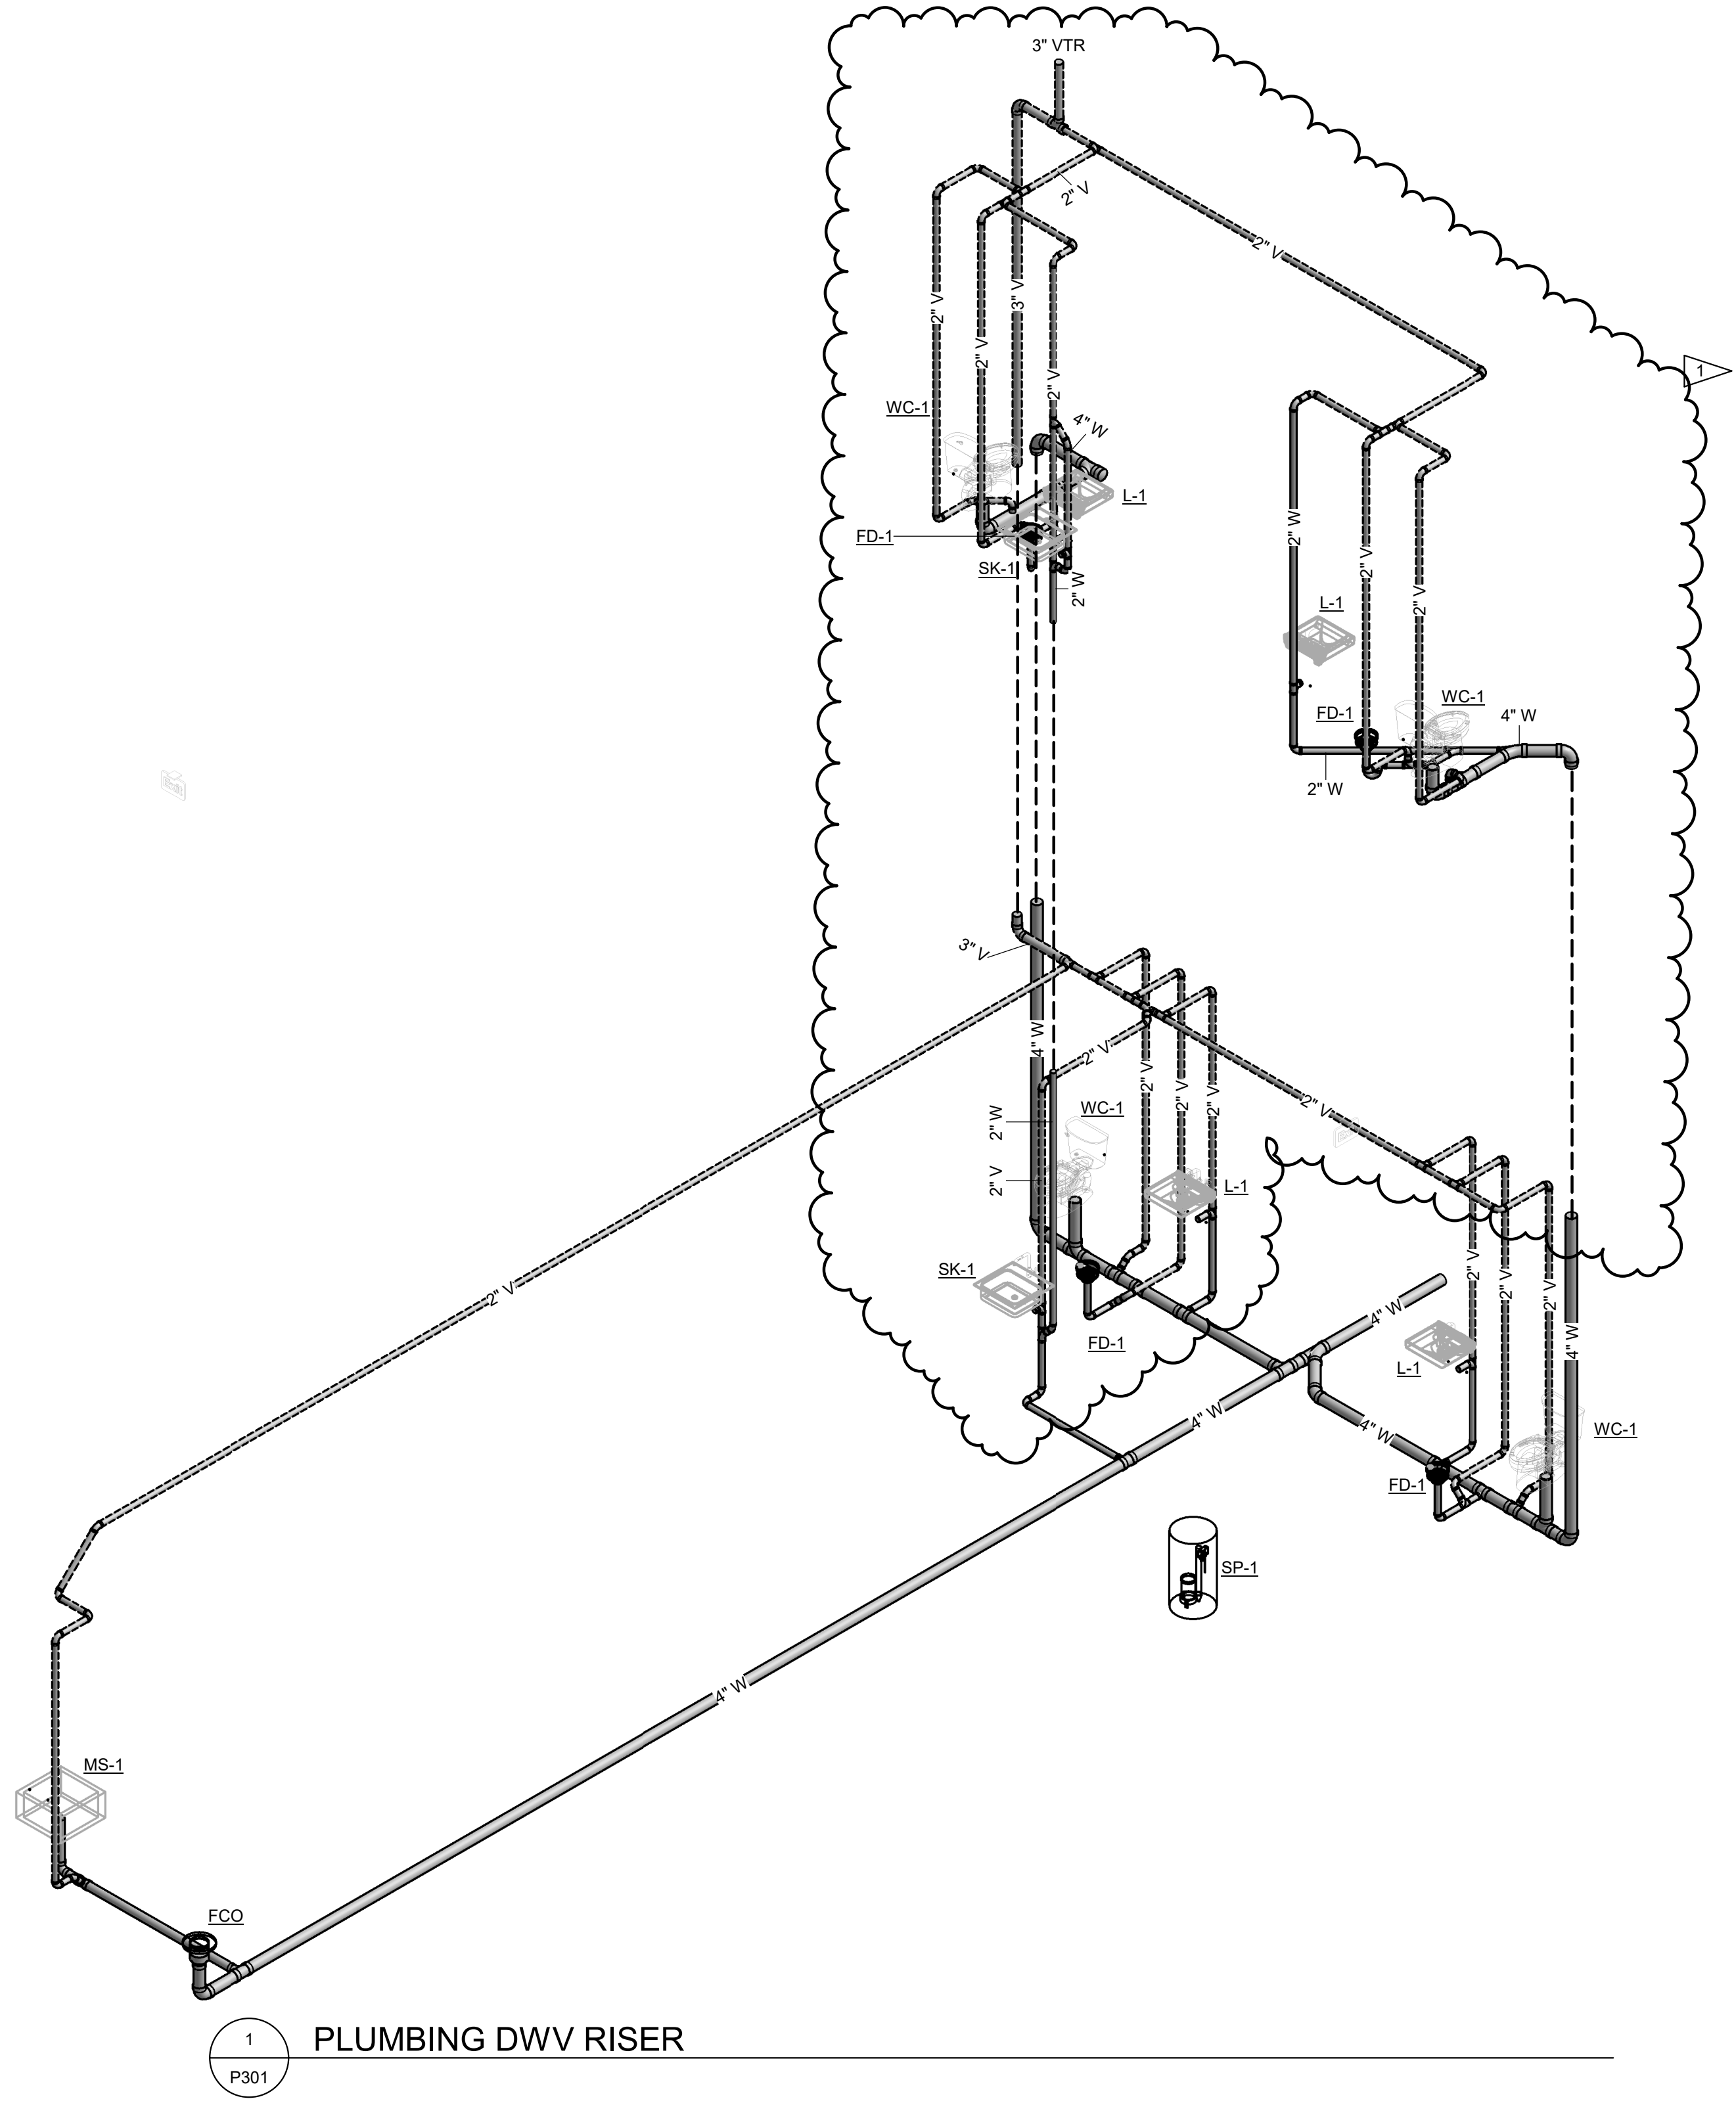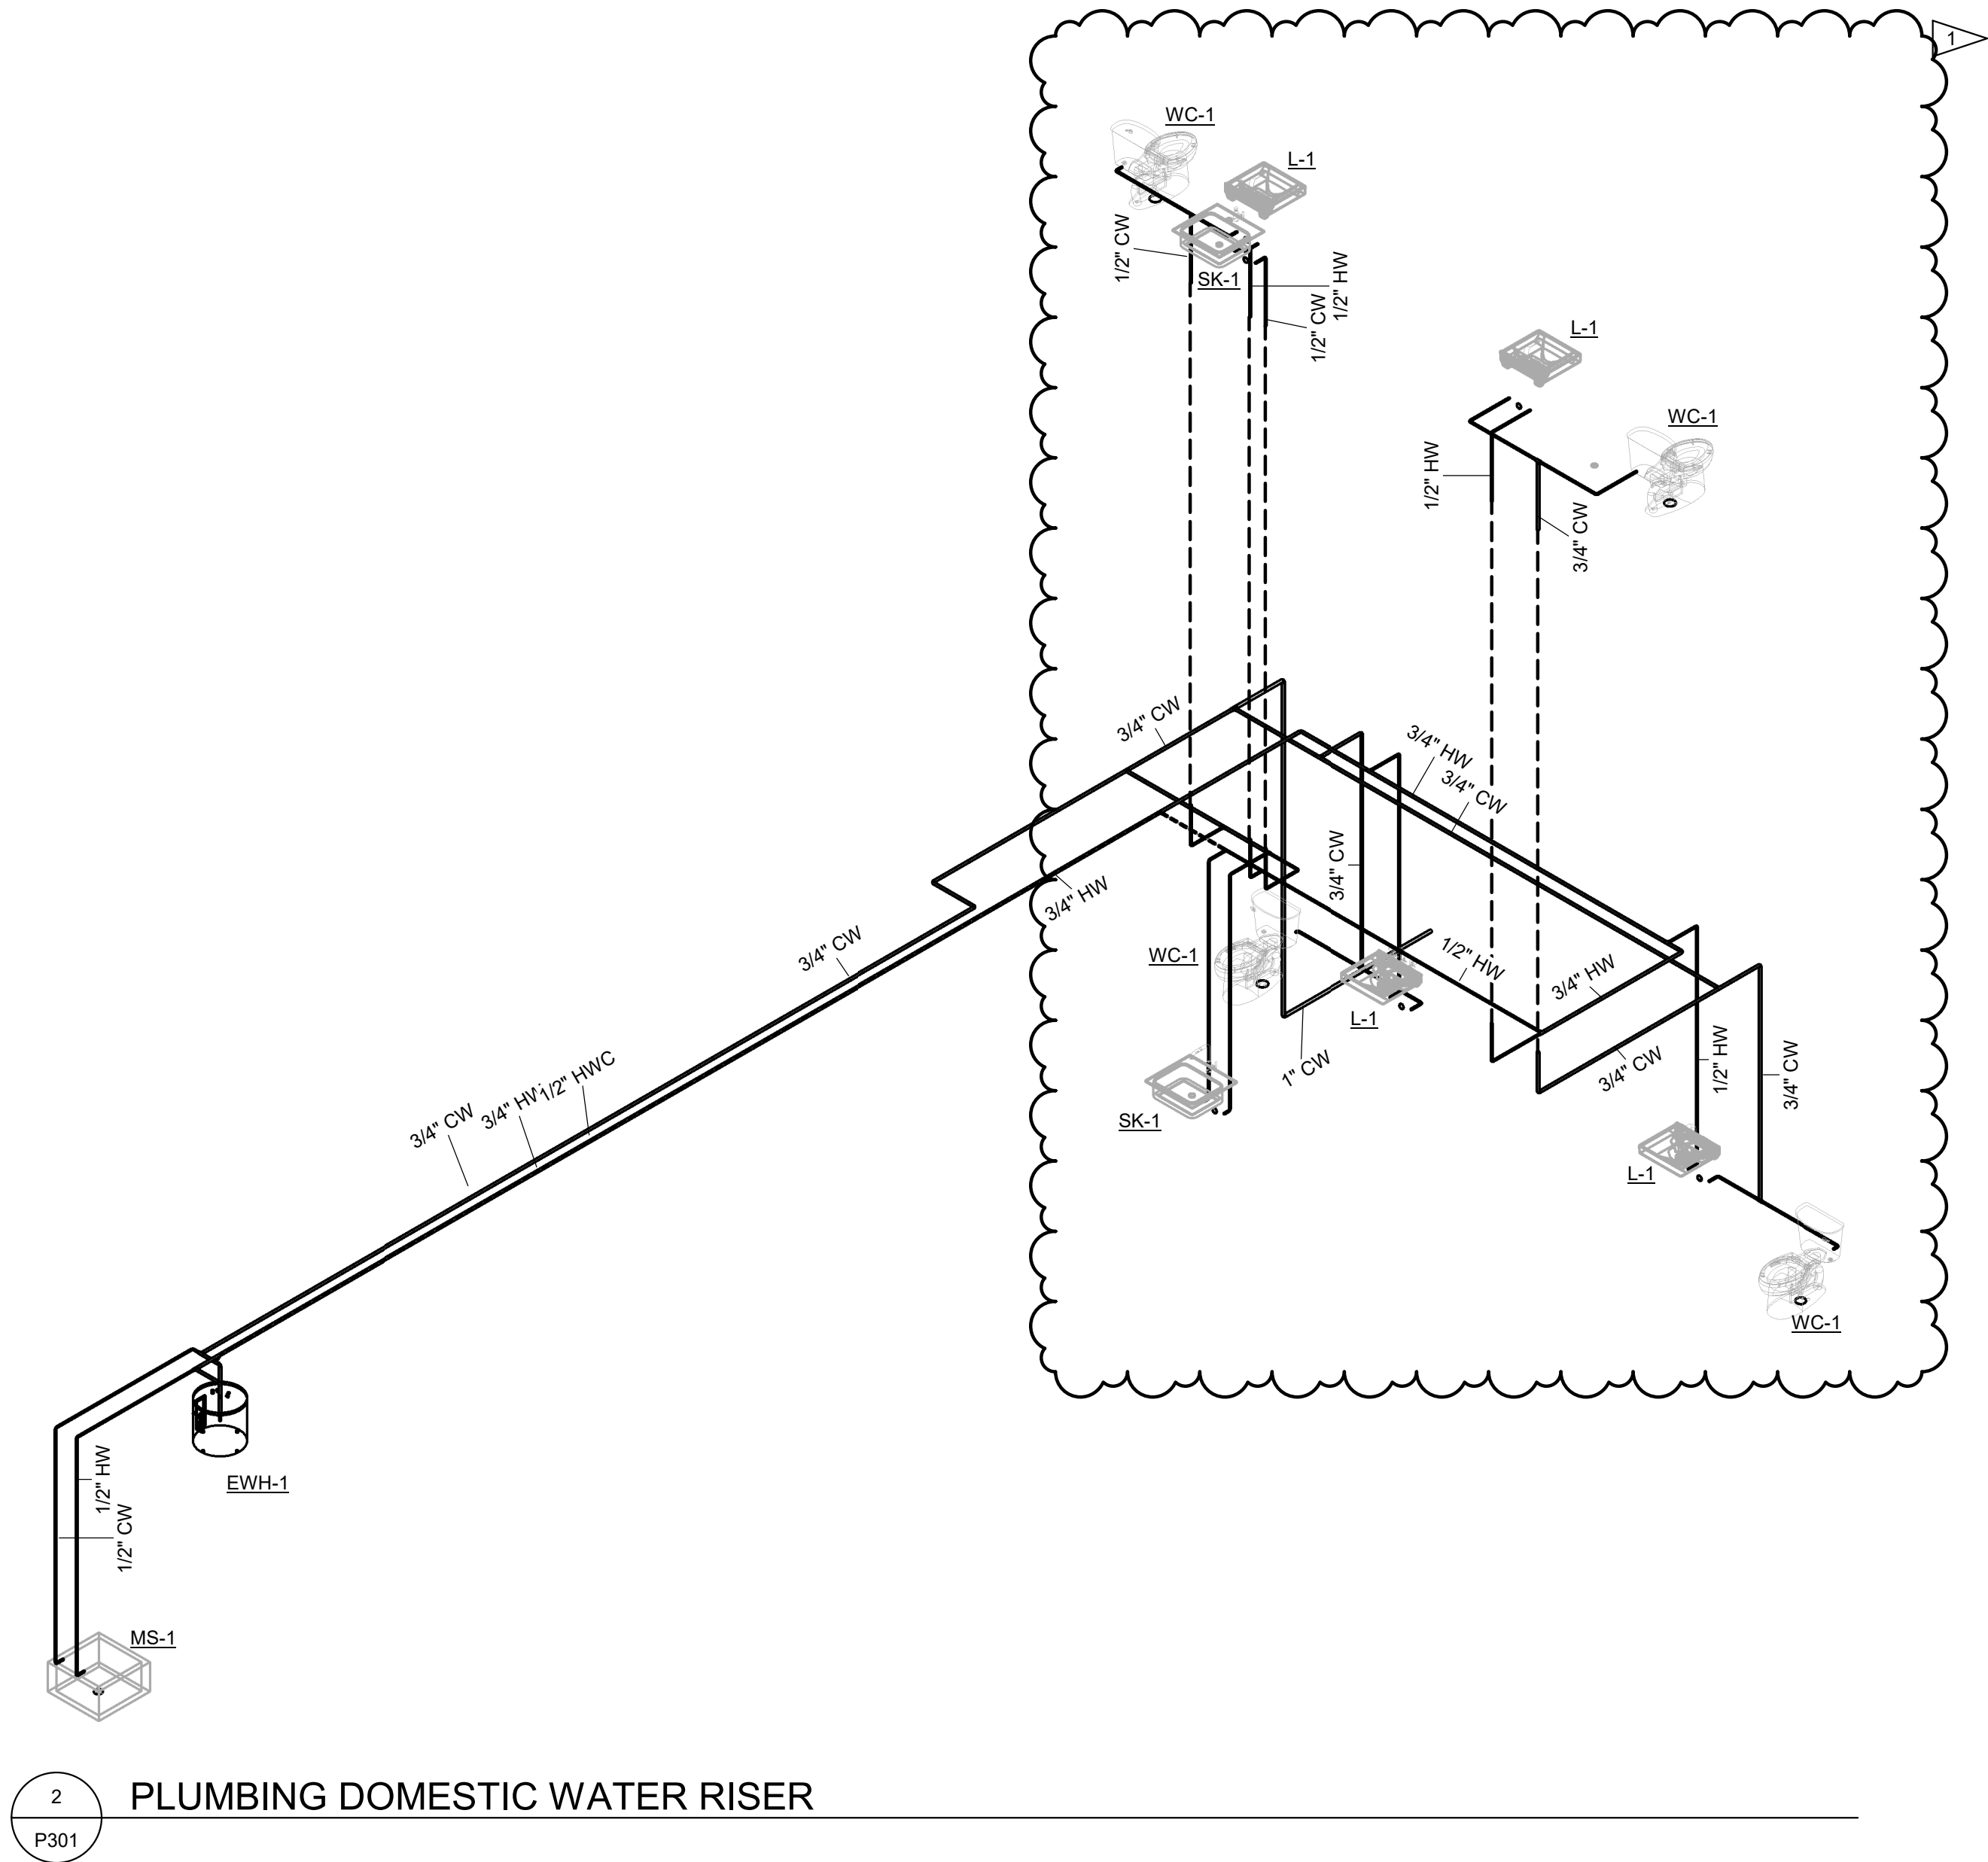

Project Number: 33-1408  
© 2024 LEVY DYKEMA  
**PLUMBING RISER  
DIAGRAMS**

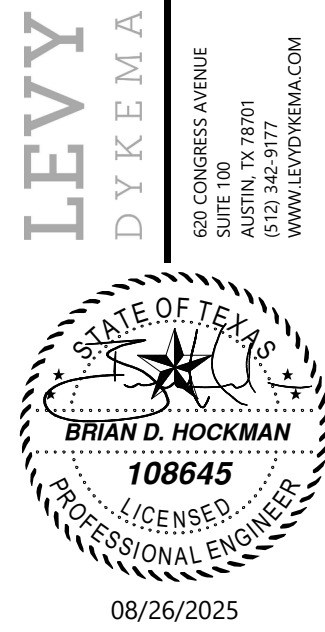

**BURNET COUNTY ANNEX**

127 E JACKSON ST. BURNET TX 78611

**P301**