


**GENERAL NOTES**

- ALL WORK SHALL BE PERFORMED PER 2020 NEC, AND ALL WORK SHALL BE PERFORMED IN COMPLIANCE WITH THE LATEST EDITION OF ALL LOCAL AMENDMENTS AND REGULATIONS AS ADOPTED BY THE CITY OF BURNET AND THE STATE OF TEXAS, AND THE PUBLICATIONS AND STANDARDS OF THE FOLLOWING AUTHORITIES, IN ADDITION TO THOSE SPECIFIED IN RELATED SUPPLEMENTARY CONDITIONS, WHICH ARE REFERENCED IN ELECTRICAL SPECIFICATIONS BY THE ABBREVIATIONS NOTED.
- UNITED STATES OF AMERICA STANDARDS INSTITUTE - USASI INSTITUTE OF ELECTRICAL AND ELECTRONIC ENGINEERS - IEEE NATIONAL ELECTRICAL CODE - NEC NATIONAL FIRE PROTECTION ASSOCIATION - NFPA UNDERWRITERS LABORATORIES - UL NATIONAL ELECTRICAL MANUFACTURERS ASSOCIATION - NEMA AMERICAN SOCIETY OF TESTING MATERIALS - ASTM OCCUPATIONAL SAFETY AND HEALTH ACT - OSHA
- ALL WORK SHALL BE DONE IN ACCORDANCE WITH THE CONTRACT DOCUMENTS, PLANS AND THE SPECIFICATIONS, AND SHALL BE PERFORMED WITH THE LATEST INDUSTRY ACCEPTED STANDARDS.
- THE INTENT OF THIS CONSTRUCTION PACKAGE IS TO ILLUSTRATE ALL THE WORK TO BE ACCOMPLISHED TO PROVIDE AN ELECTRICAL INSTALLATION COMPLETE IN EVERY RESPECT. CARE HAS BEEN TAKEN TO INDICATE THE COMPLETE SCOPE OF WORK REQUIRED FOR THIS PROJECT. HOWEVER, IT IS NOT THE INTENT TO INDICATE EVERY CONFLICT WHICH MAY ARISE, AND PROVIDE FOR SUCH ON THESE DOCUMENTS. NO ASSURANCE IS GIVEN THAT THE PLANS COMPLETELY REFLECT ACTUAL JOB SITE CONDITIONS. IF IT IS DISCOVERED IN THE FIELD THAT ACTUAL LOCATIONS OR CONDITIONS DIFFER GREATLY FROM THOSE SHOWN, CONTRACTOR SHALL GET APPROVAL FROM OWNER PRIOR TO COMMENCING WORK.
- CONTRACTOR SHALL VISIT THE SITE AND FIELD VERIFY THE PROPOSED INSTALLATION LOCATION AND ALL WORKING CONDITIONS SUCH AS STARTING TIME, NOISE LIMITATIONS, CONFINED SPACE LIMITATIONS, OFFSETS AND ROUTING ADJUSTMENTS THAT MAY BE REQUIRED, ETC., TO COMPLETE THE WORK. CONTRACTOR SHALL COORDINATE WITH THE OWNER REGARDING OBSTRUCTION OF ROADWAY OR DRIVEWAY AREAS, ON SITE MATERIALS AND EQUIPMENT STORAGE, AND BUILDING ACCESS. SITE INSPECTION SHALL DETERMINE CONDITION OF EXISTING ELEMENTS TO BE PROTECTED.
- CONTRACTOR SHALL BE RESPONSIBLE FOR ADEQUATELY BRACING AND PROTECTING ALL WORK DURING CONSTRUCTION AGAINST DAMAGE, BREAKAGE, COLLAPSE, AND MISALIGNMENT ACCORDING TO APPLICABLE CODES, STANDARDS, AND GOOD CONSTRUCTION PRACTICES. CONTRACTOR SHALL TAKE PROPER PRECAUTIONS TO PROTECT ALL EXISTING OPERATIONS AND PROPERTY ADJACENT WITH WHICH WORK COMES IN CONTACT, OR OVER OR UNDER WHICH HE MAY TRANSPORT, HOIST, OR MOVE MATERIALS, EQUIPMENT, DEBRIS, ETC. CONTRACTOR SHALL BE RESPONSIBLE FOR REPAIR AND/OR REPLACEMENT IN KIND OF ALL INADVERTENT DAMAGE TO EXISTING SYSTEMS.
- ALL NECESSARY PERMITS, LICENSES, CERTIFICATES, TESTS, ETC., SHALL BE PROCURED AND PAID FOR BY THE CONTRACTOR.
- THE DRAWINGS SHALL NOT BE SCALED FOR CONSTRUCTION INSTALLATION DIMENSIONS. ALL CONDUIT ROUTING ARE SHOWN IN APPROXIMATE LOCATIONS ONLY. THE CONTRACTOR SHALL BE RESPONSIBLE FOR FIELD VERIFICATION OF CONDITIONS, AND SHALL PERFORM FIELD MEASUREMENTS PRIOR TO FABRICATION AND/OR PURCHASE OF ANY EQUIPMENT AND MATERIAL. REFERENCE ALL DETAILS FOR ADDITIONAL CONSTRUCTION REQUIREMENTS. DETAILS MAY NOT BE REFERENCED ON THE DRAWING(S), BUT ARE INTENDED TO BE TYPICAL THROUGHOUT UNLESS OTHERWISE NOTED.
- DO NOT BEGIN WORK IF ANY DISCREPANCIES OR CONFLICTS EXIST OR ARE DISCOVERED BETWEEN SYSTEMS, UTILITIES, UNTIL THE DISCREPANCIES HAVE BEEN RESOLVED. IMMEDIATELY CALL SUCH DISCREPANCIES OR CONFLICTS TO THE ATTENTION OF THE OWNER'S CONSTRUCTION REPRESENTATIVE AND/OR ENGINEER. SHOULD ANY CONFLICTS OR AMBIGUITIES EXIST IN THE DRAWINGS, NOTES, OR SPECIFICATIONS, BRING THESE TO THE ATTENTION OF THE ENGINEER IMMEDIATELY BEFORE PROCEEDING WITH WORK.
- THE CONTRACTOR SHALL BE RESPONSIBLE FOR ENSURING FULL COORDINATION WITH ALL TRADES TO ACCOMPLISH THE WORK AS INDICATED AND NOTED IN CONTRACT DOCUMENTS. COORDINATE WITH OWNER'S REPRESENTATIVE, AND MAINTAIN A SET OF ALL CHANGES BETWEEN THE DRAWINGS AND THE ACTUAL CONSTRUCTION. CONFLICTS ARISING DUE TO LACK OF COORDINATION SHALL BE THE RESPONSIBILITY OF, AND AT THE EXPENSE OF, THE CONTRACTOR. FINAL AS-BUILT DRAWINGS ARE TO BE DELIVERED TO THE OWNER/ENGINEER AND THE FINAL INVOICE FOR THE CONTRACT WILL NOT BE PAID UNTIL THESE AS-BUILT DRAWINGS ARE RECEIVED.
- WORK AREAS ARE TO BE KEPT FREE OF DEBRIS AT ALL TIMES AND ARE TO BE LEFT BROOM CLEAN AT THE END OF EACH WORKING DAY. THE CONTRACTOR SHALL DISPOSE OF OFF-SITE. ALL MATERIALS REMOVED WHICH ARE NOT BE REINSTALLED OR SALVAGED ON THE PROJECT, UNLESS DIRECTED OTHERWISE BY OWNER. DISPOSAL OF MATERIAL SHALL BE IN ACCORDANCE WITH ACCEPTABLE METHODS APPROVED BY OWNER AND COORDINATED THROUGH OWNER'S COORDINATOR.
- THE CONTRACTOR SHALL BE RESPONSIBLE FOR MAINTAINING THE RATING OF ALL PENETRATIONS THROUGH FIRE AND SMOKE RATED SURFACES. THE CONTRACTOR SHALL COMPLY WITH UL LISTING INSTRUCTIONS FOR PENETRATIONS THROUGH RATED SURFACES.
- THE CONTRACTOR SHALL BE RESPONSIBLE FOR TRAINING OF HIS EMPLOYEES AND SUBCONTRACTORS IN THE RECOGNITION AND AVOIDANCE OF UNSAFE CONDITIONS, AND IN THE REGULATIONS AND HAZARDS WHICH APPLY TO THE AREA IN WHICH THE WORK WILL TAKE PLACE. ALL SAFETY EXPOSURES OR VIOLATIONS BROUGHT TO THE ATTENTION OF THE CONTRACTOR SHALL BE RECTIFIED IMMEDIATELY.
- THE CONTRACTOR SHALL BE RESPONSIBLE FOR PROVIDING PROTECTION OF PERSONS AND PROPERTY, AND FOR PROVIDING SAFE WORKING CONDITIONS THROUGHOUT THE WORK PROCESS. CONTRACTOR SHALL PROVIDE TEMPORARY COVERINGS FOR OPENINGS THROUGH WALLS OR FLOORS, AND PROVIDE TEMPORARY BARRIERS, PARTITIONS AND OR DUST BARRIERS WHERE REQUIRED TO MAINTAIN OSHA AND THE OWNER'S SAFETY STANDARDS AND TO PREVENT DAMAGE TO PROPERTY. ALL AREAS ADJACENT TO THE CONSTRUCTION AREA OR AFFECTED BY THE CONSTRUCTION MUST BE PROTECTED FROM DAMAGE, CLEANED AND RESTORED TO THEIR ORIGINAL CONDITION AT THE END OF THE PROJECT. WELDING BLANKETS SHALL BE UTILIZED FOR PROTECTION OF COMBUSTIBLE MATERIALS IN AREA WHERE WELDING OR CUTTING WITH A TORCH IS CONDUCTED.
- ALL WORK SHALL BE GUARANTEED AGAINST DEFECTIVE MATERIALS AND WORKMANSHIP FOR A PERIOD OF NO LESS THAN ONE (1) YEAR AFTER THE DATE OF SUBSTANTIAL COMPLETION OR ACCEPTANCE OF THE WORK. THE CONTRACTOR SHALL REPAIR OR REPLACE, AT HIS OWN EXPENSE WHEN ORDERED TO DO SO, ALL WORK THAT MAY DEVELOP DEFECTS IN MATERIAL OR WORKMANSHIP WITHIN SAID PERIOD OF TIME. ALL EQUIPMENT SHALL BE INSTALLED IN ACCORDANCE WITH MANUFACTURER'S RECOMMENDATIONS FOR SERVICE INTENDED. AS INTERPRETED BY THE ENGINEER, THE INSTALLATION OF ALL EQUIPMENT SHALL BE MADE BY EXPERIENCED CRAFTSMAN IN A NEAT, WORKMANLIKE MANNER. ALL MATERIALS, TOOLS, COSTS, AND SERVICES NECESSARY TO COMPLETELY INSTALL ALL ELECTRICAL WORK SHALL BE PROVIDED BY THE CONTRACTOR.

- ALL PROPOSED EQUIPMENT INSTALLED ON THIS PROJECT SHALL BE NEW AND UNUSED UNLESS NOTED OTHERWISE. ALL EQUIPMENT SHALL BE LABELED AND LISTED OR THE INTENDED USE. THE ELECTRICAL CONTRACTOR SHALL REMOVE ALL LABELS, DIRT, PAINT SPOTS, GREASE AND STAINS FROM ALL ELECTRICAL EQUIPMENT AND SHALL CLEAN ALL EQUIPMENT AS NECESSARY. NO LOOSE PARTS OR SCRAPS OF EQUIPMENT SHALL BE LEFT ON THE PREMISES. EQUIPMENT LOCATION AND ROUTING IS APPROXIMATE AND SHALL BE PLACED TO PROVIDE PROPER ACCESS AND CLEARANCE FROM OTHER TRADES AND EQUIPMENT.
- ALL WIRING SHALL BE THWN/THHN, 98% CONDUCTIVITY COPPER, STANDARD CONDUCTOR, 600V INSULATION. ALL WIRING SHALL BE INSTALLED IN RIGID CONDUIT AND CONTINUOUS (WITHOUT SPLICES).
- A GREEN GROUNDING CONDUCTOR SHALL BE PROVIDED WITH ALL BRANCH AND FEEDER CIRCUITS. SIZE PER N.E.C. 250-122 UNLESS NOTED OTHERWISE. ALSO PROVIDE A SEPARATE DEDICATED INSULATED AND ISOLATED GROUNDING CONDUCTOR FOR ISOLATED GROUND CIRCUITS. UPON COMPLETION OF THE WORK, ALL PARTS OF THE ELECTRICAL INSTALLATION SHALL BE TESTED AND PROVED TO BE FREE OF UNWANTED GROUNDS AND OTHER DEFECTS.
- ALL EXTERIOR CONDUIT SHALL BE RIGID GALVANIZED STEEL CONDUIT. FITTINGS SHALL BE STEEL THREADED TYPE. MOUNT THE CONDUIT AS HIGH AS POSSIBLE AND RUN PARALLEL AND PERPENDICULAR TO STRUCTURE. ALL OTHER CONDUIT SHALL BE EMT WITH STEEL COMPRESSION OR STEEL SET SCREW FITTINGS, 3/4" MIN., UNLESS NOTED OTHERWISE.
- KEEP RACEWAYS AT LEAST SIX INCHES AWAY FROM PARALLEL RUNS OF FLUES AND STEAM OR HOT WATER PIPES. INSTALL HORIZONTAL RACEWAY RUNS ABOVE WATER AND STEAM PIPING.
- ELECTRICAL CONTRACTOR SHALL PROVIDE AND INSTALL PULL WIRES IN EMPTY RACEWAYS. USE NO. 14 AWG ZINC-COATED STEEL OR MONOFILAMENT PLASTIC LINE HAVING NOT LESS THAN 200-LB TENSILE STRENGTH.
- CHANNEL AND ANGLE SUPPORT SYSTEMS, HANGERS, ANCHORS, SLEEVES, AND FASTENERS SHALL BE DESIGNED TO PROVIDE SECURE SUPPORT FROM THE BUILDING STRUCTURE FOR ELECTRICAL COMPONENTS. SUPPORTING DEVICES SHALL BE HOT DIPPED GALVANIZED STEEL CONFORM TO MANUFACTURER'S RECOMMENDATIONS FOR SELECTING SUPPORTS. SUPPORT PARALLEL RUNS OF HORIZONTAL RACEWAYS TOGETHER ON TRAPEZOID OR BRACKET TYPE HANGERS.
- PULL BOXES SHALL BE GALVANIZED SHEET METAL WITH SCREW-ON COVERS AND WELDED SEAMS, STAINLESS STEEL NUTS, BOLTS, SCREWS AND WASHERS. BOXES SHALL BE SIZED IN ACCORDANCE WITH THE NEC.
- UNLESS OTHERWISE NOTED ALL 120V SINGLE PHASE CIRCUITS WILL REQUIRE A INDIVIDUAL NEUTRAL CONDUCTOR - INCLUDING MULTI-CIRCUITS COMBINED IN SINGLE CONDUIT RUNS.

**INTERIOR BOX MOUNTING HEIGHTS**

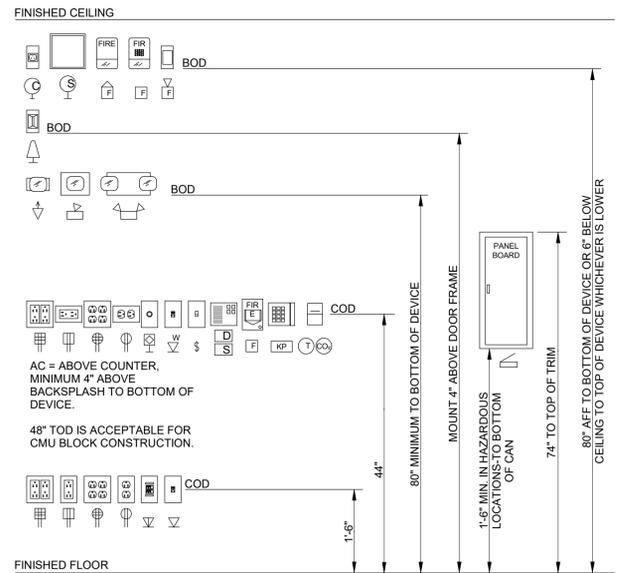

**ADDITIONAL MOUNTING HEIGHTS**

- cB 44" COD.
- cEPB 44" COD.
- cEPC 44" COD.
- c 44" COD.
- o 44" COD.

**CONTROL EQUIPMENT SCHEDULE**

UNIT	ITEMS BY OTHERS				ITEMS BY ELECTRICAL CONTRACTOR				INST. BY	FURN. BY	NOTES
	DESCRIPTION	VOLTAGE	PHASE	FLA	DISCONNECT	AMPS	NEMA ENCLOSURE	CONTROL DEVICES			
CU-1-1	CONDENSING UNIT	208 V	1	36A	NON-FUSED	60A	NEMA 3R	FCU-1-1	MC	MC	4
CU-2-1	CONDENSING UNIT	208 V	1	32A	NON-FUSED	60A	NEMA 3R	FCU-2-1	MC	MC	4
CU-IT-MAIN	CONDENSING UNIT	208 V	1	34.0	NON-FUSED	60A	NEMA 3R	FCU-IT-MAIN	MC	MC	1, 4
CU-LAB	CONDENSING UNIT	208 V	1	22.0	NON-FUSED	30A	NEMA 3R	FCU-LAB	MC	MC	1, 4
EF-1-1 thru EF-1-3	EXHAUST FAN	120 V	1	1A	MOTOR RATED	15A	NEMA 1	OCCUPANCY SENSOR	EC	EC	2, 4
EF-2-1 & EF-2-2	EXHAUST FAN	120 V	1	1A	MOTOR RATED	15A	NEMA 1	OCCUPANCY SENSOR	EC	EC	2, 4
EW-H-1	ELECTRIC WATER HEATER	208 V	1	12A	MOTOR RATED	20A	NEMA 1	---	---	---	4
FCU-1-1	FAN COIL UNIT	208 V	1	25A	NON-FUSED	30A	NEMA 1	THERMOSTAT	MC	MC	3, 4
FCU-2-1	FAN COIL UNIT	208 V	1	25A	NON-FUSED	30A	NEMA 1	THERMOSTAT	MC	MC	3, 4

- NOTES:**
- FCU POWERED BY CU. PROVIDE WIRE AND CONDUIT PER NEC.
  - INTERLOCK WITH OCCUPANCY SENSORS IN MEN'S AND WOMEN'S RESTROOMS.
  - UNIT PROVIDED WITH DUCT SMOKE DETECTOR, CONNECT TO FIRE ALARM SYSTEM.
  - ELECTRICAL CONTRACTOR TO MAKE FINAL CONNECTION AS NOTED IN PLANS.

**ELECTRICAL LEGEND**

SYMBOL	DESCRIPTION	SYMBOL	DESCRIPTION	SYMBOL	DESCRIPTION
[Symbol]	LAY-IN OR RECESSED FIXTURE, SIZE ON PLANS	AC	ABOVE COUNTER, 4" BACK SPLASH	\$	SWITCH - SPST
[Symbol]	WALL MOUNTED FIXTURE, SIZE ON PLANS	ATS	AUTOMATIC TRANSFER SWITCH	2	SINGLE POLE, DOUBLE THROW
[Symbol]	SURFACE MOUNTED FIXTURE, SIZE ON PLANS	AFG	ABOVE FINISHED GRADE	3	THREEWAY
[Symbol]	PENDANT OR SURFACE MOUNTED FIXTURE, SIZE ON PLANS	AFB	ABOVE FINISHED FLOOR	4	FOURWAY
[Symbol]	PENDANT MOUNTED FIXTURE, SIZE ON PLANS	BLG	BELOW GRADE	K	KEY OPERATED
[Symbol]	SHADED FIXTURE INDICATES FIXTURE IS UNSWITCHED AND ALSO INDICATES EMERGENCY POWER.	BOD	BOTTOM OF DEVICE	P	PILOT LIGHT
[Symbol]	RECESSED DOWNLIGHT FIXTURE	C	CONDUIT	OS	WEATHERPROOF OCCUPANCY SENSOR (DUAL TECHNOLOGY)
[Symbol]	SURFACE MOUNTED FIXTURE	CAS	CARD ACCESS SYSTEM	D	DIMMER
[Symbol]	WALL MOUNTED FIXTURE	CCTV	CLOSED CIRCUIT TV	MC	SPOT-MOMENTARY CONTACT
[Symbol]	WALL WASH OR DIRECTIONAL FIXTURE	CLG	CEILING	LV	LOW VOLTAGE
[Symbol]	WALL SCONCE FIXTURE	COD	CENTER OF DEVICE	T	TIMER SWITCH
[Symbol]	TRACK FIXTURE, SEE PLAN FOR SIZE AND HEADS	CU	COPPER	TS	TEST SWITCH
[Symbol]	CEILING FAN FIXTURE	DVR	DIGITAL VIDEO RECORDER	VS	VACANCY SENSOR (DUAL TECHNOLOGY) WITH DIMMING
[Symbol]	CEILING MOUNTED, WALL MOUNTED EXIT LIGHT (W/ DIRECTIONAL ARROWS)	(E)	EXISTING	OS1	OCCUPANCY SENSOR SWITCH (CEILING) - SUBSCRIPT IS TYPE
[Symbol]	1 HEAD REMOTE EMERGENCY LIGHT	EC	ELECTRICAL CONTRACTOR	[Symbol]	RECEPTACLE - SIMPLEX
[Symbol]	2 HEAD EMERGENCY LIGHT BATTERY PACK	EF	EXHAUST FAN	[Symbol]	RECEPTACLE - DUPLEX, MOUNTING IN CEILING
[Symbol]	1 HEAD REMOTE EMERGENCY LIGHT BATTERY PACK	GC	GENERAL CONTRACTOR	[Symbol]	GFI RECEPTACLE - DUPLEX, MOUNTING IN CEILING
[Symbol]	2 HEAD LIGHT WITH MOTION SENSOR	GND	GROUND	[Symbol]	RECEPTACLE - DUPLEX (GROUND FAULT INTERRUPT)
[Symbol]	SQUARE POLE MOUNTED FIXTURE, EXTERIOR	LSI	FIELD ADJUSTABLE LONG TIME, SHORT TIME AND INSTANTANEOUS	[Symbol]	GFI RECEPTACLE - DUPLEX (GROUND FAULT INTERRUPT) DEVICE RECEIPT W/2 USB PORTS
[Symbol]	ROUND POLE MOUNTED FIXTURE, EXTERIOR	LSIG	FIELD ADJUSTABLE LONG TIME, SHORT TIME, INSTANTANEOUS AND GROUND FAULT	[Symbol]	DC DROP CORD
[Symbol]	POST TOP FIXTURE, EXTERIOR	MC	MECHANICAL CONTRACTOR	[Symbol]	WP WEATHERPROOF COVER & WEATHER RESISTANT RECEPTACLE
[Symbol]	BOLLARD FIXTURE, EXTERIOR	(N)	NEW	[Symbol]	TR TAMPER RESISTANT
[Symbol]	DIRECTIONAL INGROUND FIXTURE, EXTERIOR	NL	NIGHT LIGHT	[Symbol]	S SURGE PROTECTED
[Symbol]		PTZ	PAN-TILT-ZOOM	[Symbol]	W WELDER - NEMA 14-50R
[Symbol]		QTY	QUANTITY	[Symbol]	* NEMA CONFIGURATION AS NOTED
[Symbol]		(R)	RELOCATED	[Symbol]	208V RECEPTACLE IN RECESSED FLOORBOX
[Symbol]		SF	SURFACE	[Symbol]	DUPLEX RECEPTACLE/GFI IN RECESSED FLOORBOX
[Symbol]		TBB	TELECOMMUNICATIONS BONDING BACKBONE	[Symbol]	DOUBLE DUPLEX RECEPTACLE/GFI IN RECESSED FLOORBOX
[Symbol]		TC	TEMPERATURE CONTROL CONTRACTOR	[Symbol]	J-BOX - BOX INDICATES FLOOR MOUNTING - 4"x4"x2-1/8" DEEP UNLESS OTHERWISE NOTED
[Symbol]		TMBG	TELECOMMUNICATIONS MAIN GROUPING BUS BAR	[Symbol]	POWER POLE
[Symbol]		TTB	TELEPHONE TERMINAL BOARD	[Symbol]	THERMOSTAT/TEMPERATURE SENSOR BY MC OR TC, J-BOX AND CONDUIT TO CEILING BY EC
[Symbol]		TYP	TYPICAL	[Symbol]	CARBON MONOXIDE DETECTOR BY MC, J-BOX & CONDUIT TO CEILING BY EC
[Symbol]		UG	UNDERGROUND	[Symbol]	MANUAL MOTOR DISCONNECT/STARTER SWITCH
[Symbol]		UON	UNLESS OTHERWISE NOTED	[Symbol]	EMERGENCY PUSHBUTTON
[Symbol]		W	WITH	[Symbol]	RELAY
[Symbol]		WM	WIRE MOLD	[Symbol]	PHOTOCELL, PHOTOCELL WALL MOUNTED
[Symbol]		WP	WEATHER PROOF (WHILE IN USE)	[Symbol]	SPECIAL PURPOSE CONNECTION - BOX INDICATES FLOOR MOUNTING - WORK AS NOTED
[Symbol]		XFMR	TRANSFORMER	[Symbol]	ELECTRIC MOTOR CONNECTION
[Symbol]		a.b.c etc	SWITCH DESIGNATION	[Symbol]	COMBINATION STARTER/DISCONNECT SWITCH
[Symbol]		BN1L-2,4,6	CIRCUIT DESIGNATION, PANEL BN1L, CIRCUITS 2,4,6	[Symbol]	DISCONNECT SWITCH
[Symbol]		1/E501	CIRCUITS DETAIL 1 ON SHEET E501	[Symbol]	CONTACTOR
[Symbol]		(1)	SHEET WORK NOTE	[Symbol]	CIRCUIT BREAKER
[Symbol]		(1)	SHEET DEMO WORK NOTE	[Symbol]	VARIABLE FREQUENCY DRIVE
[Symbol]			HOME RUN TO PANEL	[Symbol]	CONTROL PANEL
[Symbol]			CONDUIT CONCEALED IN CEILING OR WALL	[Symbol]	LRP LIGHTING RELAY PANEL
[Symbol]			CONDUIT CONCEALED UNDER FLOOR	[Symbol]	TGP TEMPERATURE CONTROL PANEL
[Symbol]			LOW VOLTAGE CIRCUIT	[Symbol]	GAP GENERATOR ANNUNCIATOR PANEL
[Symbol]			FIBER OPTIC CABLE	[Symbol]	PACP PA CONTROL PANEL
[Symbol]			CABLE TRAY	[Symbol]	MGA MED GAS ALARM PANEL
[Symbol]			CIRCUIT, NUMBER OF HASH MARKS INDICATES NUMBER OF CONDUCTORS IN CABLE/RACEWAY. GROUND WIRE IS NOT SHOWN BUT SHALL BE INCLUDED. NO HASH MARKS INDICATES 2 CONDUCTORS PLUS GROUND.	[Symbol]	TIME CLOCK
[Symbol]				[Symbol]	EXISTING PANELBOARD, SURFACE MOUNTED
[Symbol]				[Symbol]	EXISTING PANELBOARD, FLUSH MOUNTED
[Symbol]				[Symbol]	PANELBOARD, SURFACE MOUNTED
[Symbol]				[Symbol]	PANELBOARD, FLUSH MOUNTED
[Symbol]				[Symbol]	ELECTRIC METER, BUILDING MOUNTED
[Symbol]				[Symbol]	TRANSFORMER, INTERIOR
[Symbol]				[Symbol]	TRANSFORMER, EXTERIOR
[Symbol]				[Symbol]	SECURITY CAMERA



DIVISION 26 - ELECTRICAL SCOPE THE PROVISIONS, TERMS AND REQUIREMENTS OF DIVISION 1 AND 2, THE APPLICABLE DRAWINGS AND TECHNICAL SPECIFICATIONS HEREIN SHALL APPLY TO WORK UNDER THIS DIVISION.

THIS WORK CONSISTS OF, BUT IS NOT NECESSARILY LIMITED TO, THE FURNISHING OF ALL LABOR, EQUIPMENT, APPLIANCES AND MATERIALS AND THE OPERATION OF ALL OPERATIONS FOR THE COMPLETION OF WORK UNDER THIS DIVISION. INSTALLATION OF ALL ELECTRICAL WORK COMPLETED, IN STRICT ACCORDANCE WITH SPECIFICATIONS AND/OR DRAWINGS, APPLICABLE CODES, INCLUDING INCIDENTAL MATERIALS NECESSARY AND REQUIRED FOR THEIR COMPLETION.

"PROVIDE" = FURNISHED AND INSTALLED COMPLETE. "OR EQUAL" = OR EQUAL AS APPROVED TO QUOTE BY ENGINEER, 10 DAYS PRIOR TO BID.

280519 - CONDUCTORS AND CABLES

- A. SUBMIT SHOP DRAWINGS IN ACCORDANCE WITH THE "COMMON WORK RESULTS" SECTION.
B. ALL CONDUCTORS SHALL BE PROVIDED AND INSTALLED IN ACCORDANCE WITH NFPA 70, NEMA, UL NETA AT-1995, AND ALL OTHER APPLICABLE CODES.
C. MINIMUM CONDUCTOR SIZE FOR LIGHT AND POWER SHALL BE #12 AWG COPPER.
D. MC CABLE ALLOWED, IN CONCEALED WALL AND CEILING SPACES.
E. TIGHTEN ELECTRICAL CONNECTORS AND TERMINALS, INCLUDING SCREWS AND BOLTS, IN ACCORDANCE WITH MANUFACTURER'S PUBLISHED TORQUE TIGHTENING VALUES OR AS SPECIFIED IN UL CODES.
F. COLOR CODE SECONDARY SERVICE, FEEDER, AND BRANCH CIRCUIT CONDUCTORS WITH FACTORY APPLIED COLOR AS FOLLOWS:

Table with 3 columns: 208V/120 VOLTS, PHASE, 480Y/277 VOLTS. Rows include colors like BLACK, BLUE, WHITE, GREEN and their corresponding phase labels like B, C, NEUTRAL, GROUND.

280526 - GROUNDING AND BONDING

- A. SUBMIT SHOP DRAWINGS IN ACCORDANCE WITH THE "COMMON WORK RESULTS" SECTION.
B. INSTALL SEPARATE INSULATED EQUIPMENT GROUNDING CONDUCTORS FOR FEEDER AND BRANCH CIRCUITS IN COMPLIANCE WITH NFPA 70 ARTICLE 250.
C. PROVIDE #6 AWG MINIMUM GREEN INSULATED COPPER CONDUCTOR IN RACEWAY FROM GROUNDING ELECTRICAL SYSTEM TO EACH TELEPHONE, ALARM AND COMMUNICATIONS SYSTEMS TERMINAL BOARD, CABINET OR EQUIPMENT LOCATION.
D. SYSTEM GROUND - PROPERLY BOND SYSTEM NEUTRAL TO SYSTEM GROUND IN THE MAIN SERVICE APPARATUS.
E. GROUNDING ELECTRODE: USER GROUND FABRICATED ACCORDING TO NFPA 70, PARAGRAPH 250-52(A)(3).

280533 - RACEWAYS AND BOXES

- A. SUBMIT SHOP DRAWINGS IN ACCORDANCE WITH THE "COMMON WORK RESULTS" SECTION.
B. CONDUIT RACEWAY:
1. INDOORS: USE THE FOLLOWING, UNLESS OTHERWISE STATED:
2. OUTDOORS: USE THE FOLLOWING, UNLESS OTHERWISE STATED.
C. OUTLET BOXES:
1. CONFORM TO UL 514A, "METALLIC BOXES, ELECTRICAL," AND UL 514B, "FITTINGS FOR CONDUIT AND OUTLET BOXES."
D. PULL AND JUNCTION BOXES:
1. COMPLY WITH UL 50, "ELECTRICAL CABINETS AND BOXES."
E. ALL MATERIALS SHALL BE UL LISTED, APPROPRIATE FOR INTENDED APPLICATION. ENTIRE RACEWAY SYSTEM SHALL BE IN ACCORDANCE WITH NFPA 70, NEMA, UL, AND ALL OTHER APPLICABLE CODES.

282416 - PANELBOARDS

- A. SUBMIT SHOP DRAWINGS IN ACCORDANCE WITH THE "COMMON WORK RESULTS" SECTION.
B. MANUFACTURER: SIEMENS, SQUARE-D, GE OR CUTLER HAMMER.
C. LOAD CENTERS ARE NOT ACCEPTABLE UNLESS SPECIFICALLY NOTED.
D. PANELBOARDS SHALL HAVE ALUMINUM BUS INCLUDING NEUTRAL AND GROUND BARS.
E. PROVIDE TYPED CIRCUIT SCHEDULES FOR EXISTING PANELBOARDS WHERE LOADS HAVE CHANGED AND FRAMED TYPED CIRCUIT SCHEDULES FOR ALL NEW PANELBOARDS WITH IDENTIFICATION OF ITEMS CONTROLLED BY EACH INDIVIDUAL BREAKER.
282726 - WIRING DEVICES

- A. SUBMIT SHOP DRAWINGS IN ACCORDANCE WITH THE "COMMON WORK RESULTS" SECTION.
B. ACCEPTABLE MANUFACTURERS: PASS & SEYMORE, BRYANT, GE, HUBBELL, LEVITON.
C. DEVICES:
1. GENERAL LIGHT SWITCHES SHALL BE 20 AMP, 120/277 VOLT AC RATED AND INDUSTRIAL GRADE.
2. GENERAL RECEPTABLES SHALL BE SELF-GROUNDING 5-20R AND INDUSTRIAL GRADE (GFCI RATED) RECEPTABLES.
D. DEVICE PLATES:
1. DEVICE PLATES SHALL HAVE OPENING FOR DEVICE INTENDED AND SHALL BE LEXAN.
2. ALL DEVICE PLATES SHALL HAVE A CLEAR LABEL WITH THE PANEL AND CIRCUIT NUMBER DESIGNATION IN BLACK.
3. WEATHERPROOF RECEPTACLE COVERS SHALL BE A CORROSION RESISTANT DIE CAST METAL, MINIMUM 3/16" DEEP, FLIP COVER WITH LATCH AND WITH PAD LOCKING PROVISIONS.

282816 - CIRCUIT AND MOTOR DISCONNECTS

- A. SUBMIT SHOP DRAWINGS IN ACCORDANCE WITH THE "COMMON WORK RESULTS FOR ELECTRICAL" SECTION.
B. MANUFACTURER: SAME AS PANELBOARD MANUFACTURER.
C. DISCONNECTS SHALL BE HEAVY DUTY TYPE WITH CLASS R REJECTION FEATURE WHEN REQUIRED TO BE FUSIBLE.
D. STARTERS SHALL BE ACROSS-THE-LINE MAGNETIC TYPE, COMBINATION STARTER/DISCONNECT, FVNR, AND HP RATED.
E. ALL MOTOR CONTROLLERS SHALL BE UL LISTED AND INSTALLED IN ACCORDANCE WITH NFPA 70, NEMA, AND MANUFACTURER'S RECOMMENDATIONS.

282913 - MOTOR CONTROLLERS

- A. SUBMIT SHOP DRAWINGS IN ACCORDANCE WITH THE "COMMON WORK RESULTS" SECTION.
B. MANUFACTURER: SAME AS PANELBOARD MANUFACTURER.
C. UNLESS SCHEDULED OTHERWISE, 3/4 HORSEPOWER OR LESS SINGLE-PHASE MOTORS SHALL HAVE 1 HP RATED MANUAL TOGGLE STARTERS WITH THERMAL OVERLOAD PROTECTION SIGHT FOR THE MOTOR IN ACCORDANCE WITH NFPA 70.
D. STARTERS SHALL BE ACROSS-THE-LINE MAGNETIC TYPE, COMBINATION STARTER/DISCONNECT, FVNR, AND HP RATED.
E. ALL MOTOR CONTROLLERS SHALL BE UL LISTED AND INSTALLED IN ACCORDANCE WITH NFPA 70, NEMA, AND MANUFACTURER'S RECOMMENDATIONS.

285100 - LIGHTING

- A. SUBMIT SHOP DRAWINGS IN ACCORDANCE WITH THE "COMMON WORK RESULTS" SECTION.
B. MANUFACTURER, MODEL, STYLE, COLOR, SIZE, ETC., AS SCHEDULED. IF NO COLOR HAS BEEN SELECTED, PROVIDE FIXTURE WITH THE STANDARD FINISH AS PUBLISHED BY THE MANUFACTURER.
C. SUPPORT FOR RECESSED AND SEMI-RECESSED GRID-TYPE FLUORESCENT FIXTURES:
1. ALL LIGHTING FIXTURES SHALL BE POSITIVELY ATTACHED TO THE SUSPENDED CEILING SYSTEM BY MECHANICAL MEANS AS SPECIFIED IN THE NATIONAL ELECTRIC CODE, SECTION 410.6(C) UNLESS INDEPENDENTLY SUPPORTED.
D. SUPPORT FOR SUSPENDED FIXTURES: BRACE PENDANTS AND RODS OVER 48 INCHES LONG TO LIMIT SWINGING, SURPRISE MOUNTED, SINGLE-JOINT, SUSPENDED FLUORESCENT FIXTURES WITH TWIN-STEM HANGERS, FOR CONTINUOUS ROWS, USE TUBING OR STEM FOR WIRING AT ONE POINT AND TUBING OR ROD FOR SUSPENSION FOR EACH UNIT LENGTH OF CHASSIS, INCLUDING ONE AT EACH END.
E. SURFACE-MOUNTED LIGHT FIXTURES ATTACHED TO A CEILING GRID SHALL BE ATTACHED WITH POSITIVE CLAMPING DEVICES THAT COMPLETELY SURROUND THE SUPPORTING MEMBERS.
DIVISION 27 - COMMUNICATIONS
270500 - TELE-DATA COMMUNICATIONS
A. SUBMIT SHOP DRAWINGS IN ACCORDANCE WITH THE "COMMON WORK RESULTS" SECTION.
B. MANUFACTURERS: SIEMON, ICC, LEVITON, ORTRONICS, AMP, HUBBELL OR UNIPRISE.
C. BRANDING: MATERIALS SHALL HAVE NRTL LISTING IN COMPLIANCE WITH UL910, COMPLY WITH TIA/EIA-568-A AND NFPA 70 FOR PATHWAYS AND SPACES.
D. TELEPHONE/DATA ROOMS: WHERE TERMINAL BOARDS ARE INDICATED ON THE CONSTRUCTION DOCUMENTS, PROVIDE 3/4-INCH THICK INTERIOR GRADE PLYWOOD FROM FLOOR TO CEILING WITH FIRE RETARDANT PAINT ON ALL SIDES.
E. VOICE/DATA WORKSTATION ROUGH-INS: PROVIDE 4 INCH SQUARE, 2-1/8-INCH DEEP 1-GANG ROUGH-IN WITH 3/4-INCH CONDUIT STUBBED TO CEILING SPACE WITH A 90 DEGREE BEND AND INSULATED THROAT BUSHING, UNLESS OTHERWISE STATED.
F. WORKSTATION OUTLET ASSEMBLIES: (MODULES SHALL BE COLOR CODED FOR SERVICE TYPE, FACEPLATE/JACK COLOR SAME AS SPECIFIED IN THE WIRING DEVICES SECTION).

DIVISION 27 - COMMUNICATIONS

270500 - TELE-DATA COMMUNICATIONS

- A. SUBMIT SHOP DRAWINGS IN ACCORDANCE WITH THE "COMMON WORK RESULTS" SECTION.
B. MANUFACTURERS: SIEMON, ICC, LEVITON, ORTRONICS, AMP, HUBBELL OR UNIPRISE.
C. BRANDING: MATERIALS SHALL HAVE NRTL LISTING IN COMPLIANCE WITH UL910, COMPLY WITH TIA/EIA-568-A AND NFPA 70 FOR PATHWAYS AND SPACES.
D. TELEPHONE/DATA ROOMS: WHERE TERMINAL BOARDS ARE INDICATED ON THE CONSTRUCTION DOCUMENTS, PROVIDE 3/4-INCH THICK INTERIOR GRADE PLYWOOD FROM FLOOR TO CEILING WITH FIRE RETARDANT PAINT ON ALL SIDES.
E. VOICE/DATA WORKSTATION ROUGH-INS: PROVIDE 4 INCH SQUARE, 2-1/8-INCH DEEP 1-GANG ROUGH-IN WITH 3/4-INCH CONDUIT STUBBED TO CEILING SPACE WITH A 90 DEGREE BEND AND INSULATED THROAT BUSHING, UNLESS OTHERWISE STATED.
F. WORKSTATION OUTLET ASSEMBLIES: (MODULES SHALL BE COLOR CODED FOR SERVICE TYPE, FACEPLATE/JACK COLOR SAME AS SPECIFIED IN THE WIRING DEVICES SECTION).
1. WALL MOUNT TELEPHONE ASSEMBLY: STAINLESS STEEL WALL MOUNT PLATE WITH FLAT, CATEGORY 6, T568AB, RJ45 MODULE.
2. VOICE ONLY WALL JACK ASSEMBLIES: (1) ANGLED CATEGORY 6, T568AB, RJ45 MODULE AND (1) BLANK MODULE IN A MODULAR STYLE FACEPLATE.
3. DATA ONLY WALL JACK ASSEMBLIES: (1) ANGLED CATEGORY 6, T568AB, RJ45 MODULE AND (1) BLANK MODULE IN A MODULAR STYLE FACEPLATE.
G. CABLES:
1. HORIZONTAL WORKSTATION CABLING: CATEGORY 6 UNSHIELDED TWISTED PAIR (UTP) CABLE, 4 PAIR, COLOR CODED, THERMOPLASTIC-INSULATED CONDUCTORS IN POLYVINYL CHLORIDE (PVC) JACKET.
2. VERTICAL BACKBONE CABLING: CATEGORY 6 UNSHIELDED TWISTED PAIR (UTP) CABLE, 25 PAIR FOR RAYS BETWEEN WIRING CLOSETS AND EQUIPMENT ROOMS.
3. FIBER OPTIC BACKBONE CABLING: FACTORY FABRICATED, JACKETED, LOW-LOSS, GLASS-TYPE, FIBER-OPTIC MULTIMODE, GRaded INDEX, OPERATING AT 850 AND 1300 NANOMETER (NM) STANDARDS PER CABLE, 62.5 MICRON CORE DIAMETER, 125 MICRON CLADDING, MAXIMUM ATTENUATION OF MINUS 3.75 DB/KM AT 850 NM AND 1.5 DB/KM AT 1300NM, MINIMUM MODAL BANDWIDTH OF 160 MHz/KM AT 850 NM AND 500 MHz/KM AT 1300 NM AND OPERATING TEMPERATURE RANGE OF MINUS 20 TO 70 DEG C.
H. WORKSTATION PATCH PANELS: WORKSTATION PATCH PANELS SHALL BE CATEGORY 6 IN 24 OR 48 PORT SIZES WITH REAR WIRE MANAGEMENT AND S110 TERMINATION BLOCKS.
I. FIBER BACKBONE PATCH PANELS: FIBER BACKBONE PATCH PANELS SHALL BE RACK MOUNTED PATCH PANELS IN 24 OR 48 PORT SIZES EQUIPPED TO ACCOMMODATE FIBER BACKBONE CABLES PLUS 20 PERCENT SPARE CAPACITY.
J. WORKSTATION PATCH CORDS (UTP): PROVIDE 4 PAIR CABLES IN APPROPRIATE LENGTHS FOR EACH WORKSTATION PATCH PANEL PORT (USED OR UNUSED), CATEGORY 6 RATED AND TERMINATED WITH AN RJ45 PLUG AT EACH END.
K. FIBER BACKBONE PATCH CORDS: PROVIDE DUAL FIBER CABLES IN 36 INCH OR 72 INCH LENGTHS FOR EACH FIBER PATCH PANEL PORT.
L. WORKSTATION WIRING INSTALLATION:
1. INSTALL CABLE WITHOUT DAMAGING CONDUCTORS OR JACKET.
2. WIRING SHALL BE A MINIMUM OF 48 INCHES FROM TRANSFORMERS AND MOTORS => 5 HP AND MINIMUM OF 5 INCHES FROM FLUORESCENT LIGHT FIXTURES.
3. WIRING SUPPORT METHODS:
A. UTP WIRING METHOD: EXCEPT AS OTHERWISE INDICATED, INSTALL WIRING IN EMT RACEWAY, CONCEAL RACEWAY EXCEPT IN UNFINISHED SPACES AND AS INDICATED.
4. WIRING IN WIRE CLOSETS AND CABINETS: INSTALL CONDUCTORS PARALLEL TO AND AT RIGHT ANGLES TO WALLS, BUNDLE, LACE, AND TRAIN THE CONDUCTORS TO TERMINAL POINTS WITH NO EXCESS.
5. CONDUCTOR TERMINATIONS: TERMINATE CONDUCTORS OF CABLES ON TERMINAL BLOCKS, PATCH PANELS AND DEVICES USING TOOLS RECOMMENDED BY MANUFACTURER.

M. IDENTIFICATION:

- 1. CABLE/WORKSTATION LABELS: USE A UNIQUE 5-SYLLABLE ALPHANUMERIC DESIGNATION. FIRST SYLLABLE IS TO IDENTIFY AND LOCATE THE WIRING CLOSET OR EQUIPMENT ROOM WHERE THE CABLE ORIGINATES. SECOND SYLLABLE IS TO IDENTIFY THE RACK NUMBER. THIRD SYLLABLE IS TO IDENTIFY THE PATCH PANEL OR TERMINAL BLOCKS TO WHICH THE CABLE TERMINATES.
2. PATCH PANEL LABELING: LABEL EACH WORKSTATION PANEL WITH SELF-ADHESIVE PREPRINTED SINGLE LETTER DESIGNATION (A THROUGH Z). LABEL PATCH PANELS USED AS A PATCH TO TELEPHONE CROSS CONNECT BLOCKS AS "TELEPHONE PATCH" IF MORE THAN ONE TELEPHONE PATCH PANEL, INCLUDE LETTER DESIGNATION.
3. RACK LABELING: LABEL EACH RACK WITH ENGRAVED PLASTIC LAMINATE NUMBER DESIGNATION.
4. WIRING CLOSET/EQUIPMENT ROOM: LABEL WIRING CLOSET WITH ENGRAVED PLASTIC LAMINATE LETTER DESIGNATION.
5. CABLE SCHEDULE/MAP: POST AT A PROMINENT LOCATION IN EACH EQUIPMENT ROOM.
6. FIELD QUALITY CONTROL:
1. TESTING AGENCY: PROVIDE A QUALIFIED NRTL, BICSI CERTIFIED TESTING AGENCY TO PERFORM TESTS AND INSPECTIONS.
2. PERFORMANCE TESTS AND INSPECTIONS AS FOLLOWS:
A. VISUALLY INSPECT UTP AND OPTICAL FIBER CABLE JACKET MATERIALS FOR NRTL CERTIFICATION MARKINGS.
B. VISUALLY INSPECT CABLE PLACEMENT, CABLE TERMINATION, GROUNDING AND BONDING, EQUIPMENT AND PATCH CORDS, AND LABELING OF ALL COMPONENTS.
3. RETESTING: CORRECT DEFICIENCIES INDICATED BY TESTS AND COMPLETELY RETEST WORK AFFECTED BY SUCH DEFICIENCIES.
O. COMMISSIONING:
1. ACCEPTANCE: THIS IS TO BE A CERTIFIED EIA/TIA 568 CATEGORY 6 DATA SYSTEM.
DIVISION 28 - ELECTRONIC SAFETY AND SECURITY
283100 - FIRE DETECTION AND ALARM
A. SUBMIT SHOP DRAWINGS IN ACCORDANCE WITH THE "COMMON WORK RESULTS" SECTION.
B. MANUFACTURER: SIMPLEX.
C. COMPLIANCE: FIRE ALARM DESIGN SHALL BE IN COMPLIANCE WITH INTERNATIONAL BUILDING CODES, NFPA 72, NFPA 13 AND NFPA 90A AND APPLICABLE GOVERNMENT AGENCY CODES.
D. CONTROL PANEL TO BE INTELLIGENT ADDRESSABLE, WITH 150 PERCENT POWER SUPPLY BATTERY BACKUP AND INTEGRAL DUAL DIALER.
E. MANUAL STATIONS: INTELLIGENT ADDRESSABLE NON-CODED DOUBLE ACTION, MOUNT SEMIFLUSH IN RECESSED BACK BOXES.
F. HORN/STROBE UNITS: COMBINATION FLUSH MOUNT TYPE WITH WHITE FINISH.
G. PHOTOELECTRIC SMOKE DETECTORS: INTELLIGENT ADDRESSABLE PHOTOELECTRIC SMOKE DETECTOR TO EMPLOY LIGHT SCATTERING PRINCIPLE OF OPERATION.
H. HEAT DETECTORS: INTELLIGENT ADDRESSABLE.
1. FIXED TEMPERATURE TYPE, 135 DEG F.
2. RATE OF RISE TYPE, 135 DEG F.
I. DUCT DETECTION (INDUSTRIAL, COMMERCIAL, EDUCATIONAL AND RETAIL): INTELLIGENT ADDRESSABLE PHOTOELECTRIC WITH SAMPLING TUBES.
J. MAGNETIC DOOR HOLDERS SHALL BE FLOOR OR WALL MOUNTED AS INDICATED COMPLETE WITH MATCHING DOOR PLATE.
K. MAIN VALVE SUPERVISORY SWITCHES SHALL BE FURNISHED BY OTHERS AND WIRED BY ELECTRICAL CONTRACTOR.
L. FLOW AND TAMPER SWITCHES SHALL BE FURNISHED AND INSTALLED BY OTHERS AND WIRED BY ELECTRICAL CONTRACTOR.
M. NOTIFICATION CIRCUITS SHALL BE WIRED CLASS A. INITIATION CIRCUITS SHALL BE WIRED CLASS B. CONDUCTORS SHALL BE MINIMUM #16 AWG FIBER OPTIC ENCLOSED IN EMT.
N. PROVIDE A LETTER OF VERIFICATION THAT THE FIRE ALARM SYSTEM HAS BEEN COMPLETED AND TESTED IN ACCORDANCE WITH NFPA PROCEDURES BY MANUFACTURER'S REPRESENTATIVE WITH AN ATTACHED COPY OF THE AHJ'S ACCEPTANCE REPORT.
O. TRAINING: TRAIN OWNER'S PERSONNEL A MINIMUM OF 4 HOURS.
END OF SECTION

286000 - COMMON WORK RESULTS

- A. INTENT OF DRAWINGS: DRAWINGS ARE PARTLY DIAGRAMMATIC AND DO NOT SHOW EXACT LOCATION OF CONDUIT UNLESS SPECIFICALLY DIMENSIONED.
B. WORKMANSHIP:
1. WORK SHALL BE ACCOMPLISHED BY WORKMEN SKILLED IN PARTICULAR TRADE, IN CONFORMANCE WITH BEST PRACTICES AND ACCEPTED STANDARDS.
2. REQUIREMENTS OF EFFICIENCY OF OPERATION, ACCESSIBILITY, MAINTENANCE AND APPEARANCE, NO PART OF INSTALLATION SHALL INTERFERE WITH OPERATION OF ANY OTHER SYSTEM OR PART OF BUILDING.
3. NON-SATISFACTORY WORK SHALL BE CORRECTED AT NO ADDITIONAL EXPENSE TO OWNER.
C. RESPONSIBILITY:
1. THE ELECTRICAL CONTRACTOR IS RESPONSIBLE FOR INSTALLATION OF SATISFACTORY AND COMPLETE WORK IN ACCORDANCE WITH THE INTENT OF DRAWINGS AND SPECIFICATIONS.
2. IF, AT ANY TIME, AND IN ANY CASE, CHANGE IN LOCATION OF CONDUIT, OUTLETS, FIXTURES, SWITCHES, EQUIPMENT OR ASSOCIATED COMPONENTS, ETC., BECOMES NECESSARY DUE TO OBSTACLES OR INSTALLATION OF OTHER TRADES, SUCH REQUIRED CHANGES SHALL BE MADE BY CONTRACTOR AT NO EXTRA COST.
3. CONFLICTS DISCOVERED DURING CONSTRUCTION SHALL BE IMMEDIATELY CALLED TO THE ATTENTION OF THE ENGINEER FOR DECISION.
4. COORDINATE ALL ELECTRICAL WORK WITH OTHER TRADES TO PREVENT UNNECESSARY DELAYS IN THE CONSTRUCTION SCHEDULE.
5. PROVIDE TEMPORARY ELECTRICAL POWER AND LIGHTING FOR ALL TRADES THAT REQUIRE SERVICE DURING THE COURSE OF THIS PROJECT.
D. GUARANTEE/WARRANTY: THIS CONTRACTOR SHALL AND HEREBY DOES WARRANT AND GUARANTEE:
1. THAT ALL WORK EXECUTED UNDER THIS SECTION WILL BE FREE FROM DEFECTS OF MATERIALS AND WORKMANSHIP FOR A PERIOD OF ONE YEAR FROM THE DATE OF ACCEPTANCE OF THE WORK.
2. THE CONTRACTOR AGREES TO, AT THE CONTRACTOR'S OWN EXPENSE, REPAIR AND REPLACE ALL SUCH DEFECTIVE MATERIALS AND WORK AND ALL OTHER WORK DAMAGED THEREBY WHICH BECOMES DEFECTIVE DURING THE TERM OF WARRANTY.
E. PERMITS, TESTS, CODES AND STANDARDS:
1. ELECTRICAL CONTRACTOR TO PAY FOR ALL PERMITS AND FEES IN CONNECTION WITH THIS WORK.
2. ELECTRICAL WORK SHALL CONFORM TO NATIONAL ELECTRICAL CODES, LATEST EDITIONS, AS A MINIMUM REQUIREMENT.
3. ALL MATERIAL TO CONFORM WITH APPLICABLE STANDARDS.
F. DISCREPANCIES: PRIOR TO SUBMITTING BID, CONTRACTOR SHALL REFER ANY APPARENT DISCREPANCIES OR OMISSIONS TO ENGINEER FOR CLARIFICATION.
G. PRIOR APPROVALS: ALL PROPOSED SUBSTITUTIONS SHALL BE RECEIVED BY THE ENGINEER 10 DAYS PRIOR TO BID.
H. SHOP DRAWING SUBMITTALS:
1. IN ADDITION TO DISTRIBUTION REQUIREMENTS FOR SUBMITTALS SPECIFIED IN DIVISION 1 SECTION "SUBMITTALS," SUBMIT DRAWINGS FOR FINAL AND OFFICIAL APPROVAL THROUGH THE GENERAL CONTRACTOR AS LISTED BELOW.
I. PROJECT CLOSE-OUT RECORD DOCUMENTS:
1. PROVIDE THREE FULL SIZE SETS, UNLESS MORE ARE CALLED FOR UNDER DIVISION 1 (ONE FOR ENGINEER AND ONE FOR OWNER).
J. PROJECT CLOSE-OUT MAINTENANCE MANUALS:
1. PREPARE 3 COPIES, UNLESS MORE ARE CALLED FOR UNDER DIVISION 1 (ONE FOR ENGINEER, TWO FOR OWNER) IN ADDITION TO REQUIREMENTS CALLED FOR UNDER DIVISION 1, INDICATE THE FOLLOWING INSTALLED CONDITIONS:
A. ACTUAL LOCATION OF ALL ELECTRICAL SERVICE GEAR/FEEDERS, PANEL/MOTOR/SPECIAL EQUIPMENT FEEDERS, ALL MAJOR UNDERGROUND OR UNDERSLAB CONDUITS, ALL CONDUIT SIZES FOR FUTURE USE, ANY CHANGE IN BRANCH CIRCUITRY FROM DRAWINGS, KEY JUNCTION BOXES AND PULL BOXES NOT INDICATED ON DRAWINGS, ANY CONTROL LOCATIONS OR INDICATOR LIGHTS NOT SHOWN ON DRAWINGS.
K. SUPPORTING EQUIPMENT:
1. UNLESS OTHERWISE INDICATED, FASTEN ELECTRICAL ITEMS AND THEIR SUPPORTING HARDWARE SECURELY TO THE BUILDING STRUCTURE.
L. ELECTRICAL IDENTIFICATION:
1. APPLY CIRCUIT/CONTROL/ITEM DESIGNATION LABELS OF ENGRAVED PLASTIC LAMINATE FOR DISCONNECT SWITCHES, BREAKERS, PUSHBUTTONS, PILOT LIGHTS, FAULT DETECTION, MOTOR STARTERS, PANELBOARDS AND MAIN CONTROL PANEL, AND SIMILAR SYSTEMS.
2. IDENTIFY ALL 120 VAC AND 208 VAC POWER RECEPTACLE COVER PLATES WITH PANEL AND CIRCUIT NUMBER UTILIZING A CLEAR LABEL WITH BLACK DESIGNATIONS.



08/21/2025

127 E. JACKSON ST., BURNET TX 78611









BURNET COUNTY ANNEX

Table with 2 columns: #, DATE, ISSUE. The table is currently empty.




Project Number: 33-1408 © 2024 LEVY DYKEMA ELECTRICAL SPECIFICATIONS

#	DATE	ISSUE
1	08/21/2025	ADDENDUM 1

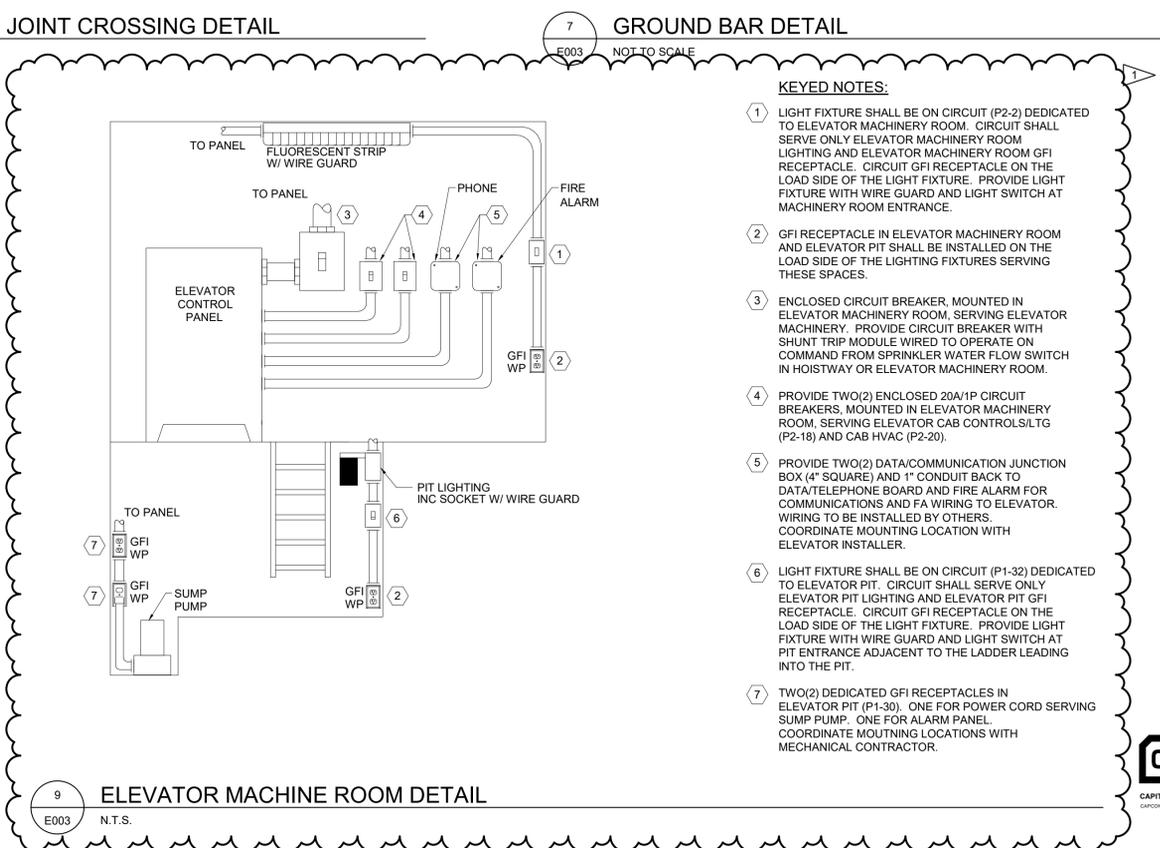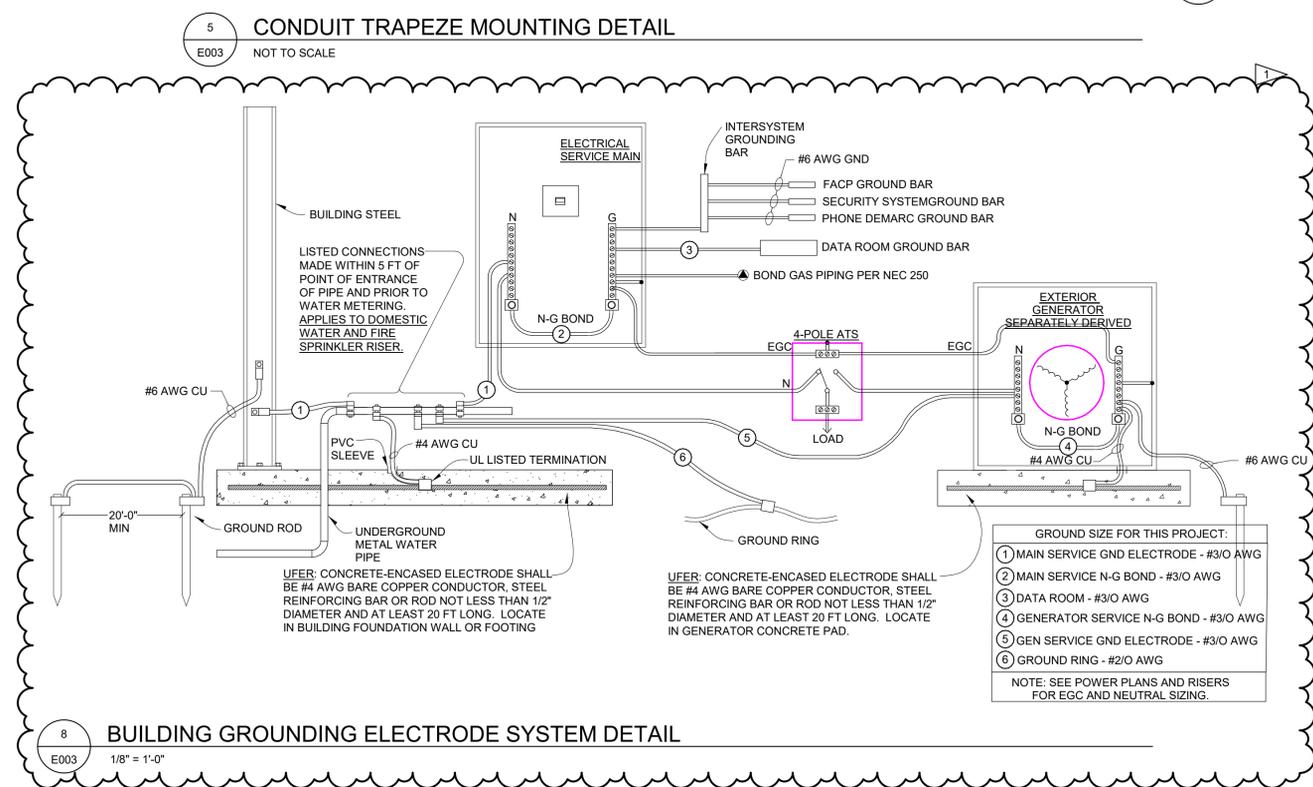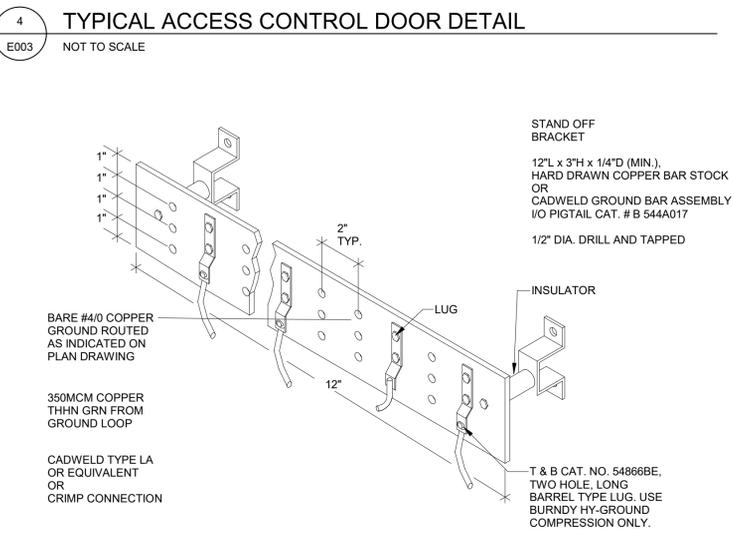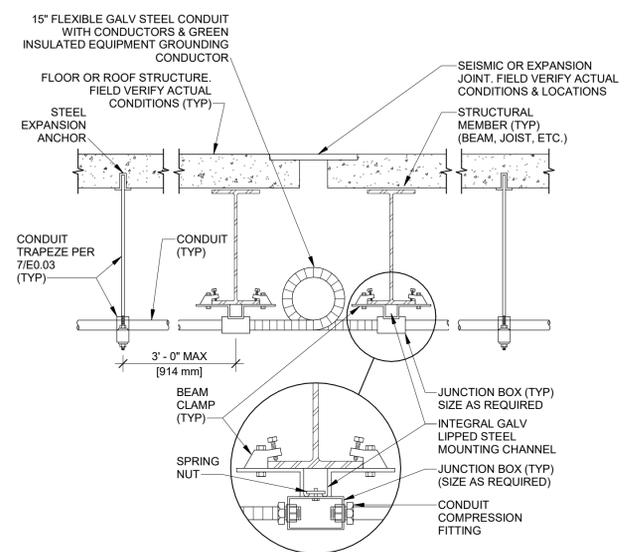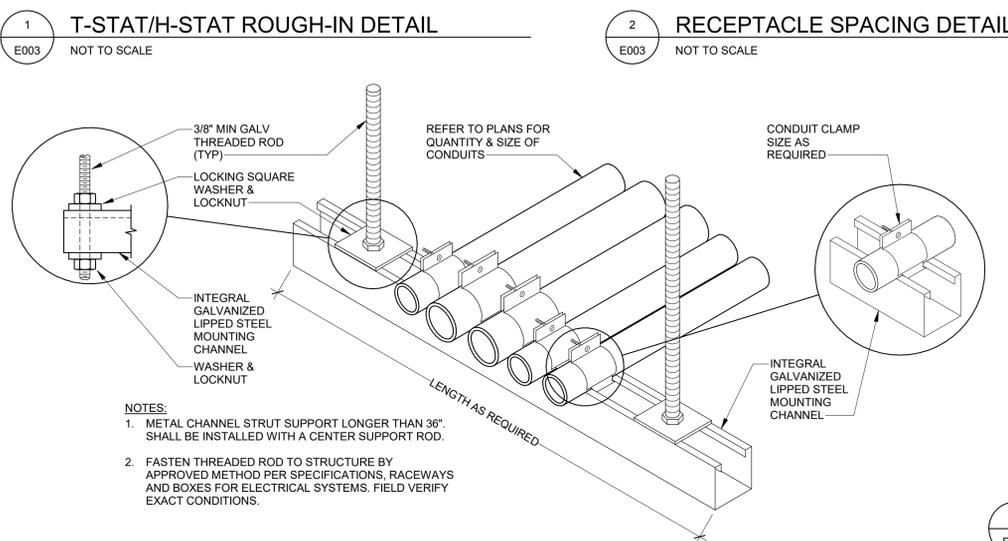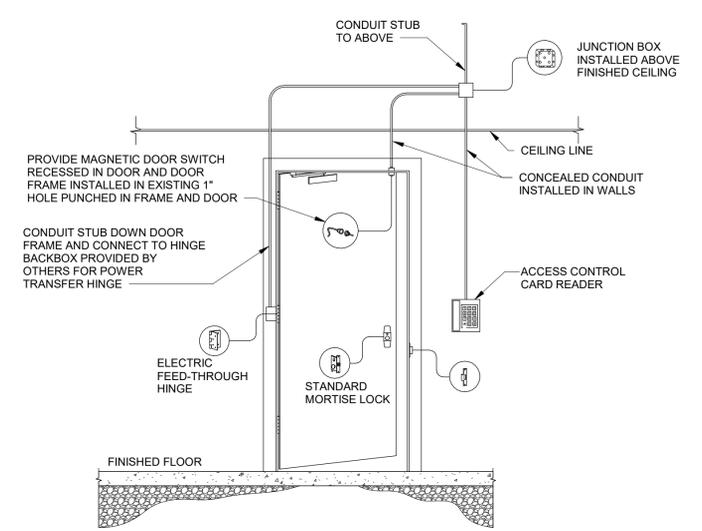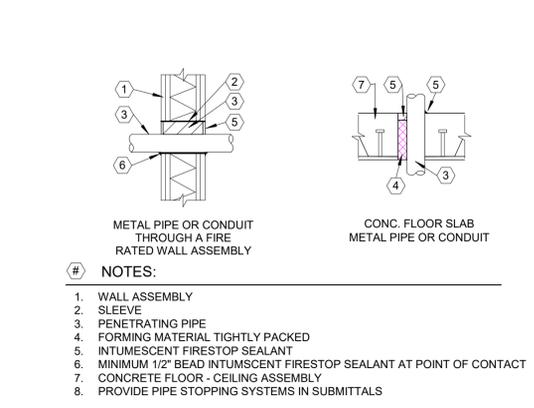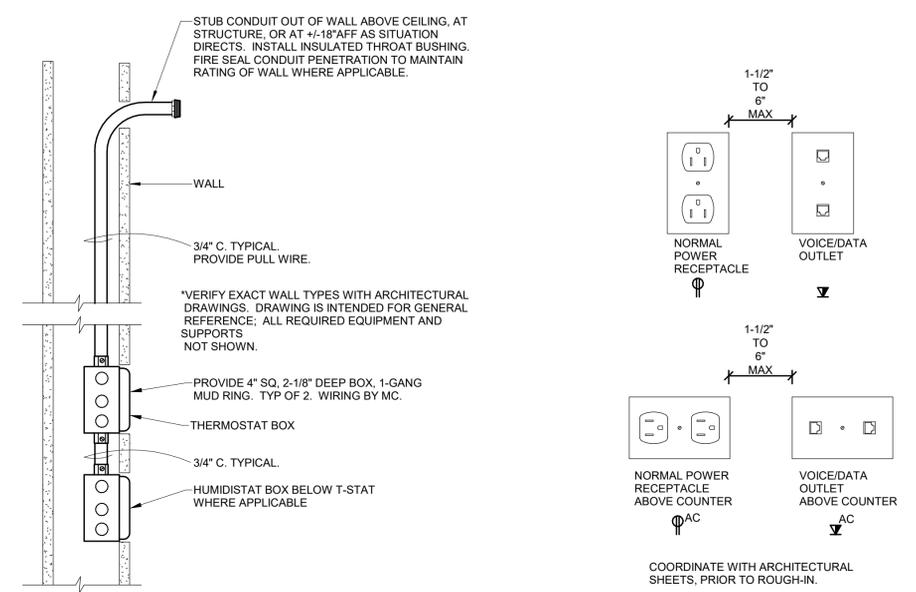

- KEYED NOTES:**
- 1 LIGHT FIXTURE SHALL BE ON CIRCUIT (P2-2) DEDICATED TO ELEVATOR MACHINERY ROOM. CIRCUIT SHALL SERVE ONLY ELEVATOR MACHINERY ROOM LIGHTING AND ELEVATOR MACHINERY ROOM GFI RECEPTACLE. CIRCUIT GFI RECEPTACLE ON THE LOAD SIDE OF THE LIGHT FIXTURE. PROVIDE LIGHT FIXTURE WITH WIRE GUARD AND LIGHT SWITCH AT MACHINERY ROOM ENTRANCE.
  - 2 GFI RECEPTACLE IN ELEVATOR MACHINERY ROOM AND ELEVATOR PIT SHALL BE INSTALLED ON THE LOAD SIDE OF THE LIGHTING FIXTURES SERVING THESE SPACES.
  - 3 ENCLOSED CIRCUIT BREAKER, MOUNTED IN ELEVATOR MACHINERY ROOM, SERVING ELEVATOR MACHINERY. PROVIDE CIRCUIT BREAKER WITH SHUNT TRIP MODULE WIRED TO OPERATE ON COMMAND FROM SPRINKLER WATER FLOW SWITCH IN HOISTWAY OR ELEVATOR MACHINERY ROOM.
  - 4 PROVIDE TWO(2) ENCLOSED 20A/1P CIRCUIT BREAKERS, MOUNTED IN ELEVATOR MACHINERY ROOM, SERVING ELEVATOR CAB CONTROLS/LTG (P2-18) AND CAB HVAC (P2-20).
  - 5 PROVIDE TWO(2) DATA/COMMUNICATION JUNCTION BOX (4" SQUARE) AND 1" CONDUIT BACK TO DATA/TELEPHONE BOARD AND FIRE ALARM FOR COMMUNICATIONS AND FA WIRING TO ELEVATOR. WIRING TO BE INSTALLED BY OTHERS. COORDINATE MOUNTING LOCATION WITH ELEVATOR INSTALLER.
  - 6 LIGHT FIXTURE SHALL BE ON CIRCUIT (P1-32) DEDICATED TO ELEVATOR PIT. CIRCUIT SHALL SERVE ONLY ELEVATOR PIT LIGHTING AND ELEVATOR PIT GFI RECEPTACLE. CIRCUIT GFI RECEPTACLE ON THE LOAD SIDE OF THE LIGHT FIXTURE. PROVIDE LIGHT FIXTURE WITH WIRE GUARD AND LIGHT SWITCH AT PIT ENTRANCE ADJACENT TO THE LADDER LEADING INTO THE PIT.
  - 7 TWO(2) DEDICATED GFI RECEPTACLES IN ELEVATOR PIT (P1-30). ONE FOR POWER CORD SERVING SUMP PUMP. ONE FOR ALARM PANEL. COORDINATE MOUNTING LOCATIONS WITH MECHANICAL CONTRACTOR.



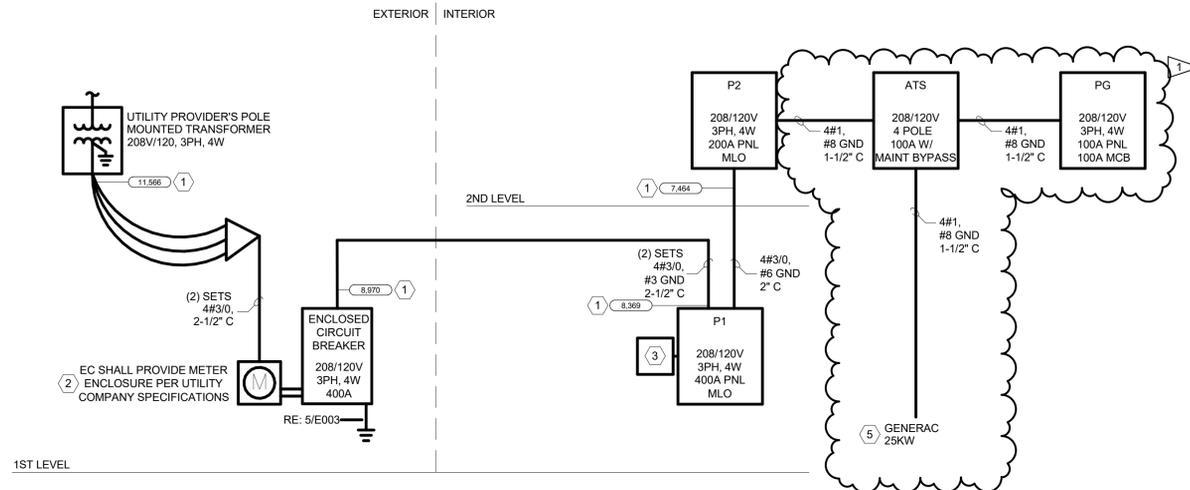

**1 ELECTRICAL ONE-LINE DIAGRAM**  
E004 NOT TO SCALE

**LIGHTING FIXTURE SCHEDULE**

NOTES:  
 1. UON, ALL LIGHT FIXTURE SPECIFICATIONS AND FINISHES SHALL BE SELECTED AND APPROVED BY THE ARCHITECT AND TENANT PRIOR TO PURCHASE AND INSTALLATION. SUBMITTALS SHALL INCLUDE:  
 2. ACTUAL PAINT FINISH COLOR SAMPLE AND ARCHITECTURAL COLOR PAINT SELECTION BROCHURE FOR OPTIONS.  
 3. SEE ARCHITECTURAL SHEETS FOR MOUNTING HEIGHT AND DETAILS.  
 4. EMERGENCY FIXTURES SHALL HAVE 90-MINUTE BATTERY PACK/INVERTER PACK INSTALLED.  
 5. UON, VERIFY LAMP COLOR TEMPERATURE REQUIREMENTS (KELVIN) WITH THE OWNER AND ARCHITECT PRIOR TO PURCHASE.  
 6. UON, CONTROLS PRICING AND LIGHTING FIXTURE PRICING SHALL BE SEPERATE.  
 UON, WHEN SUBSTITUTING FIXTURES, CONTRACTOR SHALL FURNISH BREAK-OUT PRICING OF BOTH THE SPECIFIED AND SUBSTITUTE FIXTURES FOR COMPARISO...

TYPE	MFRG	FIXTURE	CATALOG NUMBER	MOUNTING	LAMP	NO.	FIXTURE VOLTAGE	FIXTURE WATTAGE	NOTES
L1	WILLIAMS	BAR-22-L30-835-DIM-UNV & BAR-22-L30-835-EM/10W-DIM-UNV	BAR-22-L30-835-DIM-UNV & BAR-22-L30-835-EM/10W-DIM-UNV	LAY IN	LED	1	120-277V	23	4
L1A	WILLIAMS	BAR-22-L20-835-DIM-UNV & BAR-22-L20-835-EM/10W-DIM-UNV	BAR-22-L20-835-DIM-UNV & BAR-22-L20-835-EM/10W-DIM-UNV	LAY IN	LED	1	120-277V	23	4
L2	COOPER	75S-2-LL25-835-DRV-UNV	75S-2-LL25-835-DRV-UNV	SURFACE	LED	1	120-277V	18	3
L3	TECH	SLF-2-L13-935-HIA-DIM-UNV	SLF-2-L13-935-HIA-DIM-UNV	WALL	LED	1	120-277V	10	3
L4	WILLIAMS	BAR-24-L40-835-DIM-UNV & BAR-24-L40-835-EM/10W-DIM-UNV	BAR-24-L40-835-DIM-UNV & BAR-24-L40-835-EM/10W-DIM-UNV	LAY IN	LED	1	120-277V	31	4
L5	WILLIAMS	6DR-TL-L20-835-EM/10W-DIM-UNV-OV-OF-CS (EM MODE)	6DR-TL-L20-835-EM/10W-DIM-UNV-OV-OF-CS (EM MODE)	RECESSED	LED	1	120-277V	10	
L6	WILLIAMS	LRX4-4-L8-835-BMA-DIM-UNV	LRX4-4-L8-835-BMA-DIM-UNV	WALL	LED	1	120-277V	27	3
L7E	BEGA-US	LGL-FCW-25-SV-30-N-XX-EM	LGL-FCW-25-SV-30-N-XX-EM	SURFACE	LED	1	120-277V	25	5
X	COOPER	EU-X-7-X-R	EU-X-7-X-R	-	LED	1	120-277V	5	

**PANEL: P2**

LOCATION: ELEV. MACH. RM... AMPS: 200 A AIC RATING: SEE ONE-LINE DIAGRAM NOTES (NT):  
 MANUFACTURER: SEE... VOLTS: 208Y/120 MOUNTING: RECESSED  
 MODEL TYPE: PANELBOARD PHASE: 3 ENCLOSURE: TYPE 1  
 TYPE OF MAIN: MLO WIRE: 4 FEATURES:

LOAD NAME	NT	CB	P	WIRE SIZE H GND N	C SIZE (3/4" UON)	CKT NO	A	B	C	CKT NO	C SIZE (3/4" UON)	WIRE SIZE N GND H	P	CB	NT	LOAD NAME
2ND FLR LIGHTING	20	1	#10	#10	X	1	703	211		2		X #12 #12	1	20		ELEVATOR ROOM LTG & GFCI
BREAKRM & RR'S GFCI	20	1	#12	#12	X	3		900	3307	4		X #8 #8	2	35		CU-1-1
OFFICE RECEPCTS	20	1	#12	#12	X	5			1620	3307	6					
CORR & STORAGE RECEPCTS	20	1	#12	#12	X	7	1080	2600			8	X #10 #8	2	25		FCU-2-1
CONF. RM RECEPCTS	20	1	#12	#12	X	9		1440	2600		10					
OFFICE RECEPCTS	20	1	#12	#12	X	11			1440	3754	12	X #8 #6	2	40		CU-2-1
FRIDGE	20	1	#12	#12	X	13	1000	3754			14					
SYSTEM FURNITURE	20	1	#12	#12	X	15		360	720		16	X #12 #12	1	20		LAB QUAD
SYSTEM FURNITURE	20	1	#12	#12	X	17			360	1000	18	X #12 #12	1	20		ELEVATOR CAB LTG
SYSTEM FURNITURE	20	1	#12	#12	X	19	360	1500			20	X #12 #12	1	20		ELEVATOR CAB HVAC
SYSTEM FURNITURE	20	1	#12	#12	X	21		360	720		22	X #12 #12	1	20		LAB QUAD
LAB QUAD	20	1	#12	#12	X	23			720	0	24					SPARE
LAB QUAD	20	1	#12	#12	X	25	720	0			26					SPARE
SPARE	20	1				27		0	0		28					SPARE
SPARE	20	1				29			0	0	30					SPARE
SPARE	20	1				31	0	0			32					SPARE
SPARE	20	1				33		0	0		34					SPARE
SPARE	20	1				35			0	240	36	X #12 #12	1	20		EF-2-1 & 2-2
PANEL 'PG' VIA 'ATS'	20	1	#10	#10	X	37	7022	2000			38	X #10 #10	3	40		ELEVATOR
						39			14032	2000	40					
						41			125	2000	42					
							20951	26439		27004						
							175 A	227 A		232 A						

LOAD CLASSIFICATION

LOAD CLASSIFICATION	CONNECTED LOAD	DEMAND FACTOR	ESTIMATED DEMAND	PANEL TOTALS
EQUIPMENT	8500	100.00%	8500	
LIGHTING	797	100.00%	797	TOTAL CONNECTED LOAD: 74394
MOTORS	33707	100.00%	33707	TOTAL CONNECTED AMPS: 206 A
RECEPTACLES	31390	65.93%	20695	
				TOTAL ESTIMATED DEMAND: 63699
				TOTAL EST DEMAND AMPS 177 A

**PANEL: P1**

LOCATION: ELEV. MACH. RM... AMPS: 400 A AIC RATING: SEE ONE-LINE DIAGRAM NOTES (NT):  
 MANUFACTURER: SEE SPECIFICATIONS VOLTS: 208Y/120 MOUNTING: RECESSED  
 MODEL TYPE: PANELBOARD PHASE: 3 ENCLOSURE: TYPE 1  
 TYPE OF MAIN: MLO WIRE: 4 FEATURES:

LOAD NAME	NT	CB	P	WIRE SIZE H GND N	C SIZE (3/4" UON)	CKT NO	A	B	C	CKT NO	C SIZE (3/4" UON)	WIRE SIZE N GND H	P	CB	NT	LOAD NAME	
LIGHTING CONTACTOR	20	1	#12	#12	X	1	500	360		2		X #12 #12	1	20		RECEPTACLES	
1ST FLR LIGHTING	20	1	#10	#10	X	3		954	0	4						SPARE	
EXTERIOR LIGHTING	20	1	#12	#12	X	5			50	0	6					SPARE	
CONF. ROOM	20	1	#12	#12	X	7	1080	360		8		X #12 #12	1	20		REFRIGERATOR	
HALL CORR. RECEP.	20	1	#12	#12	X	9		900	1000	10	X	#12 #12	1	20		REFRIGERATOR	
BRK RM CORR. RECEP.	20	1	#12	#12	X	11			1260	1260	12	X	#12 #12	1	20		OFFICE 123
WORKSPACE WRKSTN	20	1	#12	#12	X	13	720	180		14	X	#12 #12	1	20		PRINTER	
WORKSPACE WRKSTN	20	1	#12	#12	X	15		720	180	16	X	#12 #12	1	20		PRINTER	
EF-1-1 thru EF-1-3	20	1	#12	#12	X	17			360	0	18					SPARE	
SPARE	20	1				19	0	0			20					SPARE	
SPARE	20	1				21		0	360		22					SPARE	
SPARE	20	1				23			0	360	24	X	#12 #12	1	20		SYSTEM FURNITURE
SPARE	20	1				25	0	360		26	X	#12 #12	1	20		SYSTEM FURNITURE	
SPARE	20	1				27		0	360	28	X	#12 #12	1	20		SYSTEM FURNITURE	
SPARE	20	1				29			0	360	30	X	#12 #12	1	20		GFCI SUMP PUMP
SPARE	20	1				31	0	500		32	X	#12 #12	1	20		ELEVATOR PIT LIGHTING	
SPARE	20	1				33		0	0	34						SPARE	
SPARE	20	1				35			0	0	36					SPARE	
SPARE	20	1				37	0	0		38						SPARE	
SPARE	20	1				39		0	0	40						SPARE	
SPARE	20	1				41			0	0	42					SPARE	
SPARE	20	1				43	0	0		44						SPARE	
SPARE	20	1				45		0	0	46						SPARE	
EW-1-1	20	2	#12	#12	X	47			1250	0	48					SPARE	
	20	2	#12	#12	X	49	1250	0		1250	0	50				SPARE	
FCU-1-1	20	2	#8	#10	X	51		2600	0	52						SPARE	
	20	2	#8	#10	X	53			2600	0	54					SPARE	
	20	2	#8	#10	X	55	209	0		26439	0	56				SPARE	
	20	2	#8	#10	X	57				270	0	58				SPARE	
	20	2	#8	#10	X	59				270	0	60				SPARE	
							26261	33513		34504							
							219 A	289 A		297 A							


LOAD CLASSIFICATION

LOAD CLASSIFICATION	CONNECTED LOAD	DEMAND FACTOR	ESTIMATED DEMAND	PANEL TOTALS
EQUIPMENT	9000	100.00%	9000	
LIGHTING	2300	100.00%	2300	TOTAL CONNECTED LOAD: 94278
MOTORS	39627	100.00%	39627	TOTAL CONNECTED AMPS: 262 A
RECEPTACLES	40850	62.24%	25425	
CONTINUOUS	2500	125.00%	3125	TOTAL ESTIMATED DEMAND: 79478
				TOTAL EST DEMAND AMPS 221 A


**PANEL: PG**

LOCATION: ELEV. MACH. RM... AMPS: 100 A AIC RATING: SEE ONE-LINE DIAGRAM NOTES (NT):  
 MANUFACTURER: SEE... VOLTS: 208Y/120 MOUNTING: RECESSED  
 MODEL TYPE: PANELBOARD PHASE: 3 ENCLOSURE: TYPE 1  
 TYPE OF MAIN: MCB WIRE: 4 FEATURES:

LOAD NAME	NT	CB	P	WIRE SIZE H GND N	C SIZE (3/4" UON)	CKT NO	A	B	C	CKT NO	C SIZE (3/4" UON)	WIRE SIZE N GND H	P	CB	NT	LOAD NAME	
SERVER RM LIGHTING	20	1	#12	#12	X	1	62	2750		2		X #10 #10	1	30		SERVER RM 5-30R	
SERVER RM 5-30R	30	1	#10	#10	X	3		2750	2750	4	X	#10 #10	1	30		SERVER RM 5-30R	
SERVER RM 5-30R	30	1	#10	#10	X	5			2750	1100	6	X	#12 #12	2	20		SERVER RM 6-20R
SERVER RM 5-30R	30	1	#10	#10	X	7	2750	1100		8							
SERVER RM 6-20R	20	2	#12	#12	X	9		1100	180	10	X	#10 #12	1	30		SERVER RM 5-30R	
						11			1100	180	12	X	#10 #12	1	30		SERVER RM 5-30R
SERVER RM 5-30R	30	1	#12	#10	X	13	180	180		14	X	#10 #12	1	30		SERVER RM 5-30R	
SERVER RM 5-30R	30	1	#12	#10	X	15		180	0	16						SPARE	
SERVER RM QUAD	20	1	#12	#12	X	17			360	0	18					SPARE	
SPARE	20	1				19	0	0			20					SPARE	
SPARE	20	1				21		0	0		22					SPARE	
SPARE	20	1				23			0	0	24					SPARE	
SPARE	20	1															

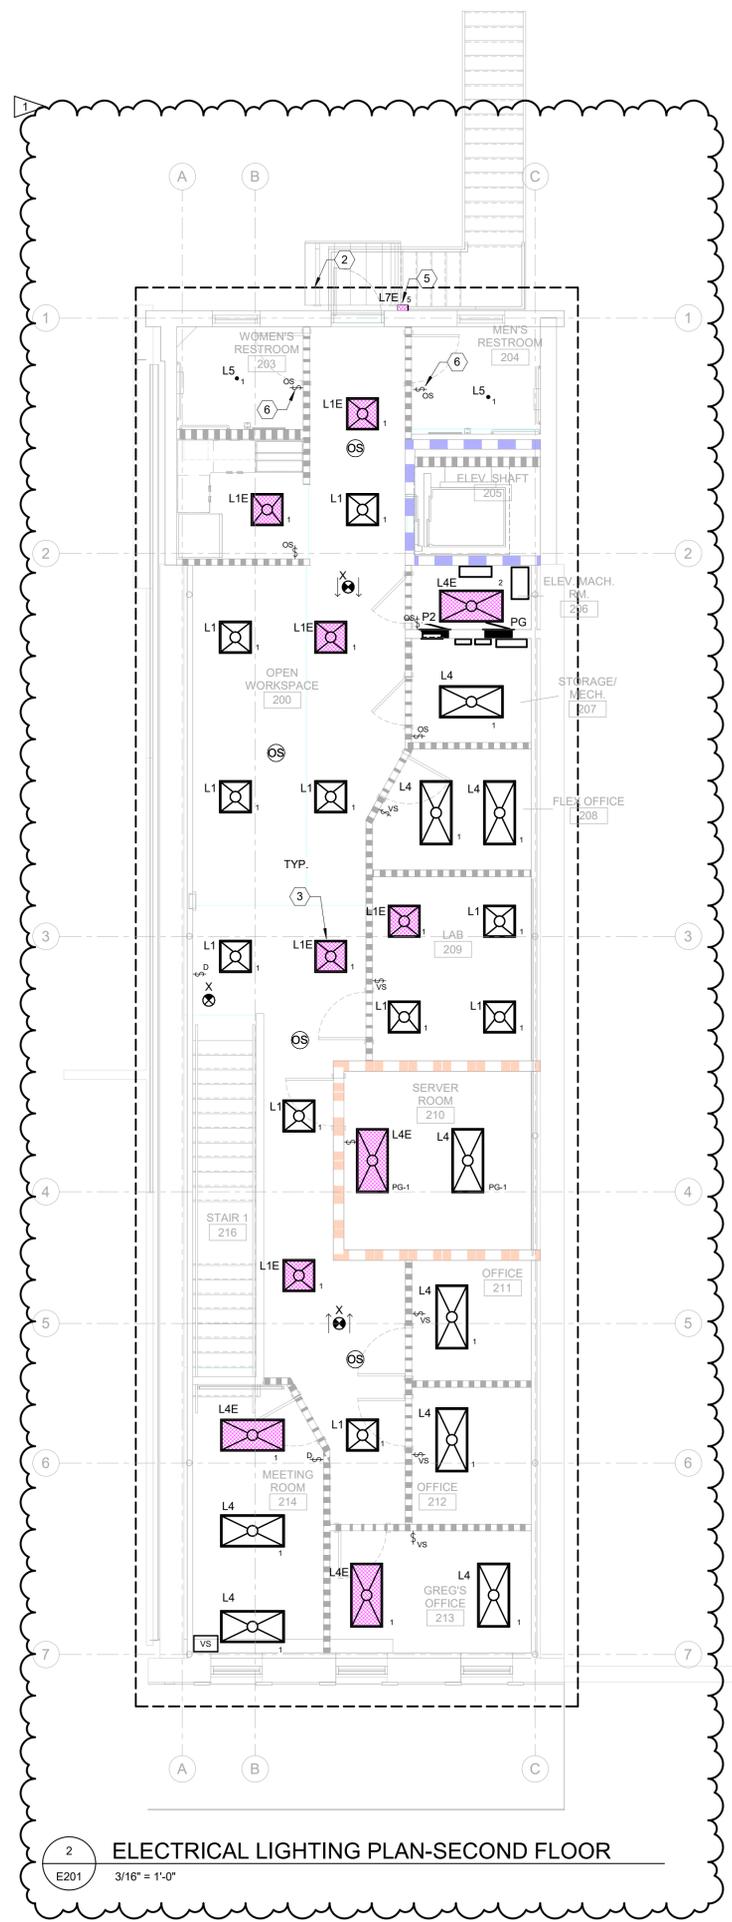

**2 ELECTRICAL LIGHTING PLAN-SECOND FLOOR**  
 E201 3/16" = 1'-0"

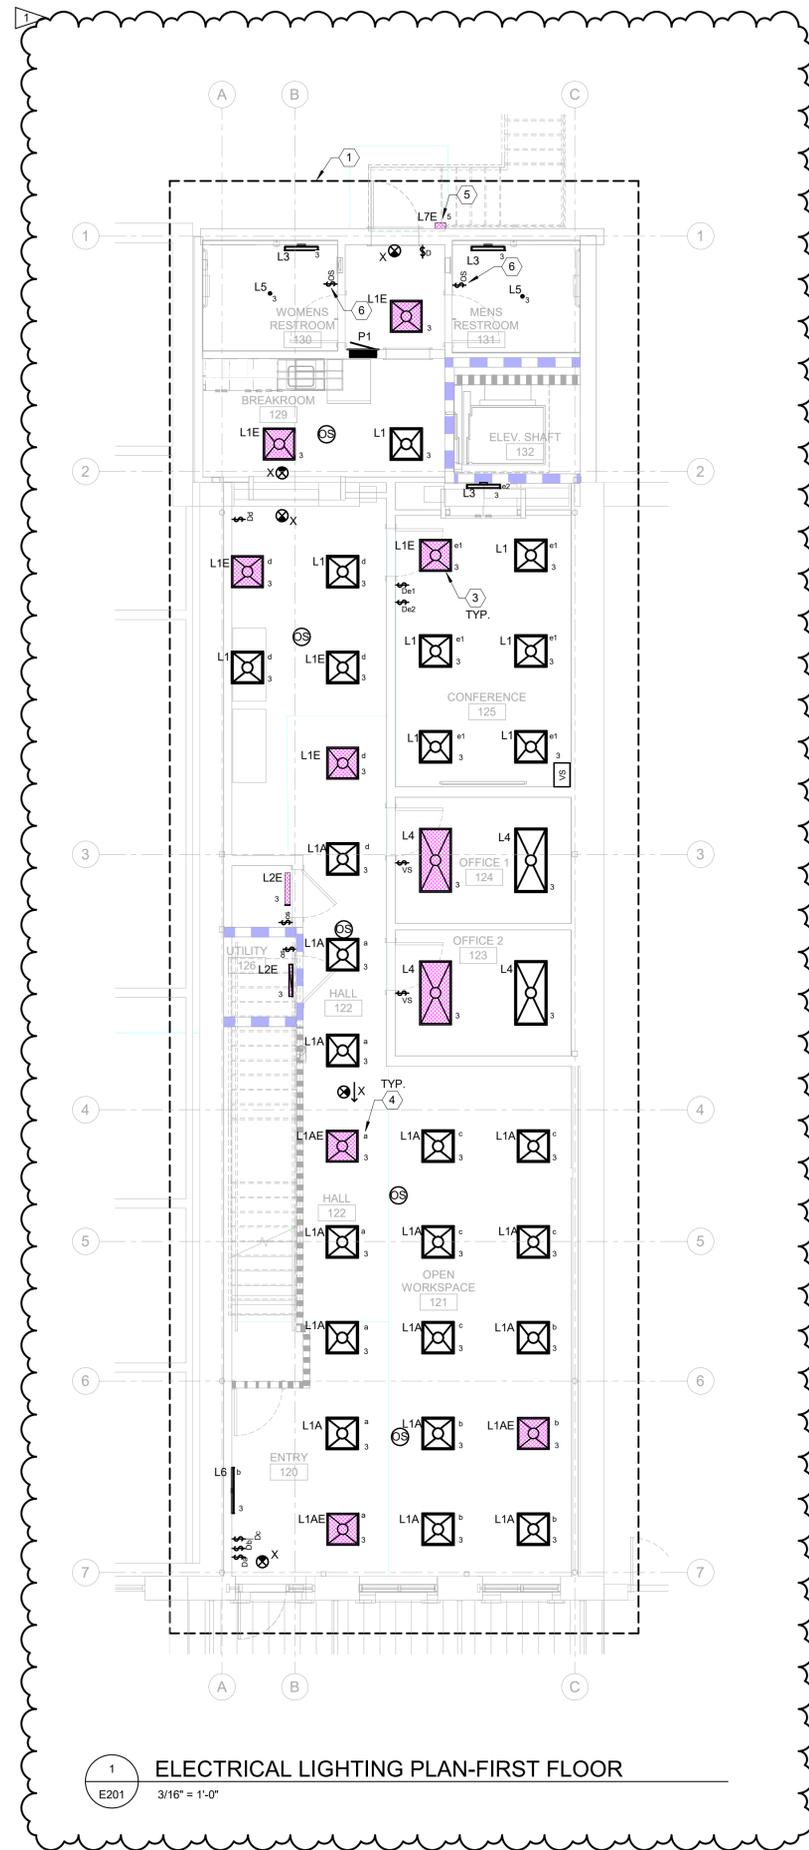

**1 ELECTRICAL LIGHTING PLAN-FIRST FLOOR**  
 E201 3/16" = 1'-0"

**GENERAL NOTES**

- A. REFER TO SPECIFICATIONS, SCHEDULES, DETAILS AND GENERAL NOTES SHEET FOR ADDITIONAL LIGHTING INSTALLATION REQUIREMENTS.
- B. CONTRACTOR SHALL COORDINATE LUMINAIRE LOCATIONS WITH THE ARCHITECTURAL ELEVATIONS AND RCP PRIOR TO INSTALLATION. VERIFY LOCATIONS AND MOUNTING METHODS AND MATERIALS THAT ARE UNCLEAR PRIOR TO ORDERING OR INSTALLING LUMINAIRES.
- C. CIRCUIT NUMBER AND FIXTURE TAG SHOWN ADJACENT TO EACH LUMINAIRE.
- D. CIRCUIT EXIT SIGNS (UNSWITCHED) WITH THE ADJACENT LIGHTING IN THE ROOM.

**# SHEET WORK NOTES**

1. UON, CIRCUIT ALL LIGHTING IN THIS AREA TO PANEL 'P1'.
2. UON, CIRCUIT ALL LIGHTING IN THIS AREA TO PANEL 'P2'.
3. LUMINAIRES SHOWN HATCHED OR TAGGED 'X\*' AND ALL EXIT SIGNS SHALL BE PROVIDED WITH INTEGRAL BATTERY PACKS FOR 90 MIN OF EMERGENCY OPERATION. PROVIDE WITH VISIBLE BATTERY STATUS INDICATOR, TYPICAL.
4. LOWER CASE LETTER ADJACENT TO LUMINAIRE INDICATES SWITCH-LEG TO SERVE LUMINAIRE.
5. LUMINAIRES SHALL BE SWITCHED BY A CONTACTOR CONTROLLED BY A 24 HOUR, 7 DAY ASTRONOMICAL TIME CLOCK WITH HOLIDAY SCHEDULING. CONTACTOR AND TIME CLOCK TO BE MOUNTED ADJACENT TO PANEL.
6. PROVIDE SWITCH MOUNTED DUAL TECHNOLOGY OCCUPANCY SENSOR WITH INTEGRAL ON/OFF CONTROL SWITCH AND DUAL RELAYS FOR LIGHTING AND EXHAUST FAN, TYPICAL.

LIGHTING CONTROLS SYMBOLS LEGEND	
\$os	WALL MOUNTED OCCUPANCY SENSOR (DUAL TECH)
\$vs	WALL MOUNTED VACANCY SENSOR WITH DIMMING
OS	CEILING MOUNTED OCCUPANCY SENSOR (DUAL TECH)
VS	CEILING MOUNTED VACANCY SENSOR WITH DIMMING
OS	CORNER MOUNTED OCCUPANCY SENSOR (DUAL TECH)
VS	CORNER MOUNTED VACANCY SENSOR WITH DIMMING




#	DATE	ISSUE
1	08/21/2025	ADDENDUM 1

**GENERAL NOTES**


- A. REFER TO SPECIFICATIONS, SCHEDULES, DETAILS AND GENERAL NOTES SHEET FOR ADDITIONAL ELECTRICAL EQUIPMENT AND SYSTEM INSTALLATION REQUIREMENTS.
- B. CONTRACTOR SHALL PROVIDE POWER TO ALL ITEMS SHOWN FROM THE PANEL AND CIRCUIT NUMBERS THAT ARE SHOWN ADJACENT TO THE LOAD (RECEPTACLE, DISCONNECT, JBOX, EQUIPMENT CONNECTION POINT, ETC). SIZE CIRCUIT PER PANEL SCHEDULE. PROVIDE NEUTRAL AND GROUND, U.N.O.
- C. EC'S SCOPE INCLUDES RACEWAY INFRASTRUCTURE FOR ALL ITEMS SHOWN ON THE SPECIAL SYSTEMS PLANS. RACEWAY REQUIREMENTS ARE DEFINED IN SPECIFICATION NOTES AND DETAILS, BUT SHALL BE FIELD VERIFIED BEFORE WORK.
- D. ALL IT CABLING, JACKS, EQUIPMENT RACKS, AV AND NETWORKING EQUIPMENT WILL BE PROVIDED AND INSTALLED BY OTHERS. EC RESPONSIBLE FOR ALL ROUGH IN WORK AND POWER CONNECTIONS.
- E. COORDINATE TELECOMMUNICATIONS INFRASTRUCTURE REQUIREMENTS WITH OWNER'S IT REPRESENTATIVE PRIOR TO STARTING WORK.

**# SHEET WORK NOTES**

1. UON, ALL CIRCUITS SHOWN IN THIS AREA WILL BE FED FROM PANEL 'P1'.
2. UON, ALL CIRCUITS SHOWN IN THIS AREA WILL BE FED FROM PANEL 'P2'.
3. TV MOUNTED ON WALL AT THIS LOCATION. PROVIDE (1) CHIEF PAC525 BOX BEHIND TELEVISION, (1) CHIEF BOX SHALL HAVE (1) QUAD AND (2) DATA DROPS WITH (2) 1-1/2" CONDUITS TO ABOVE ACCESSIBLE CEILING. COORDINATE ELEVATION WITH ARCHITECT AND INSTALLATION WITH TELEVISION BLOCKING AND MOUNTING EQUIPMENT. COORDINATE DETAILS WITH AV CONTRACTORS DRAWINGS PRIOR TO ROUGH-IN.
4. PROVIDE ONE 2" CONDUIT (WITH PULL STRING) FROM THIS LOCATION TO EXTERIOR COMMUNICATION JUNCTION BOX. REFER TO ARCHITECTURAL PLANS TO DETERMINE CONDUIT RUN LENGTHS AND ROUTING. COORDINATE EXACT TERMINATION POINT WITH COMMUNICATIONS CONTRACTORS.
5. PROVIDE ONE 1" CONDUIT (WITH PULL STRING) FROM THIS LOCATION TO SECOND FLOOR DATA CLOSET. REFER TO ARCHITECTURAL PLANS TO DETERMINE CONDUIT RUN LENGTHS AND ROUTING. COORDINATE EXACT TERMINATION POINT WITH COMMUNICATIONS CONTRACTORS.
6. PROVIDE A GROUND LUG AND TERMINAL STRIP WITH A #4 ISOLATED GROUND CONDUCTOR BONDED TO THE BUILDING GROUNDING ELECTRODE.
7. PROVIDE 3/4" FIRE RATED PLYWOOD BACKBOARD FOR MOUNTING COMMUNICATIONS EQUIPMENT ON ALL SERVER RM WALLS. WIDTH OF PANEL SHALL BE COORDINATED WITH INFORMATION TECHNOLOGIES CONTRACTOR. PAINT TO MATCH WALL TO WHICH BOARD IS ATTACHED.
8. PROVIDE ONE POWER AND ONE DATA JUNCTION BOX IN WALL AT THIS LOCATION FOR BRANCH CIRCUIT AND DATA VOICE TO SERVE SYSTEM FURNITURE THAT IS PROVIDED WITH INTEGRAL RECEPTACLES. PROVIDE COVER PLATE WITH ANGLE CONNECTOR AND FLEXIBLE METAL CONDUIT (FMC) FROM EACH JUNCTION BOX IN WALL TO CONNECTION POINT ON FURNITURE. PROVIDE POWER CONDUCTORS, AND MAKE ALL ELECTRICAL TERMINATIONS. COORDINATE JUNCTION BOX LOCATION AND INSTALLATION OF CONDUCTORS WITH FURNITURE PROVIDER. COORDINATE CIRCUIT COUNT WITH FURNITURE PRIOR TO ROUGH-IN. PROVIDE (4) DEDICATED CIRCUITS ACROSS A MAXIMUM OF (8) WORKSTATIONS. PROVIDE DEDICATED NEUTRAL AND GROUND WITH EACH CIRCUIT. PROVIDE CREDIT TO TENANT IF CIRCUIT COUNT IS LESS THAN 4. PROVIDE 1-1/2" CONDUIT FOR DATA JUNCTION BOX.
9. PROVIDE DEDICATED GFI RECEPTACLE MOUNTED IN PIT ADJACENT TO SUMP PUMP FOR CONNECTION TO SUMP PUMP.
10. PROVIDE NEMA 5-30R. COORDINATE INSTALLATION WITH COMMUNICATIONS CONTRACTOR. RECEPTACLE SHALL BE MOUNTED TO OWNER FURNISHED, OWNER INSTALLED LADDER RACK ABOVE TELECOM RACK, TYPICAL OF 10.
11. PROVIDE NEMA 6-20R. COORDINATE INSTALLATION WITH COMMUNICATIONS CONTRACTOR. RECEPTACLE SHALL BE MOUNTED TO OWNER FURNISHED, OWNER INSTALLED LADDER RACK ABOVE TELECOM RACK. COORDINATE FINAL LOCATIONS WITH OWNER PRIOR TO ROUGH-IN. TYPICAL OF 2.
12. ENCLOSED CIRCUIT BREAKER WITH LOTO PROVISIONS, SERVING ELEVATOR POWER UNIT. CIRCUIT BREAKER WITH SHUNT TRIP MODULE WIRED TO OPERATE ON COMMAND FROM SPRINKLER WATER FLOW SWITCH IN HOISTWAY OR ELEVATOR MACHINERY ROOM.

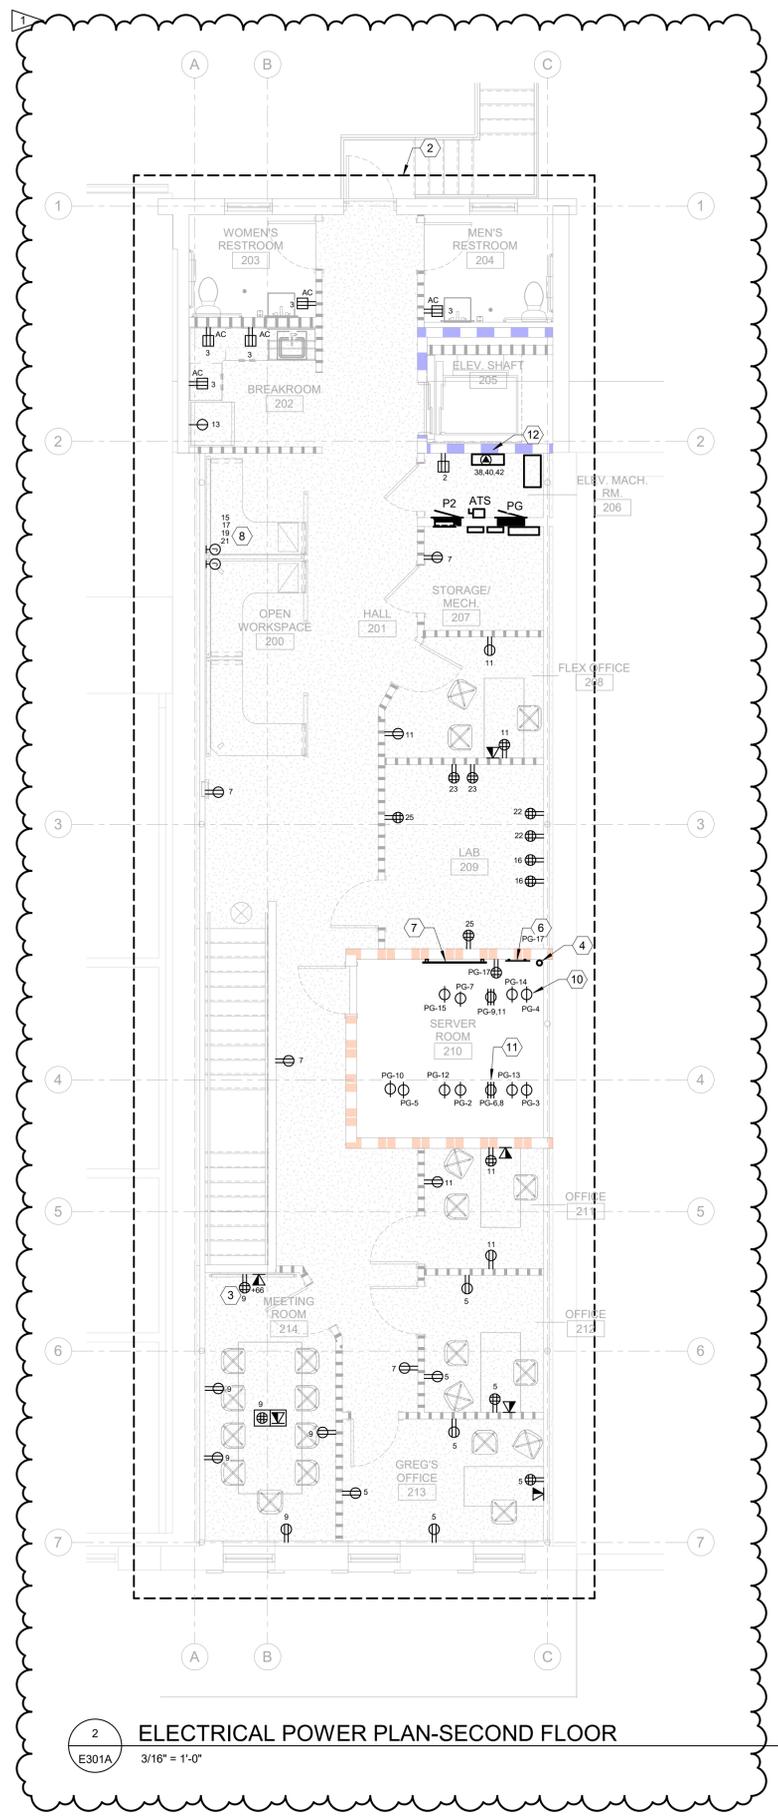

**2 ELECTRICAL POWER PLAN-SECOND FLOOR**  
 E301A 3/16" = 1'-0"

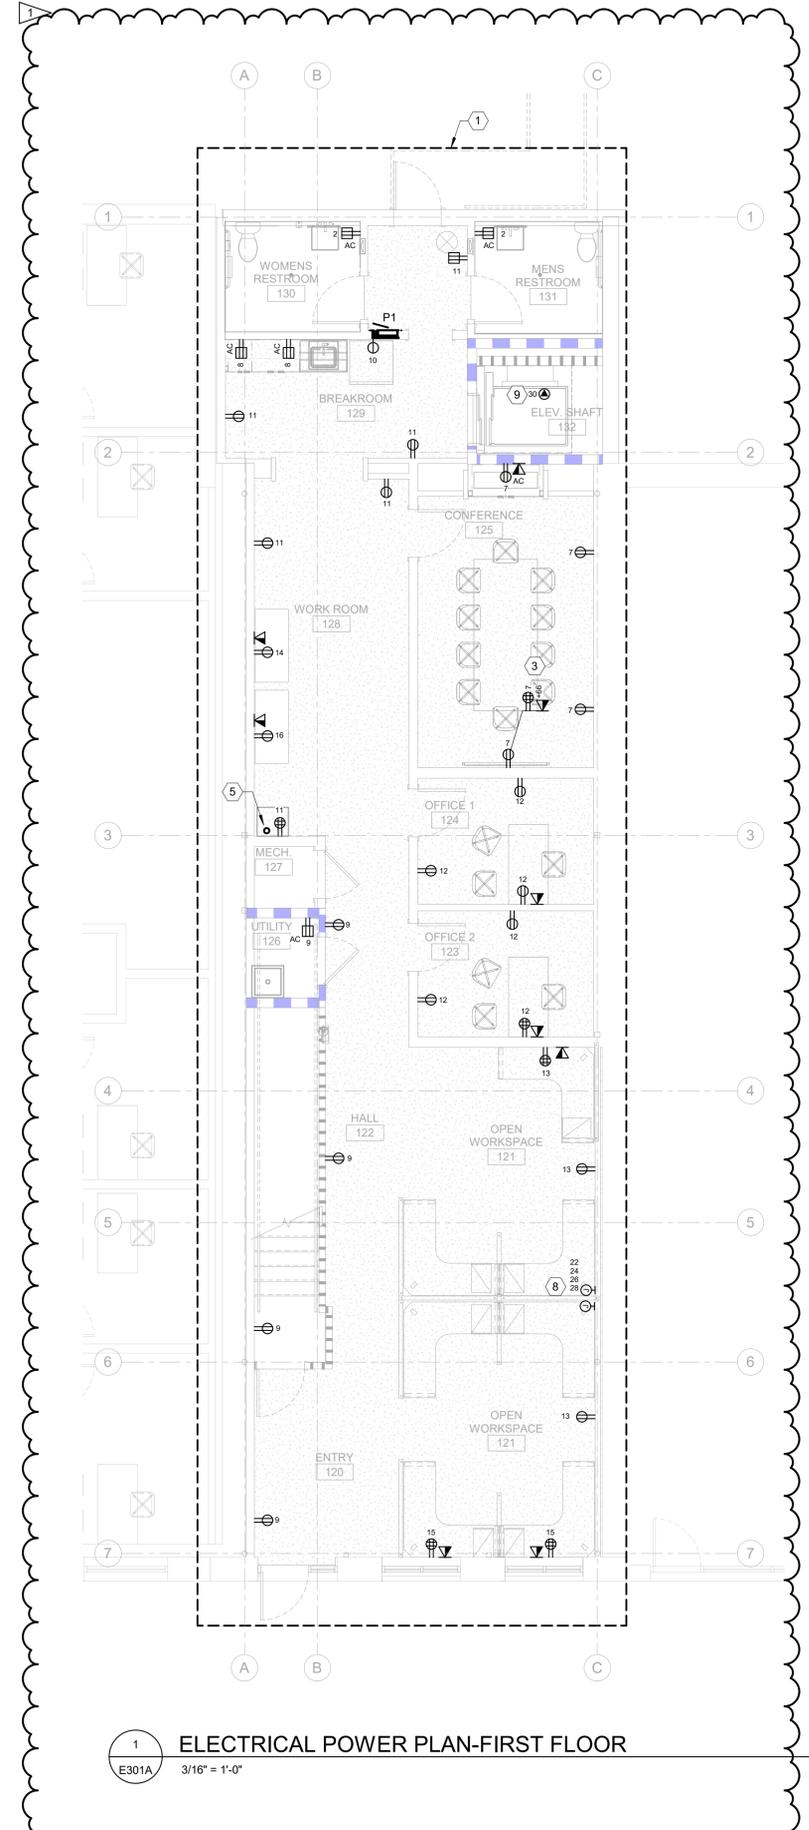

**1 ELECTRICAL POWER PLAN-FIRST FLOOR**  
 E301A 3/16" = 1'-0"




**GENERAL NOTES**


- A. REFER TO SPECIFICATIONS, SCHEDULES, DETAILS AND GENERAL NOTES SHEET FOR ADDITIONAL ELECTRICAL EQUIPMENT AND SYSTEM INSTALLATION REQUIREMENTS.
- B. REFER TO ELECTRICAL EQUIPMENT SCHEDULE FOR DISCONNECT AND CONTROLS REQUIREMENTS.
- C. CONTRACTOR SHALL PROVIDE POWER TO ALL ITEMS SHOWN FROM THE PANEL AND CIRCUIT NUMBERS THAT ARE SHOWN ADJACENT TO THE LOAD. SIZE CIRCUIT PER PANEL SCHEDULE. PROVIDE NEUTRAL AND GROUND, U.N.O.

**# SHEET WORK NOTES**

- 1. MOUNT EQUIPMENT TO STRUCTURE ABOVE CEILING ADJACENT TO LOAD TO BE SERVED, IN A VISIBLE AND ACCESSIBLE LOCATION, AND PROVIDED WITH WORKING SPACE. COORDINATE LOCATION WITH OTHER TRADES PRIOR TO ROUGH-IN. PROVIDE GFCI RECEPTACLE MOUNTED BELOW DISCONNECT. RECEPTACLE SHALL BE CIRCUITED TO NEAREST GENERAL PURPOSE CIRCUIT.
- 2. PROVIDE DUCT MOUNTED SMOKE DETECTOR IN AIR DUCT OF HVAC UNIT. DUCT DETECTOR TO BE WIRED TO SHUT DOWN UNIT UPON DETECTION OF SMOKE. PROVIDE DUCT DETECTOR WITH LED ALARM INDICATOR REMOTE MOUNTED TO BOTTOM OF CEILING BELOW UNIT SERVED. PROVIDE CONTROL POWER FOR DUCT DETECTOR FROM UNIT SERVED. COORDINATE REQUIREMENTS AND INSTALLATION WITH MECHANICAL CONTRACTOR AND INTERFACE WITH FIRE ALARM SYSTEM WITH FIRE ALARM CONTRACTOR.
- 3. MOUNT EQUIPMENT ON WALL ADJACENT TO LOAD TO BE SERVED, IN A VISIBLE AND ACCESSIBLE SPACE, AND PROVIDED WITH NEC REQUIRED CLEARANCES. COORDINATE LOCATION WITH OTHER TRADES PRIOR TO ROUGH-IN. PROVIDE GFCI RECEPTACLE MOUNTED BELOW DISCONNECT. RECEPTACLE SHALL BE CIRCUITED TO NEAREST GENERAL PURPOSE CIRCUIT.
- 4. PROVIDE 120V CONNECTION AND MOTOR RATED SWITCH FOR IT CIRCULATION PUMP. CIRCUIT TO NEAREST GENERAL PURPOSE CIRCUIT.
- 5. COORDINATE WITH MECHANICAL DRAWINGS FOR NEW THERMOSTAT LOCATIONS.
- 6. INDOOR UNIT IS POWERED BY OUTDOOR UNIT. PROVIDE 3#12'S IN 3/4" C. FROM INDOOR UNIT TO OUTDOOR UNIT. COORDINATE CONDUIT ROUTING WITH REFRIGERANT PIPING.

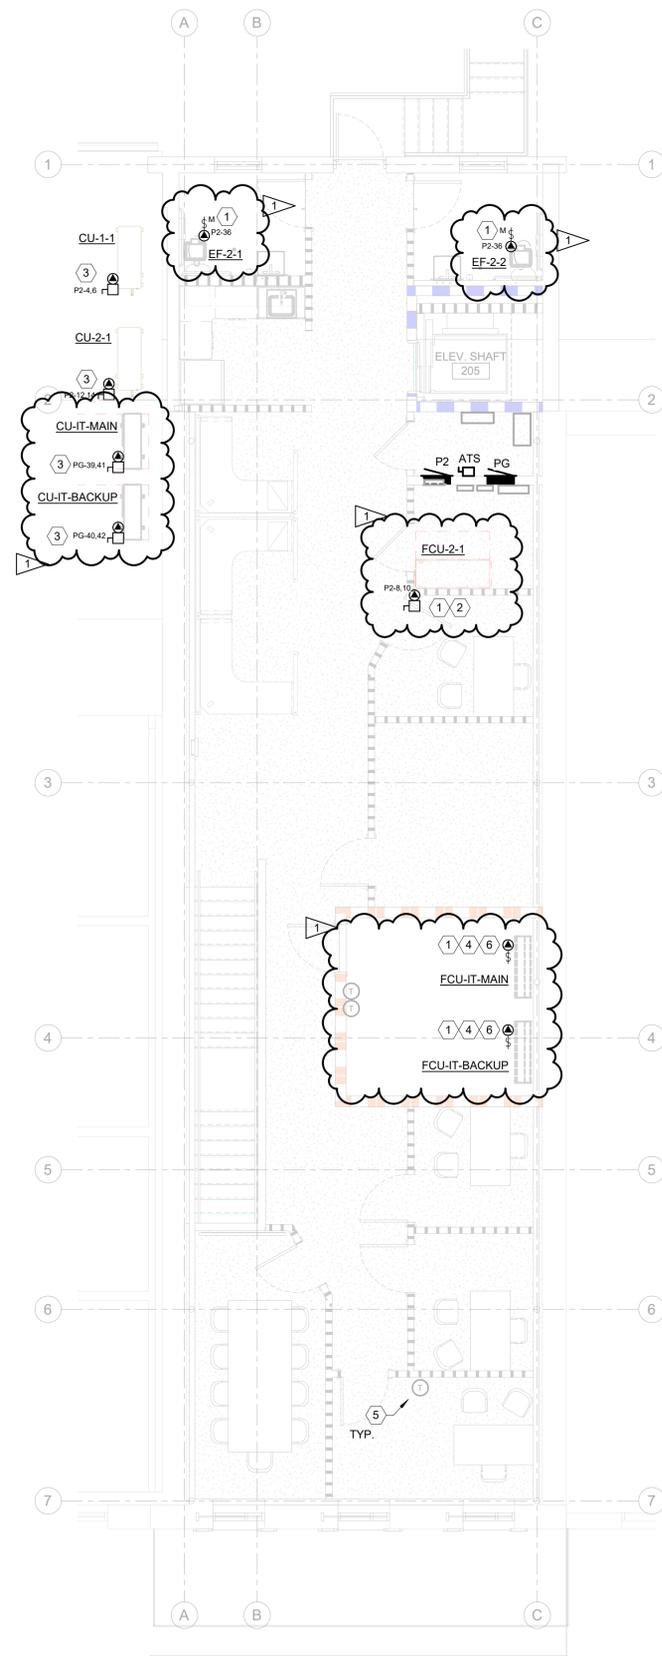

**2**  
 E301B ELECTRICAL HVAC POWER PLAN-SECOND FLOOR  
 3/16" = 1'-0"

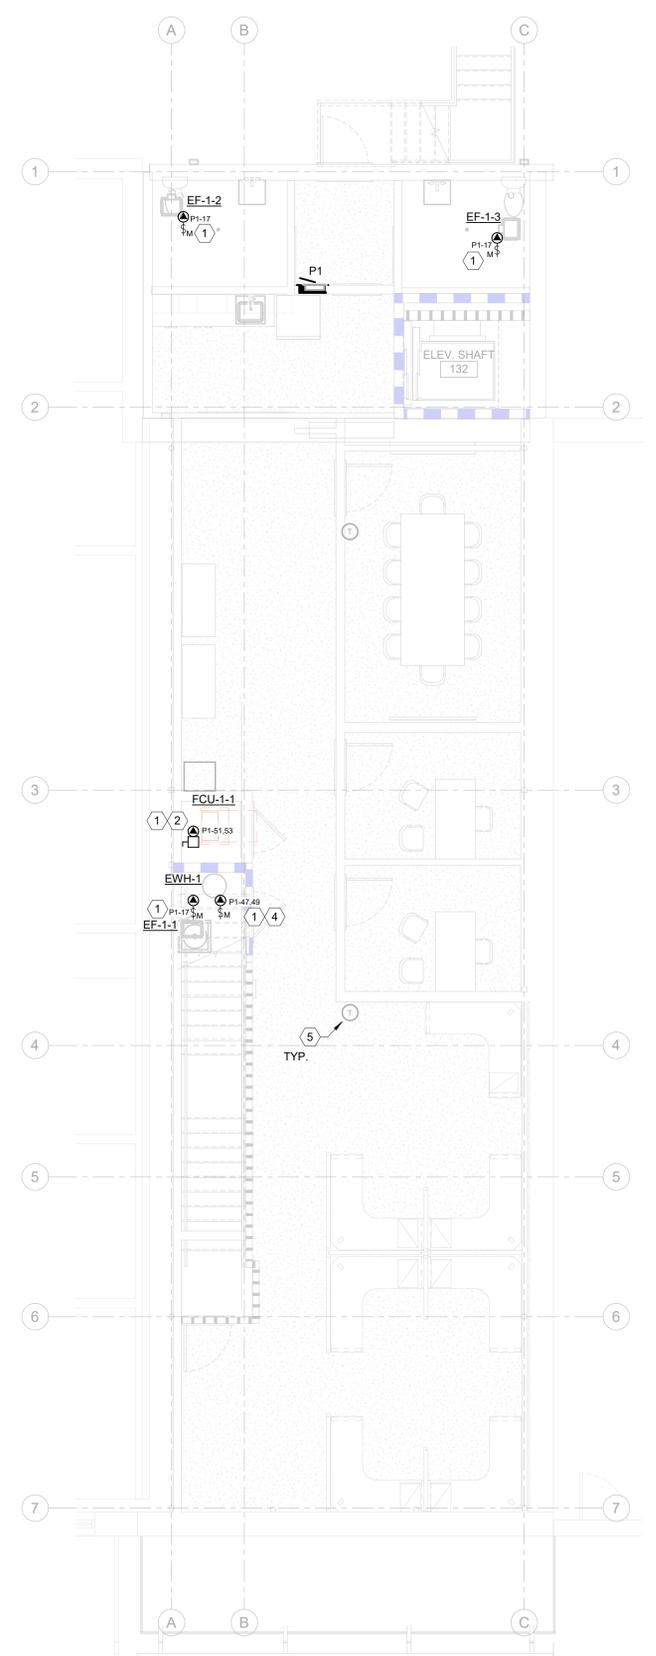

**1**  
 E301B ELECTRICAL HVAC POWER PLAN-FIRST FLOOR  
 3/16" = 1'-0"

127 E. JACKSON ST., BURNETT TX 78611

**BURNETT COUNTY ANNEX**

#	DATE	ISSUE
1	08/21/2025	ADDENDUM 1



Project Number: 33-1408  
 © 2024 LEVY DYKEMA  
 ELECTRICAL HVAC  
 POWER PLANS

MECHANICAL LEGEND AND SYMBOLS	
SYMBOL	DESCRIPTION
—D—	DRAIN
—HWS—	HEATING WATER SUPPLY
—HWR—	HEATING WATER RETURN
—CWS—	CHILLED WATER SUPPLY
—CWR—	CHILLED WATER RETURN
—RS—	REFRIGERANT SUCTION LINE
—RL—	REFRIGERANT LIQUID LINE
—HG—	REFRIGERANT HOT GAS LINE
FOS	FUEL OIL SUPPLY
—FOR—	FUEL OIL RETURN
—FOV—	FUEL OIL VENT
—DFS—	DRY FLUID SUPPLY
—DFR—	DRY FLUID RETURN
—LPS—	LOW PRESSURE STEAM SUPPLY
—COND—	STEAM CONDENSATE RETURN
—G—	GATE VALVE
—B—	BALL VALVE
—BV—	BUTTERFLY VALVE
—GV—	GLOBE VALVE
—TDV—	TRIPLE DUTY VALVE
—SCV—	SWING CHECK VALVE
—S—	STRAINER
—FC—	FLEX CONNECTOR
—HEDV—	HOSE END DRAIN VALVE
—PRV—	PRESSURE REDUCING VALVE
—UR—	UNION
—M—	MOTORIZED T.C. VALVE / 2-WAY
—M3—	MOTORIZED T.C. VALVE / 3-WAY
—EBCV—	ECCENTRIC PLUG BALANCING VALVE
—VIR—	VALVE IN RISER
—TU—	TEE UP
—TDN—	TEE DOWN
—EU—	ELBOW UP
—ED—	ELBOW DOWN
—PSC—	PIPE SIZE CHANGE
—MFBV—	MANUAL FLOW BALANCING VALVE (CIRCUIT SETTER)
—AFBV—	AUTOMATIC FLOW BALANCING VALVE
—PG—	PIPE GUIDE
—PA—	PIPE ANCHOR
—PTP—	PRESSURE / TEMP. TEST PLUG
—DT—	DIAL THERMOMETER

MECHANICAL DESIGN CRITERIA	
SYMBOL	DESCRIPTION
—T—	THERMOSTAT/TEMPERATURE SENSOR
—R—	REVERSE ACTING THERMOSTAT
—T <sub>R</sub> —	THERMOSTAT/TEMPERATURE SENSOR W/ GUARD
—H—	HUMIDISTAT
—CO—	CARBON MONOXIDE SENSOR
—CD—	CARBON DIOXIDE SENSOR
—NO—	NITROGEN DIOXIDE SENSOR
—L—	ACOUSTICALLY LINED SHEET METAL DUCT
—M—	MANUAL BALANCING DAMPER
—F—	FLEX CONNECTOR
—AD—	ACCESS DOORS
—FD—	FIRE DAMPER
—FSD—	FIRE/SMOKE DAMPER
—M—	MOTORIZED DAMPER
—M—	TURNING VANE ELBOW
—L—	45° LOW-LOSS TAKE-OFF FITTING W/ DAMPER & FLEX DUCT
—L—	45° LOW-LOSS TAKE-OFF FITTING W/ DAMPER & RIGID ROUND DUCT
—R—	RECTANGULAR/ROUND DUCT WITH 45° HIGH EFFICIENCY TAKE-OFF
—S—	SUPPLY DIFFUSER W/ FLEX DUCT, THROW PATTERN SHOWN ON PLANS
—S—	LAY-IN SUPPLY DIFFUSER W/ FLEX DUCT, THROW PATTERN SHOWN ON PLANS
—R—	RETURN GRILLE
—G—	EXHAUST GRILLE
—C—	CONNECT NEW WORK TO EXISTING
—P—	PRESSURE GAUGE W/ SNUBBER
—C—	COMMON
—E—	EXISTING

APPLICABLE CODES AND STANDARDS	
1.	BUILDING CODE - 2015 IBC WITH CITY OF BURNET AMENDMENTS
2.	FIRE CODE - 2015 IFC WITH CITY OF BURNET AMENDMENTS
3.	ELECTRICAL CODE - 2014 NEC WITH CITY OF BURNET AMENDMENTS.
4.	MECHANICAL CODE - 2015 IMC WITH CITY OF BURNET AMENDMENTS
5.	PLUMBING CODE - 2015 IPC WITH CITY OF BURNET AMENDMENTS
6.	OTHER - 2015 INTERNATIONAL ENERGY CONSERVATION CODE WITH CITY OF BURNET AMENDMENTS
7.	OTHER - MOST CURRENT ADOPTED VERSION OF NFPA 101, LIFE SAFETY CODE
8.	OTHER - FEDERAL DEPARTMENT OF JUSTICE AMERICANS WITH DISABILITIES ACT AND TEXAS ACCESSIBILITY STANDARDS.

### 2015 IECC ENERGY CODE COMPLIANCE


2015 IECC ENERGY CODE COMPLIANCE	
COMPLIANCE WITH 2015 IECC & CITY OF BURNET AMENDMENTS TO 2015 IECC.	
<b>EQUIPMENT SIZING AND PERFORMANCE:</b>	
1.	LOAD CALCULATIONS HAVE BEEN PERFORMED IN ACCORDANCE WITH ASHRAE STANDARD 183 OR BY AN APPROVED COMPUTATIONAL PROCEDURE USING THE DESIGN PARAMETERS SPECIFIED IN CHAPTER 3 OF THE 2015 IECC.
2.	EQUIPMENT HAS BEEN SELECTED PER 2015 IECC C403.2.2 EQUIPMENT SIZING.
3.	VENTILATION AND THE ABILITY TO REDUCE OUTSIDE AIR TO IMC MINIMUMS SHALL BE PROVIDED PER 2015 IECC C403.2.6 VENTILATION.
<b>HVAC SYSTEM CONTROLS &amp; CRITERIA</b>	
4.	TEMPERATURE CONTROL SYSTEM SHALL HAVE A MINIMUM DEAD BAND OF 5°F AS REQUIRED BY 2015 IECC SECTION C403.2.4.1.2 DEADBAND.
5.	HVAC SYSTEMS SHALL BE EQUIPPED WITH AUTOMATIC CONTROLS CAPABLE OF PROVIDING NIGHT SETBACK, SEVEN DIFFERENT DAILY SCHEDULES AND OPTIMUM START PER THE REQUIREMENTS OF 2015 IECC SECTION C403.2.4.1.2 OFF-HOUR CONTROLS.
6.	OUTSIDE AIR DAMPERS, EXHAUST OUTLETS AND RELIEF OUTLETS SHALL BE PROVIDED WITH DAMPERS THAT COMPLY WITH 2015 IECC SECTION C403.2.4.3 SHUTOFF DAMPERS. DAMPER SHALL AUTOMATICALLY CLOSE WHEN SYSTEM OR SPACES SERVED ARE NOT IN USE OR DURING WARM-UP, COOL-DOWN AND SETBACK. DAMPER MAXIMUM LEAKAGE RATE SHALL NOT EXCEED 4.0 CFM/SF AT 1" WATER GAUGE.
7.	ALL DUCTWORK SHALL BE CONSTRUCTED AND SEALED IN ACCORDANCE WITH 2015 IECC SECTION C403.2.9 CONSTRUCTION OF HVAC SYSTEM ELEMENTS. DUCTWORK INSTALLED ON THIS PROJECT IS CLASSIFIED AS LOW PRESSURE (BELOW 2" WATER GAUGE).
8.	DUCTWORK SHALL BE INSULATED TO THE APPROPRIATE R-VALUE AS LISTED IN THE SPECIFICATIONS ON THIS PROJECT. INSULATION SHALL COMPLY WITH 2015 IECC C403.2.9 DUCT AND PLENUM INSULATION AND SEALING.
<b>TEST, ADJUST AND BALANCING REQUIREMENTS:</b>	
9.	EACH SUPPLY AIR DEVICE AND ZONE TERMINAL DEVICE SHALL BE EQUIPPED WITH MEANS FOR AIR BALANCING IN ACCORDANCE WITH THE REQUIREMENTS OF CHAPTER 6 OF THE IMC. AIR SYSTEMS SHALL BE BALANCED IN A MANNER TO FIRST MINIMIZE THROTTLING LOSSES THEN, FOR FANS WITH SYSTEM POWER GREATER THAN 1 HP, FAN SPEED SHALL BE ADJUSTED TO MEET DESIGN FLOW CONDITIONS.

GENERAL NOTES	
1.	FURNISH AND INSTALL ALL ITEMS NECESSARY TO PROVIDE FULLY FUNCTIONING SYSTEMS AS INDICATED BY THE DESIGN AND THE EQUIPMENT SPECIFIED. ELEMENTS OF THE WORK SHALL INCLUDE, BUT ARE NOT LIMITED TO, MATERIALS, LABOR, SUPERVISION, SUPPLIES, EQUIPMENT, TRANSPORTATION, HOISTING/RIGGING, STORAGE, UTILITIES, AND ALL REQUIRED PERMITS AND LICENSES.
2.	DRAWINGS ARE SCHEMATIC IN NATURE AND DO NOT REFLECT ALL WORK AND MATERIALS REQUIRED TO COMPLETE PROJECT. CONTRACTOR SHALL PROVIDE ALL MATERIALS, LABOR AND EQUIPMENT AS REQUIRED TO COMPLETE PROJECT WITHIN DESIGN. CONTRACTOR SHALL REQUEST ADDITIONAL INFORMATION AND DETAILS WHERE SCOPE IS UNCLEAR.
3.	ALL WORK SHALL COMPLY WITH THE MOST RECENT ADOPTED VERSION OF ALL APPLICABLE LAWS, RULES, REGULATIONS AND ORDINANCES OF ALL FEDERAL, STATE AND LOCAL AUTHORITIES. IF CONFLICT BETWEEN THE CONTRACT DOCUMENTS AND THE LOCAL ENFORCING AUTHORITY EXISTS, THE LOCAL ENFORCING AUTHORITY SHALL APPLY. ANY MODIFICATIONS TO THE DESIGN SHALL BE MADE WITHOUT ADDITIONAL COST TO THE OWNER OR ARCHITECT/ENGINEER. THE CONTRACTOR SHALL REPORT TO THE ARCHITECT/ENGINEER AND SECURE HIS APPROVAL BEFORE PROCEEDING WITH ANY MODIFICATIONS.
4.	WHERE THE REQUIREMENTS OF THE CONTRACT DOCUMENTS EXCEED THE REQUIREMENTS OF THE CODES, THE CONTRACT DOCUMENTS SHALL TAKE PRECEDENCE PROVIDED THAT THEY ARE NOT IN CONFLICT WITH THE CODES.
5.	BEFORE SUBMITTING BIDS, EACH CONTRACTOR SHALL PERFORM A SITE VISIT AND UNDERSTAND THE CONDITIONS TO BE MET IN INSTALLING THE WORK, AND SHALL MAKE PROVISIONS FOR THE CONDITIONS IN HIS FINAL BID. FAILURE ON THE PART OF THE CONTRACTOR TO COMPLY WITH THIS REQUIREMENT SHALL NOT BE CONSIDERED JUSTIFICATION FOR THE OMISSION OR FAULTY INSTALLATION OF ANY WORK COVERED BY THE CONTRACT DOCUMENTS.
6.	MISUNDERSTANDING OF THE SCOPE OR AMOUNT OF WORK TO BE PERFORMED SHALL BE THE RESPONSIBILITY OF THE CONTRACTOR, AND SHALL NOT RESULT IN ANY ADDITIONAL COST TO THE OWNER. TENDER OF A PROPOSAL CONVEYS FULL CONTRACTOR AGREEMENT OF THE ITEMS AND CONDITIONS SPECIFIED AND/OR INDICATED, SCHEDULED, OR IMPLIED ON THE CONTRACT DOCUMENTS, AND/OR REQUIRED BY THE NATURE OF THIS WORK.
7.	ALL WORK SHALL BE CARRIED OUT IN A NEAT, WELL ORGANIZED MANNER. ALL SERVICES SHALL BE ROUTED PARALLEL AND PERPENDICULAR TO THE PRIMARY LINES OF THE BUILDING. LOCATE ALL EQUIPMENT TO PROVIDE ACCESS AND ARRANGE ALL WORK WITH ADEQUATE ACCESS FOR OPERATION AND MAINTENANCE, AND TO MAINTAIN PROPER CODE AND MANUFACTURER'S CLEARANCES.
8.	ALL EQUIPMENT AND MATERIAL TO BE FURNISHED AND INSTALLED ON THIS PROJECT SHALL BE UL OR ETL LISTED, IN ACCORDANCE WITH THE AUTHORITY HAVING JURISDICTION, AND SUITABLE FOR ITS INTENDED USE ON THIS PROJECT.
9.	THE CONTRACTOR SHALL PROVIDE SUBMITTALS FOR ALL NEW EQUIPMENT, CONTROLS, AND FIXTURES TO BE PROVIDED AND INSTALLED.
10.	THE FOLLOWING SUBMITTAL DATA SHALL BE FURNISHED AND SHALL INCLUDE BUT NOT BE LIMITED TO: A. EQUIPMENT AND MATERIALS SHOP DRAWINGS B. COORDINATION DRAWINGS C. RECORD DRAWINGS D. OPERATING AND MAINTENANCE MANUALS E. FIRE STOP MATERIALS AND DETAIL
11.	THE GENERAL CONTRACTOR AND ALL SUBCONTRACTORS SHALL COORDINATE THE INSTALLATION OF DUCTWORK, PIPING, CONDUIT, CABLE, ETC., WITH LIGHTING FIXTURES, SPECIAL CEILING CONSTRUCTION, AIR DISTRIBUTION EQUIPMENT, AND THE STRUCTURE. PROVIDE ADDITIONAL RISES AND OFFSETS AS REQUIRED. IF, AFTER INSTALLED, NEW DUCTWORK, PIPING, CONDUIT, CABLE, ETC., IS FOUND TO BE IN CONFLICT WITH THE ARCHITECTURE, STRUCTURE OR OTHER TRADE WORK, WHICH IS EITHER EXISTING OR SHOWN ON THE CONTRACT DOCUMENTS, THE DUCTWORK, PIPING, CONDUIT, CABLE, ETC., SHALL BE RELOCATED WITHOUT ADDITIONAL COST TO THE OWNER/TENANT. COORDINATE ALL WORK WITH ALL OTHER TRADES PRIOR TO INSTALLATION.
12.	MATERIALS AND EQUIPMENT SHALL BE NEW AND IN GOOD CONDITION. THE COMMERCIAL STANDARD ITEMS OF EQUIPMENT AND THE SPECIFIC NAMES INDICATED ARE INTENDED TO IDENTIFY STANDARDS OF QUALITY AND PERFORMANCE NECESSARY FOR THE PROPER FUNCTIONING OF THE WORK. MATERIALS AND EQUIPMENT, WHICH ARE FOUND TO HAVE FACTORY DEFECTS SHALL BE REPLACED OR REPAIRED IN A MANNER ACCEPTABLE TO THE OWNER/TENANT AND ENGINEER AT NO ADDITIONAL COST TO THE OWNER/TENANT.
13.	DAMAGE CAUSED DURING CONSTRUCTION TO EXISTING MATERIALS/EQUIPMENT WILL BE REPAIRED OR REPLACED AT NO ADDITIONAL COST TO OWNER. RE-SUPPORT ANY REMAINING PIPING OR DEVICES THAT WERE SUPPORTED BY WALLS BEING REMOVED.
14.	THE WARRANTY PERIOD SHALL BE NO LESS THAN ONE (1) FULL YEAR, UNLESS SPECIFIED OTHERWISE AND SHALL INCLUDE AT LEAST ONE (1) FULL HEATING SEASON AND ONE (1) FULL COOLING SEASON. DURING THE WARRANTY PERIOD THE CONTRACTOR SHALL GUARANTEE THE FOLLOWING IN A FORM SPECIFIC TO THE OWNER/TENANT: A. ALL WORK INSTALLED SHALL BE FREE FROM ANY AND ALL DEFECTS IN WORKMANSHIP AND/OR MATERIALS. B. ALL APPARATUS WILL DEVELOP CAPACITIES AND PERFORMANCE CHARACTERISTICS SPECIFIED. C. THE SYSTEMS SHALL OPERATE WITHOUT MALFUNCTION.
15.	THE START OF THE CONTRACTOR'S WARRANTY PERIOD SHALL COMMENCE ON THE DATE OF "SUBSTANTIAL COMPLETION" AS AGREED TO BY THE OWNER/TENANT.
16.	AREAS OF THE EXISTING BUILDING WILL BE OCCUPIED DURING CONSTRUCTION OF THIS PROJECT. NOISY, DUSTY, AND/OR OTHER CONSTRUCTION OPERATIONS REQUIRED FOR WORK WHICH DISTURB OR CAUSE COMPLAINTS BY THE EXISTING BUILDING OCCUPANTS SHALL NOT BE ACCEPTABLE. ALL AFTER-HOUR OR OVERTIME WORK REQUIRED BY THE CONTRACTOR TO AVOID DISRUPTION OF EXISTING OCCUPANTS WILL BE PROVIDED AT NO COST TO THE OWNER/TENANT. THE CONTRACTOR SHALL USE CONSTRUCTION METHODS AND MATERIALS WHICH SHALL NOT ADVERSELY AFFECT THE INDOOR AIR QUALITY OF THE EXISTING OCCUPIED AREAS.
17.	PORTIONS OF THE BUILDING WILL BE IN USE AND OCCUPIED DURING THE CONSTRUCTION PERIOD OF THIS PROJECT. ALL BUILDING SERVICES, UTILITIES, POWER, CHILLED WATER, FIRE PROTECTION, AND DOMESTIC COLD AND HOT WATER WHICH WILL BE REQUIRED FOR THIS PROJECT MAY NOT BE DISRUPTED FOR ANY REASON WITHOUT PRIOR COORDINATION WITH A REPRESENTATIVE OF BUILDING MANAGEMENT AND THE OWNER AND A WRITTEN AUTHORIZATION FROM THE BUILDING MANAGER AND OWNER DESIGNATING A DATE, TIME, AND DURATION THAT ARE APPROVED BY THE BUILDING MANAGER AND OWNER FOR SUCH DISRUPTION. AN ADDITIONAL ADVANCE NOTIFICATION OF SEVEN (7) DAYS SHALL BE GIVEN TO THE BUILDING MANAGER AND OWNER PRIOR TO EACH DISRUPTION.
18.	THIS BUILDING MAY HAVE A STRUCTURAL SYSTEM UTILIZING POST-TENSIONED CABLES. THE CONTRACTOR SHALL DETERMINE THE EXISTING STRUCTURAL SYSTEM PRIOR TO CUTTING, DRILLING, OR CORING. THE CONTRACTOR SHALL X-RAY ALL PENETRATIONS PRIOR TO CUTTING THE FLOOR SLAB.
19.	THIS CONTRACTOR SHALL SECURE ALL PERMITS, LICENSES AND INSPECTIONS REQUIRED FOR HIS WORK, AND SHALL PAY ALL FEES IN CONNECTION WITH SUCH PERMITS, LICENSES AND INSPECTIONS.
20.	IN THE EVENT OF A CONFLICT BETWEEN DRAWINGS AND/OR SPECIFICATIONS, THE CONTRACTOR SHALL PROVIDE PRICING REFLECTING THE GREATEST COST. THE CONFLICT SHALL BE BROUGHT TO THE ATTENTION OF THE ENGINEER FOR CLARIFICATION.
21.	PENETRATIONS THROUGH FLOORS OR FIRE-RATED CONSTRUCTION SHALL BE FIRE RATED TO COMPLY WITH ASTM E-814 (UL 1479), AND THE LOCAL AUTHORITY HAVING JURISDICTION.
22.	UPON COMPLETION OF THE PROJECT, THE CONTRACTOR SHALL SUBMIT TO THE ENGINEER, A COMPLETE SET OF "AS BUILT" DRAWINGS PORTRAYING ACTUAL SITE CONDITIONS OF THE MECHANICAL, ELECTRICAL, PLUMBING AND FIRE PROTECTION WORK. SUBMISSION SHALL CONSIST OF ONE SET OF PAPER COPIES AND ONE SET OF CAD FILES IN AUTOCAD (CONTRACTOR SHALL UTILIZE OWNER'S LAYER STANDARDS IF EXISTING).
23.	IN THE EVENT THAT MATERIALS, PRODUCTS, AND/OR PROCESSES BEING PROPOSED FOR THIS PROJECT CONTAIN, OR MAY EMIT, ANY VOLATILE ORGANIC COMPOUNDS (VOC), FORMALDEHYDE FORMULATIONS, OR HAZARDOUS OUT-GASSING, AS DETERMINED BY THE MANUFACTURER, A MATERIALS SAFETY DATA SHEET SHALL BE SUBMITTED AS PART OF THE SHOP DRAWING PROCESS FOR REVIEW BY THE ARCHITECT/ENGINEER/ OWNER.
24.	THE CONTRACTOR SHALL TAKE NOTE THAT THE DRAWINGS ARE SCHEMATIC IN NATURE AND INDICATE THE APPROXIMATE LOCATIONS OF THE HVAC AND PLUMBING SYSTEMS. LOCATE ALL ITEMS IN THE FIELD. COORDINATE WITH OTHER TRADES TO ENSURE PROPER FIT AND ACCESS TO ALL ITEMS.
25.	THE CONTRACTOR SHALL PROTECT THE WORK, EQUIPMENT, AND MATERIALS FROM DAMAGE BY HIS WORK OR HIS PERSONNEL, AND SHALL CORRECT ALL DAMAGE CAUSED WITHOUT ADDITIONAL COST TO THE OWNER. THE CONTRACTOR SHALL BE RESPONSIBLE FOR ALL WORK, MATERIALS, AND EQUIPMENT UNTIL FINAL ACCEPTANCE BY THE OWNER. PROTECT ALL WORK AGAINST THEFT, INJURY, OR DAMAGE. CAREFULLY STORE MATERIAL AND EQUIPMENT RECEIVED ON SITE WHICH IS NOT IMMEDIATELY INSTALLED. THE CONTRACTOR SHALL CLOSE OPEN ENDS OF WORK WITH TEMPORARY COVERS OR PLUGS DURING CONSTRUCTION TO PREVENT THE ENTRY OF DUST, DIRT, AND OBSTRUCTING MATERIAL.


MECHANICAL ABBREVIATIONS	
AFF	ABOVE FINISHED FLOOR
ACFM	ACTUAL CFM
AHU	AIR HANDLING UNIT
ANSI	AMERICAN NATIONAL STANDARDS INSTITUTE
AMP	AMPERE (AMP, AMPS)
APD	AIR PRESSURE DROP
APPROX	APPROXIMATE
BHP	BRAKE HORSEPOWER, BOILER HORSEPOWER
BTU	BRITISH THERMAL UNIT
BD	BOTTOM OF DUCT
MBH	BTU PER HOUR (THOUSAND)
C	COMMON
CU FT	CUBIC FEET
CU IN	CUBIC INCH
CFM	CUBIC FEET PER MINUTE
COD	CENTER OF DUCT
SCFM	CFM, STANDARD CONDITIONS
DB	DECIBEL
DIA	DIAMETER
ID	DIAMETER, INSIDE
OD	DIAMETER, OUTER
DBT	DRY-BULB TEMPERATURE
EAT	ENTERING AIR TEMPERATURE
EC	ELECTRICAL CONTRACTOR
EDR	EQUIVALENT DIRECT RADIATION
EXP	EXPANSION
EWT	ENTERING WATER TEMPERATURE
F	FAHRENHEIT
FPM	FEET PER MINUTE
FPS	FEET PER SECOND
FT	FOOT OR FEET
HZ	FREQUENCY
GA	GAGE OR GAUGE
GAL	GALLONS
G.C.	GENERAL CONTRACTOR
GPH	GALLONS PER HOUR
GPM	GALLONS PER MINUTE
GPD	GALLONS PER DAY
HD	HEAD
HGT	HEIGHT
HP	HORSEPOWER
RH	HUMIDITY, RELATIVE
KW	KILOWATT
KWH	KILOWATT HOUR
LAT	LEAVING AIR TEMPERATURE
LWT	LEAVING WATER TEMPERATURE
LF	LINEAR FEET
MAX	MAXIMUM
MC	MECHANICAL CONTRACTOR
MIN	MINIMUM
NO	NORMALLY OPEN
NC	NORMALLY CLOSED
N/A	NOT APPLICABLE
NIC	NOT IN CONTRACT
NTS	NOT TO SCALE
NO	NUMBER
QBD	OPPOSED BLADE DAMPER
OA	OUTSIDE AIR
%	PERCENT
PH	PHASE (ELECTRICAL)
LBS	POUNDS
PSI	POUNDS PER SQUARE INCH
PSIA	PSI ABSOLUTE
PD	PRESSURE DROP
PSIG	PSI GAUGE
R/O	RUN OUT
RA	RETURN AIR
RPM	REVOLUTIONS PER MINUTE
SH	SENSIBLE HEAT
SPEC	SPECIFICATION
SP VOL	SPECIFIC VOLUME
STD	STANDARD
SP	STATIC PRESSURE
SUCT	SUCTION
SA	SUPPLY AIR
TEMP	TEMPERATURE
TD	TEMPERATURE DIFFERENCE
T STAT	THERMOSTAT
TOD	TOP OF DUCT
TONS	TONS OF REFRIGERATION
TC	TEMPERATURE CONTROL
VAC	VACUUM
VAV	VARIABLE AIR VOLUME
VEL	VELOCITY
V	VOLT
VOL	VOLUME
VFD	VARIABLE FREQUENCY DRIVE
WPD	WATER PRESSURE DROP
W	WITH

MECHANICAL GENERAL NOTES	
1.	ALL EXISTING DUCTWORK AND PIPING SIZES AND LOCATIONS SHOWN ARE FROM EXISTING RECORDS, DOCUMENTS, AND SITE OBSERVATIONS. MECHANICAL CONTRACTOR SHALL FIELD VERIFY ALL EXISTING CONDITIONS AND SHALL INCLUDE IN HIS BID THE COST OF REPLACEMENT, REPAIR, RELOCATION, OR REMOVAL OF EXISTING MEP ITEMS AS REQUIRED TO COMPLETE THE INSTALLATION OF ALL MECHANICAL SYSTEMS SHOWN ON THESE DRAWINGS PRIOR TO SUBMITTING A BID.
2.	THE CONTRACTOR SHALL VERIFY THAT ALL EXISTING AND NEW TERMINAL UNITS ARE MOUNTED SO THAT ALL REQUIRED SERVICING AND MAINTENANCE CLEARANCES ARE MAINTAINED AT THE BOTTOM AND SIDES OF EACH UNIT. COORDINATE WITH ALL NEW ARCHITECTURAL WALLS TO STRUCTURE AND RELOCATE TERMINAL UNITS AS REQUIRED TO MAINTAIN PROPER CLEARANCES.
3.	IT IS ACCEPTABLE TO REUSE EXISTING AIR DEVICES IF THEY MATCH THE SCHEDULED MANUFACTURER AND MODEL NUMBER, NECK SIZE AND PERFORMANCE INDICATED IN THIS DRAWING SET. CONTRACTOR SHALL FIELD VERIFY EXISTING CONDITIONS AND TAKE INVENTORY OF EXISTING AIR DEVICES WITHIN THE SPACE PRIOR TO SUBMITTING A BID. ALL REUSED AIR DEVICES SHALL BE CLEANED AND REPAINTED AS REQUIRED TO RETURN TO "LIKE-NEW" CONDITIONS.
4.	EXISTING TAKE-OFF CONNECTIONS MAY BE REUSED IF LOCATED WITHIN 3'-0" OF NEW CONNECTION SHOWN ON DRAWING. ALL TAKE-OFF CONNECTIONS NOT USED SHALL BE REMOVED AND DUCTWORK SHALL BE PATCHED WITH SHEET METAL, SEALED AND RE-INSULATED TO MATCH EXISTING.
5.	NO FAN POWERED TERMINAL UNITS SHALL HAVE SPRINKLER PIPING BLOCKING BOTTOM-MOUNTED ACCESS PANELS. OFFSET NEW AND EXISTING SPRINKLER PIPING AS REQUIRED. EXISTING FAN POWERED TERMINAL BOXES MOUNTED ABOVE OR ADJACENT TO WALLS WHERE ACCESS IS OBSTRUCTED SHALL BE RELOCATED AS REQUIRED.
6.	MECHANICAL CONTRACTOR SHALL COORDINATE WITH ALL OTHER MEP TRADES TO MAINTAIN A MINIMUM OF 9' CLEAR SPACE FOR TENANT EQUIPMENT, CABLE TRAY, WIRING, ETC.
7.	PROVIDE REMOTE DAMPER OPERATORS FOR ALL SPIN-IN DAMPERS LOCATED ABOVE INACCESSIBLE CEILINGS. OPERATORS SHALL BE ROTO-TWIST (OR APPROVED EQUAL) CABLE-TYPE OPERATORS, CONCEALED WITHIN DUCT RUN-OUT TO DEVICE, AND ACCESSIBLE FOR BALANCING FROM FACE OF AIR DEVICE. PROVIDE REQUIRED CABLE LENGTHS, MOUNTING CLIPS, AND ALL OTHER REQUIRED COMPONENTS FOR PROPER INSTALLATION AND OPERATION.
8.	PRIMARY AND SECONDARY DUCTWORK SHALL HAVE EXTERNAL INSULATION INSTALLED ON TOP SIDE OF DUCTWORK PRIOR TO HANGING DUCTWORK TO ALLOW DUCT TO BE SUSPENDED WITH INSULATION TIGHT TO STRUCTURE. DO NOT COMPRESS INSULATION.
9.	IT SHALL BE THE CONTRACTOR'S RESPONSIBILITY TO BRING TO THE ENGINEER'S ATTENTION ANY WALLS THAT EXTEND FROM THE FINISHED FLOOR TO STRUCTURE AND REQUIRE RETURN AIR PATHWAYS. RETURN AIR BOOTS SHALL BE INSTALLED TO PROVIDE CROSS SECTIONAL AREA EQUIVALENT TO 500 FPM OF AIRFLOW BASED ON THE SUPPLY CFM TO THE ROOM ENCLOSED BY THE FULL HEIGHT WALLS.
10.	FINAL LOCATION OF ALL NEW EQUIPMENT SHALL BE APPROVED BY BUILDING OWNER OR PROJECT MECHANICAL ENGINEER PRIOR TO INSTALLATION.
11.	ROOF PENETRATIONS SHALL BE PERFORMED TO MAINTAIN THE WARRANTY ON THE ROOF. COORDINATE PENETRATIONS WITH THE ROOF MEMBRANE MANUFACTURER.
12.	MOUNT ALL TEMPERATURE CONTROL DEVICES 48" ABOVE FINISHED FLOOR TO THE CENTER OF THE DEVICE TO COMPLY WITH THE REQUIREMENTS OF THE AMERICANS WITH DISABILITIES ACT ANSI A117.1.
13.	DURING CONSTRUCTION, SEAL ALL OPEN DUCTS WITH PLASTIC TO PREVENT DUST/DIRT. CLEAN ALL INTERIOR DUCT SURFACES PRIOR TO DUCT INSTALLATION. ALL VAV TERMINAL UNIT FILTERS SHALL BE MAINTAINED DURING CONSTRUCTION AND REPLACED AT THE END OF CONSTRUCTION. PROVIDE CONSTRUCTION FILTERS OVER AIR HANDLING UNIT INTAKES AND MAINTAIN FILTER MEDIA DURING CONSTRUCTION. REPLACE ALL FILTERS AT END OF CONSTRUCTION. ALL RETURN AIR INTAKES TO MECHANICAL ROOM SHALL BE COVERED WITH FILTER MEDIA DURING CONSTRUCTION. REMOVE UPON COMPLETION.
14.	SEAL ALL NEW AND EXISTING PIPE, CONDUIT, AND DUCT PENETRATIONS THRU FIRE RATED WALLS WITH FIRE CAULKING. FIRE CAULKING SHALL BE EQUAL TO 3M BRAND CP25WP FIRE CAULK. INSTALL CAULKING IN STRICT ACCORDANCE WITH ALL MANUFACTURER'S RECOMMENDATIONS AND WRITTEN INSTRUCTIONS AND IN ACCORDANCE WITH ALL APPLICABLE UL DETAILS.
15.	CONTRACTOR SHALL MAINTAIN A SET OF CONSTRUCTION DOCUMENTS FOR THE SOLE PURPOSE OF INDICATING AS-BUILT CONDITIONS. SET SHALL NOT BE USED FOR ANY OTHER PURPOSE. AS-BUILT REVISIONS SHALL BE INDICATED USING RED PENCIL AND BE CLEARLY DRAWN AND LABELED TO BE LEGIBLE. ILLEGIBLE ENTRIES SHALL BE REVISIED BY THE CONTRACTOR. PROVIDE AS-BUILT SET TO THE OWNER AT SUBSTANTIAL COMPLETION.
16.	CONTRACTOR SHALL COMPLETE START-UP FORMS AND CHECK-OUT UTILIZING MANUFACTURER CERTIFIED START-UP TECHNICIANS. EQUIPMENT START-UP AND CHECK-OUT FORMS SHALL BE INCLUDED IN THE O&M MANUALS.
17.	RADIUS ELBOWS 2 TIMES THE DUCT DIMENSION AND LARGER DO NOT REQUIRE SPLITTER VANES; PROVIDE SPLITTER VANES FOR ALL RADIUS ELBOWS 1.5 TIMES AND SMALLER. SPLITTER VANES SHALL BE LOCATED AND SECURED IN ACCORDANCE WITH SMACNA "HVAC DUCT CONSTRUCTION STANDARDS - METAL AND FLEXIBLE."
18.	RECTANGULAR ELBOWS SHALL INCORPORATE TURNING VANES. VANES SHALL BE SINGLE-THICKNESS GALVANIZED STEEL VANES SET IN GALVANIZED STEEL RUNNERS. VANES AND RUNNERS SHALL BE CONSTRUCTED AND SECURED IN ACCORDANCE WITH SMACNA "HVAC DUCT CONSTRUCTION STANDARDS - METAL AND FLEXIBLE."


SHEET LIST	
DRAWING	SHEET TITLE
M001	MECHANICAL COVER SHEET
M002	MECHANICAL DETAILS
M003	MECHANICAL SCHEDULES
M004	MECHANICAL HVAC PLANS
M301	MECHANICAL ROOF PLAN

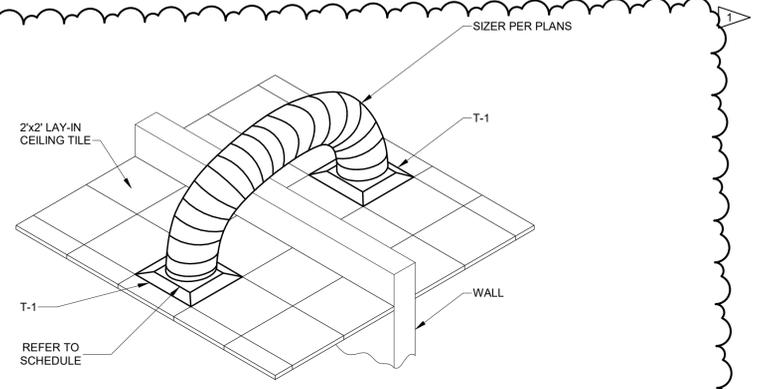


**H TRANSFER DUCT DETAIL**  
 M002 NOT TO SCALE

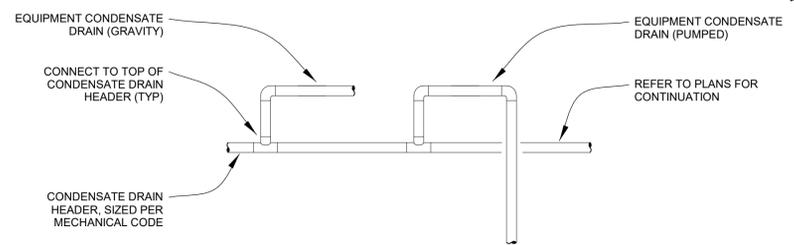


**J DIFFUSER IN LAY-IN CEILING DETAIL**  
 M002 NOT TO SCALE

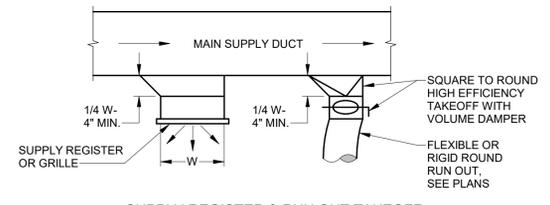

**SUPPLY REGISTER & RUN OUT TAKEOFF**

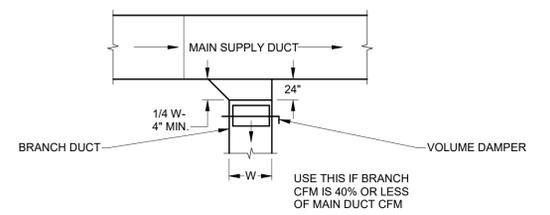


**BRANCH DUCT TAKEOFF**

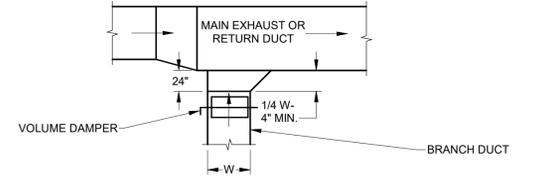


**EXHAUST AND/OR RETURN BRANCH DUCT**

**K LOW VELOCITY DUCT DETAILS**  
 M002 NOT TO SCALE

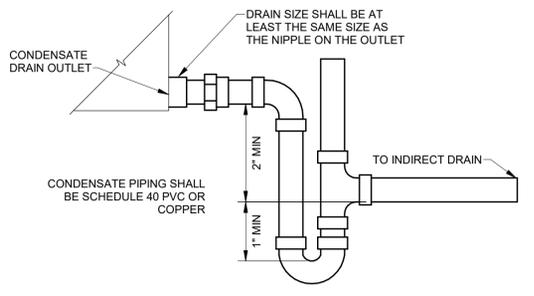


**D CONDENSATE TRAP**  
 M002 NOT TO SCALE

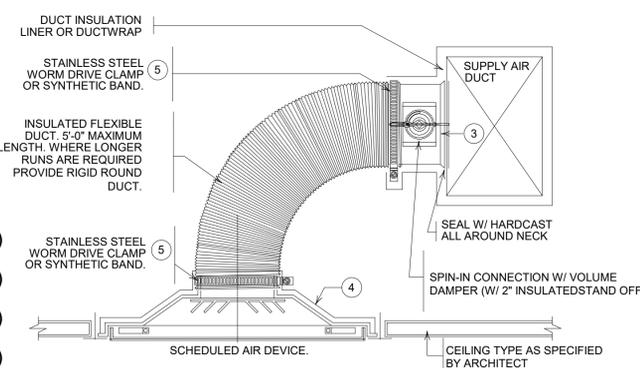


- NOTES:
1. CEILING DIFFUSER SHALL BE INSTALLED SUCH THAT THE FACE OF DIFFUSER IS FLUSH WITH CEILING.
  2. SUPPORT FLEXIBLE DUCT FROM STRUCTURE, FLEXIBLE DUCT SHALL NOT KINK, SAG OR REST ON LIGHT FIXTURE, CEILING SUPPORT "TEES" OR CEILING TILE.
  3. PROVIDE SQUARE TO ROUND TAP WHERE FLEXIBLE DUCT SIZE EXCEEDS DIMENSION OF RECTANGULAR DUCT. (SEE DET. FOR ADDITIONAL INFORMATION.)
  4. FOR UNCONDITIONED CEILING PLENUMS, INSULATE ENTIRE BACK OF CEILING DIFFUSER WITH 2" DUCT WRAP AND SEAL WITH VAPOR BARRIER TAPE.
  5. EXTEND INSULATION AND OUTER JACKET OVER THE SECURE CLAMP/BAND AND TAPE DOWN TO SLEEVE/COLLAR TO MAINTAIN VAPOR BARRIER INTEGRITY. (TYPICAL)


**E DIFFUSER DETAIL**  
 M002 NOT TO SCALE

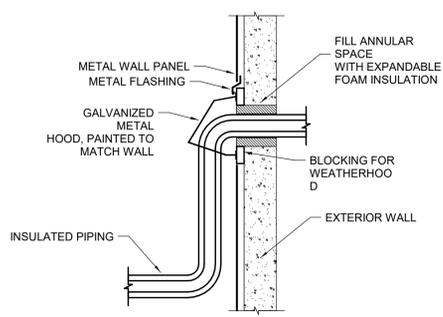


**G EXHAUST FAN DETAIL**  
 M002 NOT TO SCALE

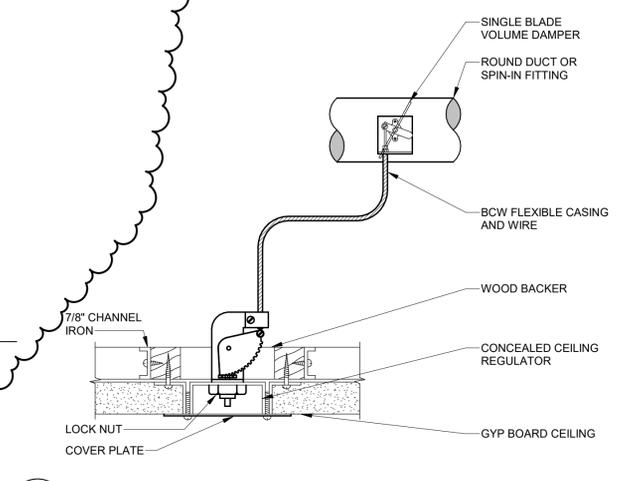


**F REMOTE DAMPER DETAIL**  
 M002 NOT TO SCALE

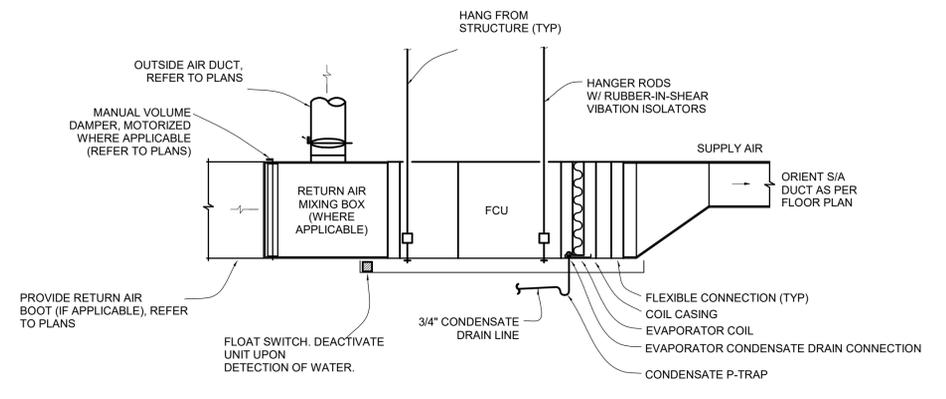

**A FAN COIL UNIT - RETURN BOOT**  
 M002 NOT TO SCALE

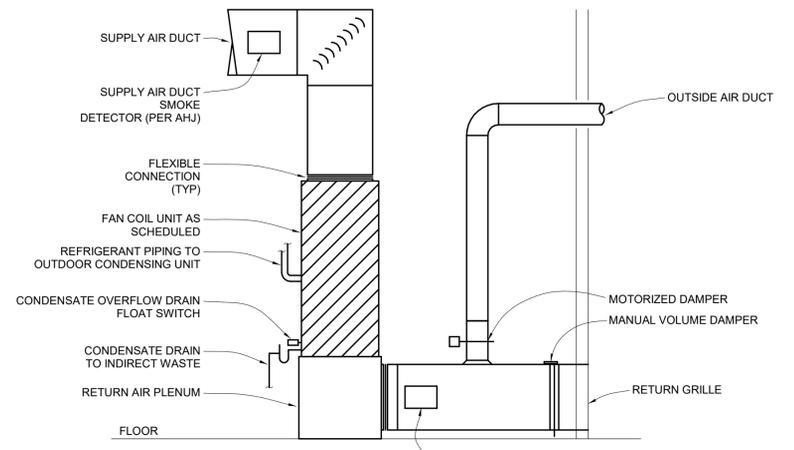

**B VERTICAL FAN COIL UNIT DETAIL**  
 M002 NOT TO SCALE

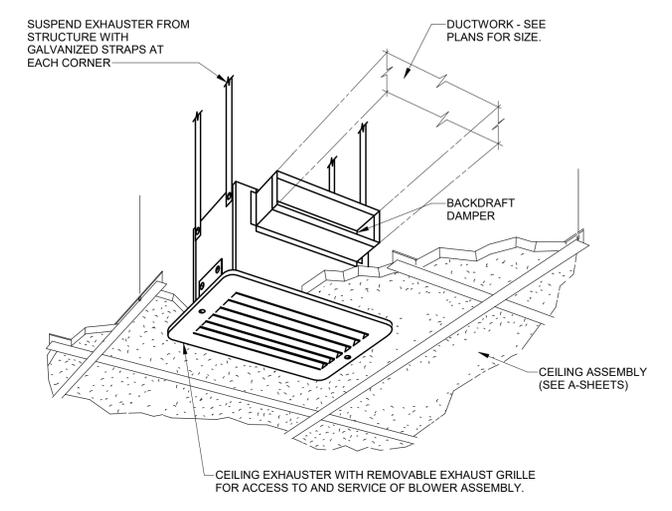

**C CEILING MOUNTED EXHAUST FAN**  
 M002 NOT TO SCALE

### VENTILATION / PRESSURE CALCS - 1ST FLOOR

OUTSIDE AIR INTAKE		BUILDING EXHAUST		
TAG	AIR FLOW (CFM)	TAG	SERVICE	AIR FLOW (CFM)
FCU-1-1	210	EF-1-1	126 UTILITY	0
		EF-1-2	130 WOMEN'S RESTROOM	75
		EF-1-3	131 MEN'S RESTROOM	75
<b>TOTAL OA (CFM)</b>	<b>210</b>	<b>TOTAL EXHAUST (CFM)</b>		<b>150</b>
<b>REQUIRED MIN. VENTILATION RATE (CFM)</b>				207
<b>TOTAL BUILDING PRESSURIZATION (CFM)</b>				60
<b>BUILDING PRESSURIZATION RATE (CFM/SF)</b>				0.04

**NOTES:**  
 (1) TOTAL APPROXIMATE AREA 1,560 SQUARE FT  
 (2) \*INTERMITTENT USAGE, TWO FAN OPERATIONAL SIMULTANEOUSLY.

### VENTILATION / PRESSURE CALCS - 2ND FLOOR

OUTSIDE AIR INTAKE		BUILDING EXHAUST		
TAG	AIR FLOW (CFM)	TAG	SERVICE	AIR FLOW (CFM)
FCU-2-1	220	EF-2-1	203 WOMEN'S RESTROOM	75
		EF-2-2	204 MEN'S RESTROOM	75
<b>TOTAL OA (CFM)</b>	<b>220</b>	<b>TOTAL EXHAUST (CFM)</b>		<b>150</b>
<b>REQUIRED MIN. VENTILATION RATE (CFM)</b>				219
<b>TOTAL BUILDING PRESSURIZATION (CFM)</b>				70
<b>BUILDING PRESSURIZATION RATE (CFM/SF)</b>				0.04

**NOTES:**  
 (1) TOTAL APPROXIMATE AREA 1,767 SQUARE FT  
 (2) \*INTERMITTENT USAGE, TWO FAN OPERATIONAL SIMULTANEOUSLY.

### AIR DEVICE SCHEDULE

TAG	MANUFACTURER	MODEL	DUCT SIZE (IN)	NOM. FACE SIZE (IN)	MAX AIRFLOW (CFM)	THROW (@50 FPM)	NC AT MAX AIRFLOW	MATERIAL	FINISH	MOUNTING	NOTES
<b>SUPPLY GRILLE</b>											
S-1	TITUS	OMNI	6"Ø	12x12	135	11	17	ALUMINUM	WHITE SURFACE	LAY-IN	1-6
S-2	TITUS	OMNI	6"Ø	12x12	135	11	17	STEEL	WHITE SURFACE	LAY-IN	1-6
S-3	TITUS	OMNI	6"Ø	24x24	135	6	NC < 10	STEEL	WHITE	LAY-IN	1-6
S-4	TITUS	OMNI	8"Ø	24x24	245	10	12	STEEL	WHITE	LAY-IN	1-6
S-5	TITUS	OMNI	10"Ø	24x24	435	14	20	STEEL	WHITE	LAY-IN	1-6
<b>RETURN GRILLE</b>											
R-1	TITUS	350RL	18x18	20x20	1450	-	28	STEEL	WHITE	WALL	1-4
R-2	TITUS	350RL	24x20	26x22	2180	-	30	STEEL	WHITE	WALL	1-4
<b>TRANSFER GRILLE</b>											
T-1	TITUS	PAR	22x10	24x12	765	-	-	STEEL	WHITE	LAY-IN	1-6

**NOTES:**  
 (1) COORDINATE WITH ARCHITECTURAL DRAWINGS FOR REQUIRED MOUNTING TYPES.  
 (2) COORDINATE WITH ARCHITECT AND GC FOR FINAL COLOR OF AIR DEVICE.  
 (3) AIR DEVICES FROM ALTERNATE MANUFACTURER EQUAL TO SCHEDULED MODELS ARE ACCEPTABLE (PRICE, METALAIR, ETC.).  
 (4) AIR DEVICES LOCATED IN INACCESSIBLE CEILINGS TO BE PROVIDED WITH REMOTE OPERABLE SINGLE BLADE AIR DAMPERS.  
 (5) PLAQUE AIR DEVICES TO BE PROVIDED WITH BACKPAN INSULATION.  
 (6) MECHANICAL CONTRACTOR TO SIZE BRANCH DUCTWORK TO MAINTAIN AT LEAST ≤ 800 FPM OR AS INDICATED ON PLANS.

### EXHAUST FAN SCHEDULE

TAG	MANUFACTURER	MODEL	SERVICE	LOCATION	FAN TYPE	DRIVE TYPE	AIR VOLUME (CFM)	EXT. STATIC PRESSURE (IN WG)	ELEC		WEIGHT (LBS)	NOTES
									POWER	MOTOR SIZE		
EF-1-1, 2, & 3 EF-2-1 & 2	GREENHECK	SP-A50-90-VG	REFER TO PLANS	CEILING	CENTRIFUGAL	DIRECT	75	0.25	120/60/1	6 W	12	1-3

**NOTES:**  
 (1) FANS PROVIDED AND INSTALLED BY MECHANICAL CONTRACTOR.  
 (2) PROVIDE MANUFACTURER'S INTEGRAL BACKDRAFT DAMPER, VIBRATION ISOLATION KIT, AND DECORATIVE GRILLE.  
 (3) COORDINATE WITH ELECTRICAL CONTRACTOR FOR INSTALLATION AND WIRING OF DISCONNECTING MEANS. ELECTRICAL TO INTERLOCK WITH LIGHTS. PROVIDE LIGHT SWITCH WITH TIME-DELAY RELAY.  
 (4) ALTERNATE MANUFACTURERES: COOK, METALAIR

**ACCESSORIES:**  
 (1) NEMA-3R DISCONNECT SWITCH PROVIDED WITH EQUIPMENT, WIRED BY EC

### SPLIT SYSTEM SCHEDULE

	FCU-1-1	FCU-2-1	FCU-IT-MAIN & BACKUP
<b>INDOOR UNIT</b>			
MANUFACTURER	TRANE	TRANE	TRANE
MODEL	TEM8A0C48V41+TDR	TEM8A0D60V51+TDR	PKA-A36AKA8
TYPE	DX SPLIT HEAT PUMP	DX SPLIT HEAT PUMP	DX SPLIT COOLING ONLY
SIZE	4 TON	5 TON	3 TON
ORIENTATION	MULTIPOSITION	MULTIPOSITION	WALL MOUNT
WEIGHT (LBS)	174	174	46
<b>SUPPLY FAN SECTION</b>			
DESIGN AIRFLOW (CFM)	1530	2010	830
DESIGN OUTSIDE AIRFLOW (CFM)	210	220	
DESIGN ESP (IN WTR)	0.5	0.5	N/A
MOTOR RATING (HP)	3/4	3/4	74 WATTS
FLA (AMPS)	5.7	5.7	0.6
<b>COOLING SECTION</b>			
AMBIENT (°F)	95	95	95
MIXED AIR (EAT) DESIGN CONDITIONS DB/WB (°F)	80 / 67	80 / 67	80 / 67
COOL CAPACITY (AHRI TOTAL MBH)	48.00	58.50	33.40
<b>HEAT PUMP HEATING</b>			
AMBIENT (°F)	17	17	N/A
CAPACITY (MBH)	31.4	37.8	N/A
HSPF2 (AHRI 210/240 - 2023)	9.00	8.70	N/A
<b>ELECTRICAL</b>			
VOLTAGE/PH	208-230/60/1	208-230/60/1	POWERED BY OUTDOOR UNIT
AUX. HEATER CAPACITY (208/240)	3.60 / 4.80	3.60 / 4.80	-
AMPS	17.3 / 20.0	17.3 / 20.0	-
MCA (AMPS) (208/230)	25.0 / 29.0	25.0 / 29.0	-
MOCP (AMPS) (208/230)	25 / 30	25 / 30	-
NOTES / ACCESSORIES	(1 - 7)	(1 - 7)	(1 - 6, & 8)
<b>OUTDOOR UNIT</b>			
TAG	CU-1-1	CU-2-1	CU-IT-MAIN & BACKUP
MANUFACTURER	TRANE	TRANE	TRANE
MODEL	4TTL9048A1	4TTL9060A1	PUY-AK36NL
TYPE	HEAT PUMP	HEAT PUMP	COOLING ONLY HEAT PUMP
SIZE	4.0 TON	5.0 TON	3.0 TON
WEIGHT (LBS)	245	245	224
<b>COMPRESSOR INFORMATION</b>			
NO./TYPE	1 / SCROLL	1 / TWIN ROTARY	1 / TWIN ROTARY
REFRIGERANT	R-410A	R-410A	R-454B
STAGES	VARIABLE	VARIABLE	VARIABLE
<b>EFFICIENCY (AHRI 210/243)</b>			
AMBIENT DB	105.0	105.0	105.0
EER2/SEER2 (AHRI 210/240 - 2023)	12.0 / 19.0	11.0 / 19.0	12.0 / 20.3
<b>ELECTRICAL</b>			
VOLTAGE/PH	208-230/60/1	208-230/60/1	208-230/60/1
MCA	31.8	36.1	34.0
MOCP	35	40	56
NOTES / ACCESSORIES	(9 - 11)	(9 - 11)	(9 - 11)

**NOTES / ACCESSORIES:**  
 (1) NEMA 1 DISCONNECT PROVIDED AND INSTALLED BY ELECTRICAL CONTRACTOR  
 (2) MANUFACTURER WIRED CONTROLS  
 (3) AUXILIARY DRAIN PAN WITH FLOAT SWITCH W/ AUTOMATIC SHUT DOWN UPON DETECTION OF WATER  
 (4) FILTER RACK AND FILTER  
 (5) MANUFACTURER'S 7-DAY PROGRAMMABLE THERMOSTAT  
 (6) COORDINATE DISCONNECT SIZE AND REQUIREMENTS WITH ELECTRICAL CONTRACTOR. ELECTRICAL CONTRACTOR TO PROVIDE AND INSTALL.  
 (7) PROVIDE AND INSTALL LITTLE GIANT MODEL #553201, 1/18 HP MOTOR, 115V/1PH WITH CORDED PLUG. MINIMUM PERFORMANCE 1.7 GPM AT 20-FT OF HEAD.  
 (8) PROVIDE AND INSTALL MANUFACTURER'S PREFERRED CONDENSATE PUMP BLUEDIAMOND #MAXIBLUE  
 (9) PROVIDE LOCKING REFRIGERANT PORT CAPS  
 (10) HAIL GUARDS, ANTI-SHORT CYCLE TIMER, HIGH PRESSURE SWITCH  
 (11) DEFROST CONTROL


### OA SCHEDULE

Outside air shall be provided in accordance with ASHRAE Standard 62.1-2022 as follows:


Room	Qty.	Rp (CFM/P)	Pz (People)	Ra (CFM/SF)	Az (SF)	Vbz (CFM)	Voz (CFM)
<b>FCU-1-1</b>							
120 ENTRY	1	5	2	0.06	261	25.7	32.1
121 OPEN WORKSPACE	1	5	5	0.06	340	45.4	56.8
122 HALL	1	0	0	0.06	71	4.3	5.3
123 OFFICE 2	1	5	1	0.06	87	10.2	12.8
124 OFFICE 1	1	5	1	0.06	87	10.2	12.8
125 CONFERENCE*	1	5	10	0.06	196	36.8	46.0
126 UTILITY	1	0	0	0.00	20	0.0	0.0
127 MECH	1	0	0	0.00	14	0.0	0.0
128 WORKROOM*	1	5	2	0.06	223	18.4	23.0
129 BREAKROOM	1	5	1	0.06	115	11.9	14.9
129 BREAKROOM (EXIT)	1	0	0	0.06	46	2.8	3.4
130 WOMENS RESTROOM	1	0	0	0.00	46	0.0	0.0
131 MENS RESTROOM	1	0	0	0.00	54	0.0	0.0
<b>Total</b>				22.0	1,560.0		207.0
						<b>PROVIDED</b>	<b>210.0</b>
<b>FCU-2-1</b>							
200 OPEN SPACE	1	5	3	0.06	152	24.1	30.2
201 HALL	1	0	0	0.06	653	39.2	49.0
202 BREAKROOM*	1	5	1	0.06	61	6.2	7.7
203 WOMENS RESTROOM	1	0	0	0.00	50	0.0	0.0
204 MENS RESTROOM	1	0	0	0.00	64	0.0	0.0
206 ELEV & MECH RM	1	0	0	0.00	41	0.0	0.0
207 STORAGE	1	0	0	0.06	38	2.3	2.8
208 FLEX OFFICE	1	5	1	0.06	70	9.2	11.5
209 LAB	1	10	1	0.18	140	35.2	44.0
211 OFFICE	1	5	1	0.06	57	8.4	10.5
212 OFFICE	1	5	1	0.06	64	8.8	11.1
213 GREGS OFFICE*	1	5	2	0.06	102	11.1	13.9
214 MEETING ROOM*	1	5	9	0.06	136	30.7	38.3
<b>Total</b>				19.0	1,628.0		219.0
						<b>PROVIDED</b>	<b>220.0</b>
						<b>TOTAL OA REQUIRED</b>	<b>425.9</b>
						<b>TOTAL OA PROVIDED</b>	<b>430.0</b>

\*Intermittent occupancy reduced 50%



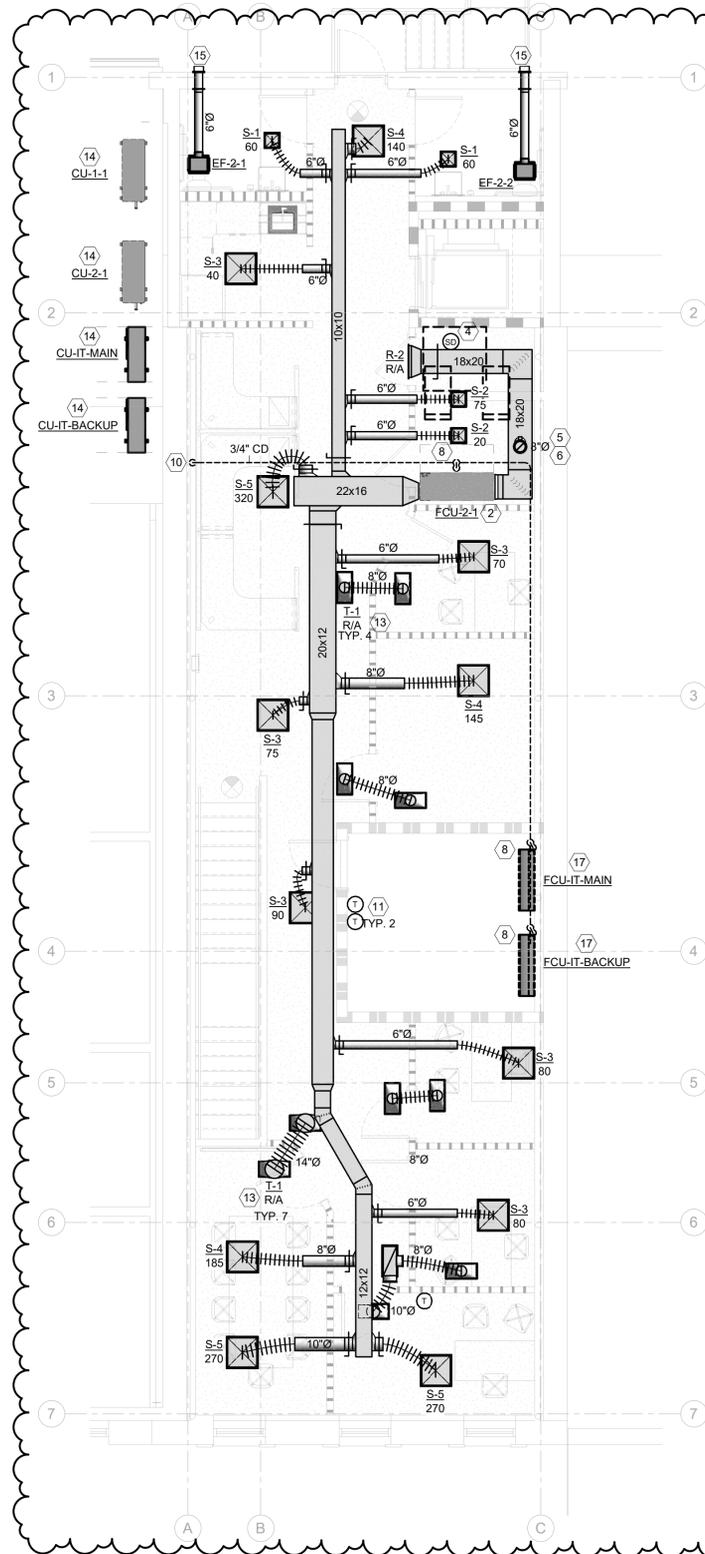

2 MECHANICAL HVAC PLAN-SECOND FLOOR  
M201 3/16" = 1'-0"

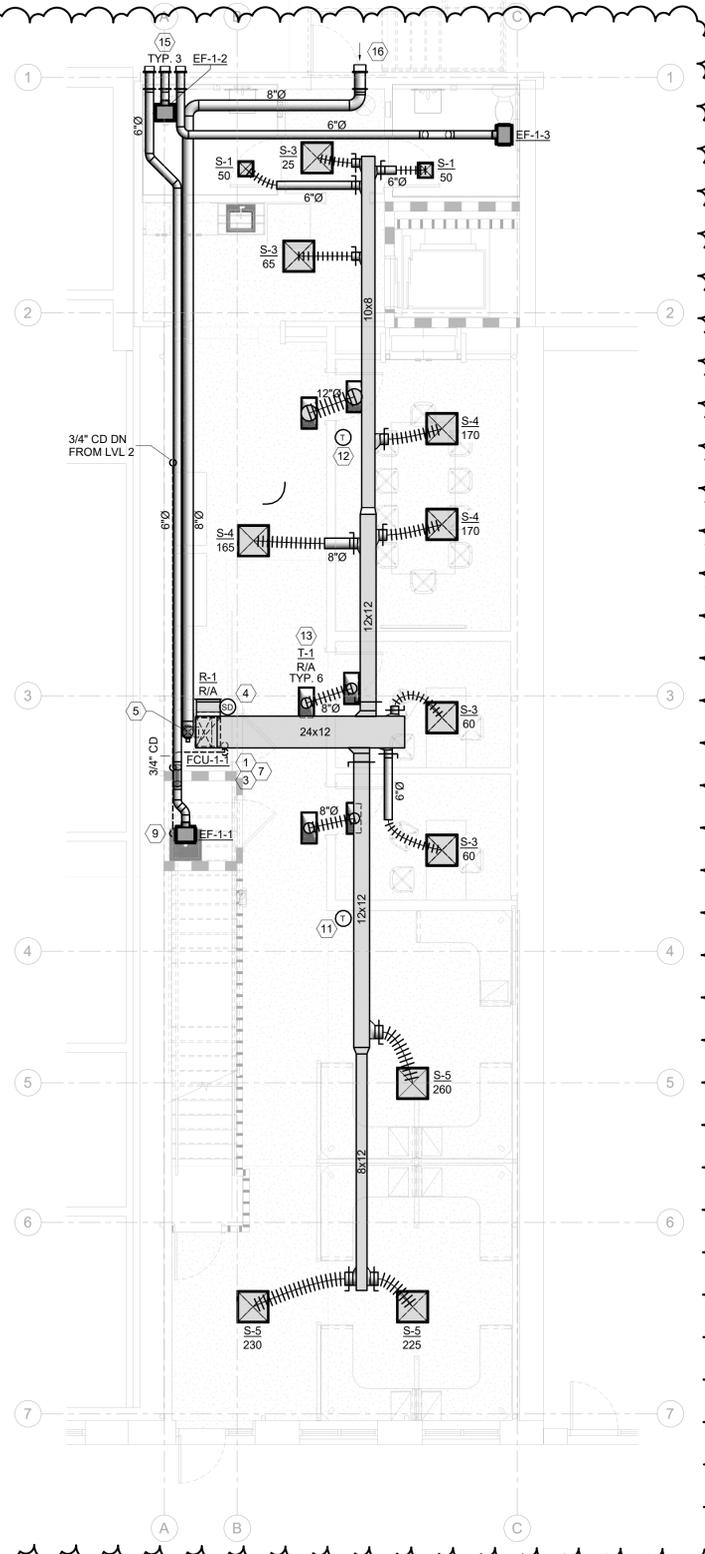

1 MECHANICAL HVAC PLAN-FIRST FLOOR  
M201 3/16" = 1'-0"

FLEXIBLE DUCT SIZE TABLE	
AIRFLOW (CFM)	FLEXIBLE DUCT SIZE
0 - 100	6" RND
101 - 225	8" RND
226 - 400	10" RND
401 - 650	12" RND
651 - 925	14" RND

**NOTES:**  
FLEXIBLE DUCTWORK EQUIVALENT TO FLEXMASTER 6M

**GENERAL NOTES**

- A. REFER TO MECHANICAL COVER SHEET DRAWING FOR SYMBOLS, ABBREVIATIONS, SPECIFICATIONS, AND ADDITIONAL INFORMATION.
- B. DUE TO DRAWING SCALE, IT IS NOT POSSIBLE TO INDICATE ALL OFFSETS, FITTINGS, AND ACCESSORIES WHICH MAY BE REQUIRED. THE CONTRACTOR SHALL EXAMINE FIELD CONDITIONS AND FURNISH THE NECESSARY FITTINGS WHICH MAY BE REQUIRED TO COMPLETE THE INSTALLATION.
- C. FINAL LOCATION OF ALL NEW EQUIPMENT, PRIOR TO EQUIPMENT INSTALLATION, SHALL BE APPROVED BY BUILDING OWNER AND PROJECT MECHANICAL ENGINEER IF LOCATION DIFFERS FROM CONSTRUCTION DOCUMENTS.
- D. MAINTAIN CODE REQUIRED AND MANUFACTURER'S RECOMMENDED CLEARANCES FOR ALL NEW EQUIPMENT.
- E. MECHANICAL CONTRACTOR SHALL BE RESPONSIBLE FOR COORDINATING ALL FINAL AIR DEVICE/DOOR COLORS TO MATCH ARCHITECTURAL CEILING FINISHES.
- F. COORDINATE INSTALLATION OF ALL EQUIPMENT, DUCTWORK, AIR DEVICES, AND ACCESSORIES WITH ALL OTHER TRADES SO AS TO AVOID INSTALLATION CONFLICTS.
- G. DUCTWORK SHALL BE KEPT TIGHT TO STRUCTURE, WHERE APPLICABLE, RUN BRANCH DUCTWORK WITHIN ROOF TRUSSES, COORDINATE WITH NEW PLUMBING, ELECTRICAL AND FIRE UTILITIES TO AVOID CONFLICTS.

**# SHEET WORK NOTES**

1. PROVIDE AND INSTALL FAN COIL UNIT (FCU) VERTICALLY WITH RETURN AIR PLENUM/SUPPORT BELOW AIR HANDLER IN SECONDARY CONTAINMENT PAN. FIELD COORDINATE FINAL INSTALLATION LOCATION AND ORIENTATION WITH ALL OTHER TRADES. REFER TO VERTICAL AIR HANDLER UNIT DETAIL FOR ADDITIONAL INFORMATION.
2. PROVIDE AND INSTALL FAN COIL UNIT (FCU) HORIZONTALLY IN SECONDARY CONTAINMENT PAN. FIELD COORDINATE FINAL INSTALLATION LOCATION AND HEIGHT WITH OTHER TRADES. REFER TO HORIZONTAL AIR HANDLER UNIT DETAIL FOR ADDITIONAL INFORMATION.
3. PROVIDE P-TRAP AT EQUIPMENT CONNECTION PER DETAILS AND PROVIDE INTEGRAL FLOAT SWITCH IN CONDENSATE DRAIN PAN. INTEGRAL FLOAT SWITCH TO AUTOMATICALLY SHUT OFF FAN COIL UNIT (FCU) UPON DETECTION OF WATER.
4. PROVIDE AND INSTALL DEDICATED SMOKE DETECTOR AS REQUIRED BY CODE AND LOCAL AHJ. IN THE RETURN DUCT OF UNITS 2,000 CFM OR GREATER OR WHERE COMBINED CFM OF SHARED RETURN CFM EXCEEDS 2,000 CFM. DETECTORS SHALL BE CONNECTED TO THE ALARM SYSTEM TO GENERATE SUPERVISORY NOTIFICATION. UPON DETECTION, UNIT SHALL SHUT DOWN AUTOMATICALLY AND ALARM. COORDINATE WITH FIRE ALARM CONTRACTOR.
5. PROVIDE MOTORIZED BACKDRAFT DAMPER. UPON UNIT FAN, ENERGIZING, DAMPER SHALL OPEN AND PROVIDE CODE MINIMUM OA PER SCHEDULE; OUTSIDE AIR DUCT TO CONNECT TO FAN COIL UNIT (FCU) RETURN AIR PLENUM, DOWNSTREAM OF RETURN AIR BALANCING DAMPER.
6. ROUTE 8"Ø OUTSIDE AIR DUCT UP TO ROOF. TERMINATE AT ROOF WITH ROOF CAP EQUAL TO LUXURY METAL #5JV826. COORDINATE WITH ROOFING CONTRACTOR FOR INSTALLATION AND FLASHING SO AS NOT TO VOID ROOF WARRANTY. TRANSITION AS REQUIRED TO DUCT CONNECTION SIZE AT OUTSIDE AIR INTAKE. REFER TO M301 FOR CONTINUATION.
7. ROUTE 3/4" CONDENSATE DRAIN PIPE FROM FAN COIL UNIT (FCU) TO MOP SINK AS SHOWN. REFER TO MANUFACTURER'S AHU INSTALLATION REQUIREMENTS. ALL PIPING SHALL BE INSULATED AND SLOPED AT MINIMUM 1/8"/FT. TERMINATE INSULATED CONDENSATE DRAIN PIPING WITH INDIRECT CONNECTION. COORDINATE WITH PLUMBING CONTRACTOR FOR FINAL TERMINATION.
8. ROUTE PUMPED CONDENSATE DRAIN PIPE FROM FAN COIL UNIT (FCU) DRAIN CONNECTION TIGHT TO STRUCTURE AND CONTINUE TO GRAVITY HEADER (REFER TO DETAILS). ROUTE CONDENSATE DRAIN AS HIGH AS POSSIBLE TO ACCOMMODATE FALL TO DISCHARGE LOCATION. REFER TO FCU MANUFACTURER'S INSTALLATION REQUIREMENTS. ALL PIPING SHALL BE INSULATED AND SLOPED AT MINIMUM 1/8"/FT.
9. 3/4" INSULATED CONDENSATE DRAIN SHALL TERMINATE AT MOP SINK RIM WITH 1" AIR GAP. COORDINATE WITH PLUMBING CONTRACTOR FOR FINAL TERMINATION.
10. ROUTE 3/4" INSULATED CONDENSATE DOWN FROM LEVEL 2 TO LEVEL 1, AND TIE INTO 3/4" INSULATED CONDENSATE FROM FCU-1-1.
11. PROVIDE AND INSTALL THERMOSTAT WITH REMOTE SENSOR 54" A.F.F. COORDINATE WITH ELECTRICAL CONTRACTOR TO PROVIDE EMPTY J-BOX AND CONDUIT FOR THERMOSTAT LOCATION. UTILIZE TEMPERATURE AVERAGING FOR FCU-1-1 UNIT CONTROL.
12. PROVIDE AND INSTALL THERMOSTAT WITH REMOTE SENSOR 54" A.F.F. COORDINATE WITH ELECTRICAL CONTRACTOR TO PROVIDE EMPTY J-BOX AND CONDUIT FOR THERMOSTAT LOCATION.
13. PROVIDE AND INSTALL AIR TRANSFER DUCT/DEVICES PER SCHEDULES AND DETAILS. REFER TO DETAILS AND SCHEDULES FOR ADDITIONAL INFORMATION.
14. PROVIDE AND INSTALL CONDENSING UNIT ON WALL OF ANNEX, ACCESSIBLE FROM ADJACENT ROOF STRUCTURE. COORDINATE WITH MANUFACTURER TO PROVIDE WALL MOUNTING BRACE FOR CONDENSING UNITS. ROUTE REFRIGERANT PIPING THROUGH WATERTIGHT PENETRATION TO SERVE FAN COIL UNIT INDOORS. ALL INSULATED REFRIGERANT PIPING EXPOSED TO THE ELEMENTS SHALL BE PROVIDED WITH ALUMINUM METAL JACKET FOR PROTECTION.
15. TERMINATE EXHAUST AT EXTERIOR WALL WITH MANUFACTURER'S WALL CAP. MAINTAIN CODE REQUIRED MINIMUM 10-FT CLEARANCE TO ALL OUTSIDE AIR INTAKES. TYPICAL.
16. PROVIDE AND INSTALL 8"Ø OUTSIDE AIR INTAKE EQUAL TO BROAN 643FA WITH INSECT SCREEN ON INTAKE. ROUTE 8" RND OUTSIDE AIR DUCT TIGHT TO STRUCTURE TO RETURN OF FAN COIL UNIT.
17. INSTALL FAN COIL UNIT (FCU) ON WALL AT APPROX. 9'-0" A.F.F. PER MANUFACTURER'S INSTALLATION INSTRUCTIONS.



127 E JACKSON ST. BURNET TX 78611

BURNET COUNTY ANNEX

#	DATE	ISSUE
1	08/21/2025	ADDENDUM 1



Project Number: 33-1408  
© 2024 LEVY DYKEMA  
MECHANICAL HVAC PLAN

M201



08/26/2025

127 E JACKSON ST. BURNET TX 78611


BURNET COUNTY ANNEX

### GENERAL NOTES

- A. REFER TO MECHANICAL COVER SHEET DRAWING FOR SYMBOLS, ABBREVIATIONS, SPECIFICATIONS, AND ADDITIONAL INFORMATION.
- B. DUE TO DRAWING SCALE, IT IS NOT POSSIBLE TO INDICATE ALL OFFSETS, FITTINGS, AND ACCESSORIES WHICH MAY BE REQUIRED. THE CONTRACTOR SHALL EXAMINE FIELD CONDITIONS AND FURNISH THE NECESSARY FITTINGS WHICH MAY BE REQUIRED TO COMPLETE THE INSTALLATION.
- C. FINAL LOCATION OF ALL NEW EQUIPMENT, PRIOR TO EQUIPMENT INSTALLATION, SHALL BE APPROVED BY BUILDING OWNER AND PROJECT MECHANICAL ENGINEER IF LOCATION DIFFERS FROM CONSTRUCTION DOCUMENTS.
- D. MAINTAIN CODE REQUIRED AND MANUFACTURER'S RECOMMENDED CLEARANCES FOR ALL NEW EQUIPMENT.
- E. MECHANICAL CONTRACTOR SHALL BE RESPONSIBLE FOR COORDINATING ALL FINAL AIR DEVICE/LOUVER COLORS TO MATCH ARCHITECTURAL CEILING FINISHES.
- F. COORDINATE INSTALLATION OF ALL EQUIPMENT, DUCTWORK, AIR DEVICES, AND ACCESSORIES WITH ALL OTHER TRADES SO AS TO AVOID INSTALLATION CONFLICTS.
- G. DUCTWORK SHALL BE KEPT TIGHT TO STRUCTURE WHERE APPLICABLE, RUN BRANCH DUCTWORK WITHIN ROOF TRUSSES. COORDINATE WITH NEW PLUMBING, ELECTRICAL AND FIRE UTILITIES TO AVOID CONFLICTS.

### # SHEET WORK NOTES

- 1. PROVIDE AND INSTALL ROOF CAP EQUAL TO LUXURY METAL #SJV826. COORDINATE WITH ROOFING CONTRACTOR FOR INSTALLATION AND FLASHING SO AS NOT TO VOID ROOF WARRANTY. ROOF CAP TO BE LOCATED 10'-0" OR GREATER FROM ANY EXHAUST OUTLET AND PLUMBING VENT.

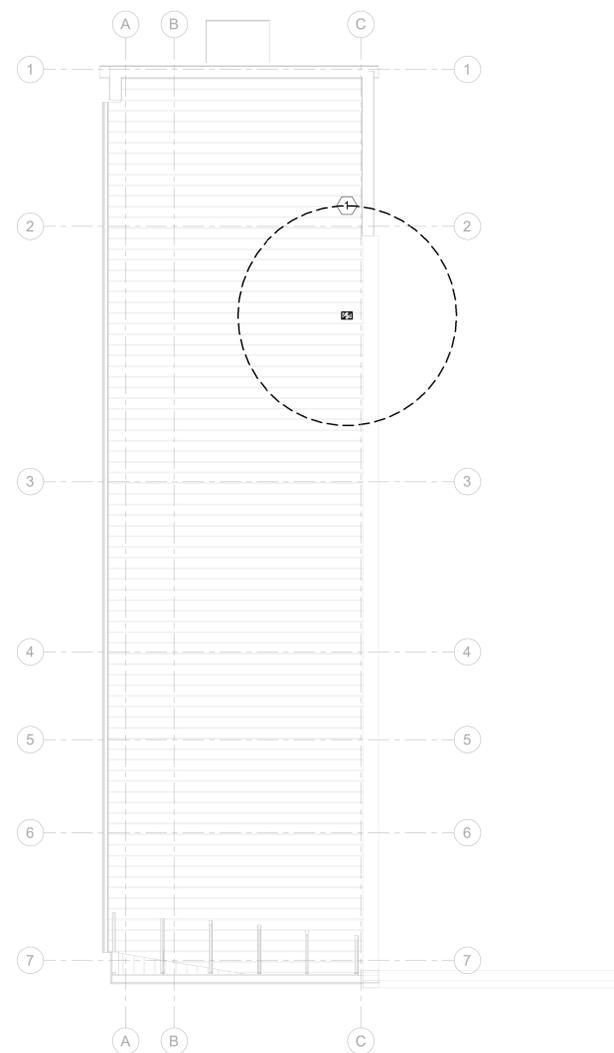

1 MECHANICAL ROOF PLAN  
M301 1/8" = 1'-0"

#	DATE	BY
1	08/21/2025	addendum 1

PROJECT NORTH  
TRUE NORTH

Project Number: 33-1408  
© 2024 LEVY DYKEMA  
**MECHANICAL ROOF PLAN**



M301

PLUMBING LEGEND AND SYMBOLS		GENERAL NOTES	
SYMBOL	DESCRIPTION	SYMBOL	DESCRIPTION
—CW—	DOMESTIC COLD WATER		SHUTOFF VALVE
—HW—	DOMESTIC HOT WATER		GATE VALVE
—HWC—	DOMESTIC HOT WATER RECIRC.		BALL VALVE
—SCW—	SOFT COLD WATER		BUTTERFLY VALVE
—W—	WASTE		GLOBE VALVE
—AW—	ACID WASTE		GAS SHUT-OFF COCK
—V—	VENT		SWING CHECK VALVE
—AV—	ACID VENT		SPRING CHECK VALVE
COM/CO	CLEANOUT/ WALL CLEANOUT		STRAINER
FCO	FLOOR CLEANOUT		WATER OUTLET (TYPE INDICATED)
GCO	GRADE CLEANOUT		BACKFLOW PREVENTER (TYPE INDICATED)
—CD—	CONDENSATE DRAIN		SLEEVE (PIPE) THRU WALL OR FLOOR
—D—	DRAIN		FLEX CONNECTOR (TYPE INDICATED)
—F—	FIRE SERVICE		HOSE END DRAIN VALVE
—FND—	FOUNDATION DRAINAGE		PRESSURE REDUCING VALVE
—RWL—	RAIN WATER LEADER		TEMPERATURE & PRESSURE RELIEF VALVE
—OFL—	OVERFLOW RAIN LEADER		AUTOMATIC AIR VENT
—PCR—	PUMPER CONDENSATE RETURN		DIELECTRIC UNION
—CR—	CONDENSATE RETURN		UNION
S=XXX	SLOPE DOWN IN DIRECTION OF FLOW		AUTOMATIC FLOW BALANCING VALVE
—NG—	NATURAL GAS		DIAL THERMOMETER
—O—	OXYGEN - MEDICAL		PRESSURE GAUGE - PROVIDE WITH PIGTAIL FOR STEAM
—MA—	AIR - MEDICAL		PIPE ANCHOR
—MV—	VACUUM - MEDICAL		SOLENOID VALVE
—EVAC—	EVACUATION - ANESTHESIA		L.P. VALVE
—N—	NITROGEN - MEDICAL		ECCENTRIC PLUG BALANCING VALVE
—DA—	AIR - DENTAL		VALVE IN RISER
—DV—	VACUUM - DENTAL		TEE UP
	MEDICAL GAS OUTLET		TEE DOWN
	MEDICAL GAS CONSOLE		ELBOW UP
	MASTER MEDICAL GAS ALARM PANEL		ELBOW DOWN
	AREA MEDICAL GAS ALARM PANEL		PIPE CAP
	MEDICAL GAS EMERGENCY SHUTOFF VALVE BOX		PIPE DRAIN & CAP
			CONNECT TO EXISTING
			NEW PIPING
			EXISTING PIPING
			PIPING TO BE REMOVED

PLUMBING ABBREVIATIONS			
AB.C.	ABOVE CEILING	MAX	MAXIMUM
AFF	ABOVE FINISHED FLOOR	MIN	MINIMUM
AV	ACID VENT	NG	NATURAL GAS
AW	ACID WASTE	(N)	NEW
BFF	BELOW FINISHED FLOOR	NO	NORMALLY OPEN (VALVE)
BG	BELOW GRADE	NC	NORMALLY CLOSED (VALVE)
CA	COMPRESSED AIR	OH	OVER HEAD
CD	CONDENSATE DRAIN	OFL	OVERFLOW RAIN LEADER
C-I.N.H.	CAST IRON NO HUB	(R)	PIPE RISE
CO	CLEANOUT	RIO	ROUGH-IN ONLY
CKV	CHECK VALVE	RWL	RAIN WATER LEADER
CW	COLD WATER	SHT	SHEET
CX	CONNECT TO EXISTING	SCW	SOFT COLD WATER
(A)	PIPE DROP	SOC	SHUT OFF COCK (GAS)
DN	PIPE DROP TO NEXT LEVEL	SOV	SHUT OFF VALVE
DTL	DETAIL	TPL	TRAP PRIMER LINE
(E)	EXISTING	UG	UNDERGROUND
F	FIRE SERVICE	UP	PIPE RISE TO NEXT LEVEL
FCO	FLOOR CLEANOUT	US	UNDER SLAB
FND	FOUNDATION DRAIN	UTR	UP THRU ROOF
GCO	GRADE CLEANOUT	V	VENT
HW	HOT WATER	VA	VALVE
HWC	HOT WATER CIRCULATION	VTR	VENT THRU ROOF
IDW	INDIRECT WASTE	W	WALL CLEANOUT
I.E.	INVERT ELEVATION	WCO	WASTE
IRR	IRRIGATION		
LPG	LIQUEFIED PETROLEUM GAS		
LWCO	LOW WATER CUTOFF		


PLUMBING DESIGN CRITERIA	
<b>GENERAL GUIDELINES:</b>	
ALL PLUMBING WORK AND MATERIALS SHALL COMPLY WITH THE 2015 IPC WITH CITY OF BURNET AMENDMENTS.	
<b>SANITARY DRAINAGE AND VENT PIPING</b>	
SIZED PER TABLE 710.1(1) OF THE 2015 IPC. DRAIN PIPE SHALL SLOPE PER 2015 IPC SECTION 704.1.	
<b>DRAINAGE FIXTURE UNITS</b>	
SIZED PER TABLE 709.1 OF THE 2015 IPC.	
<b>WATER SUPPLY FIXTURE UNITS</b>	
SIZED PER TABLE E-103.3(2) OF THE 2015 IPC.	
<b>WATER SUPPLY PIPE SIZING</b>	
SIZED PER TABLE E-103.3(5) OF THE 2015 IPC.	

GENERAL NOTES	
1.	FURNISH AND INSTALL ALL ITEMS NECESSARY TO PROVIDE FULLY FUNCTIONING SYSTEMS AS INDICATED BY THE DESIGN AND THE EQUIPMENT SPECIFIED. ELEMENTS OF THE WORK SHALL INCLUDE, BUT ARE NOT LIMITED TO, MATERIALS, LABOR, SUPERVISION, SUPPLIES, EQUIPMENT, TRANSPORTATION, HOISTING/RIGGING, STORAGE, UTILITIES, AND ALL REQUIRED PERMITS AND LICENSES.
2.	DRAWINGS ARE SCHEMATIC IN NATURE AND DO NOT REFLECT ALL WORK AND MATERIALS REQUIRED TO COMPLETE PROJECT. CONTRACTOR SHALL PROVIDE ALL MATERIALS, LABOR AND EQUIPMENT AS REQUIRED TO COMPLETE PROJECT WITHIN DESIGN. CONTRACTOR SHALL REQUEST ADDITIONAL INFORMATION AND DETAILS WHERE SCOPE IS UNCLEAR.
3.	ALL WORK SHALL COMPLY WITH THE MOST RECENT ADOPTED VERSION OF ALL APPLICABLE LAWS, RULES, REGULATIONS AND ORDINANCES OF ALL FEDERAL, STATE AND LOCAL AUTHORITIES. IF CONFLICT BETWEEN THE CONTRACT DOCUMENTS AND THE LOCAL ENFORCING AUTHORITY EXISTS, THE LOCAL ENFORCING AUTHORITY SHALL APPLY. ANY MODIFICATIONS TO THE DESIGN SHALL BE MADE WITHOUT ADDITIONAL COST TO THE OWNER OR ARCHITECT/ENGINEER. THE CONTRACTOR SHALL REPORT TO THE ARCHITECT/ENGINEER AND SECURE HIS APPROVAL BEFORE PROCEEDING WITH ANY MODIFICATIONS.
4.	WHERE THE REQUIREMENTS OF THE CONTRACT DOCUMENTS EXCEED THE REQUIREMENTS OF THE CODES, THE CONTRACT DOCUMENTS SHALL TAKE PRECEDENCE PROVIDED THAT THEY ARE NOT IN CONFLICT WITH THE CODES.
5.	BEFORE SUBMITTING BIDS, EACH CONTRACTOR SHALL PERFORM A SITE VISIT AND UNDERSTAND THE CONDITIONS TO BE MET IN INSTALLING THE WORK, AND SHALL MAKE PROVISIONS FOR THE CONDITIONS IN HIS FINAL BID. FAILURE ON THE PART OF THE CONTRACTOR TO COMPLY WITH THIS REQUIREMENT SHALL NOT BE CONSIDERED JUSTIFICATION FOR THE OMISSION OR FAULTY INSTALLATION OF ANY WORK COVERED BY THE CONTRACT DOCUMENTS.
6.	MISUNDERSTANDING OF THE SCOPE OR AMOUNT OF WORK TO BE PERFORMED SHALL BE THE RESPONSIBILITY OF THE CONTRACTOR, AND SHALL NOT RESULT IN ANY ADDITIONAL COST TO THE OWNER. TENDER OF A PROPOSAL CONVEYS FULL CONTRACTOR AGREEMENT OF THE ITEMS AND CONDITIONS SPECIFIED AND/OR INDICATED, SCHEDULED, OR IMPLIED IN THE CONTRACT DOCUMENTS, AND/OR REQUIRED BY THE NATURE OF THIS WORK.
7.	ALL WORK SHALL BE CARRIED OUT IN A NEAT, WELL ORGANIZED MANNER. ALL SERVICES SHALL BE ROUTED PARALLEL AND PERPENDICULAR TO THE PRIMARY LINES OF THE BUILDING. LOCATE ALL EQUIPMENT TO PROVIDE ACCESS AND ARRANGE ALL WORK WITH ADEQUATE ACCESS FOR OPERATION AND MAINTENANCE, AND TO MAINTAIN PROPER CODE AND MANUFACTURER'S CLEARANCES.
8.	ALL EQUIPMENT AND MATERIAL TO BE FURNISHED AND INSTALLED ON THIS PROJECT SHALL BE UL OR ETL LISTED, IN ACCORDANCE WITH THE AUTHORITY HAVING JURISDICTION, AND SUITABLE FOR ITS INTENDED USE ON THIS PROJECT.
9.	THE CONTRACTOR SHALL PROVIDE SUBMITTALS FOR ALL NEW EQUIPMENT, CONTROLS, AND FIXTURES TO BE PROVIDED AND INSTALLED.
10.	THE FOLLOWING SUBMITTAL DATA SHALL BE FURNISHED AND SHALL INCLUDE BUT NOT BE LIMITED TO: A. EQUIPMENT AND MATERIALS SHOP DRAWINGS B. COORDINATION DRAWINGS C. RECORD DRAWINGS D. OPERATING AND MAINTENANCE MANUALS E. FIRE STOP MATERIALS AND DETAILS
11.	THE GENERAL CONTRACTOR AND ALL SUBCONTRACTORS SHALL COORDINATE THE INSTALLATION OF DUCTWORK, PIPING, CONDUIT, CABLE, ETC., WITH LIGHTING FIXTURES, SPECIAL CEILING CONSTRUCTION, AIR DISTRIBUTION EQUIPMENT, AND THE STRUCTURE. PROVIDE ADDITIONAL RISES AND OFFSETS AS REQUIRED. IF, AFTER INSTALLED, NEW DUCTWORK, PIPING, CONDUIT, CABLE, ETC., IS FOUND TO BE IN CONFLICT WITH THE ARCHITECTURE, STRUCTURE OR OTHER TRADE WORK, WHICH IS EITHER EXISTING OR SHOWN ON THE CONTRACT DOCUMENTS, THE DUCTWORK, PIPING, CONDUIT, CABLE, ETC., SHALL BE RELOCATED WITHOUT ADDITIONAL COST TO THE OWNER/TENANT. COORDINATE ALL WORK WITH ALL OTHER TRADES PRIOR TO INSTALLATION.
12.	MATERIALS AND EQUIPMENT SHALL BE NEW AND IN GOOD CONDITION. THE COMMERCIAL STANDARD ITEMS OF EQUIPMENT AND THE SPECIFIC NAMES INDICATED ARE INTENDED TO IDENTIFY STANDARDS OF QUALITY AND PERFORMANCE NECESSARY FOR THE PROPER FUNCTIONING OF THE WORK. MATERIALS AND EQUIPMENT WHICH ARE FOUND TO HAVE FACTORY DEFECTS SHALL BE REPLACED OR REPAIRED IN A MANNER ACCEPTABLE TO THE OWNER/TENANT AND ENGINEER AT NO ADDITIONAL COST TO THE OWNER/TENANT.
13.	DAMAGE CAUSED DURING CONSTRUCTION TO EXISTING MATERIALS/EQUIPMENT WILL BE REPAIRED OR REPLACED AT NO ADDITIONAL COST TO OWNER. RE-SUPPORT ANY REMAINING PIPING OR DEVICES THAT WERE SUPPORTED BY WALLS BEING REMOVED.
14.	THE WARRANTY PERIOD SHALL BE NO LESS THAN ONE (1) FULL YEAR, UNLESS SPECIFIED OTHERWISE AND SHALL INCLUDE AT LEAST ONE (1) FULL HEATING SEASON AND ONE (1) FULL COOLING SEASON. DURING THE WARRANTY PERIOD THE CONTRACTOR SHALL GUARANTEE THE FOLLOWING IN A FORM SATISFACTORY TO THE OWNER/TENANT: A. ALL WORK INSTALLED SHALL BE FREE FROM ANY AND ALL DEFECTS IN WORKMANSHIP AND/OR MATERIALS. B. ALL APPARATUS WILL DEVELOP CAPACITIES AND PERFORMANCE CHARACTERISTICS SPECIFIED. C. THE SYSTEMS SHALL OPERATE WITHOUT MALFUNCTION.
15.	THE START OF THE CONTRACTOR'S WARRANTY PERIOD SHALL COMMENCE ON THE DATE OF "SUBSTANTIAL COMPLETION" AS AGREED TO BY THE OWNER/TENANT.
16.	THIS BUILDING MAY HAVE A STRUCTURAL SYSTEM UTILIZING POST-TENSIONED CABLES. THE CONTRACTOR SHALL DETERMINE THE EXISTING STRUCTURAL SYSTEM PRIOR TO CUTTING, DRILLING, OR CORING. THE CONTRACTOR SHALL X-RAY ALL PENETRATIONS PRIOR TO CUTTING THE FLOOR SLAB.
17.	THIS CONTRACTOR SHALL SECURE ALL PERMITS, LICENSES AND INSPECTIONS REQUIRED FOR HIS WORK, AND SHALL PAY ALL FEES IN CONNECTION WITH SUCH PERMITS, LICENSES AND INSPECTIONS.
18.	IN THE EVENT OF A CONFLICT BETWEEN DRAWINGS AND/OR SPECIFICATIONS, THE CONTRACTOR SHALL PROVIDE PRICING REFLECTING THE GREATEST COST. THE CONFLICT SHALL BE BROUGHT TO THE ATTENTION OF THE ENGINEER FOR CLARIFICATION.
19.	PENETRATIONS THROUGH FLOORS OR FIRE-RATED CONSTRUCTION SHALL BE FIRE RATED TO COMPLY WITH ASTM E-814 (UL 1479), AND THE LOCAL AUTHORITY HAVING JURISDICTION.
20.	UPON COMPLETION OF THE PROJECT, THE CONTRACTOR SHALL SUBMIT TO THE ENGINEER, A COMPLETE SET OF "AS BUILT" DRAWINGS PORTRAYING ACTUAL SITE CONDITIONS OF THE MECHANICAL, ELECTRICAL, PLUMBING AND FIRE PROTECTION WORK. SUBMISSION SHALL CONSIST OF ONE SET OF PAPER COPIES AND ONE SET OF CAD FILES IN AUTOCAD (CONTRACTOR SHALL UTILIZE OWNER'S LAYER STANDARDS IF EXISTING).
21.	IN THE EVENT THAT MATERIALS, PRODUCTS, AND/OR PROCESSES BEING PROPOSED FOR THIS PROJECT CONTAIN, OR MAY EMIT, ANY VOLATILE ORGANIC COMPOUNDS (VOC), FORMALDEHYDE FORMULATIONS, OR HAZARDOUS OUT-GASSING, AS DETERMINED BY THE MANUFACTURER, A MATERIALS SAFETY DATA SHEET SHALL BE SUBMITTED AS PART OF THE SHOP DRAWING PROCESS FOR REVIEW BY THE ARCHITECT/ENGINEER/OWNER.
22.	VERIFY LOCATIONS OF EXISTING VALVES LOCATED WITHIN SCOPE OF WORK. MODIFY EXISTING OR PROVIDE NEW MEANS OF ACCESS WHERE REQUIRED BECAUSE OF NEW CONSTRUCTION.
23.	PLUMBING EQUIPMENT SHALL BE IDENTIFIED BY MEANS OF NAMEPLATES PERMANENTLY ATTACHED TO THE EQUIPMENT. NAMEPLATES SHALL BE BLACK SURFACE, WHITE CORE LAMINATED WITH ENGRAVED LETTERS. PLATES SHALL BE A MINIMUM OF 3" LONG BY 1" WIDE WITH WHITE LETTERS 1/4" HIGH.
24.	THE CONTRACTOR SHALL TAKE NOTE THAT THE DRAWINGS ARE SCHEMATIC IN NATURE AND INDICATE THE APPROXIMATE LOCATIONS OF THE HVAC AND PLUMBING SYSTEMS. LOCATE ALL ITEMS IN THE FIELD. COORDINATE WITH OTHER TRADES TO ENSURE PROPER FIT AND ACCESS TO ALL ITEMS.
25.	AFTER COMPLETION OF INSTALLATION, BUT PRIOR TO SUBSTANTIAL COMPLETION, CONTRACTOR SHALL CERTIFY IN WRITING THAT PRODUCTS AND MATERIALS INSTALLED AND PROCESSES USED DO NOT CONTAIN ASBESTOS OR POLYCHLORINATED BIPHENYL (PCB).
26.	THE CONTRACTOR SHALL PROTECT THE WORK, EQUIPMENT, AND MATERIALS FROM DAMAGE BY HIS WORK OR HIS PERSONNEL, AND SHALL CORRECT ALL DAMAGE THUS CAUSED WITHOUT ADDITIONAL COST TO THE OWNER. THE CONTRACTOR SHALL BE RESPONSIBLE FOR ALL WORK, MATERIALS, AND EQUIPMENT UNTIL FINAL ACCEPTANCE BY THE OWNER. PROTECT ALL WORK AGAINST THEFT, INJURY, OR DAMAGE AND CAREFULLY STORE MATERIAL AND EQUIPMENT RECEIVED ON SITE WHICH IS NOT IMMEDIATELY INSTALLED. THE CONTRACTOR SHALL CLOSE OPEN ENDS OF WORK WITH TEMPORARY COVERS OR PLUGS DURING CONSTRUCTION TO PREVENT THE ENTRY OF DUST, DIRT, AND OBSTRUCTING MATERIAL. THE CONTRACTOR SHALL PROTECT ALL EQUIPMENT AND MATERIALS FROM DAMAGE DUE TO WATER, SPRAY-ON FIREPROOFING, CONSTRUCTION DEBRIS, ETC. IN A MANNER ACCEPTABLE TO THE ENGINEER AND/OR OWNER.

PLUMBING GENERAL NOTES	
1.	REFER TO THE ARCHITECTURAL PLANS AND DETAILS FOR EXACT LOCATIONS AND MOUNTING HEIGHTS OF ALL PLUMBING FIXTURES.
2.	REFER TO THE ARCHITECTURAL PLANS AND DETAILS FOR EXACT LOCATIONS OF ALL FLOOR DRAINS.
3.	ALL SANITARY AND VENT PIPING SHALL BE ROUTED AT A SLOPE OF NOT LESS THAN 1/4" PER FOOT, UNLESS OTHERWISE NOTED.
4.	THE PLUMBING CONTRACTOR SHALL COORDINATE EXACT ROUTING OF ALL PIPING WITH THE WORK OF ALL OTHER TRADES. PROVIDE OFFSETS IN PIPING WHERE REQUIRED BY COORDINATION OF TRADES.
5.	INSTALL ALL FLOOR DRAINS AND FLOOR SINKS SUCH THAT GRATING IS FLUSH WITH ADJACENT FLOORING SURFACE. FLOOR SHALL SLOPE TO DRAIN. COORDINATE ALL REQUIREMENTS WITH ARCHITECT AND GENERAL CONTRACTOR PRIOR TO INSTALLATION.
6.	THE PLUMBING CONTRACTOR SHALL CLEAN, FLUSH, AND DISINFECT ALL COLD WATER AND HOT WATER PIPING AND ALL FIXTURES PRIOR TO COMPLETION OF WORK.
7.	VENTS THROUGH ROOF TO BE LOCATED A MINIMUM OF 15'-0" HORIZONTALLY AWAY FROM OUTSIDE AIR INTAKES.
8.	FLOOR DRAINS NOT RECEIVING REGULAR-USE DRAINAGE ARE TO BE TRAP PRIMED.
9.	PROVIDE BACKFLOW PREVENTION AS REQUIRED BY THE LOCAL CROSS CONNECTION CONTROL DEPT. STANDARDS WHERE NOT PROVIDED OR INADEQUATELY PROVIDED BY EQUIPMENT MANUFACTURER.
10.	INSTALL PIPING AS HIGH AS POSSIBLE UNLESS OTHERWISE NOTED.
11.	VERIFY DIMENSIONS FROM ARCHITECTURAL DRAWINGS AND FROM ACTUAL MEASUREMENTS AT JOBSITE.
12.	PROVIDE SADDLES AND SHIELDS FOR SUPPORT OF INSULATED PIPING TO PREVENT CRUSHING.
13.	PIPING PENETRATIONS THROUGH PERIMETER BEAMS, FOUNDATION ON GRADE, AND STRUCTURAL FLOORS SHALL BE SLEEVED. COORDINATE SLEEVE LOCATIONS AND SIZES WITH STRUCTURAL PRIOR TO POUR.
14.	PROVIDE DIELECTRIC UNIONS AT DISSIMILAR MATERIALS.
15.	PROVIDE ESCUTCHEONS AT ALL FINISHED WALL AND CEILING PIPING PENETRATIONS.
16.	ALL PIPING SHALL BE IDENTIFIED AS TO TYPE OF USE, SERVICE, AND DIRECTION OF FLOW. LOCATE MARKERS AT EACH VALVE, AT ENTRIES TO WALLS, AND ON 20" CENTERS ON STRAIGHT RUNS OF PIPE. PROVIDE A FLOW ARROW AT EACH IDENTIFICATION MARKER. PIPE MARKERS SHALL BE SETON "SETMARK" OR EQUAL.
17.	COORDINATE WORK COMPLETELY WITH ALL OTHER TRADES.
18.	INSTALL PIPING FREE OF SAGS AND BENDS. PROVIDE NON-METALLIC COATED HANGERS WHERE IN DIRECT CONTACT WITH COPPER PIPING.
19.	PROVIDE ENGINEERED WATER HAMMER ARRESTERS SIZED AND PLACED IN ACCORDANCE WITH STANDARD PDI-WH 201. AIR CHAMBERS SHALL NOT BE ALLOWED.
20.	PROVIDE FLEXIBLE EXPANSION FITTINGS SUITABLE FOR SANITARY (DWV) AND RAINWATER PIPING WHERE PIPING ENTERS EXPANSIVE SOILS TO ALLOW FOR 4" OF DIFFERENTIAL MOVEMENT.
21.	ALL FLOOR PENETRATIONS MUST BE SEALED WITH FIRE CAULK.
22.	MAKE ALL NECESSARY EXCAVATIONS, CUTTING OF PAVING, CONCRETE, ETC., REMOVAL OF UNUSABLE SPOIL MATERIAL, ALL BACKFILLING WITH STABILIZED FILL, AND PERFORM TEMPORARY PATCH PAVING REPAIRS NECESSARY FOR PROPER EXECUTION OF THE WORK. BACKFILL SHALL BE MECHANICALLY COMPACTED TO A DENSITY OF 95% OF THE MAXIMUM DRY DENSITY AT OPTIMUM MOISTURE CONTENT AS DETERMINED BY THE STANDARD PROCTOR COMPACTION TEST.
23.	PROVIDE MINIMUM 1" AIR GAP AT DRAIN DISCHARGE FOR ALL INDIRECT WASTE PIPING.
24.	DISCHARGE PIPING FROM A DISHWASHER SHALL BE LOOPED UP AND SECURELY FASTENED TO THE UNDERSIDE OF THE COUNTER OR AN APPROVED DISHWASHER AIR-GAP FITTING IS REQUIRED.
25.	COMPRESSION TANKS SUPPLIED AT EACH WATER HEATER SHALL BE SECURED TO A WALL WITH (2) 1" x 14 GA. GALVANIZED STRAPS. PROVIDE LAG BOLTS AND BLOCKING AS REQUIRED.
26.	AN ATMOSPHERIC VACUUM BREAKER OR OTHER APPROVED BACKFLOW PREVENTION DEVICE MUST BE INSTALLED ON ALL THREADED HOSE BIBB, WALL HYDRANT, OR FAUCET CONNECTIONS LOCATED INSIDE OR OUTSIDE THE BUILDING.


2015 IECC ENERGY CODE COMPLIANCE	
<b>REQUIREMENTS SPECIFIC TO WATER HEATING:</b>	
1.	HEAT TRAPS SHALL BE PROVIDED ON NONCIRCULATING WATER HEATING SYSTEMS ON BOTH INLET AND OUTLET CONNECTIONS. HEAT TRAPS MAY BE PRE-FABRICATED OR FIELD-FABRICATED BY CREATING A LOOP OR INVERTED U-SHAPED ARRANGEMENT ON THE INLET AND OUTLET PIPES. REFER TO WATER HEATER DETAIL.
2.	PIPE INSULATION FOR THE SPECIFIED NONCIRCULATING SERVICE HOT WATER SYSTEM IS REQUIRED FOR ALL PIPING IN THE FOLLOWING CATEGORIES: a) THE FIRST 8' OF OUTLET PIPING FROM ANY CONSTANT-TEMPERATURE, NONCIRCULATING STORAGE SYSTEM. b) THE INLET PIPING BETWEEN THE STORAGE TANK AND A HEAT TRAP IN A NONCIRCULATING STORAGE SYSTEM.
3.	INSULATION SHALL COMPLY WITH PIPE INSULATION SPECIFICATIONS AS INDICATED ON THIS DRAWING PER TABLE C403.2.10 MINIMUM PIPE INSULATION THICKNESS.
<b>GENERIC PLUMBING REQUIREMENTS:</b>	
1.	SERVICE WATER HEATING EQUIPMENT SHALL MEET MINIMUM FEDERAL EFFICIENCY REQUIREMENTS INCLUDED IN THE NATIONAL APPLIANCE ENERGY CONSERVATION ACT AND THE ENERGY POLICY ACT OF 1992, WHICH MEET OR EXCEED 2015 IECC AND ASHRAE 90.1 FOR ENERGY EFFICIENCY AND STANDBY LOSS.
2.	WATER-HEATING EQUIPMENT SHALL BE PROVIDED WITH CONTROLS THAT ALLOW THE USER TO SET THE WATER TEMPERATURE TO 140°F.

PLUMBING PIPING & MATERIALS	
<b>DOMESTIC WATER PIPING</b>	
ABOVE GRADE: ASTM B88, TYPE L HARD DRAWN COPPER TUBING, WITH SOLDERED JOINTS, ASME B16.22, WROUGHT COPPER AND BRONZE FITTINGS, OR PRESSURE SEALED FITTINGS AND JOINTS COMPLYING WITH ASTM B584	
BELOW GRADE: ASTM D1785, SCHEDULE 80 PVC, WITH SOLVENT WELDS.	
TO CARBONATORS: ASTM A312, TYPE 304 SCHEDULE 40 STAINLESS STEEL, WITH THREADED FITTINGS.	
<b>VENT PIPING ABOVE CEILINGS:</b>	
ALL VENT PIPING ABOVE CEILINGS SHALL BE SERVICE WEIGHT, NO-HUB CAST IRON PIPE AND DRAINAGE FITTINGS WITH HEAVY DUTY COUPLINGS.	
WHEN CEILING CAVITY IS A RETURN AIR PLENUM, PROVIDE TRANSITION TO PVC WASTE AND VENT PIPING AS REQUIRED, PRIOR TO ENTERING PLENUM (IF APPLICABLE). PVC SHALL NOT BE EXPOSED IN A RETURN AIR PLENUM.	
<b>WASTE &amp; VENT PIPING</b>	
ABOVE GRADE: ASTM A74, HUBLESS CAST IRON, WITH CISPI 301 SPIGOT BEAD ENDS FOR COUPLING ASSEMBLY. ASTM D2665, SCHEDULE 40 PVC JOINED WITH SOLVENT WELDS.	
BELOW GRADE: ASTM A74, CAST IRON, HUB AND SPIGOT TYPE, JOINED WITH ASTM C564 NEOPRENE COMPRESSION GASKETS. ASTM D2665, SCHEDULE 40 PVC JOINED WITH SOLVENT WELDS.	
<b>SOFTDRING TUBING CONDUIT:</b>	
BELOW GRADE: ASTM D2665, SCHEDULE 40 PVC JOINED WITH SOLVENT WELDS. PROVIDE LONG RADIUS FITTINGS AND PULL STRING.	
<b>DOMESTIC WATER VALVES:</b>	
DOMESTIC WATER: BALL VALVES, 2" AND SMALLER, ASTM B 584, BRONZE BODY AND BONNET, 2-PIECE CONSTRUCTION, CHROME-PLATED BRASS BALL, FULL PORT, BLOWOUT PROOF, BRASS OR BRONZE STEM, TEFLON SEAT AND SEALS, STEM EXTENSION FOR VALVES INSTALLED IN INSULATED PIPING, AND THREADED ENDS.	
SHEET LIST	
DRAWING	SHEET TITLE
P001	PLUMBING COVER SHEET
P002	PLUMBING DETAILS
P003	PLUMBING SCHEDULES
P101	PLUMBING DWV PLANS
P201	PLUMBING DOMESTIC WATER PLANS
P301	PLUMBING RISER DIAGRAMS

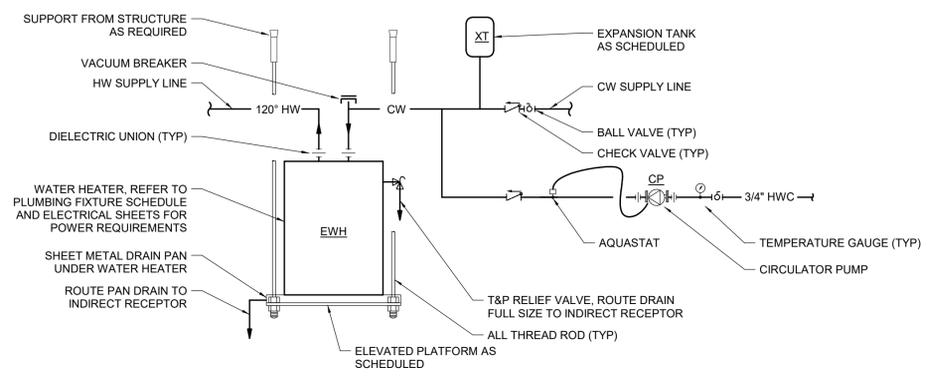


D WATER HEATER DETAIL  
 P002 NOT TO SCALE

NOTE: WATER HAMMER ARRESTOR BY SIOUX CHIEF 650 - 660 SERIES HYDRA-RESTER REQUIRED IN PIPING SYSTEMS. WATER HAMMER ARRESTERS SHALL HAVE SUFFICIENT VOLUME OF AIR TO DISSIPATE THE CALCULATED KINETIC ENERGY GENERATED IN THE PIPING SYSTEM. ARRESTERS SHALL BE EFFECTIVE WHEN INSTALLED AT ANY ANGLE. ARRESTERS SHALL BE APPROVED FOR INSTALLATION WITH NO ACCESS PANEL REQUIRED. WATER HAMMER ARRESTERS SHALL BE SIZED AND PLACED PER MANUFACTURER'S INSTRUCTIONS.

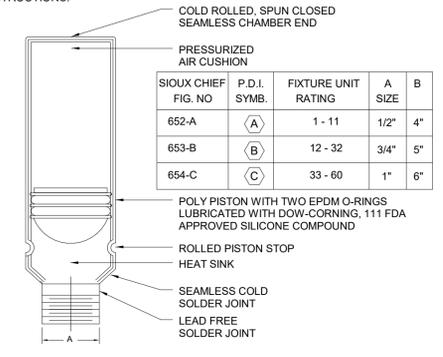


SIOUX CHIEF FIG. NO.	P.D.I. SYMB.	FIXTURE UNIT RATING	A SIZE	B
652-A	(A)	1 - 11	1/2"	4"
653-B	(B)	12 - 32	3/4"	5"
654-C	(C)	33 - 60	1"	6"


H Sioux Chief WHA  
 P002 NOT TO SCALE

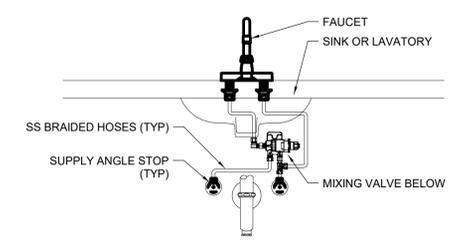

E Lavatory TMV  
 P002 NOT TO SCALE

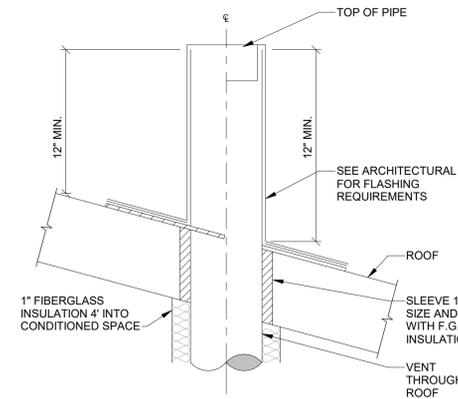


F VENT THROUGH ROOF DETAIL 2  
 P002 NOT TO SCALE


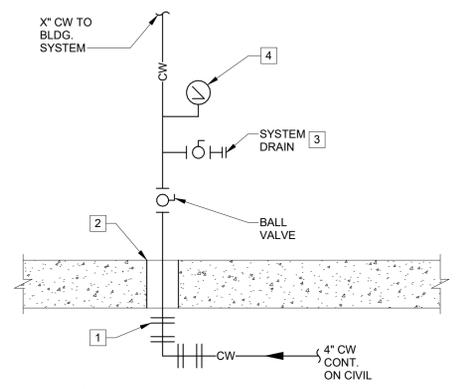


- NOTES:
- MEGA-LUG THRUST RESTRAINT SYSTEM UNDER BUILDING SLAB.
  - SLEEVE AND SEAL WATER TIGHT THRU FLOOR.
  - 1" BALL VALVE WITH 3/4" MALE HOSE THREAD.
  - 3 1/2"Ø PRESSURE GAUGE READS 0-100 PSI.

I WATER ENTRANCE DETAIL  
 P002 NOT TO SCALE

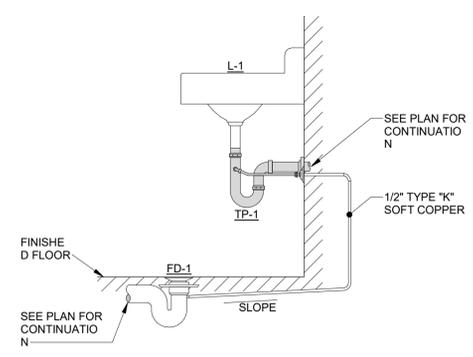


G TRAP PRIMER DETAIL  
 P002 NOT TO SCALE

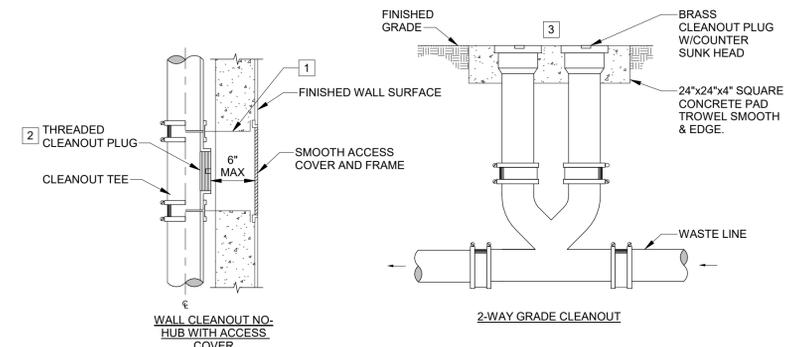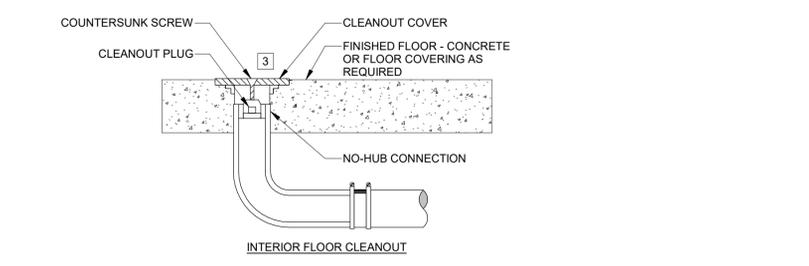


- NOTES:
- WHERE WCO OCCURS IS SOLID CONCRETE OR GROUTED CMU WALL, USE SLEEVE BETWEEN PIPE AND COVER PLATE TO KEEP ACCESS TO PLUG OPEN.
  - USE EXTENSIONS BETWEEN TEE AND ACCESS COVER AS NEEDED.
  - WHERE A CLEANOUT SHALL BE CLEARLY IDENTIFIED WITH A LABEL STATING "BACKWATER VALVE DOWNSTREAM"

A CLEANOUT DETAIL  
 P002 NOT TO SCALE

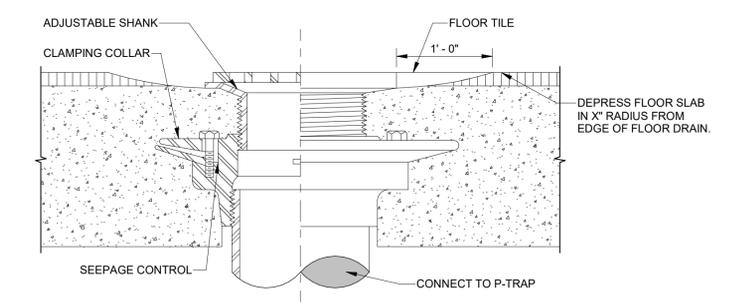

B FLOOR DRAIN DETAIL  
 P002 NOT TO SCALE

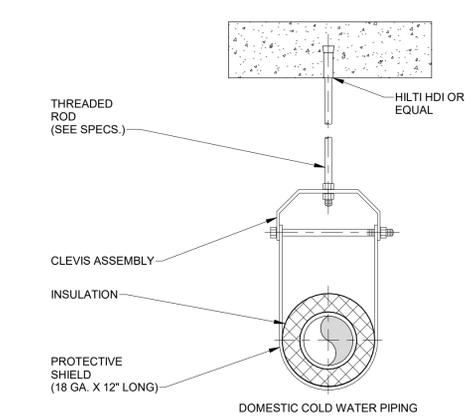

MAXIMUM PIPE/TUBING SUPPORT SPACING, FEET										
NOM. SIZE	THRU 3/4"	1"	1-1/4"	1-1/2"	2"	2-1/2"	3"	4"	6"	8"
COPPER	5	6	7	8	8	9	10	12	14	16


C PIPE HANGER DETAIL  
 P002 NOT TO SCALE




PLUMBING FIXTURE SCHEDULE								
TAG	DESCRIPTION	MANUFACTURER - MODEL	TRIM & ACCESSORIES	CONNECTIONS (INCHES)				DESCRIPTION AND NOTES
				HW	CW	W	V	
CP-1	CIRCULATION PUMP	TACO #003B	PROVIDE WITH TACO #265-3 DIGITAL TIMER AND AQUASTAT FOR PUMP CONTROL	3/4	-	-	-	1/40 HP, 120/1/60, 0.5 GPM @ 4 FT HEAD, BRONZE CONSTRUCTION. COORDINATE OPERATING TIMES WITH OWNER
EWH-1	ELECTRIC WATER HEATER	A.O. SMITH DEL-10S-2.5	CONTAINMENT PAN W/ DRAIN, WALL MOUNT, (HOLDRITE 30-SWHP-WM OR EQUAL), CP-1 AND XT-1 AS SCHEDULED	3/4	3/4	-	-	10 GALLON ELECTRIC STORAGE WATER HEATER, 2.5 KW, 10 GPH AT 100 DEG F RISE, T&P RELIEF ASSEMBLY, SET AT 120 DEG F DISCHARGE, PROVIDE XT-1 EXPANSION TANK, 208V1PH, 25 FLA
FCO	FLOOR CLEANOUT	JAY R. SMITH #4020	FLANGE W/ FLASHING CLAMP	-	-	-	-	CAST IRON BODY, ABS CLEANOUT PLUG WITH GASKET, NICKEL BRONZE COVER, ADJUSTABLE HOUSING FOR FLUSH INSTALLATION, REFER TO PLANS FOR PIPE SIZE
L-1	LAVATORY (ADA)	KOHLER SOHO #K-2053-N	FAUCET: KOHLER #K-23484-4N-CP, TRAP, S.S. BRAIDED HOSES, 1/4 TURN ANGLE STOPS, WALL ESCUTCHEONS, TRUEBRO PIPE GUARDS	1/2	1/2	2	2	WHITE VITREOUS CHINA WALL MOUNT SINK, 0.5 GPM THREE HOLE COUNTER MOUNT FAUCET IN CHROME, BASKET STRAINER, CHROME TAILPIECE AND P-TRAP, ADA COMPLIANT
MS-1	MOP SINK	FIAT #MSB2424	FAUCET: FIAT #830-AA, MOP HANGER	1/2	1/2	3	2	24"x24"x12" MOLDED STONE MOP SINK, CHROME PLATED SERVICE FAUCET WITH VACUUM BREAKER, WALL BRACE, PAIL HOOK, AND HOSE THREAD
SA-1	SHOCK ARRESTOR	SIoux CHIEF HYDRARESTER 650 SERIES	-	-	*	-	-	FACTORY PRECHARGED WATER HAMMER ARRESTOR, *REFER TO MANUFACTURER LITERATURE FOR SIZING CRITERIA AND MODEL SELECTION
SK-1	BREAK ROOM SINK	ELKAY LUSTERTONE #LRAD221965	FAUCET: KOHLER #K-7505-CP, TRAP, S.S. BRAIDED HOSES, 1/4 TURN ANGLE STOPS, WALL ESCUTCHEONS	1/2	1/2	2	2	18 GA STAINLESS STEEL SINGLE BOWL, COUNTERMOUNT SINK, 6" DEEP, 1.5 GPM SINGLE HOLE COUNTER MOUNT FAUCET IN CHROME, BASKET STRAINER, CHROME TAILPIECE AND P-TRAP.
SP-1	ELEVATOR SUMP PUMP	BELL & GOSSETT #ELKT2EC0311L	HIGH WATER FLOAT ALARM SWITCH	-	-	2	-	AUTOMATIC OPERATION ELEVATOR SUMP PUMP, 1/3 HP, 120V/1PH, 50 GPM AT 17 FT HEAD, PROVIDE HIGH ALARM FLOAT, COORDINATE INSTALLATION OF ALARM PANEL WITH ARCH.
TMV-1	TEMPERATURE MIXING VALVE	WATTS #LFUSG-B	-	1/2	1/2	-	-	THERMOSTATIC MIXING VALVE, LEAD FREE BRASS BODY, 0.35 GPM, INTEGRAL CHECK VALVES, SET AT 110°F OUTLET TEMPERATURE, INSTALL AT ALL LAV-1 FIXTURES
TP-1	TRAP PRIMER	PRECISION PLUMBING PRODUCTS #LTP-1500	-	-	1/2	-	-	BRASS CONSTRUCTION, FULLY AUTOMATIC TRAP PRIMER. PROVIDE WITH SHUTOFF VALVE FOR MAINTENANCE.
WCO	WALL CLEANOUT	JAY R. SMITH #4402C	-	-	-	-	-	STAINLESS STEEL COVER, REFER TO PLANS FOR SIZE
WB-1	REFRIGERATOR WALL BOX	IPS WATER TITE	-	-	1/2	-	-	WALL BOX WITH 1/4 TURN ANGLE STOP, WALL FLANGE, AND INTEGRAL WATER HAMMER ARRESTOR
WC-1	WATER CLOSET (ADA)	KOHLER KINGSTON #K-25087	-	-	1/2	4	2	VITREOUS CHINA, TWO PIECE FLOOR MOUNTED WITH ELONGATED BOWL, GRAVITY SIPHON JET, 1.28 GPF, MATCHING SEAT WITH STAINLESS STEEL POSTS, ADA COMPLIANT HEIGHT
WH-1	WALL HYDRANT	WOODFORD #B65	-	-	3/4	-	-	ANTI-SIPHON FREEZELESS WALL HYDRANT, CHROME WITH ANTI-SIPHON VACUUM BREAKER HOSE THREAD, STAINLESS STEEL STEM WITH KEY OPERATOR, CONCEALED RECTANGULAR BOX
XT-1	EXPANSION TANK	AMTROL #ST-5-C	-	-	3/4	-	-	2 GALLON EXPANSION TANK, 0.45 ACCEPTANCE FACTOR, CERTIFIED FOR POTABLE WATER USAGE

WATER CALCULATIONS (2015 IPC) - SERVICE SIZE			
AVAILABLE WATER PRESSURE		60.0	
PRESSURE LOSS AT METER		15.0	
ELEVATION OF HIGHEST FIXTURE (FEET)		14	
MIN. PRESSURE REQUIRED (FLUSH TANK)		8.0	
STATIC PRESSURE LOSS (ELEV)		6.0	
TOTAL AVAILABLE PRESSURE		31.0	
DISTANCE TO LAST FIXTURE (IN FT.)		60	
TOTAL DEVELOPED LENGTH (IN FT.)		72	
PEAK FLOW (IN GPM)		24	
ALLOWABLE FRICTION LOSS/100 FT		43.0	
FIXTURE	QTY	WSFU EA.	TOTAL WSFU
WATER CLOSET (FLUSH TANK)	4.0	5.00	20.0
LAVATORY	4.0	1.50	6.0
BREAK SINK	2.0	2.00	4.0
MOP SINK	1.0	3.00	3.0
TOTAL WSFU			33.0
EQUIVALENT GPM			24.3
METER SIZE:		3/4"	
BUILDING SUPPLY SIZE:		1"	



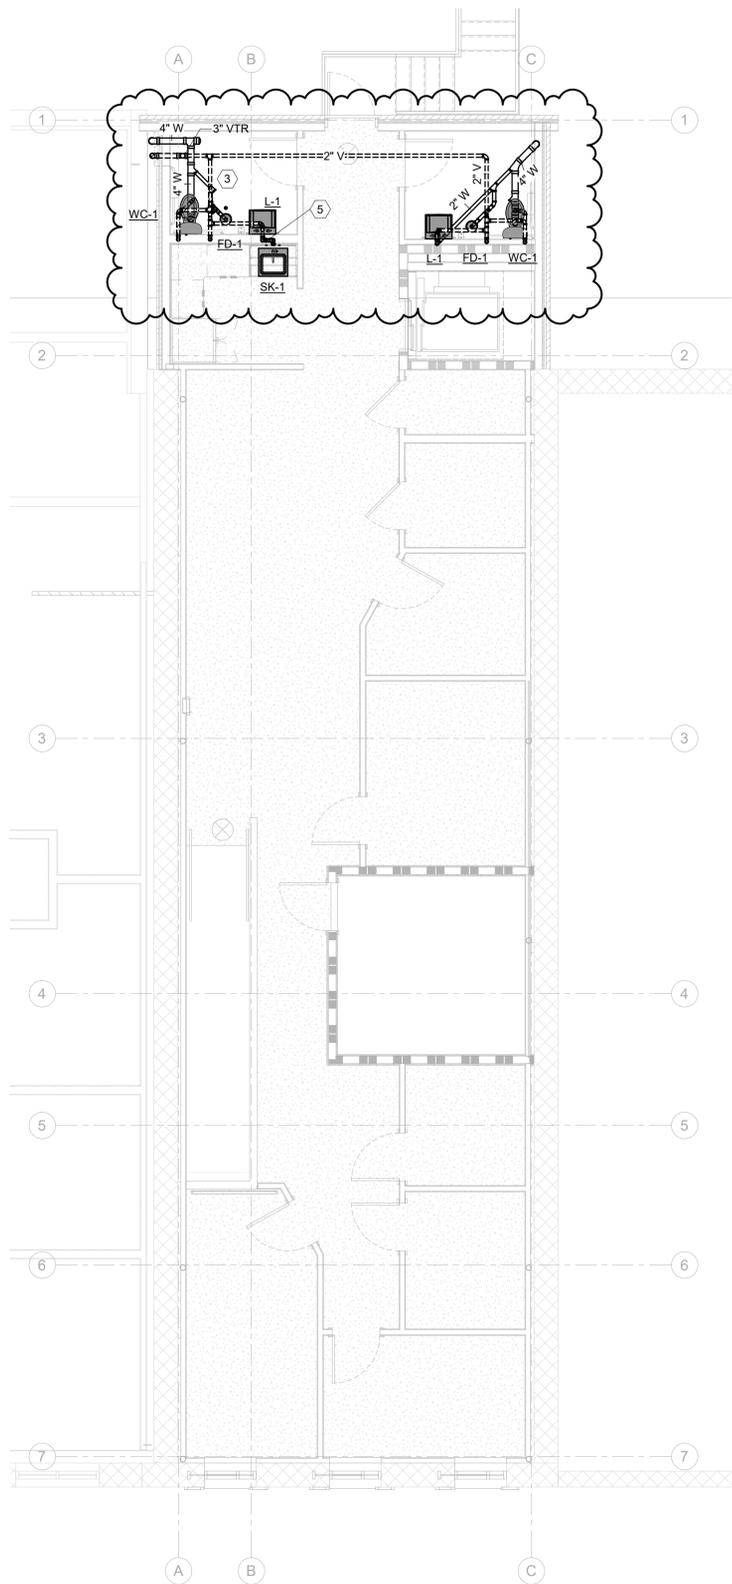

**2 PLUMBING DWV PLAN-SECOND FLOOR**  
 P101 3/16" = 1'-0"

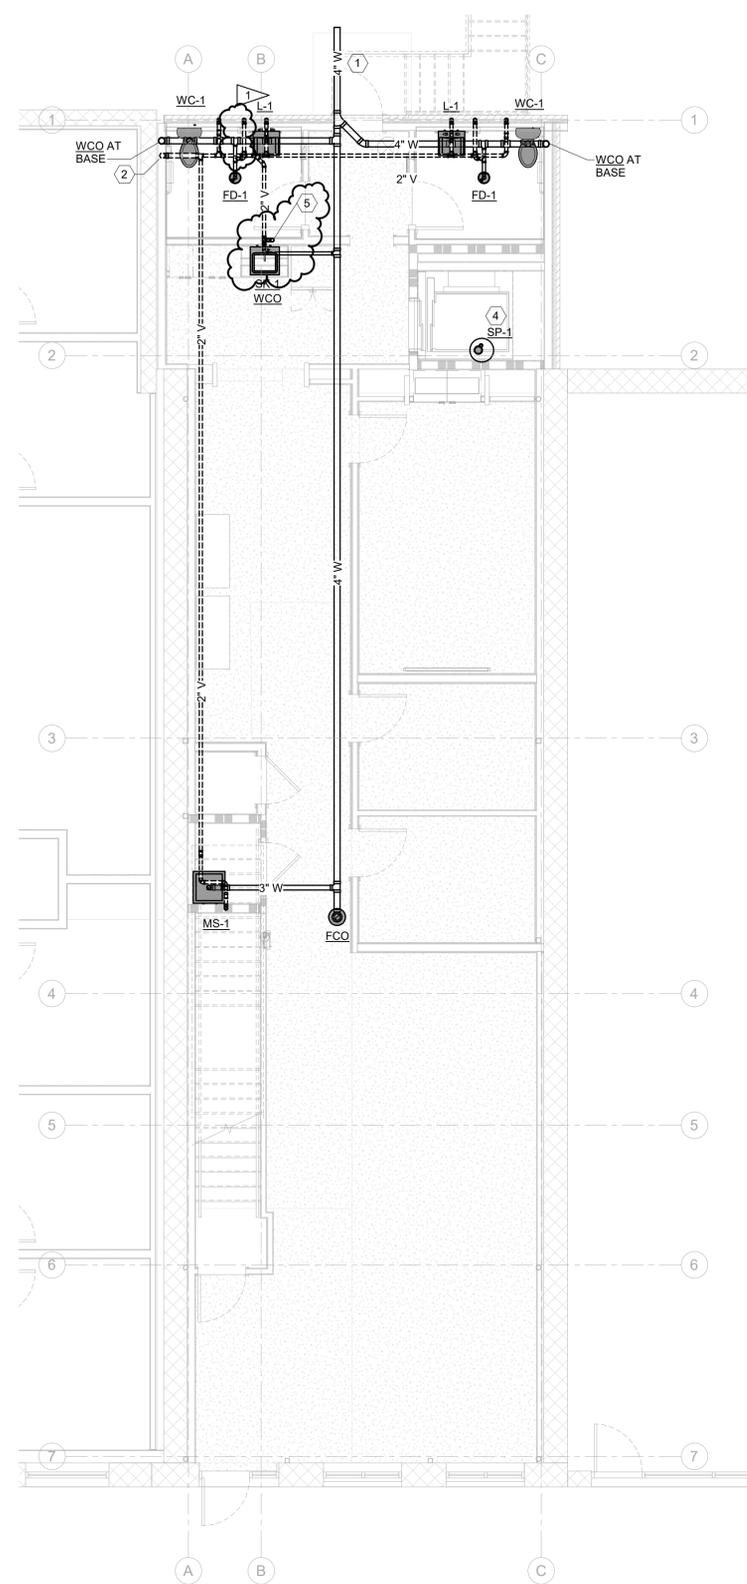

**1 PLUMBING DWV PLAN-FIRST FLOOR**  
 P101 3/16" = 1'-0"

**GENERAL NOTES**

- A. REFER TO PLUMBING COVER SHEET DRAWING FOR SYMBOLS, ABBREVIATIONS, SPECIFICATIONS, AND ADDITIONAL INFORMATION.
- B. DUE TO DRAWING SCALE IT IS NOT POSSIBLE TO INDICATE ALL OFFSETS, FITTINGS AND ACCESSORIES WHICH MAY BE REQUIRED.
- C. THE CONTRACTOR SHALL EXAMINE FIELD CONDITIONS AND FURNISH THE NECESSARY FITTINGS WHICH MAY BE REQUIRED TO COMPLETE THE INSTALLATION.
- D. FINAL LOCATION OF ALL NEW EQUIPMENT PRIOR TO EQUIPMENT INSTALLATION SHALL BE APPROVED BY BUILDING OWNER OR PROJECT MECHANICAL ENGINEER.
- E. MAINTAIN CODE REQUIRED AND MANUFACTURER'S RECOMMENDED CLEARANCES FOR ALL NEW EQUIPMENT.
- F. PLUMBING CONTRACTOR SHALL VERIFY ALL UTILITY LOCATIONS IN THE FIELD. ROUTE NEW SANITARY WASTE AND DOMESTIC WATER PIPING TO EXISTING.

**# SHEET WORK NOTES**


- 1. 4" SANITARY WASTE TO SITE. CONNECT TO EXISTING SANITARY WASTE MAIN IN ALLEY. CONTRACTOR SHALL VERIFY IN THE FIELD THE EXACT LOCATION AND DEPTH OF LINE PRIOR TO INSTALLATION OF NEW PLUMBING. CONFIRM ADEQUATE DEPTH AND PIPE SIZE.
- 2. 3" VENT UP TO LEVEL 2.
- 3. 3" VENT TO ROOF. COORDINATE WITH ROOFING CONTRACTOR FOR FINAL TERMINATION AND FLASHING.
- 4. PROVIDE AND INSTALL SUMP PUMP IN ELEVATOR PIT. ROUTE 2" SUMP PUMP DISCHARGE PIPING TO APPROVED DISCHARGE LOCATION. COORDINATE ROUTING OF PIPING WITH ARCHITECTURAL AND IN THE FIELD.
- 5. 2" SANITARY WASTE FROM LAVATORY AND BREAK SINK ON LVL 2 DOWN IN WALL. CONNECT TO 2" SANITARY WASTE PIPING FOR BREAK SINK ON LVL 1.




127 E JACKSON ST. BURNET TX 78611

**BURNET COUNTY ANNEX**


Autodesk Docs/733-1408 Burnet County Annex/Burnet County\_M&P\_RV22.rvt

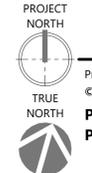

Project Number: 33-1408  
 © 2024 LEVY DYKEMA  
**PLUMBING DWV PLANS**

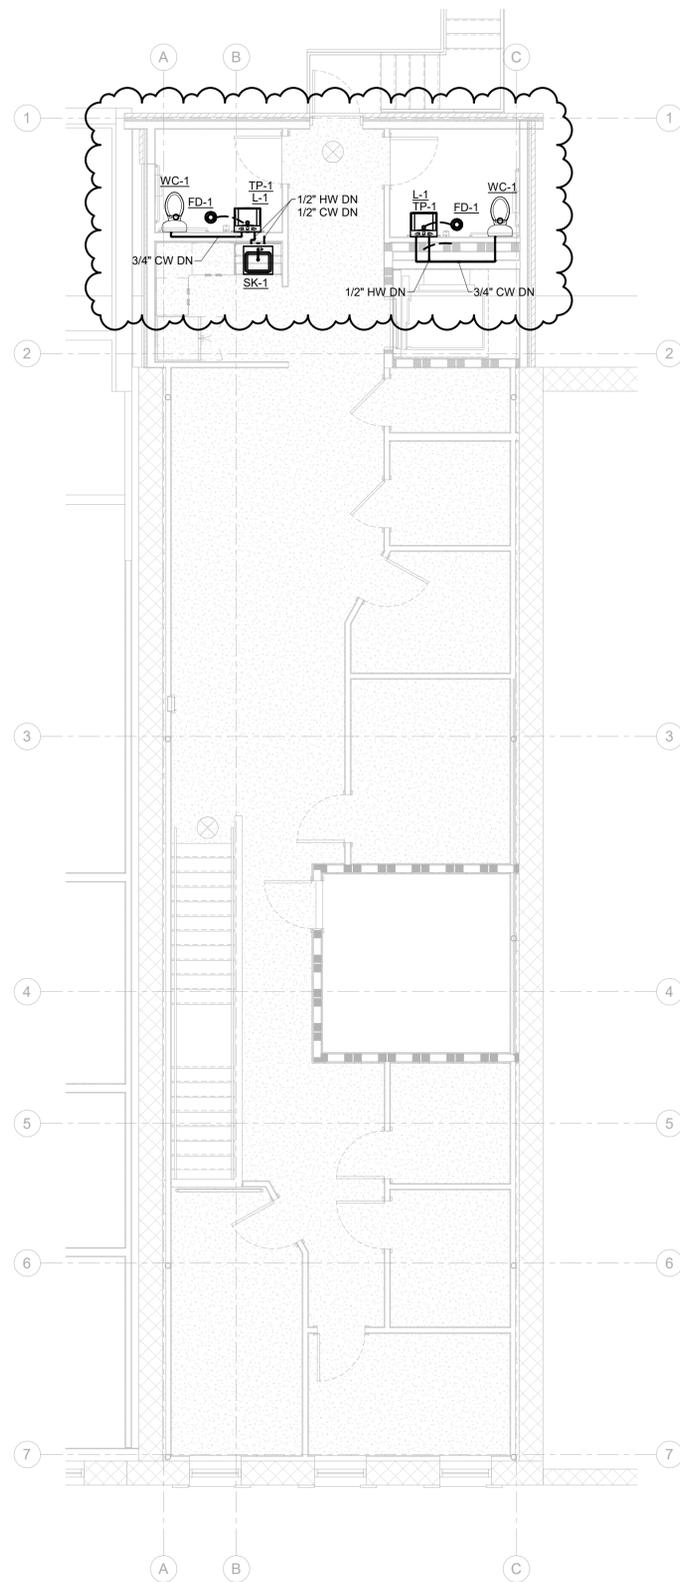

2 PLUMBING DOMESTIC W&G PLAN-SECOND FLOOR  
 P201 3/16" = 1'-0"

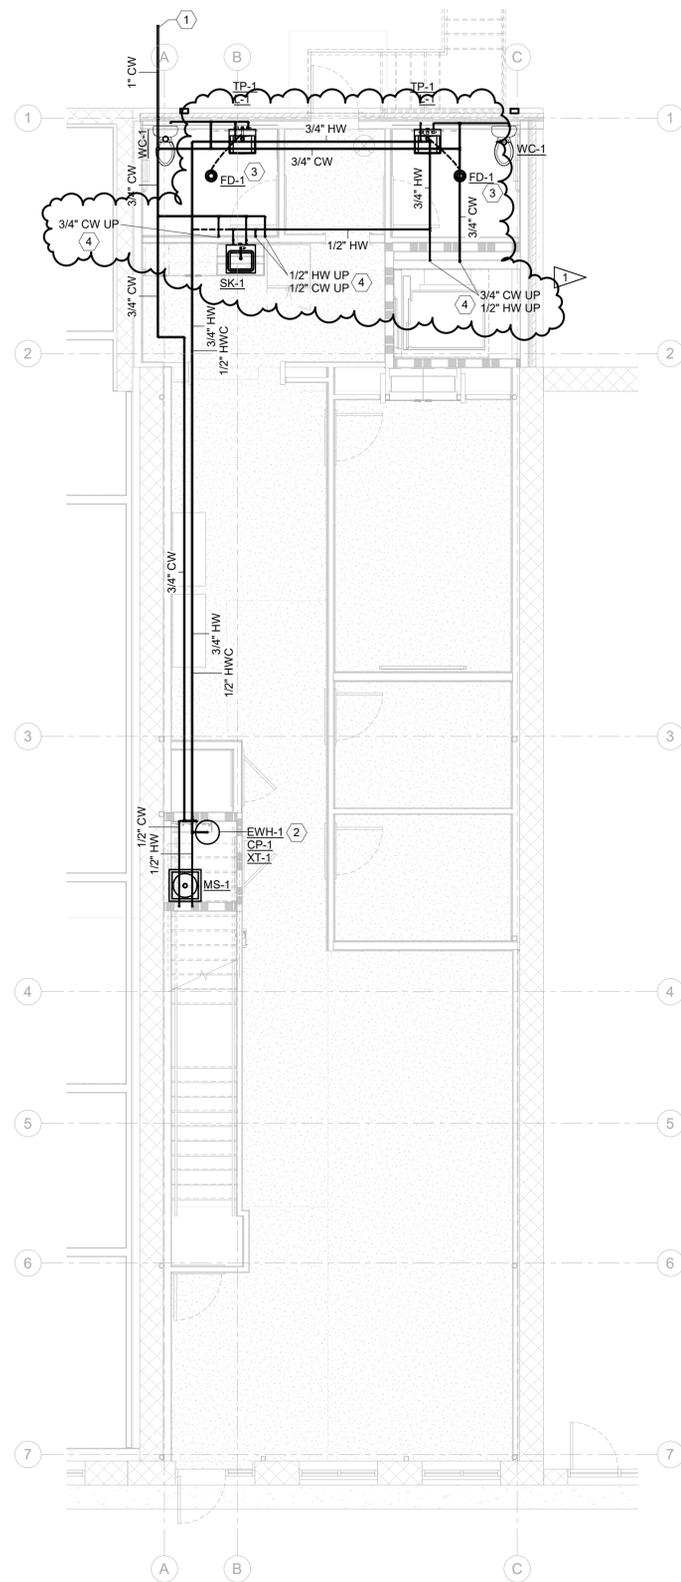

1 PLUMBING DOMESTIC W&G PLAN-FIRST FLOOR  
 P201 3/16" = 1'-0"

**GENERAL NOTES**

- A. REFER TO PLUMBING COVER SHEET DRAWING FOR SYMBOLS, ABBREVIATIONS, SPECIFICATIONS, AND ADDITIONAL INFORMATION.
- B. DUE TO DRAWING SCALE IT IS NOT POSSIBLE TO INDICATE ALL OFFSETS, FITTINGS AND ACCESSORIES WHICH MAY BE REQUIRED.
- C. THE CONTRACTOR SHALL EXAMINE FIELD CONDITIONS AND FURNISH THE NECESSARY FITTINGS WHICH MAY BE REQUIRED TO COMPLETE THE INSTALLATION.
- D. FINAL LOCATION OF ALL NEW EQUIPMENT PRIOR TO EQUIPMENT INSTALLATION SHALL BE APPROVED BY BUILDING OWNER OR PROJECT MECHANICAL ENGINEER.
- E. MAINTAIN CODE REQUIRED AND MANUFACTURER'S RECOMMENDED CLEARANCES FOR ALL NEW EQUIPMENT.
- F. PLUMBING CONTRACTOR SHALL VERIFY ALL UTILITY LOCATIONS IN THE FIELD. ROUTE NEW SANITARY WASTE AND DOMESTIC WATER PIPING TO EXISTING.

**# SHEET WORK NOTES**

- 1. PLUMBING CONTRACTOR SHALL COORDINATE WITH WATER UTILITY PROVIDER TO RELOCATE EXISTING WATER METER TO NEW LOCATION OUTSIDE OF NEW BUILDING FOOTPRINT. PROVIDE AND INSTALL METER AND 1" LINE SIZE AS REQUIRED PER WATER CALCULATION ON SHEET P003.
- 2. WATER HEATER MOUNTED TIGHT TO STRUCTURE ABOVE CUSTODIAN CLOSET DOOR. COORDINATE WITH GENERAL CONTRACTOR FOR INSTALLATION OF WALL SUPPORT.
- 3. ROUTE 1/2" TRAP PRIMER LINE FROM LAVATORY SINK TAILPIECE, BELOW SLAB TO FLOOR DRAIN TRAP PRIMER CONNECTION.
- 4. COLD WATER AND HW UP TO LEVEL 2 BATHROOMS. COORDINATE EXACT ROUTING IN THE FIELD.




127 E JACKSON ST. BURNET TX 78611

BURNET COUNTY ANNEX


Autodesk Docs/733-1408 Burnet County Annex/Burnet County\_M&P\_RV22.rvt



Project Number: 33-1408  
 © 2024 LEVY DYKEMA  
**PLUMBING DOMESTIC WATER PLANS**

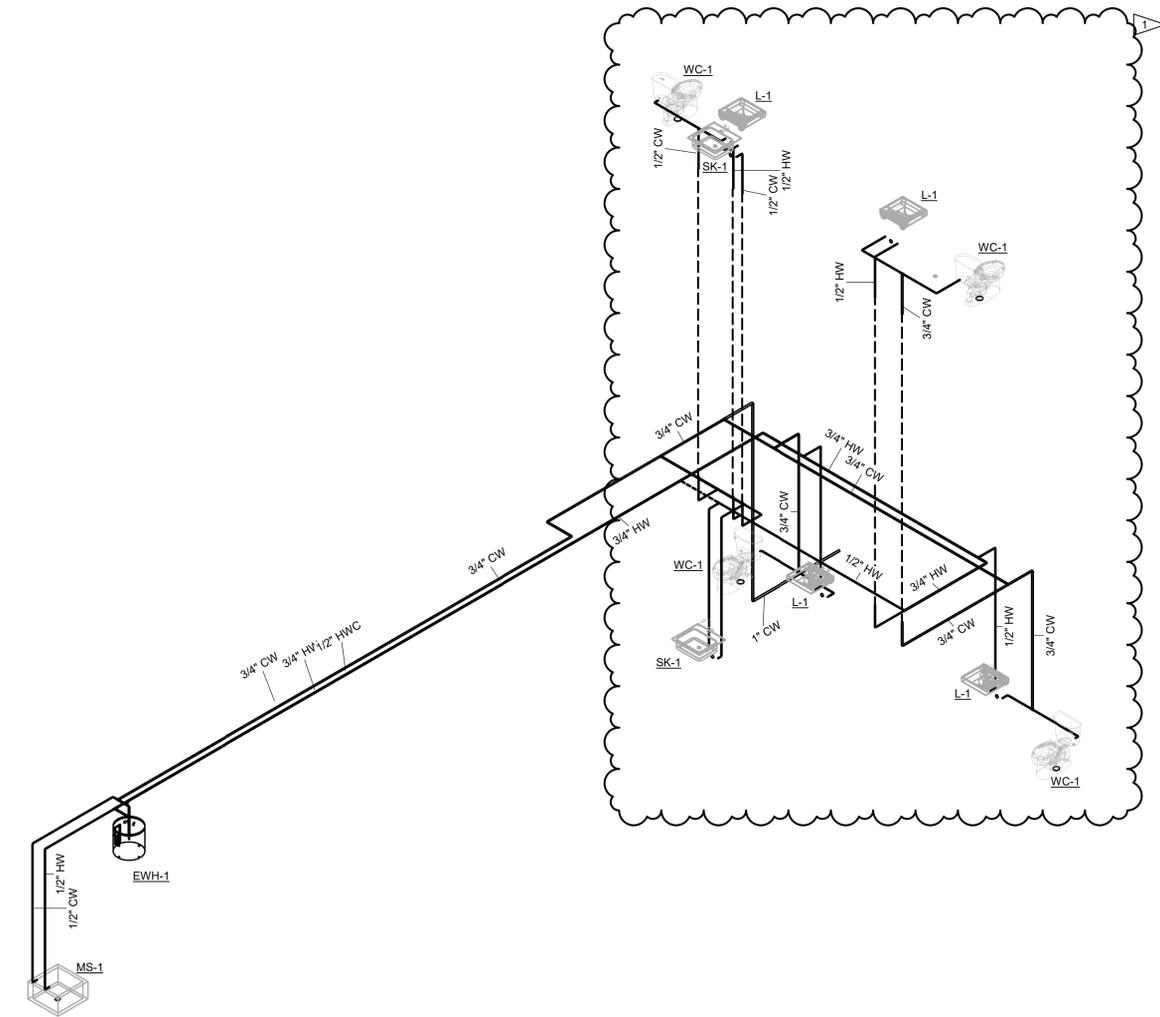

2 PLUMBING DOMESTIC WATER RISER

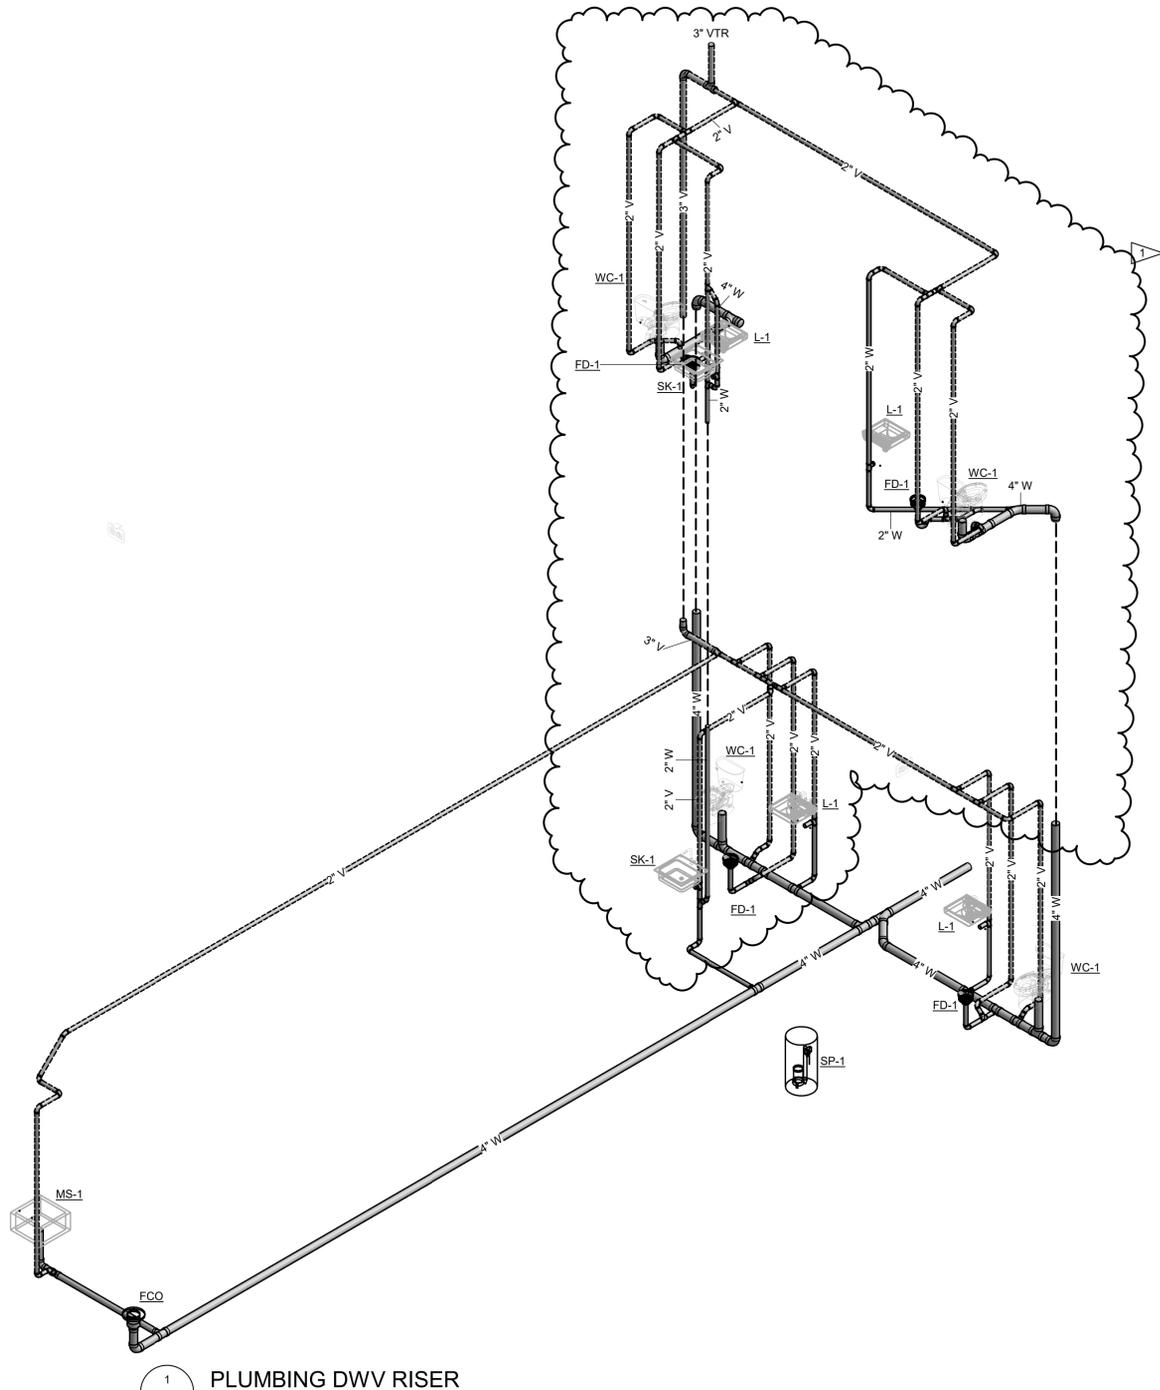

1 PLUMBING DWV RISER

#	DATE	BY
1	08/21/2025	addendum 1

Project Number: 33-1408  
© 2024 LEVY DYKEMA  
**PLUMBING RISER DIAGRAMS**

